



FED. ROAD DIST. NO.	STATE	FEDERAL - AID PROJ. NO.	FISCAL YEAR	SHEET NO.	TOTAL SHEETS
HAWAII	HAW.	NH-A311(6)R	2006	6	173

NOTE: See Superelevation Diagram for location of transitions and full super.

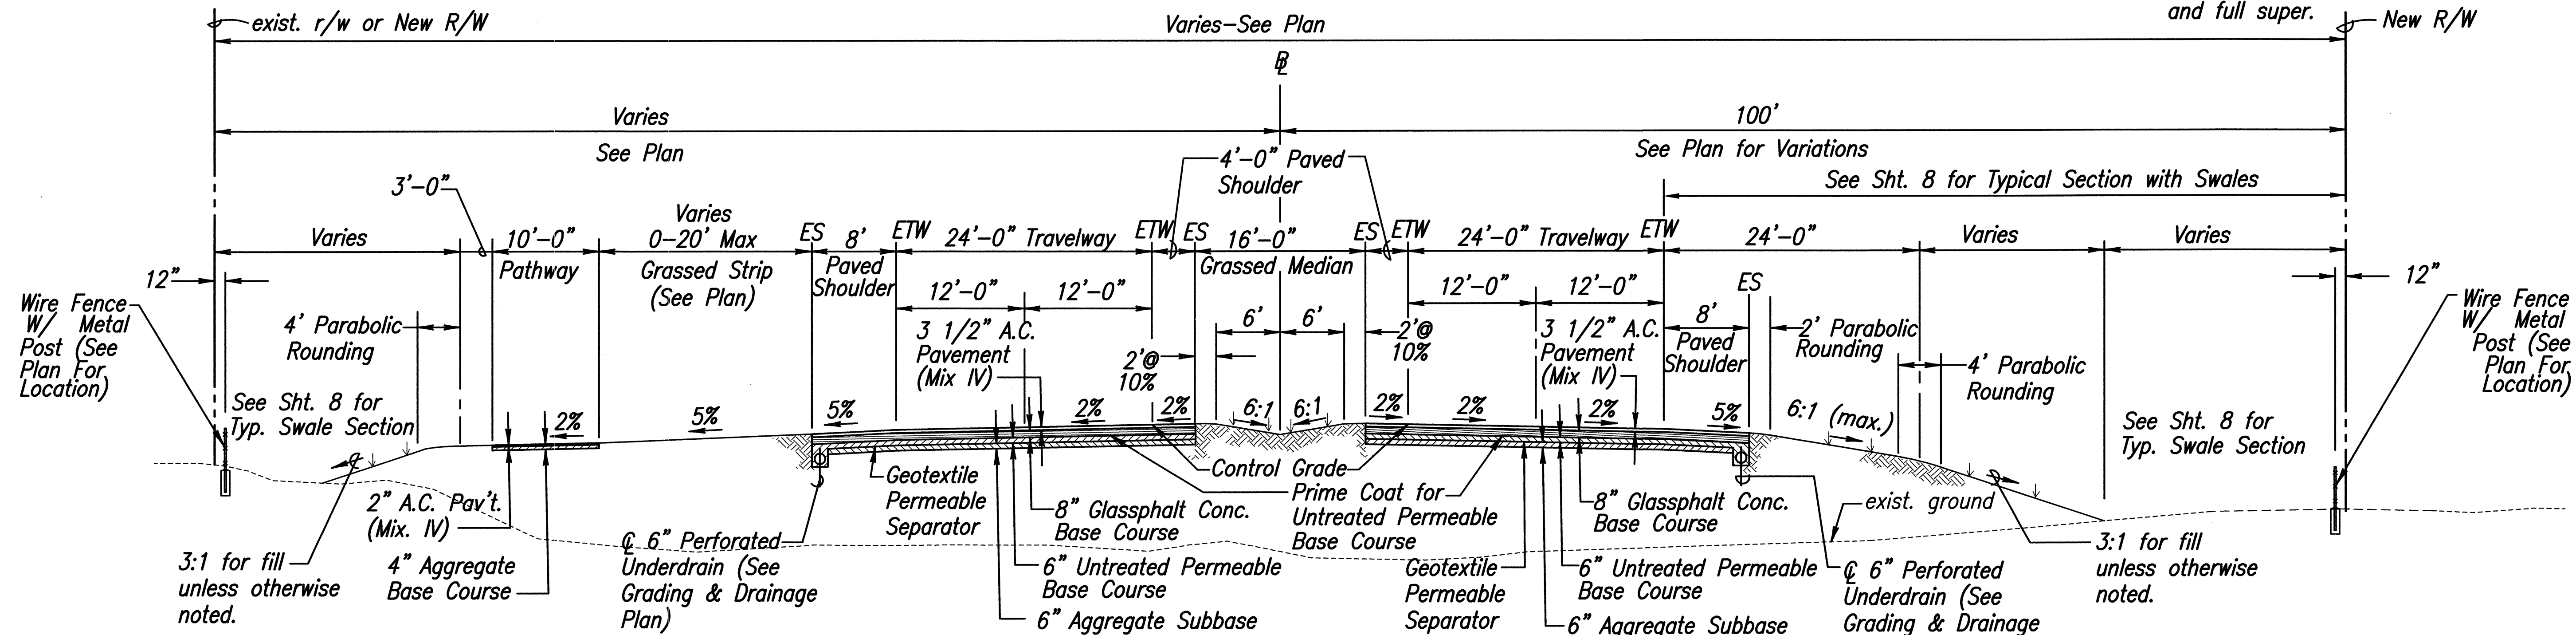

TYPICAL TANGENT SECTION-MOKULELE HIGHWAY

Scale: 1/8" = 1'-0"

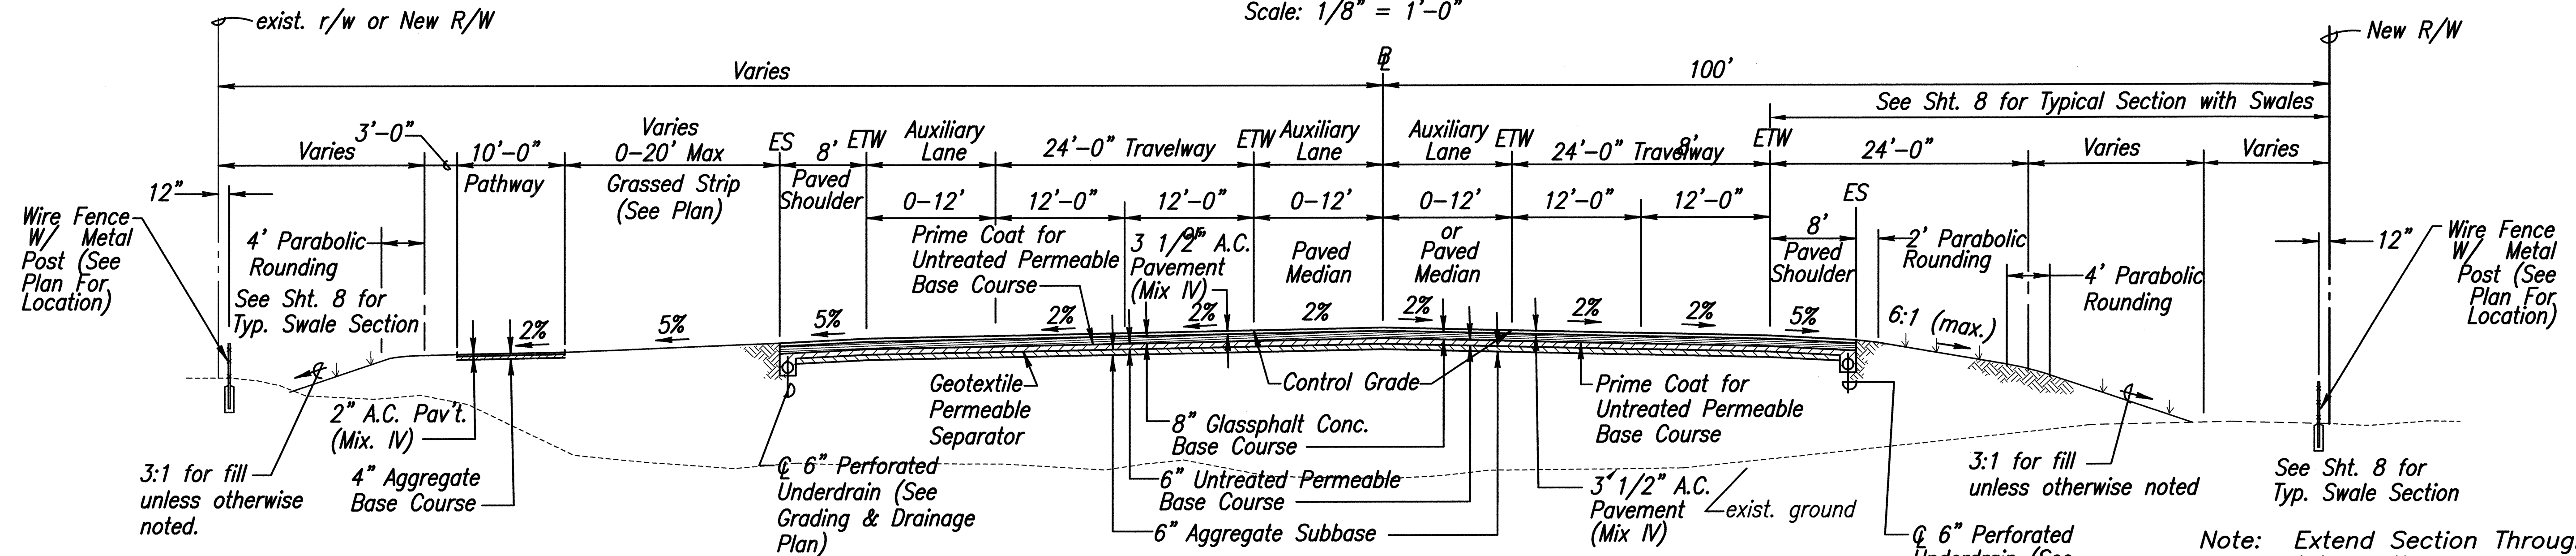

North Bound

South Bound

TYPICAL TANGENT SECTION AT PAVED MEDIAN

Scale: 1/8" = 1'-0"

Notes:

- All shoulders and graded slopes shall be planted with grass and/or ground covering in accordance with the Landscape Plans.
- Existing Pavement Structure to be Demolished and Removed Not Shown for Clarity.

- See Grading and Drainage Plan For Variations in Shoulder Slopes.
- See Sheet 74 For Typical Underdrains Sections.

SURVEY PLOTTED BY	DATE
DRAWN BY	
DESIGNED BY	
CHECKED BY	
ORIGINAL PLAN	
NOTE BOOK	
No.	

CLIFFORD M. ARAKAWA
LICENSED PROFESSIONAL ENGINEER
No. 1864-C
HAWAII U.S.A.

STATE OF HAWAII
DEPARTMENT OF TRANSPORTATION
HIGHWAYS DIVISION


TYPICAL SECTIONS

MOKULELE HIGHWAY WIDENING

Maui Humane Society
To
Vicinity of Koloa Bridge
Federal - Aid Project No. NH-A311(6)R
Scale: AS NOTED Date: JUNE 2005

SHEET No. 1 OF 3 SHEETS


FED. ROAD DIST. NO.	STATE	FEDERAL - AID PROJ. NO.	FISCAL YEAR	SHEET NO.	TOTAL SHEETS
HAWAII	HAW.	NH-A311(6)R	2006	8	173

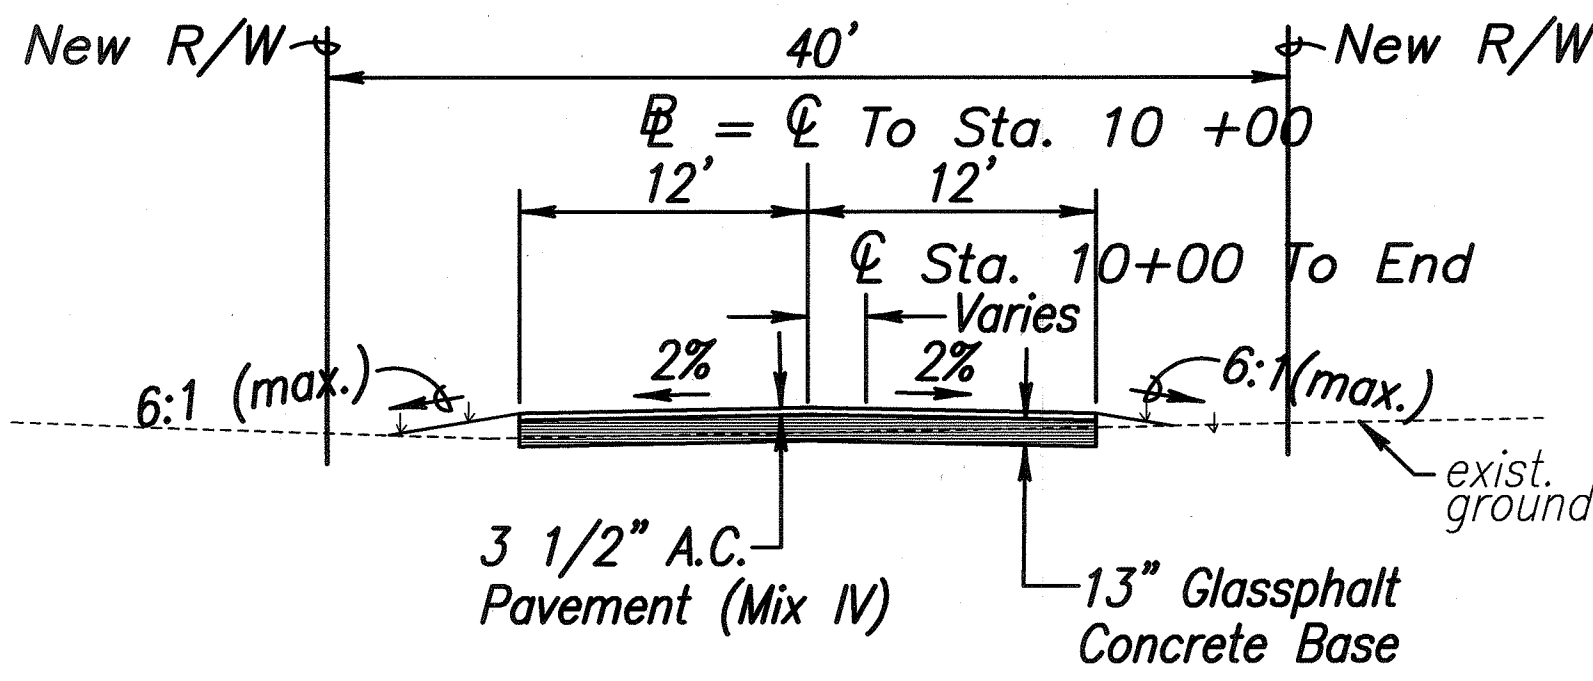

TYPICAL SECTION - MEHAMEHA LOOP


Scale: 1/8"=1'-0"

NOTE: Extend Pavement Section at 5% for Paved Shoulder

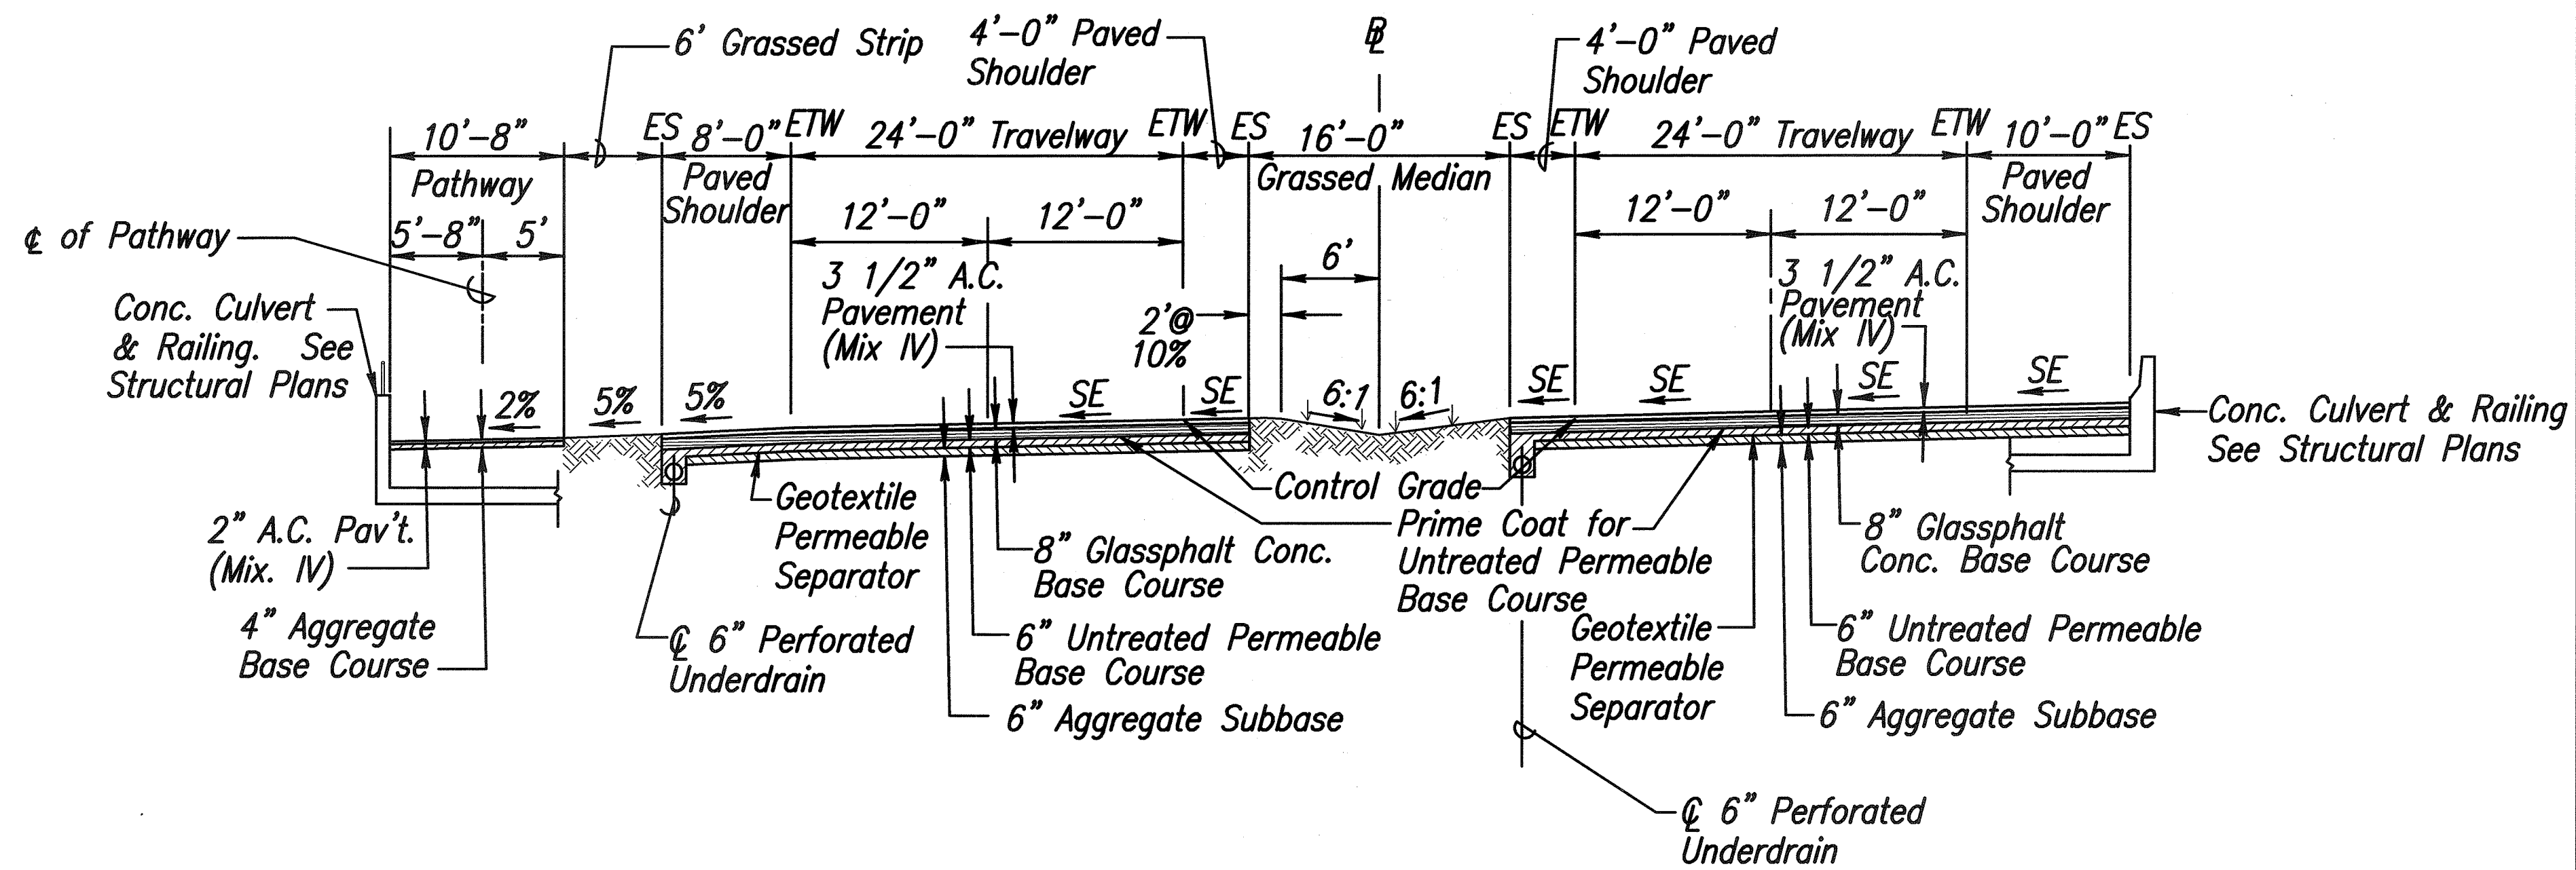


TYPICAL SECTION @ BOX CULVERT

Scale: 1/8" = 1'-0"

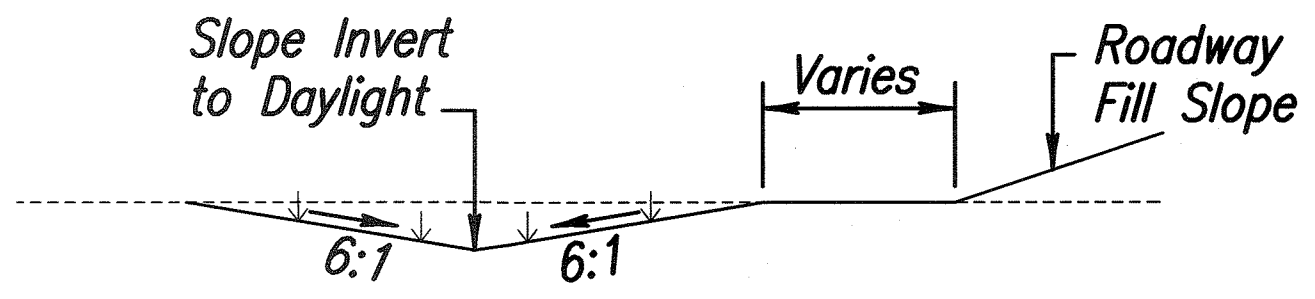


SWALE TRANSITION

Scale: 3"=1'-0"

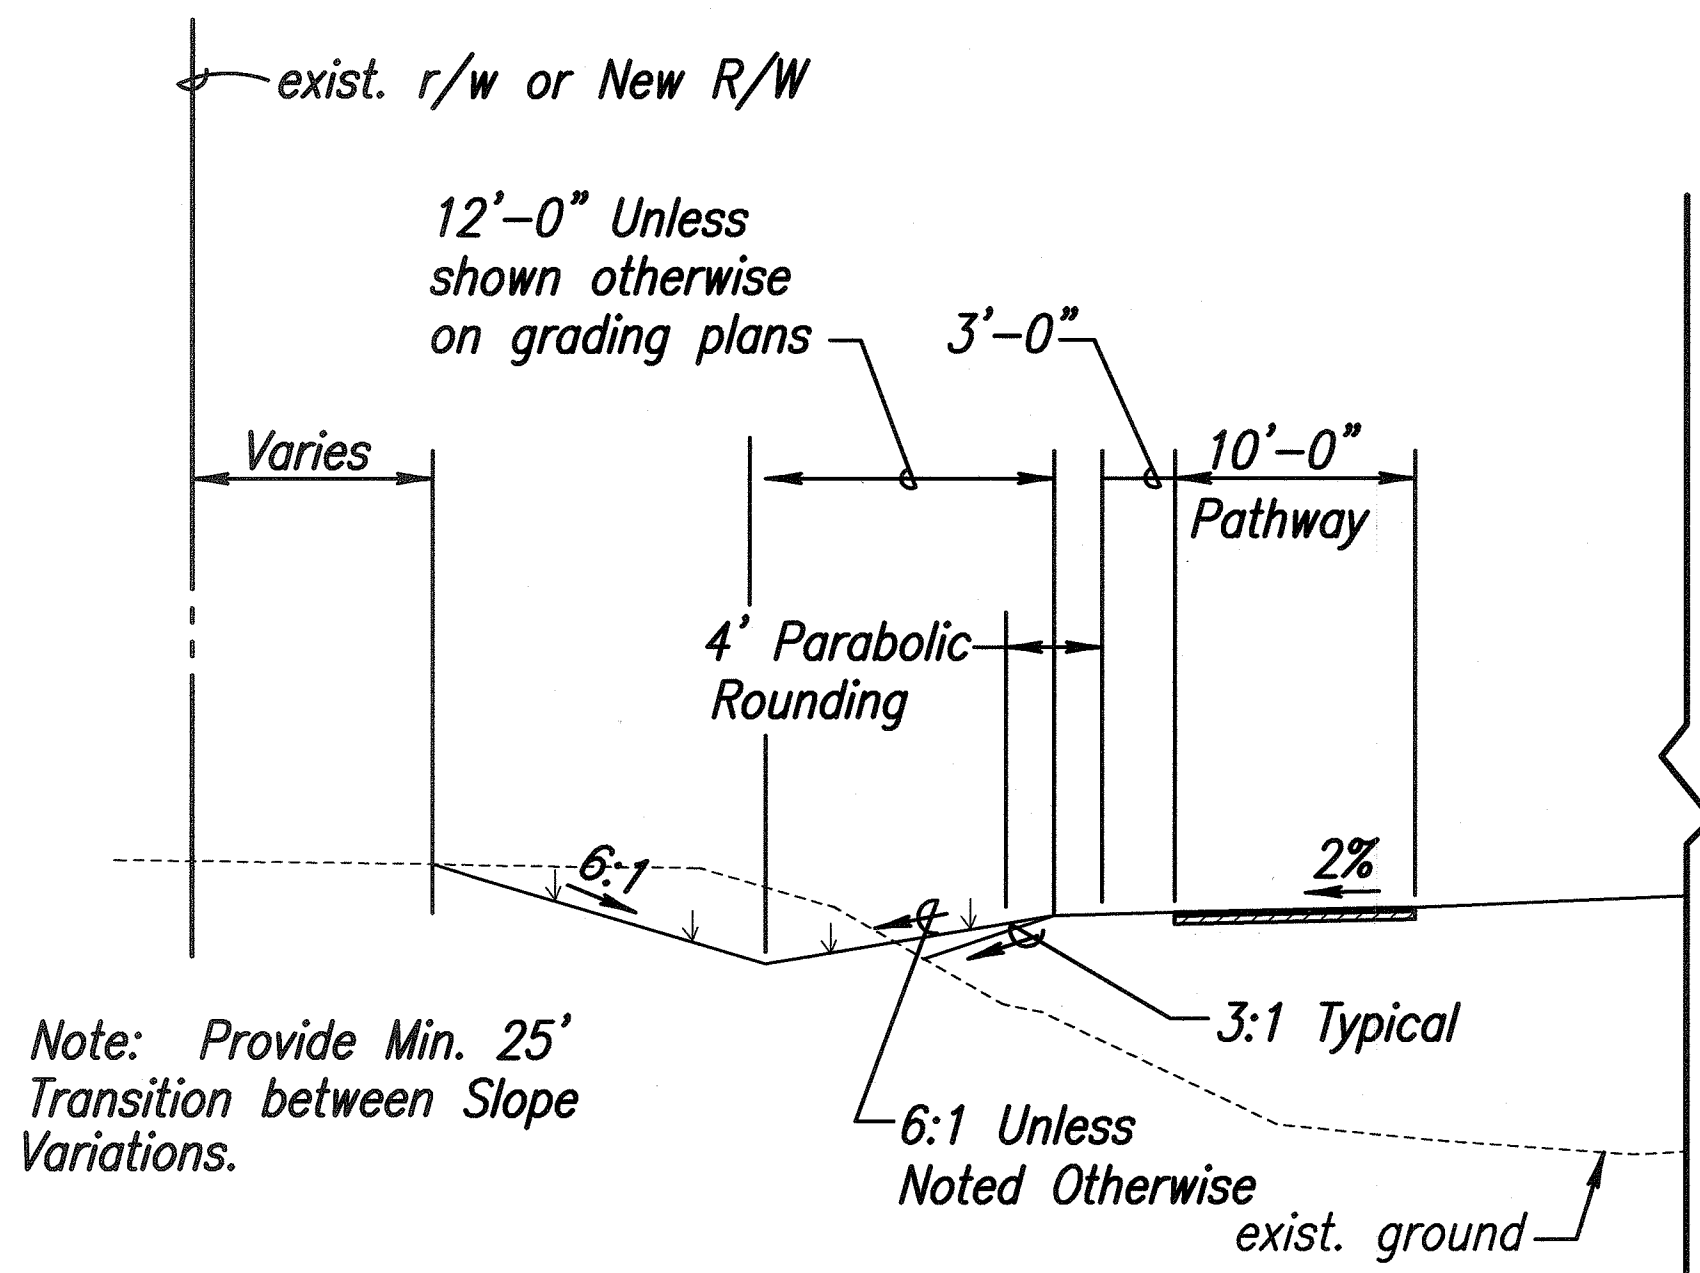

Note: Provide Min. 25' Transition between Slope Variations.


- 38' Begin to Sta. 281+88
- 42' Sta. 201+50 to 203+00
- 46' Sta. 203+50 to Sta. 220+00
- 48' Sta. 220+50 to Sta. 227+00
- 46' Sta. 227+00 to Sta. 232+50
- 45' Sta. 233+00 to Sta. 236+00
- 39' Sta. 236+50 to Sta. 244+50
- 41' Sta. 245+00 to End

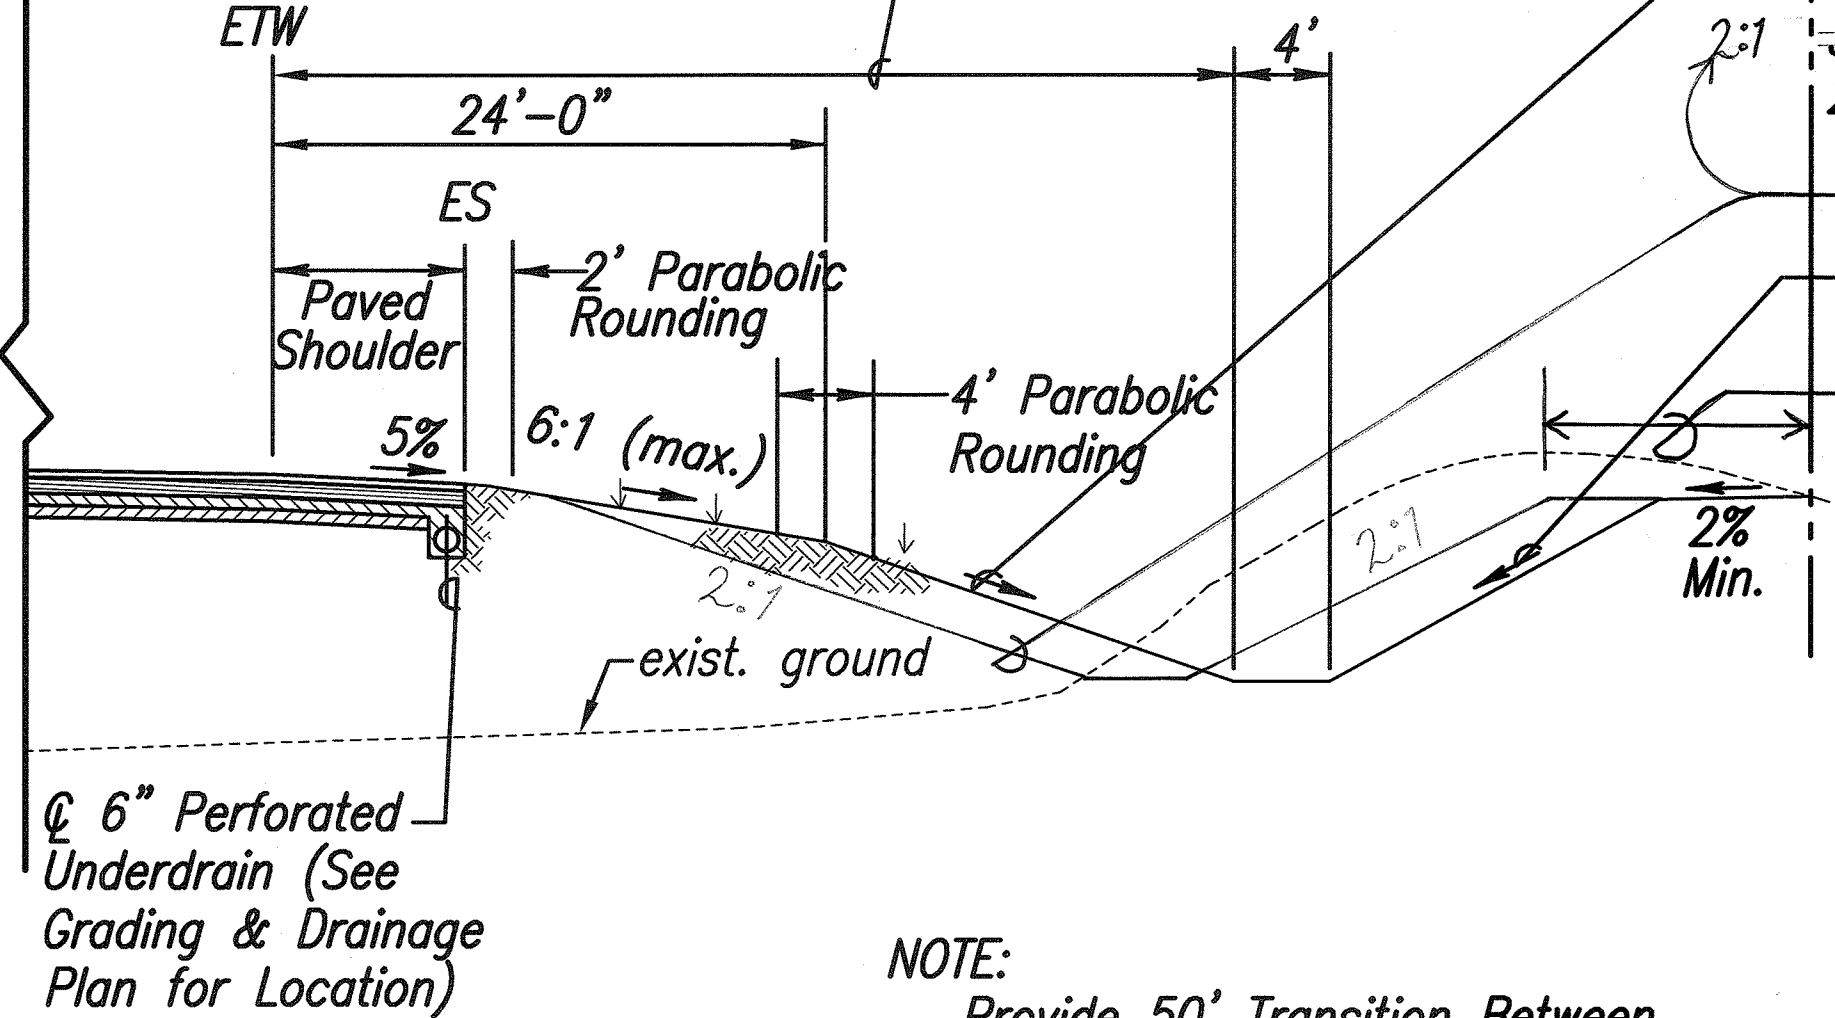

TYPICAL SECTION AT SWALES

Scale: 1/8"=1'-0"

NOTE: Provide 50' Transition Between Offset and Slope Changes.

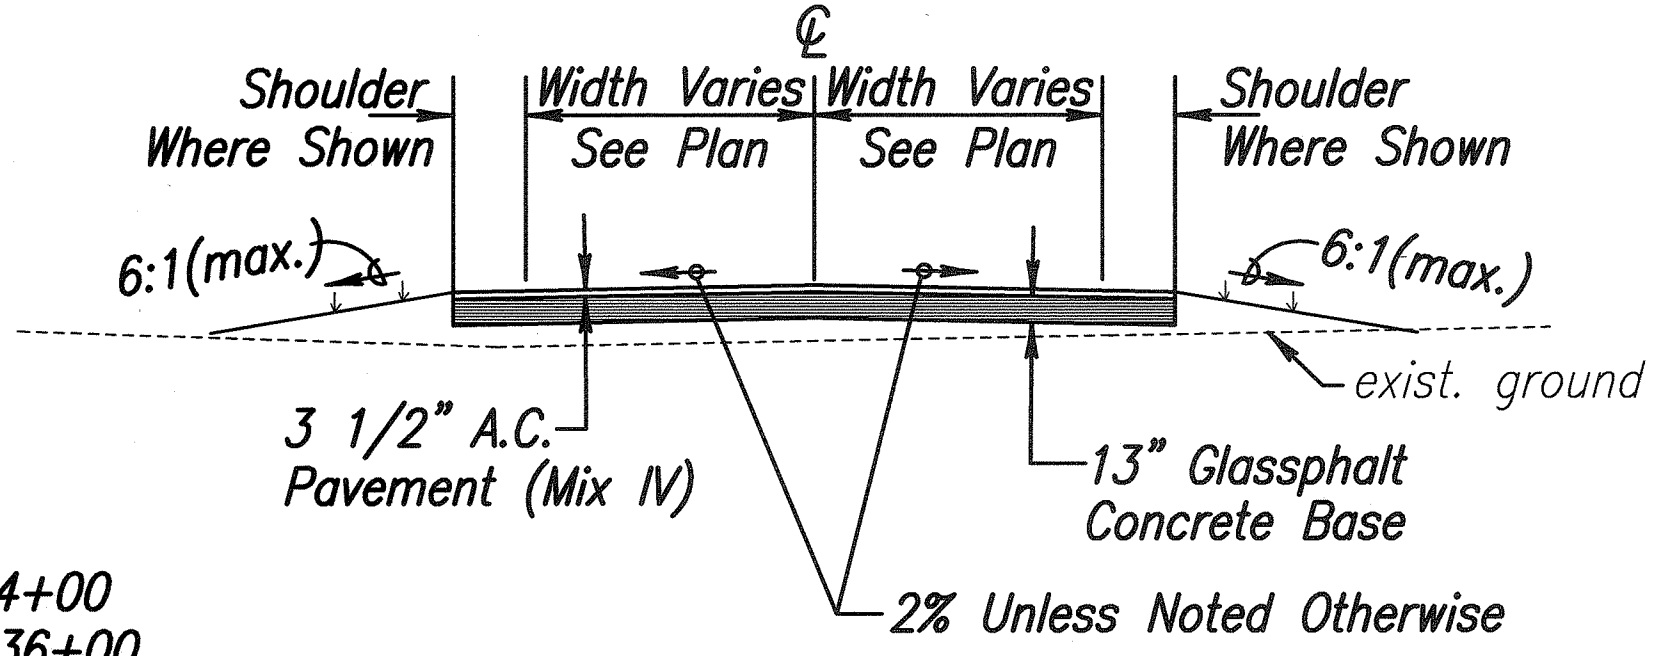

DRIVEWAYS & FRONTAGE ROADS

Scale: 1/8"=1'-0"

SURVEY PLOTTED BY	DATE
DRAWN BY	
DESIGNED BY	
CHECKED BY	
ORIGINAL PLAN	
NOTE BOOK	
No.	

CLIFFORD M. ARAKAWA
LICENSED PROFESSIONAL ENGINEER
No. 1864-C
HAWAII, U.S.A.

STATE OF HAWAII
DEPARTMENT OF TRANSPORTATION
HIGHWAYS DIVISION

TYPICAL SECTIONS

MOKULELE HIGHWAY WIDENING

Maui Humane Society
To
Vicinity of Kolaloa Bridge

Federal - Aid Project No. NH-A311(6)R

Scale: AS NOTED Date: JUNE 2005

SHEET No. 3 OF 3 SHEETS

"AS-BUILT"