
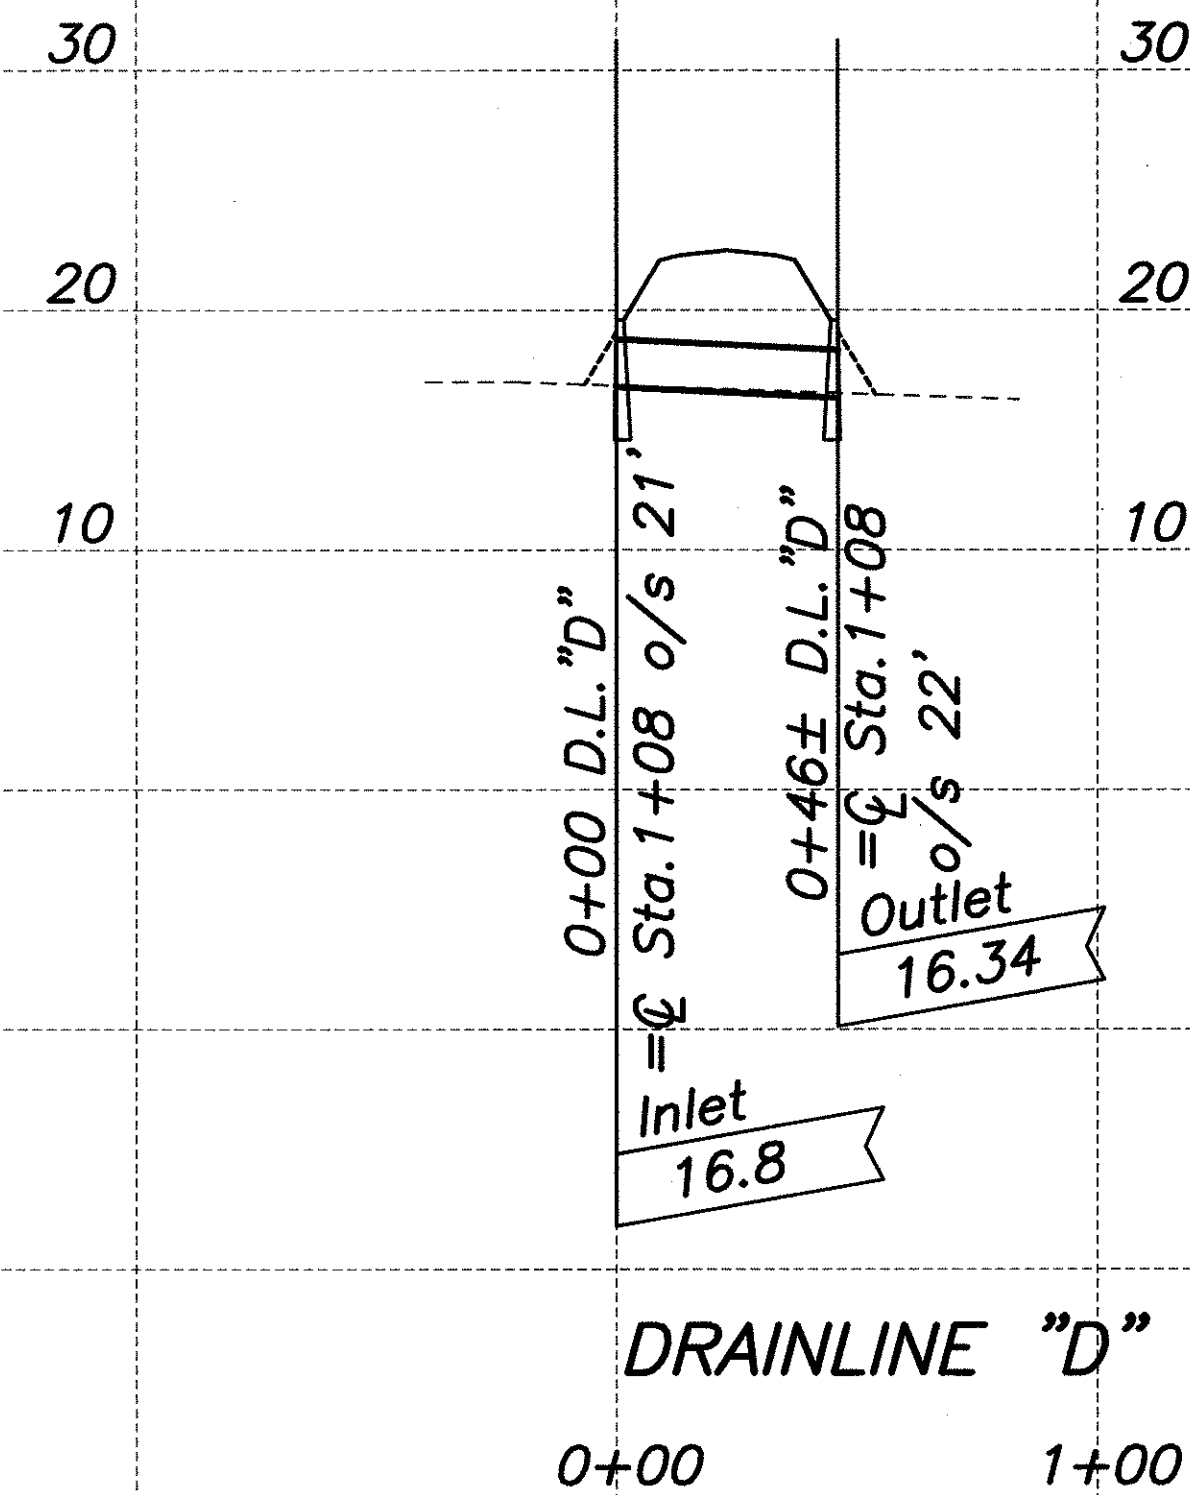
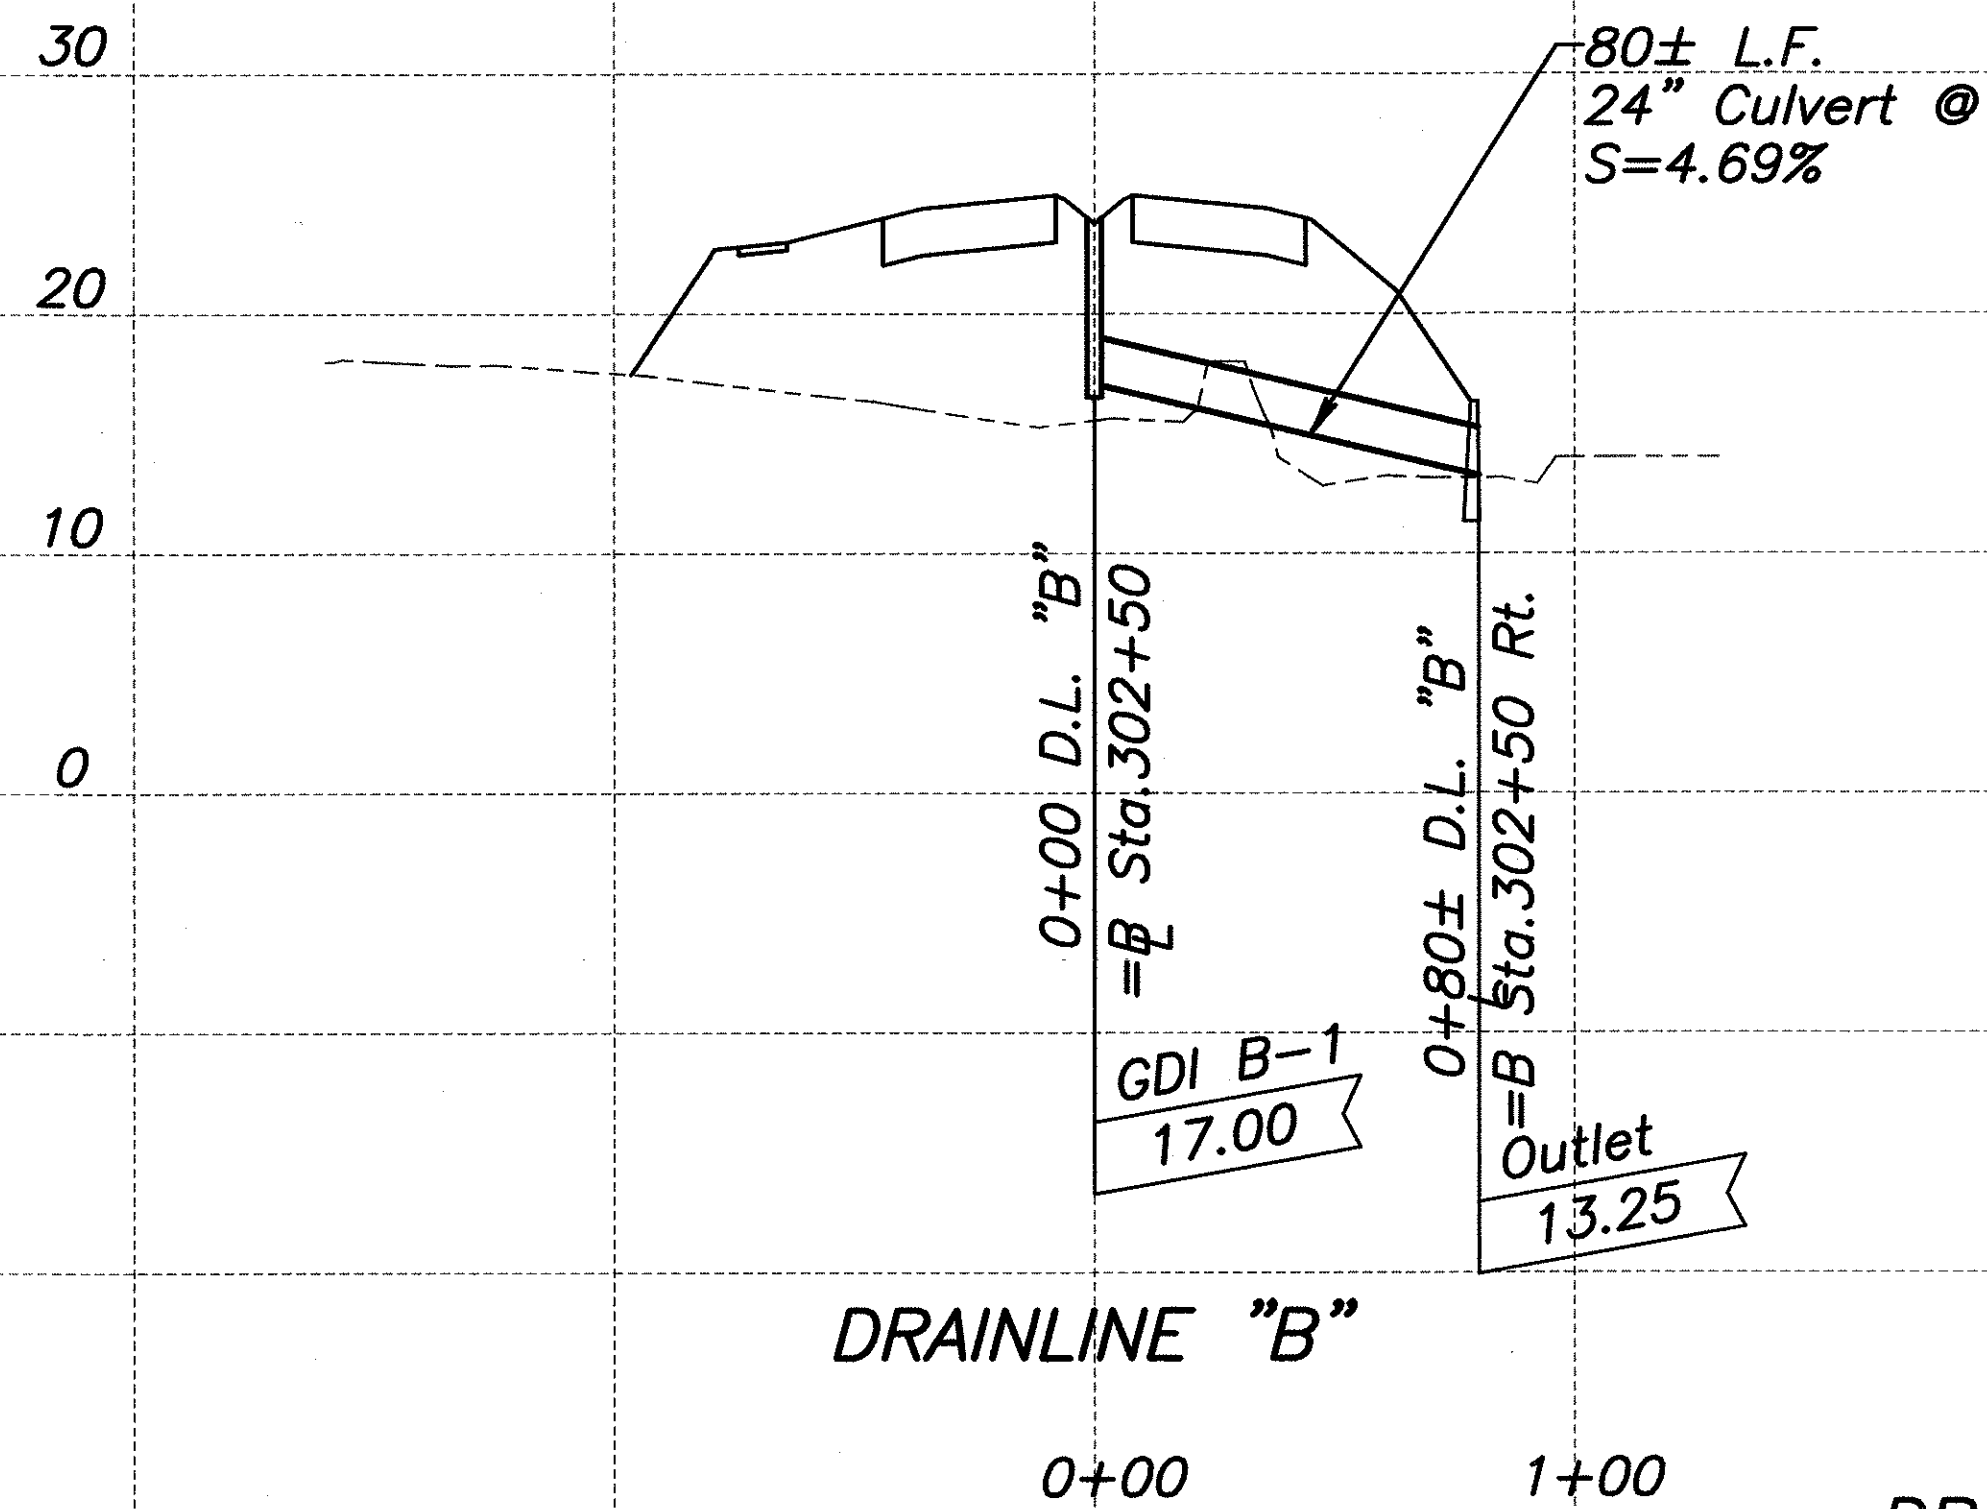
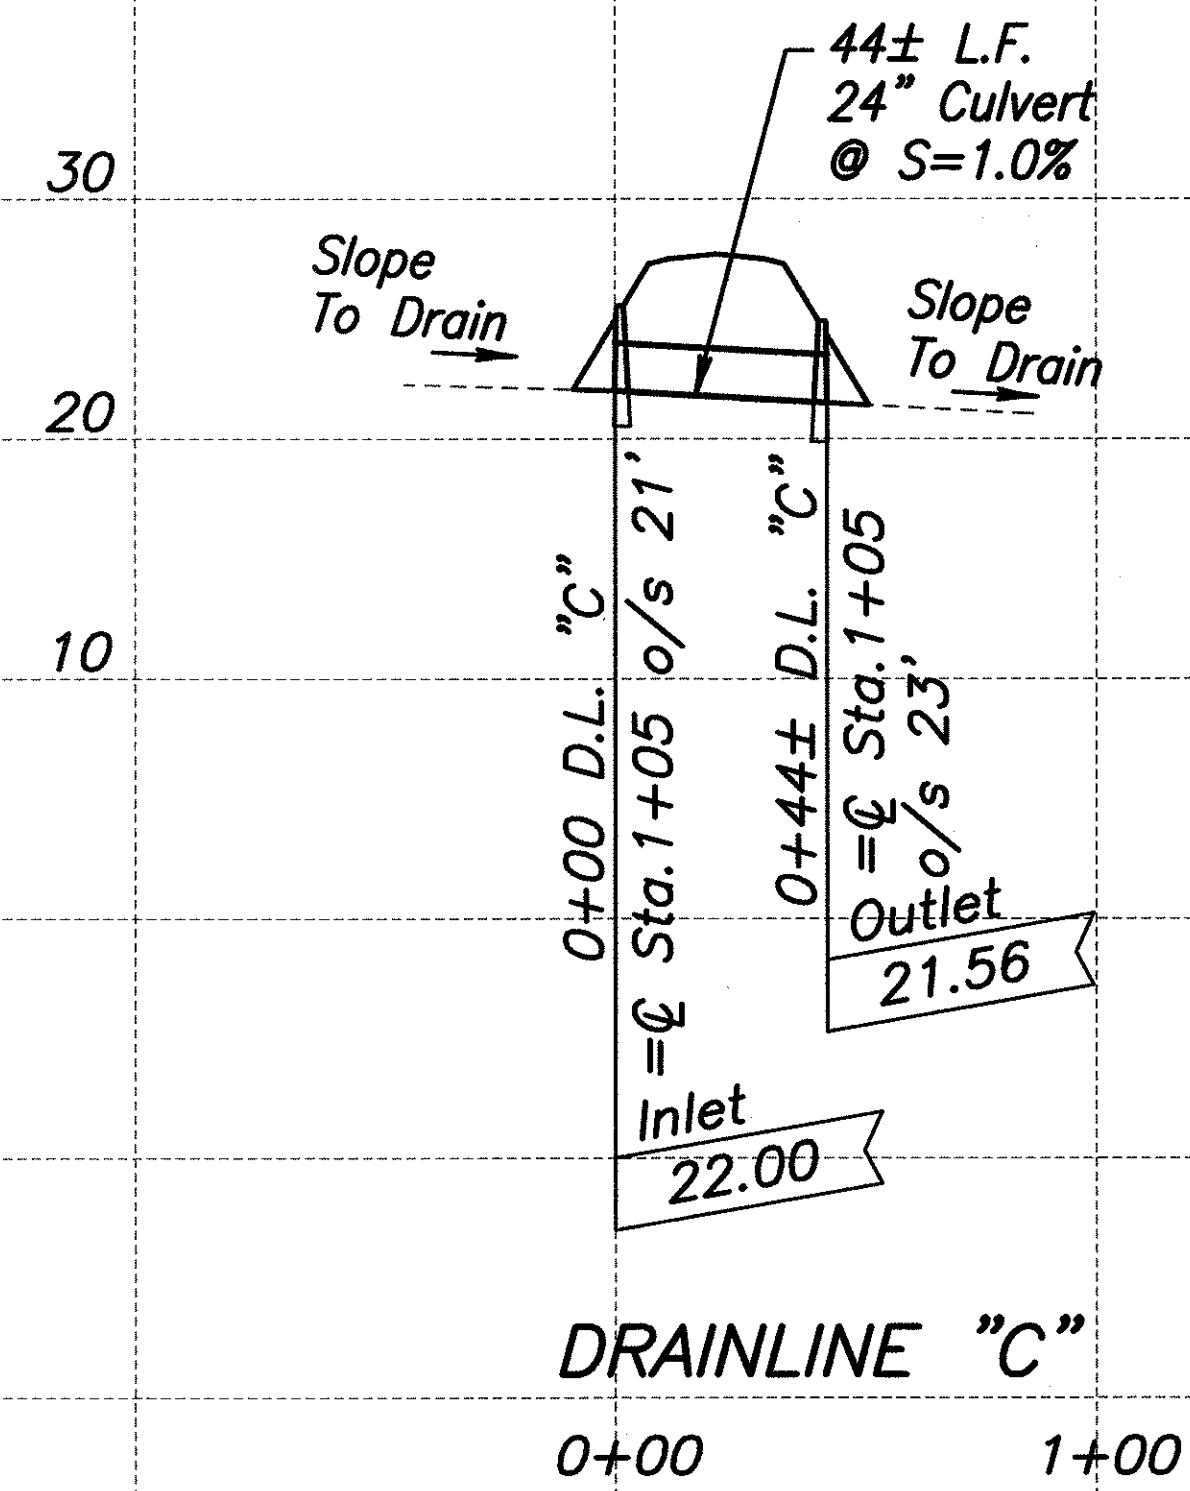


| FED. ROAD DIST. NO. | STATE | FEDERAL - AID PROJ. NO. | FISCAL YEAR | SHEET NO. | TOTAL SHEETS |
|---------------------|-------|-------------------------|-------------|-----------|--------------|
| HAWAII              | HAW.  | NH-A311(7)              | 2004        | 55        | 138          |

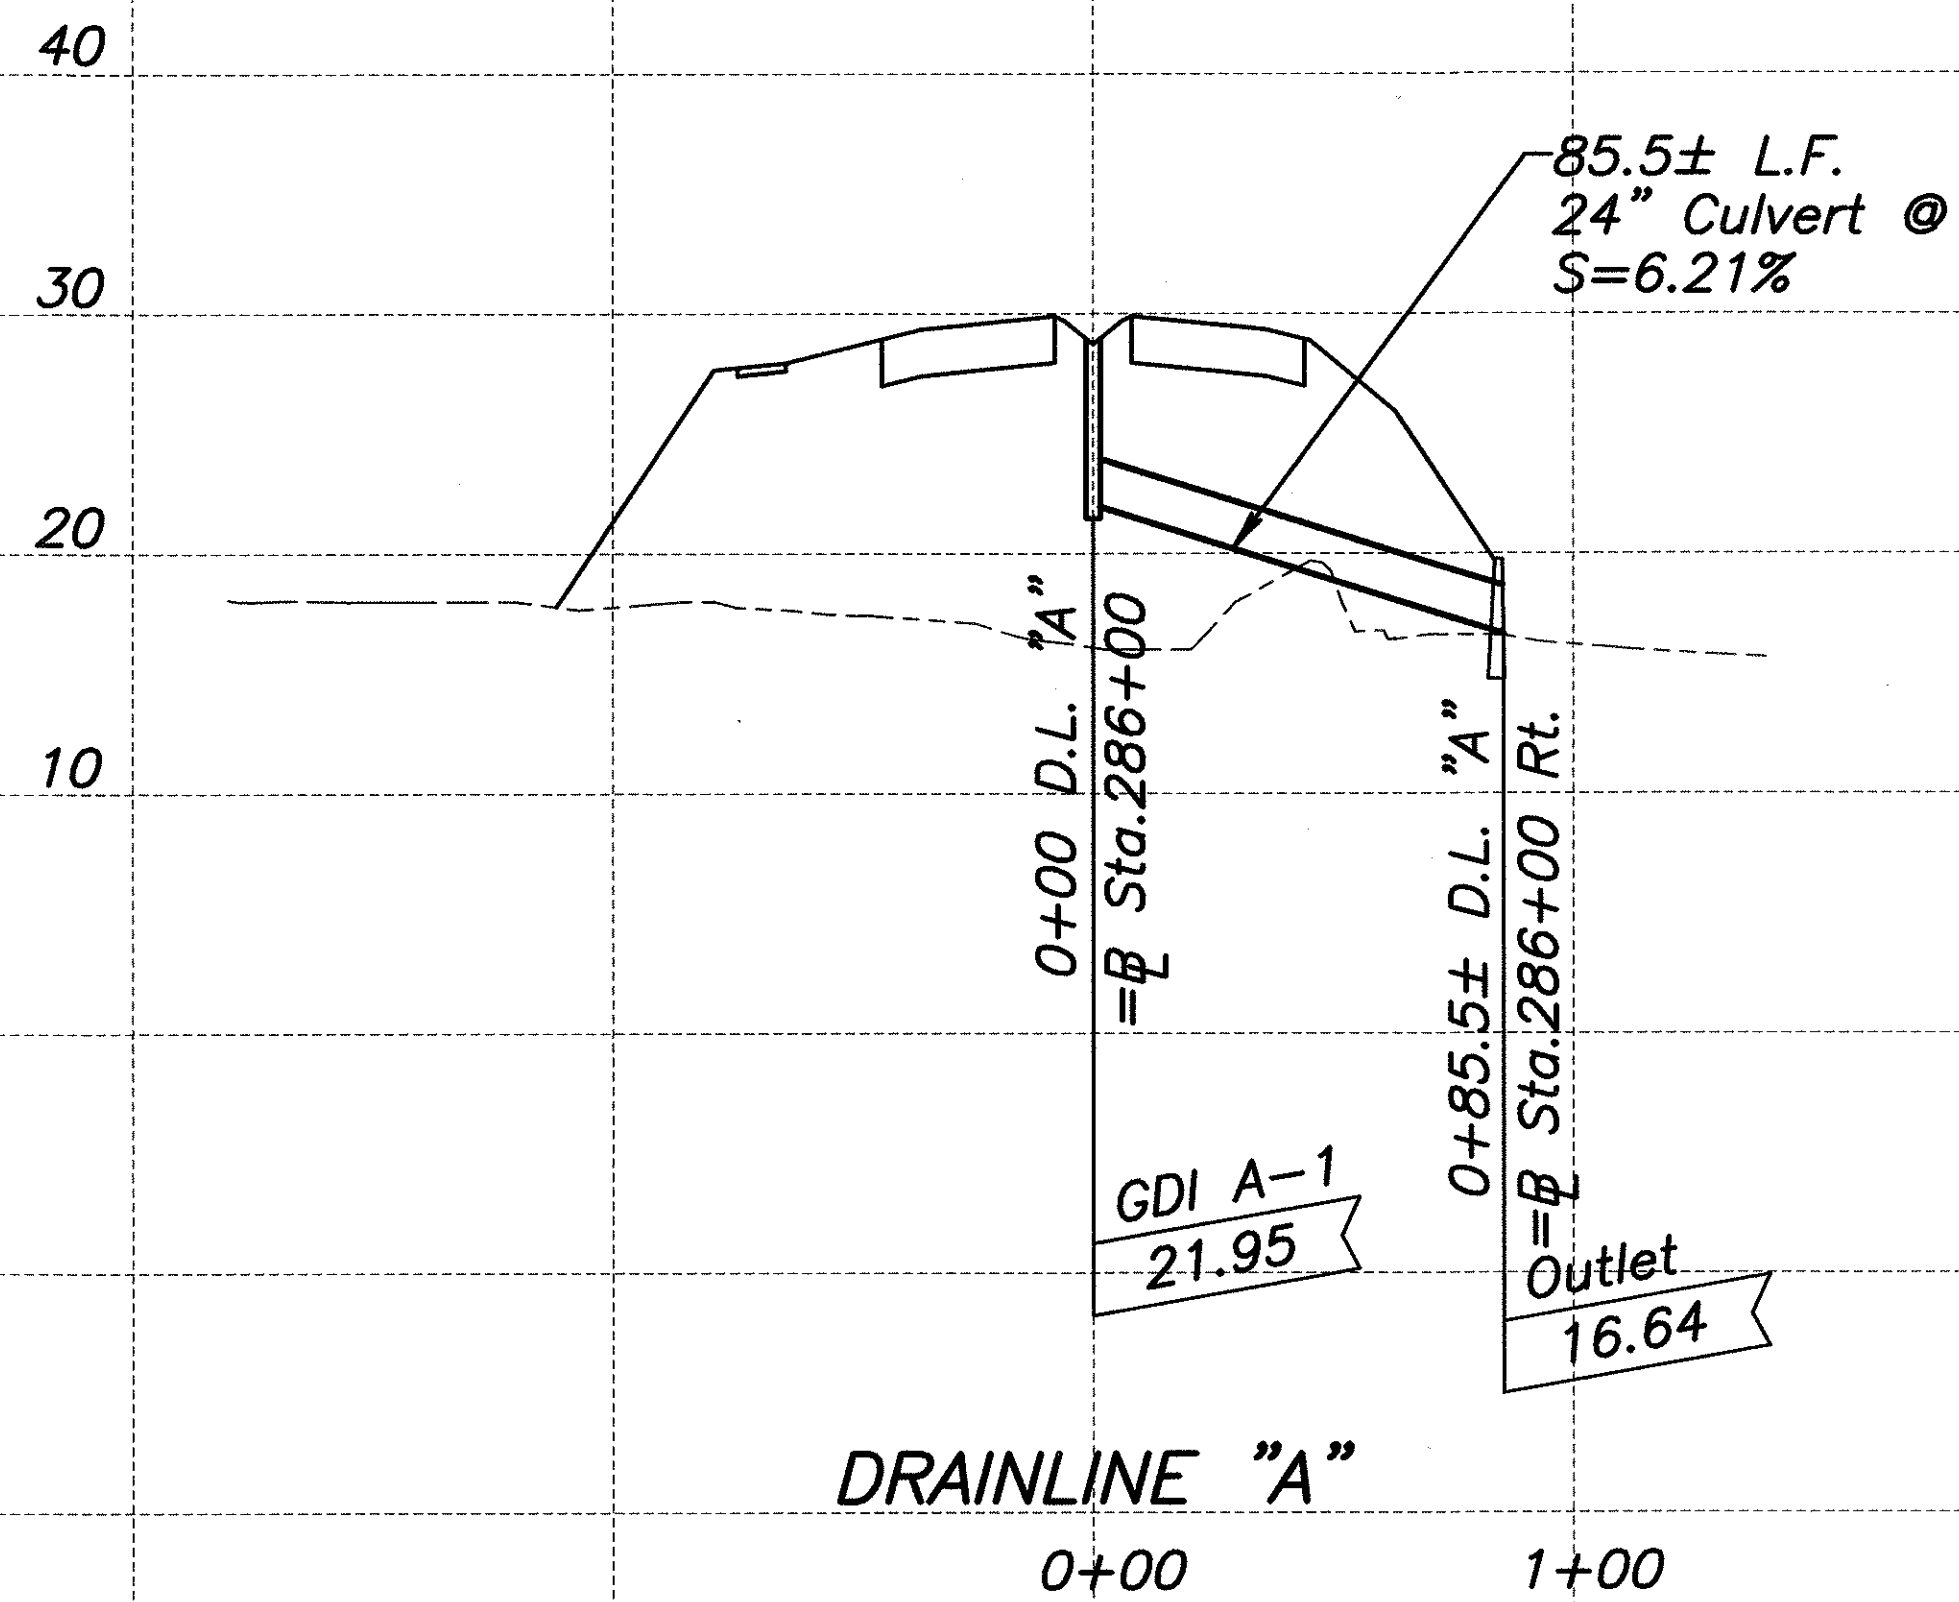

**DRAINLINE PROFILE**  
Scale: 1"=40' Horiz.  
1"=8' Vert.

|               |                   |      |
|---------------|-------------------|------|
| ORIGINAL PLAN | SURVEY PLOTTED BY | DATE |
| NOTE BOOK     | DESIGNED BY       |      |
| QUANTITIES BY | CHECKED BY        |      |
| No.           |                   |      |

STATE OF HAWAII  
DEPARTMENT OF TRANSPORTATION  
HIGHWAYS DIVISION

**DRAINLINE PROFILE**

MOKULELE HIGHWAY WIDENING  
Vicinity of Kolaloa Bridge  
To  
Vicinity of Kealia Pond Driveway  
Federal - Aid Project No. NH-A311(7)  
Scale: AS NOTED Date: August 2003

SHEET No. 1 OF 1 SHEETS

THIS WORK WAS PREPARED BY  
ME OR UNDER MY SUPERVISION

04/30/04  
EXPIRATION DATE OF THE LICENSE

DANIEL S. MIYASATO  
LICENSED PROFESSIONAL ENGINEER  
No. 3443-C  
HAWAII U.S.A.