


FED. ROAD DIST. NO.	STATE	FEDERAL - AID PROJ. NO.	FISCAL YEAR	SHEET NO.	TOTAL SHEETS
HAWAII	HAW.	NH-A311(7)	2004	68	138

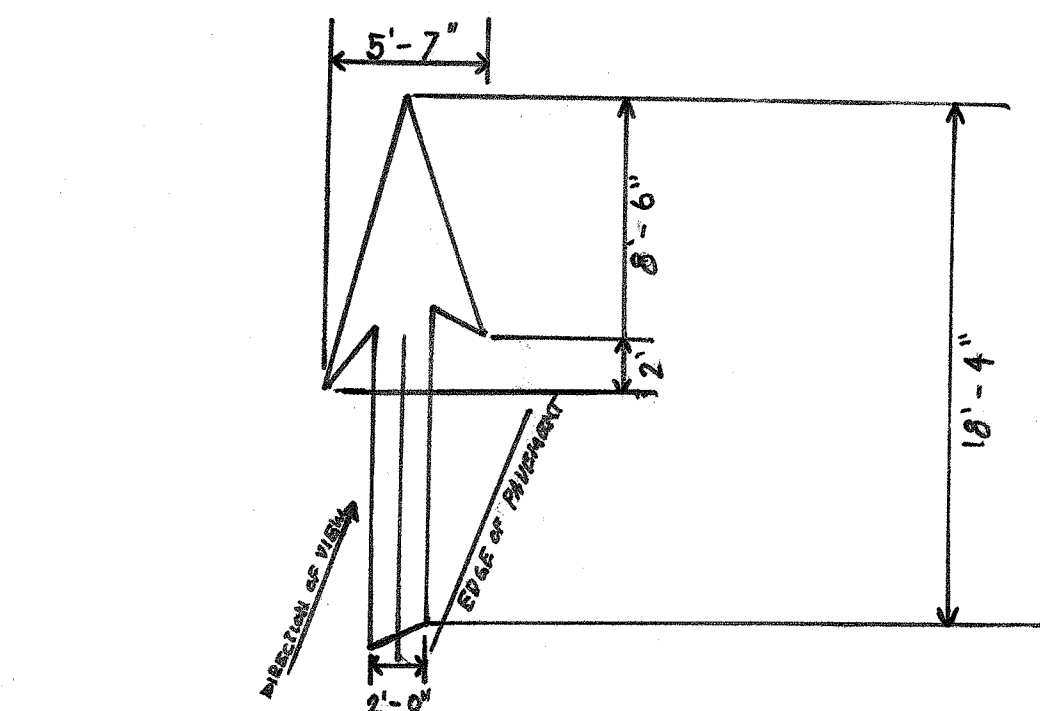

TYPE VI ARROW
Right Lane Drop Arrow
(For Left Lane Drop Use
Mirror Image)

New R/W

Station 257+00
R=800'


$\Delta = 10^\circ 45' 36''$
R = 800 F.T.
T = 75.33 F.T.
L.C. = 150 F.T.
D = 7.16°



Station 258+50
Begin Project

258+80


310 F.T.

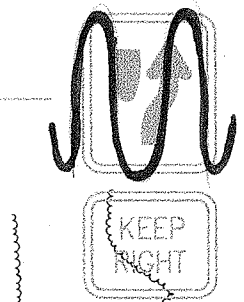

Station 263+00
Temp Striping Tie-In




R2-1(45)
24"x30"

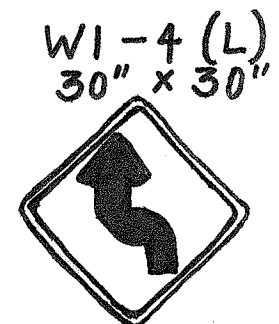

MATCHLINE
265+00

← To Kahului

To Kihei →

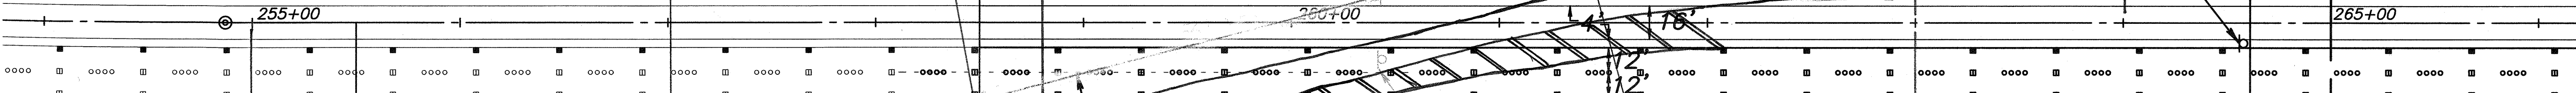

Existing
Mokulele Highway

Existing
Mokulele Highway

Remove Exist. Guide Line

Tie Into
Exist. Markings

Station 257+00

Station 263+00
R=600'


$\Delta = 14^\circ 56' 21.1''$
R = 600 F.T.
T = 78.67 F.T.
L.C. = 186 F.T.
D = 9.55°

Notes:

Install New Sign(s) & Post(s) as shown
unless otherwise specified (1)

- ① Existing sign(s) & post(s) to remain
- ② Remove existing sign(s) & post(s)
- ③ Remove existing & Install New Sign(s) & Post(s)
- ④ Relocate existing sign(s) & post(s)

Neatly bundle signs & posts to be removed and
return to Highways Kahului Baseyard
For Details of Signs See Shts. 65

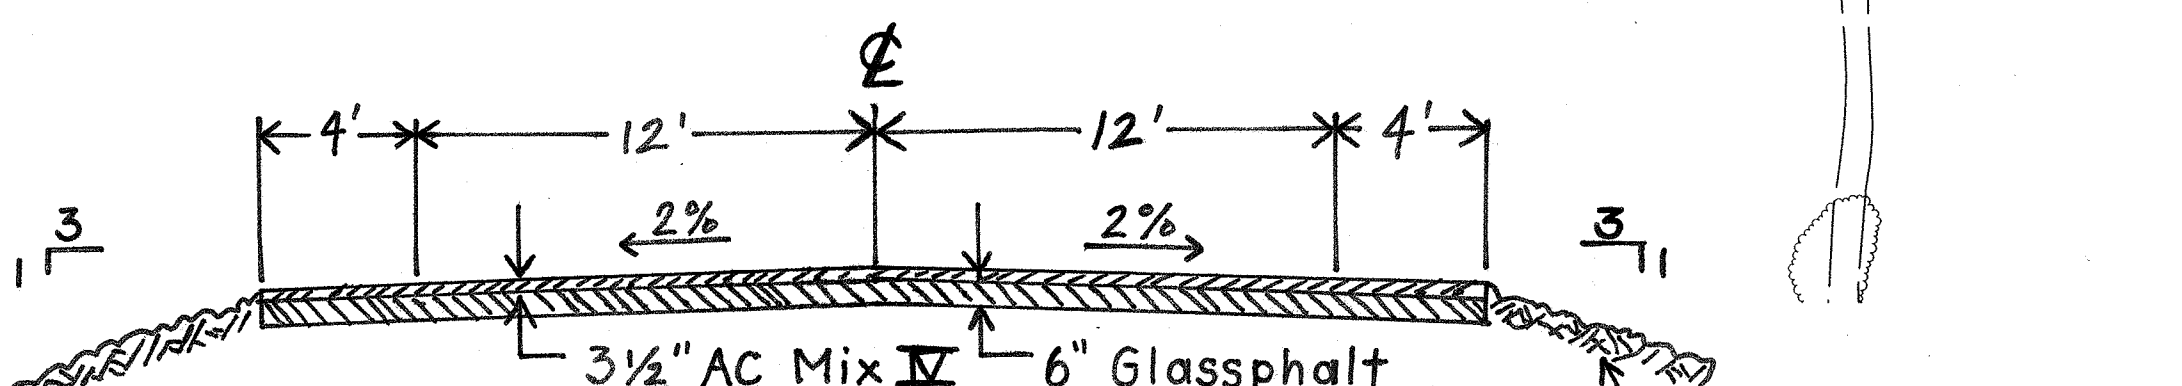


A-A (STA 257+00 to 258+50)*


Temporary Transition Road

*Striped/Grassed Median
Station 258+50 to Sta. 263+50

Shoulder Dressing

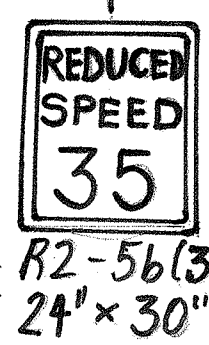


R2-5b(35)
24"x30"

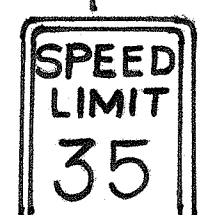

R2-1(35)
24"x30"

ORIGINAL PLAN	SURVEY PLOTTED BY	DATE
	DRAWN BY	
	DESIGNED BY	
	CHECKED BY	
NOTE BOOK	No.	

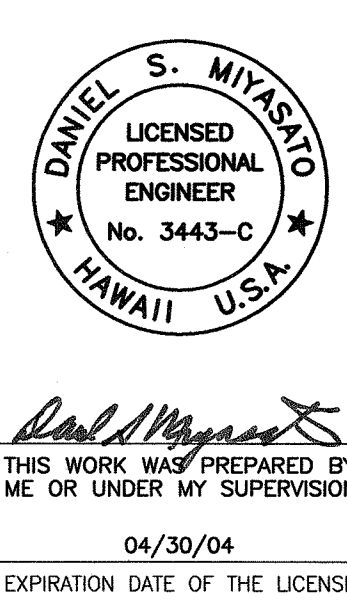

STATE OF HAWAII
DEPARTMENT OF TRANSPORTATION
HIGHWAYS DIVISION


STRIPING AND SIGNAGE PLAN

MOKULELE HIGHWAY WIDENING
Vicinity of Kolaloa Bridge
To
Vicinity of Kealia Pond Driveway
Federal - Aid Project No. NH-A311(7)
Scale: 1"=40' Date: August 2003

SHEET No. 1 OF 7 SHEETS

"AS-BUILT"

FED. ROAD DIST. NO.	STATE	FEDERAL - AID PROJ. NO.	FISCAL YEAR	SHEET NO.	TOTAL SHEETS
HAWAII	HAW.	NH-A311(7)	2004	69	138

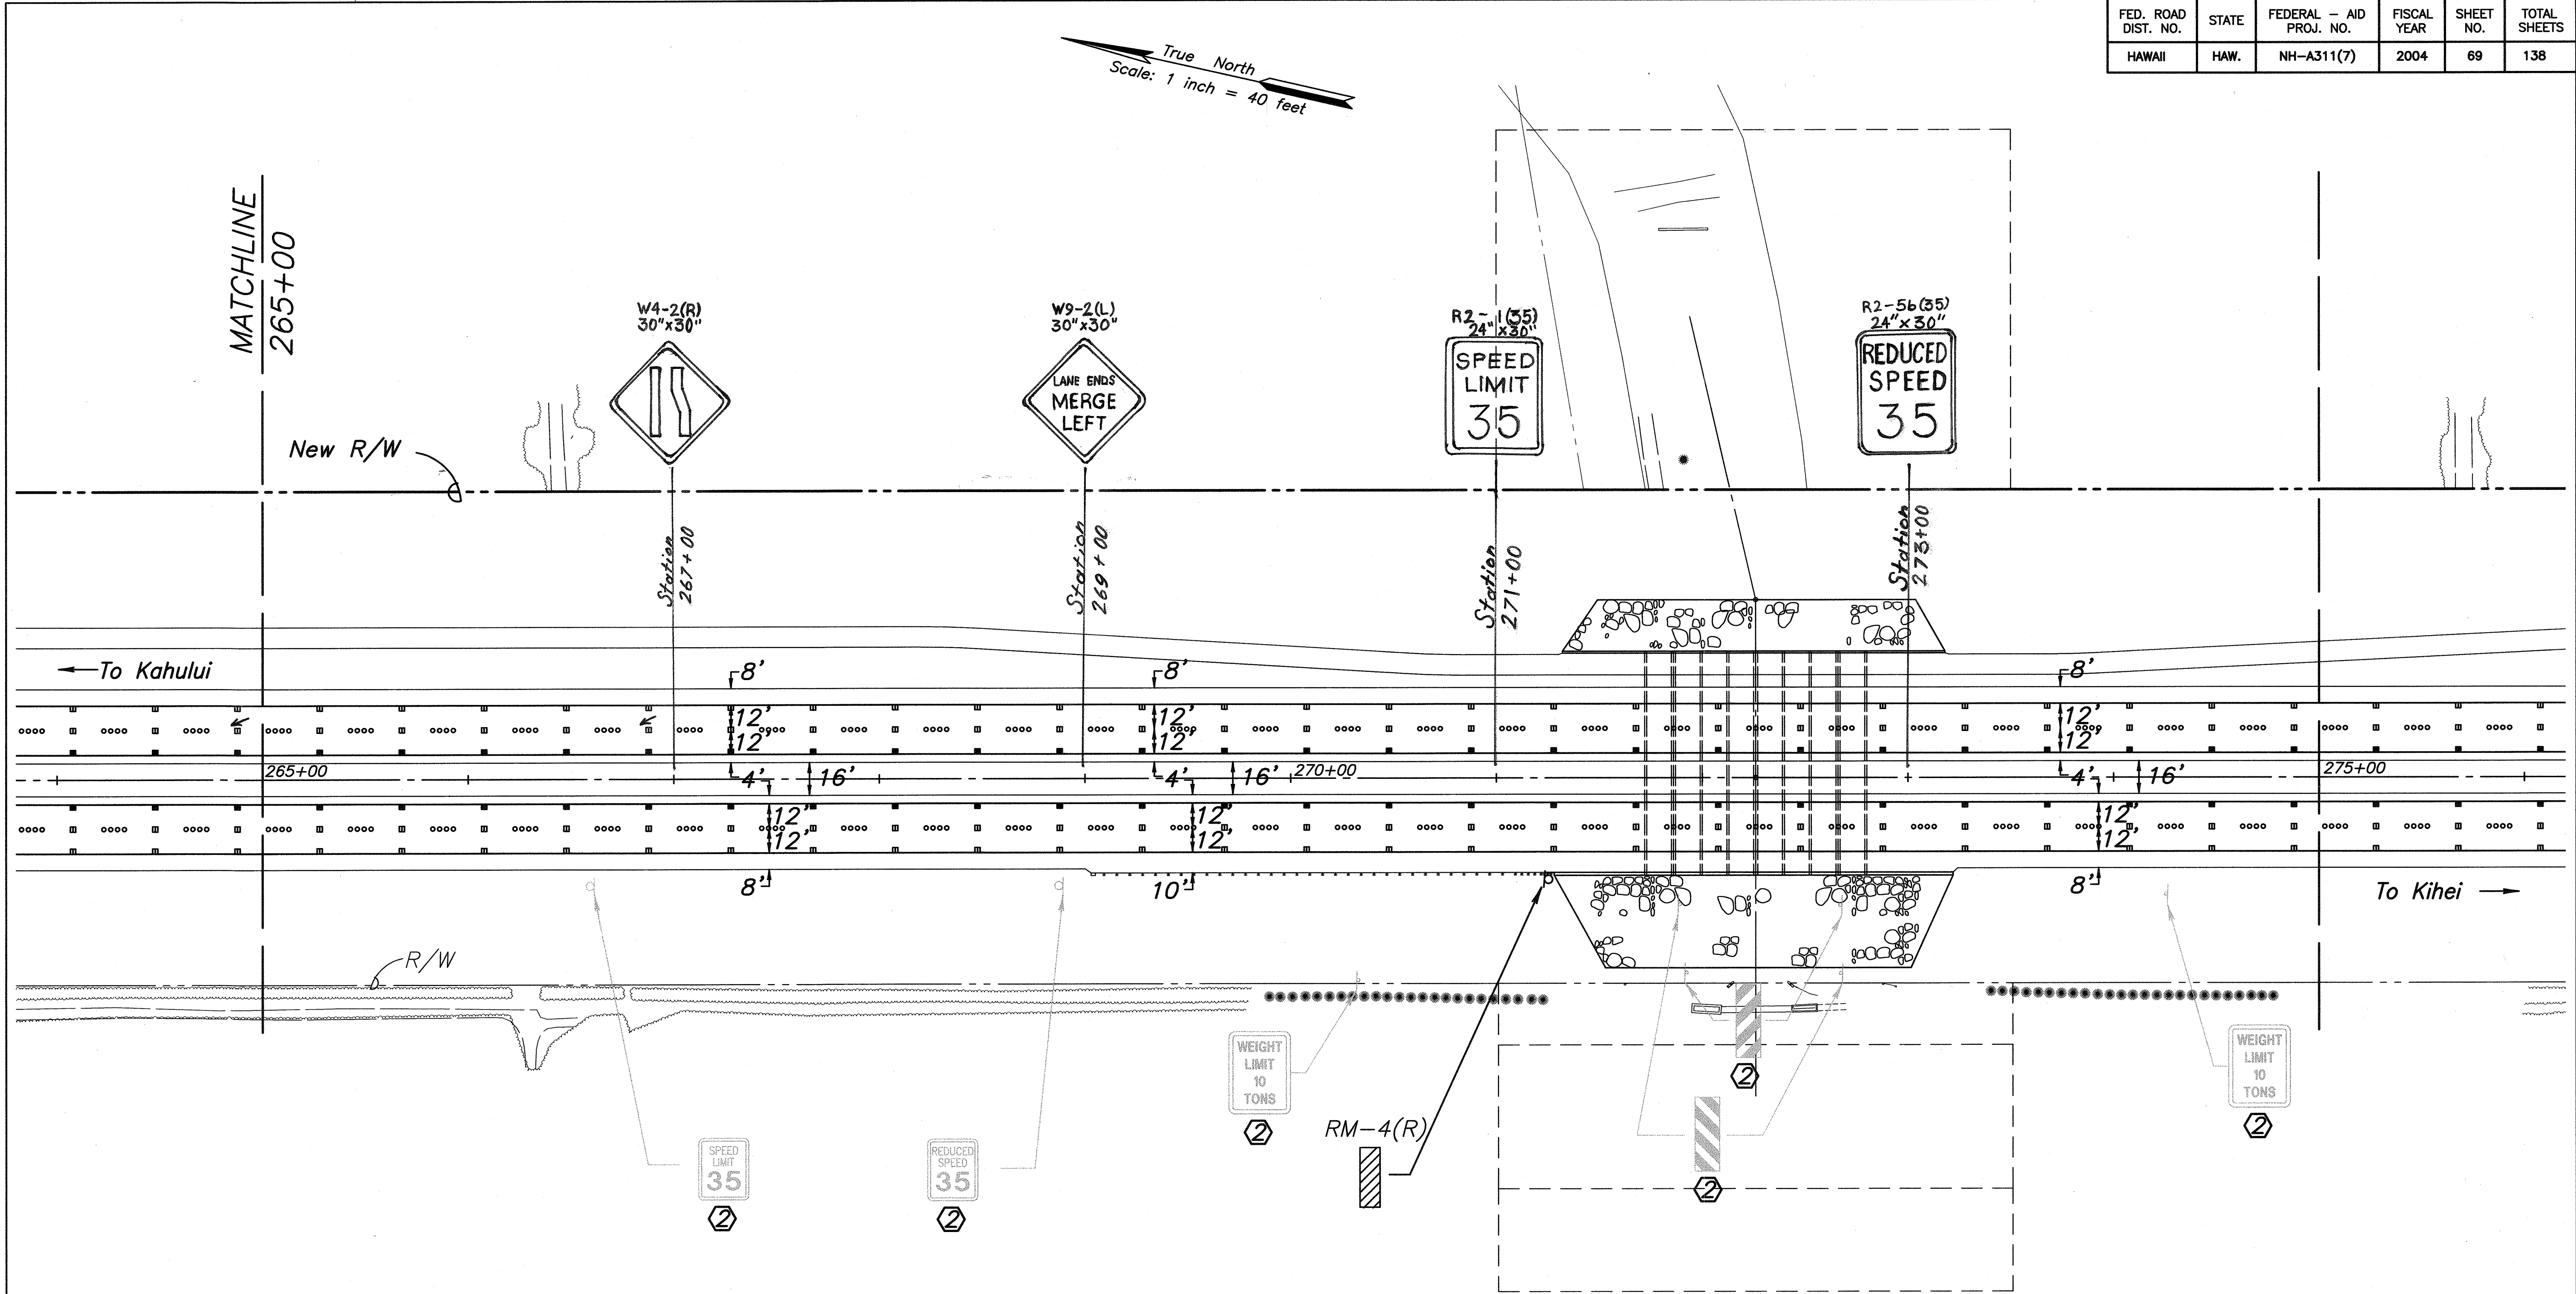


Notes:

Install New Sign(s) & Post(s) as shown unless otherwise specified (1)

- ① Existing sign(s) & post(s) to remain
- ② Remove existing sign(s) & post(s)
- ③ Remove existing & Install New Sign(s) & Post(s)
- ④ Relocate existing sign(s) & post(s)

Neatly bundle signs & posts to be removed and return to Highways Kahului Baseyard
For Details of Signs See Shts. 65

SURVEY PLOTTED BY	DATE
DRAWN BY	
DESIGNED BY	
NOTED BY	
CHECKED BY	
No.	

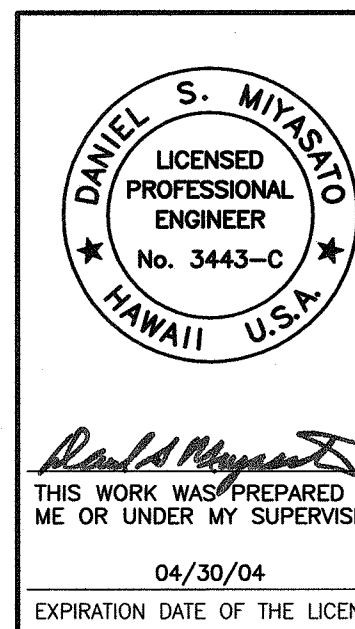

STATE OF HAWAII
DEPARTMENT OF TRANSPORTATION
HIGHWAYS DIVISION

STRIPING AND SIGNAGE PLAN

MOKULELE HIGHWAY WIDENING
Vicinity of Kolaloa Bridge
To
Vicinity of Kealia Pond Driveway
Federal - Aid Project No. NH-A311(7)
Scale: 1"=40' Date: August 2003


EXPIRATION DATE OF THE LICENSE 04/30/04

SHEET No. 2 OF 7 SHEETS

"AS-BUILT"

FED. ROAD DIST. NO.	STATE	FEDERAL - AID PROJ. NO.	FISCAL YEAR	SHEET NO.	TOTAL SHEETS
HAWAII	HAW.	NH-A311(7)	2004	70	138

True North
Scale: 1 inch = 40 feet

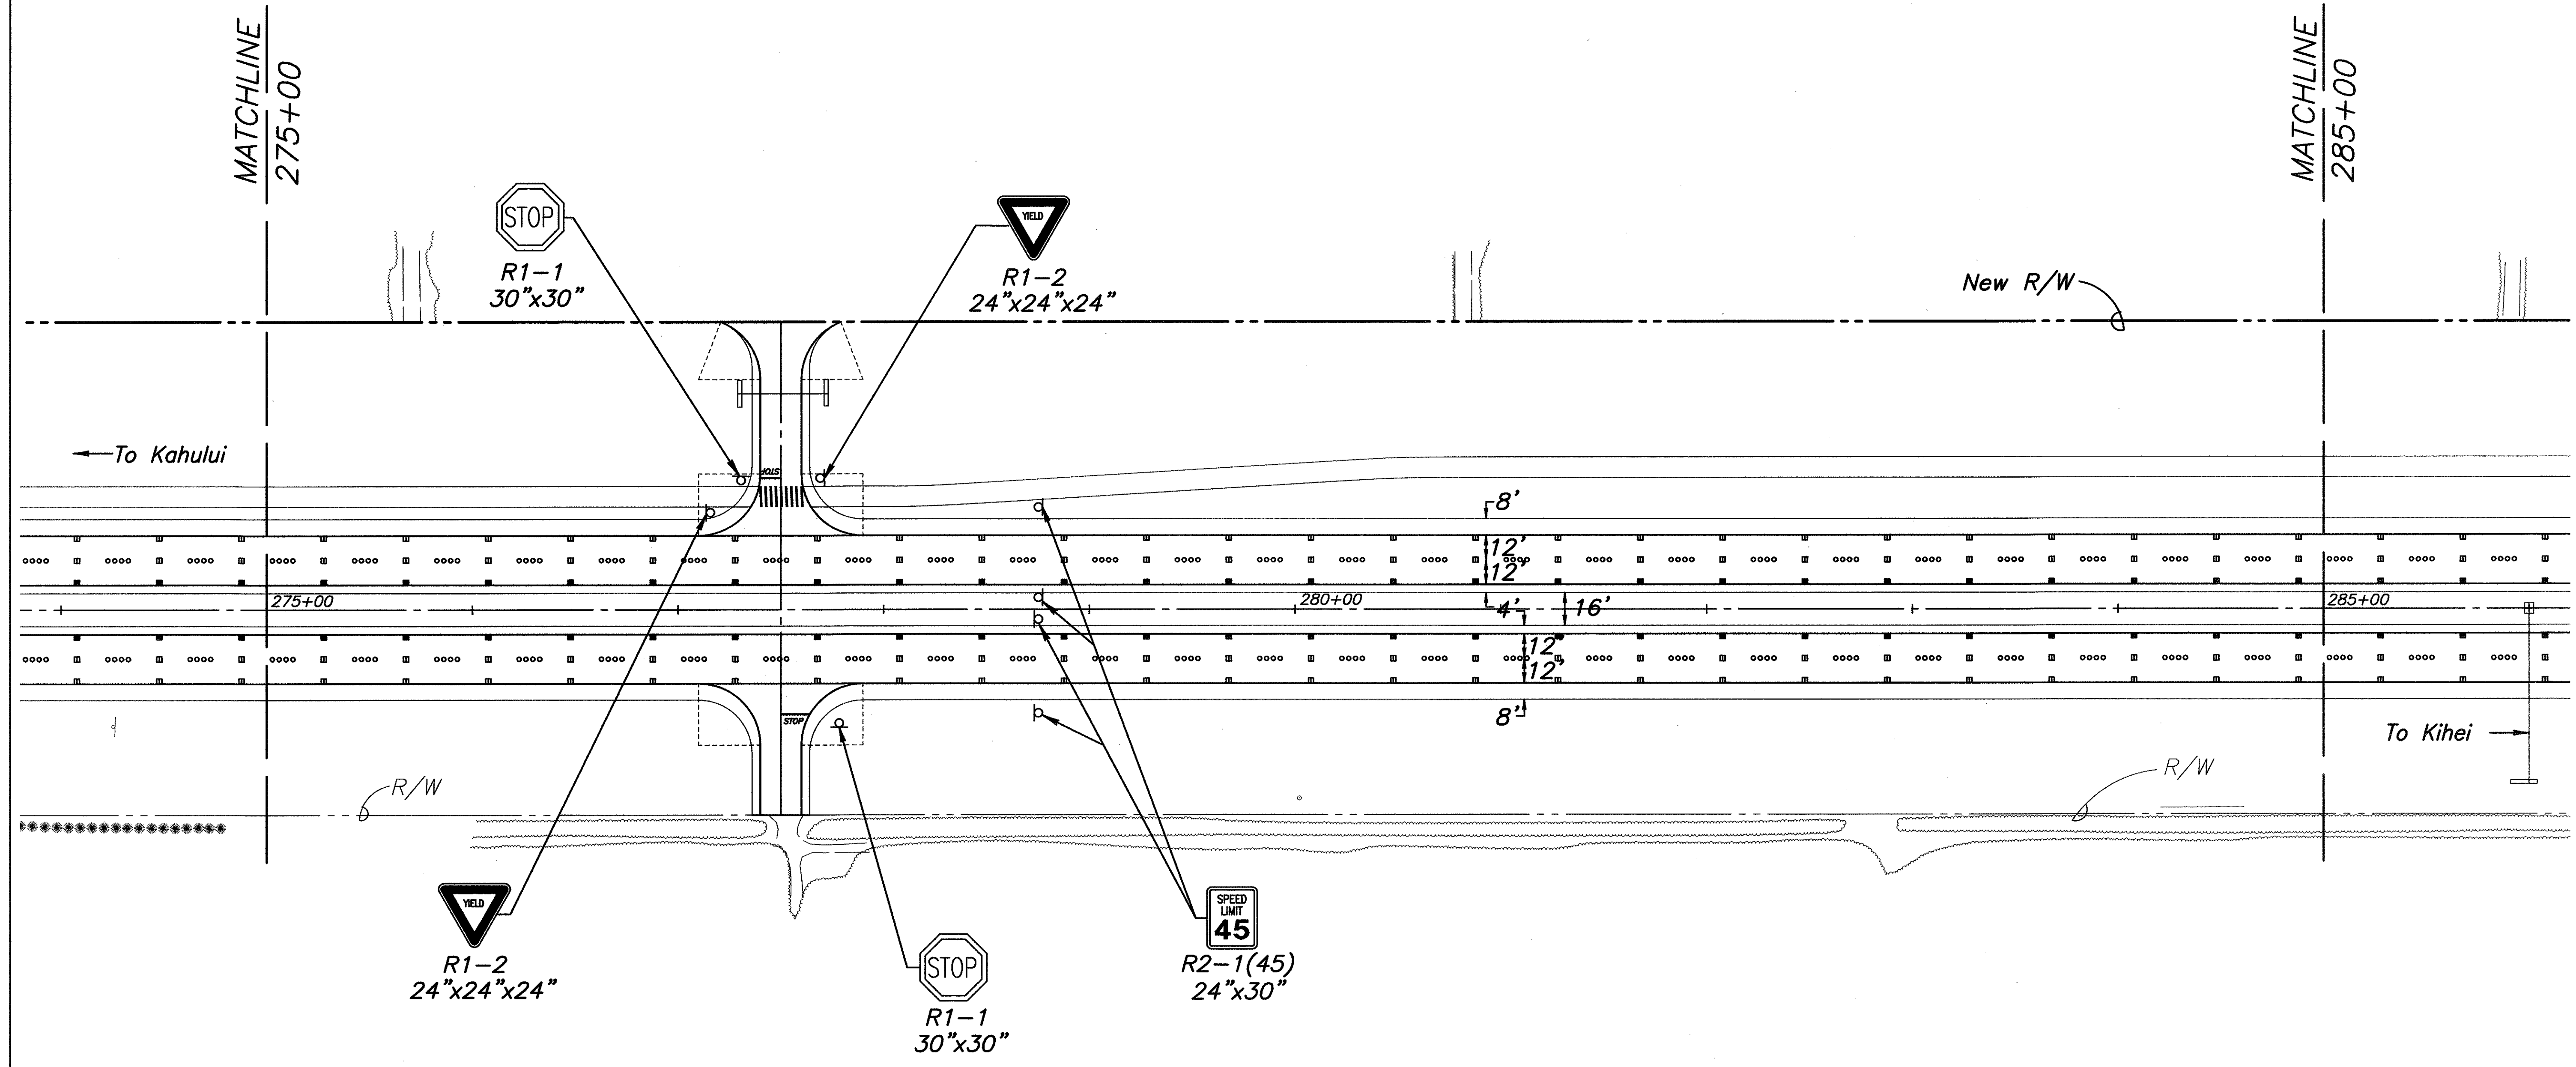

Notes:
Install New Sign(s) & Post(s) as shown unless otherwise specified (1)

- ① Existing sign(s) & post(s) to remain
- ② Remove existing sign(s) & post(s)
- ③ Remove existing & Install New Sign(s) & Post(s)
- ④ Relocate existing sign(s) & post(s)

Neatly bundle signs & posts to be removed and return to Highways Kahului Baseyard
For Details of Signs See Shts. 65

STATE OF HAWAII
DEPARTMENT OF TRANSPORTATION
HIGHWAYS DIVISION

STRIPING AND SIGNAGE PLAN

MOKULELE HIGHWAY WIDENING

Vicinity of Kealia Pond Driveway

Federal - Aid Project No. NH-A311(7)

Scale: 1"=40' Date: August 2003

SHEET No. 3 OF 7 SHEETS

THIS WORK WAS PREPARED BY
ME OR UNDER MY SUPERVISION


04/30/04
EXPIRATION DATE OF THE LICENSE

DANIEL S. MIYASATO
LICENSED PROFESSIONAL ENGINEER
No. 3443-C
HAWAII U.S.A.

ORIGINAL PLAN	SURVEY PLOTTED BY	DATE
NOTE BOOK	DRAWN BY	
	DESIGNED BY	
	CHECKED BY	
No.		

FED. ROAD DIST. NO.	STATE	FEDERAL - AID PROJ. NO.	FISCAL YEAR	SHEET NO.	TOTAL SHEETS
HAWAII	HAW.	NH-A311(7)	2004	71	138

True North
Scale: 1 inch = 40 feet

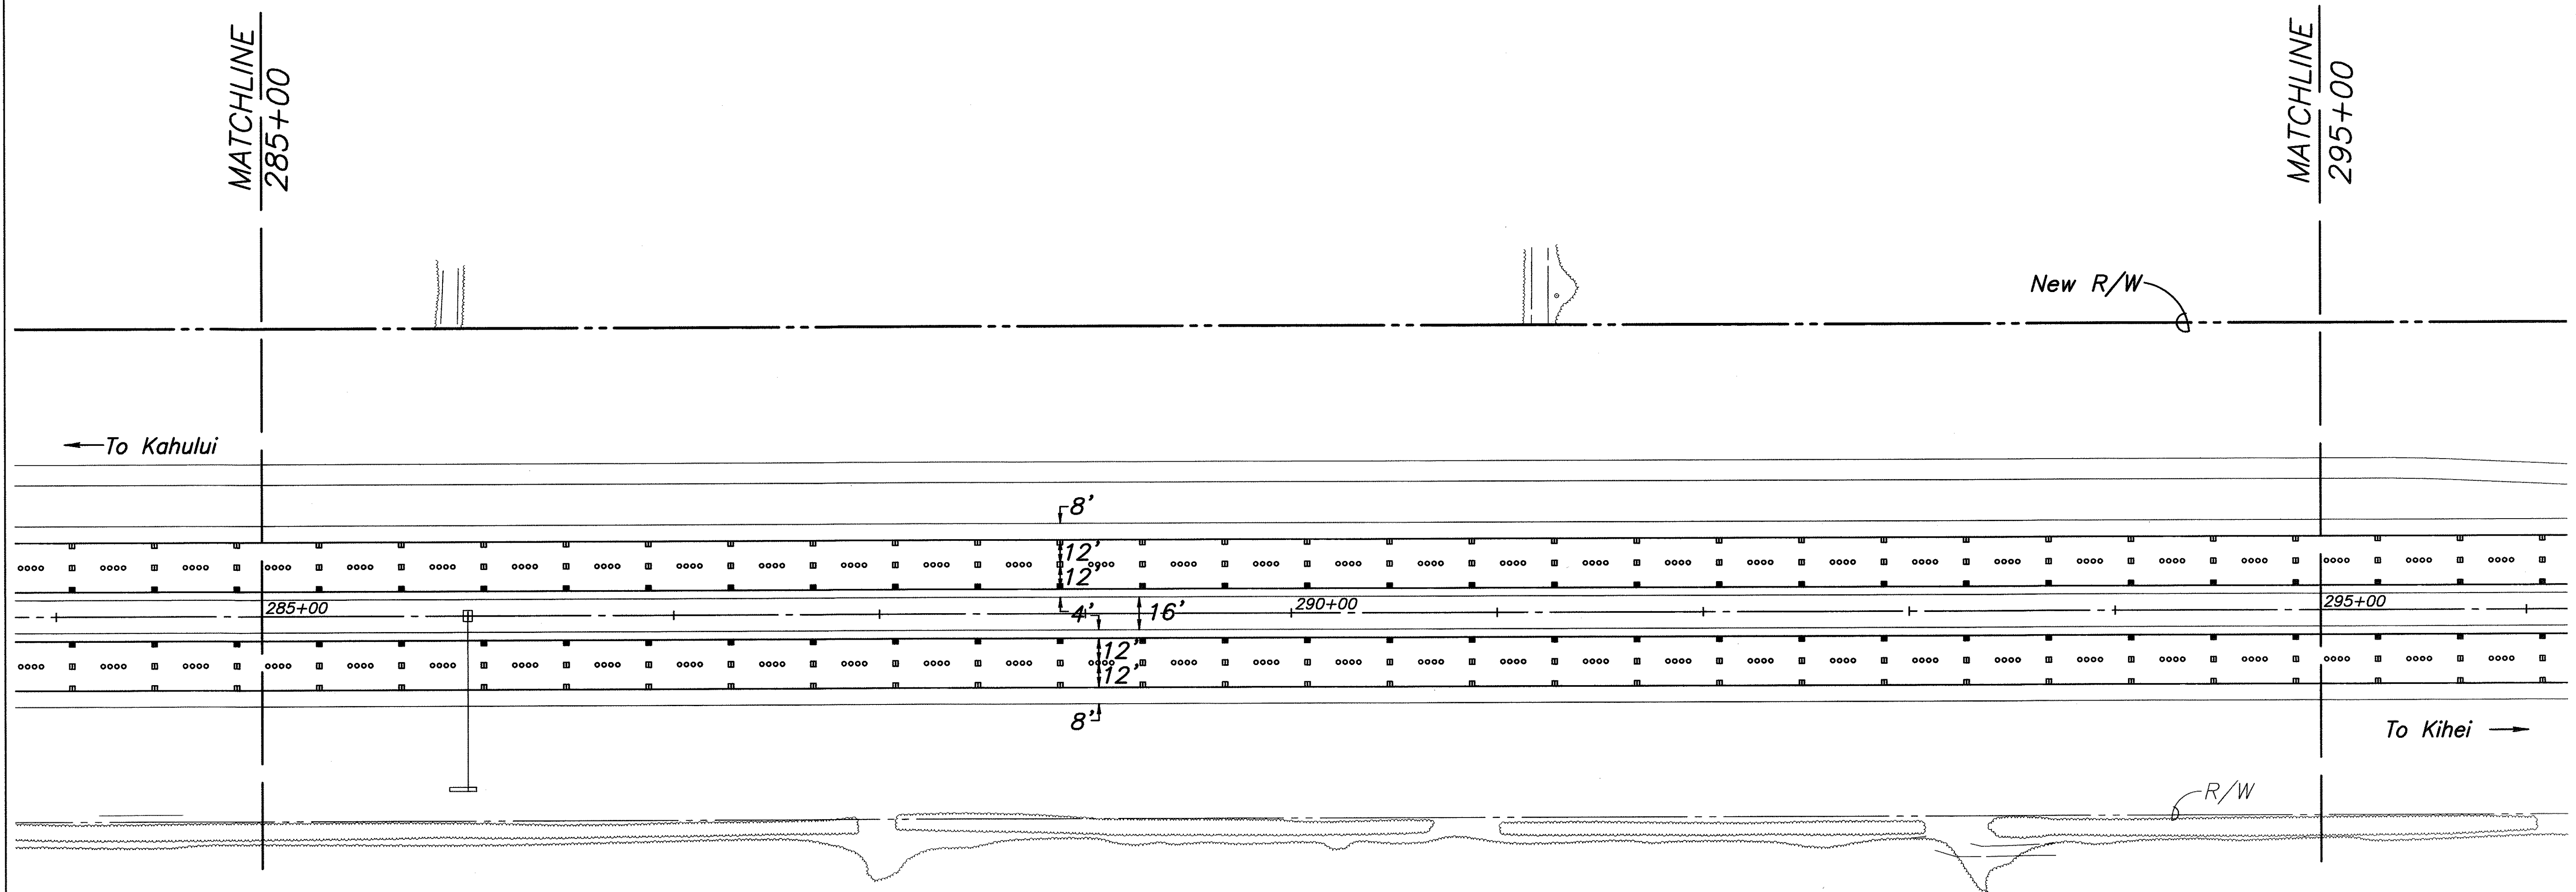


Notes:

Install New Sign(s) & Post(s) as shown unless otherwise specified (1)

- ① Existing sign(s) & post(s) to remain
- ② Remove existing sign(s) & post(s)
- ③ Remove existing & Install New Sign(s) & Post(s)
- ④ Relocate existing sign(s) & post(s)

Neatly bundle signs & posts to be removed and return to Highways Kahului Baseyard
For Details of Signs See Shts. 65

SURVEY PLOTTED BY	DATE
DRAWN BY	
DESIGNED BY	
NOTED BY	
CHECKED BY	
NO.	

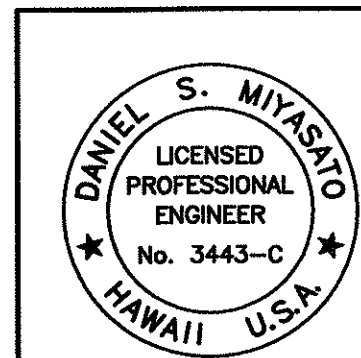

THIS WORK WAS PREPARED BY
ME OR UNDER MY SUPERVISION
04/30/04
EXPIRATION DATE OF THE LICENSE

STATE OF HAWAII
DEPARTMENT OF TRANSPORTATION
HIGHWAYS DIVISION

STRIPING AND SIGNAGE PLAN

MOKULELE HIGHWAY WIDENING
Vicinity of Kolaloa Bridge


To
Vicinity of Kealia Pond Driveway
Federal - Aid Project No. NH-A311(7)

Scale: 1"=40' Date: August 2003

SHEET No. 4 OF 7 SHEETS

True North

Scale:

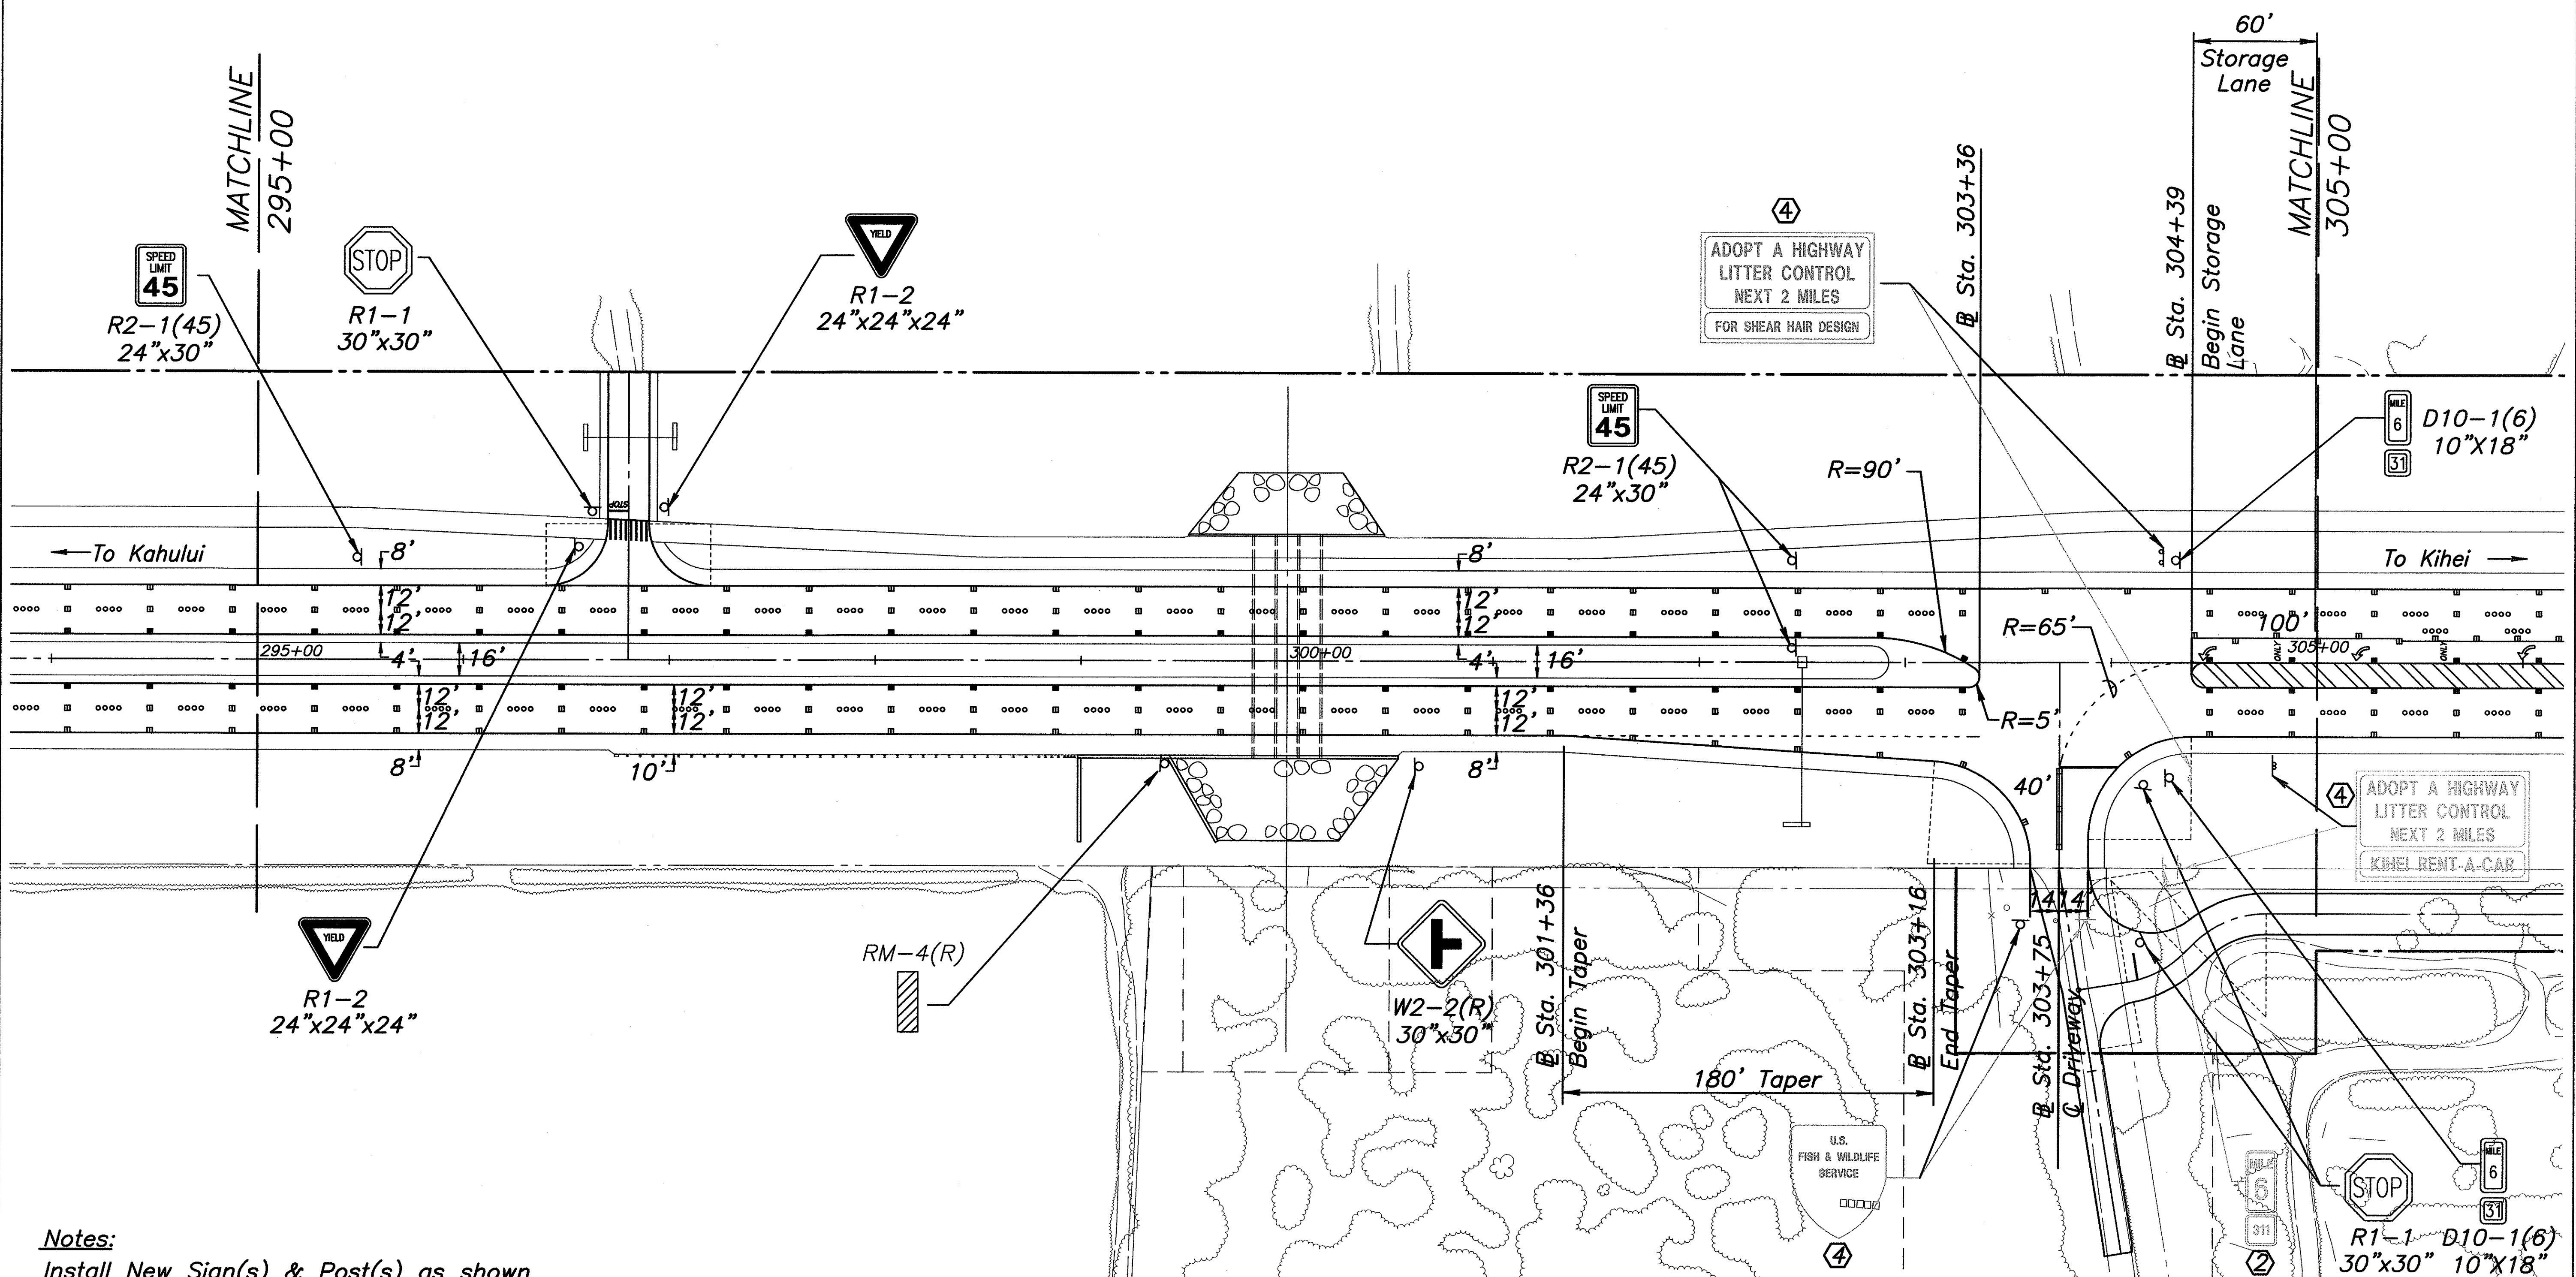

Notes:

Install New Sign(s) & Post(s) as shown unless otherwise specified (1)

- ① Existing sign(s) & post(s) to remain
- ② Remove existing sign(s) & post(s)
- ③ Remove existing & Install New Sign(s) & Post(s)
- ④ Relocate existing sign(s) & post(s)


*Neatly bundle signs & posts to be removed and
return to Highways Kahului Baseyard
For Details of Signs See Shts. 65*

ORIGINAL PLAN	SURVEY PLOTTED BY _____	DATE _____
NOTE BOOK	DRAWN BY _____	_____
	TRACED BY _____	_____
	DESIGNED BY _____	_____
	QUANTITIES BY _____	_____
	CHECKED BY _____	_____
No. _____		

  THIS WORK WAS PREPARED BY ME OR UNDER MY SUPERVISION 04/30/04 EXPIRATION DATE OF THE LICENSE	STATE OF HAWAII DEPARTMENT OF TRANSPORTATION HIGHWAYS DIVISION <u>STRIPING AND SIGNAGE PLAN</u> <u>MOKULELE HIGHWAY WIDENING</u> <u>Vicinity of Kolaloa Bridge</u> To <u>Vicinity of Kealia Pond Driveway</u> <u>Federal - Aid Project No. NH-A311(7)</u> Scale: 1"=40' Date: August 2003 SHEET No. 5 OF 7 SHEETS
---	--

FED. ROAD DIST. NO.	STATE	FEDERAL - AID PROJ. NO.	FISCAL YEAR	SHEET NO.	TOTAL SHEETS
HAWAII	HAW.	NH-A311(7)	2004	73	138

True North
Scale: 1 inch = 40 feet

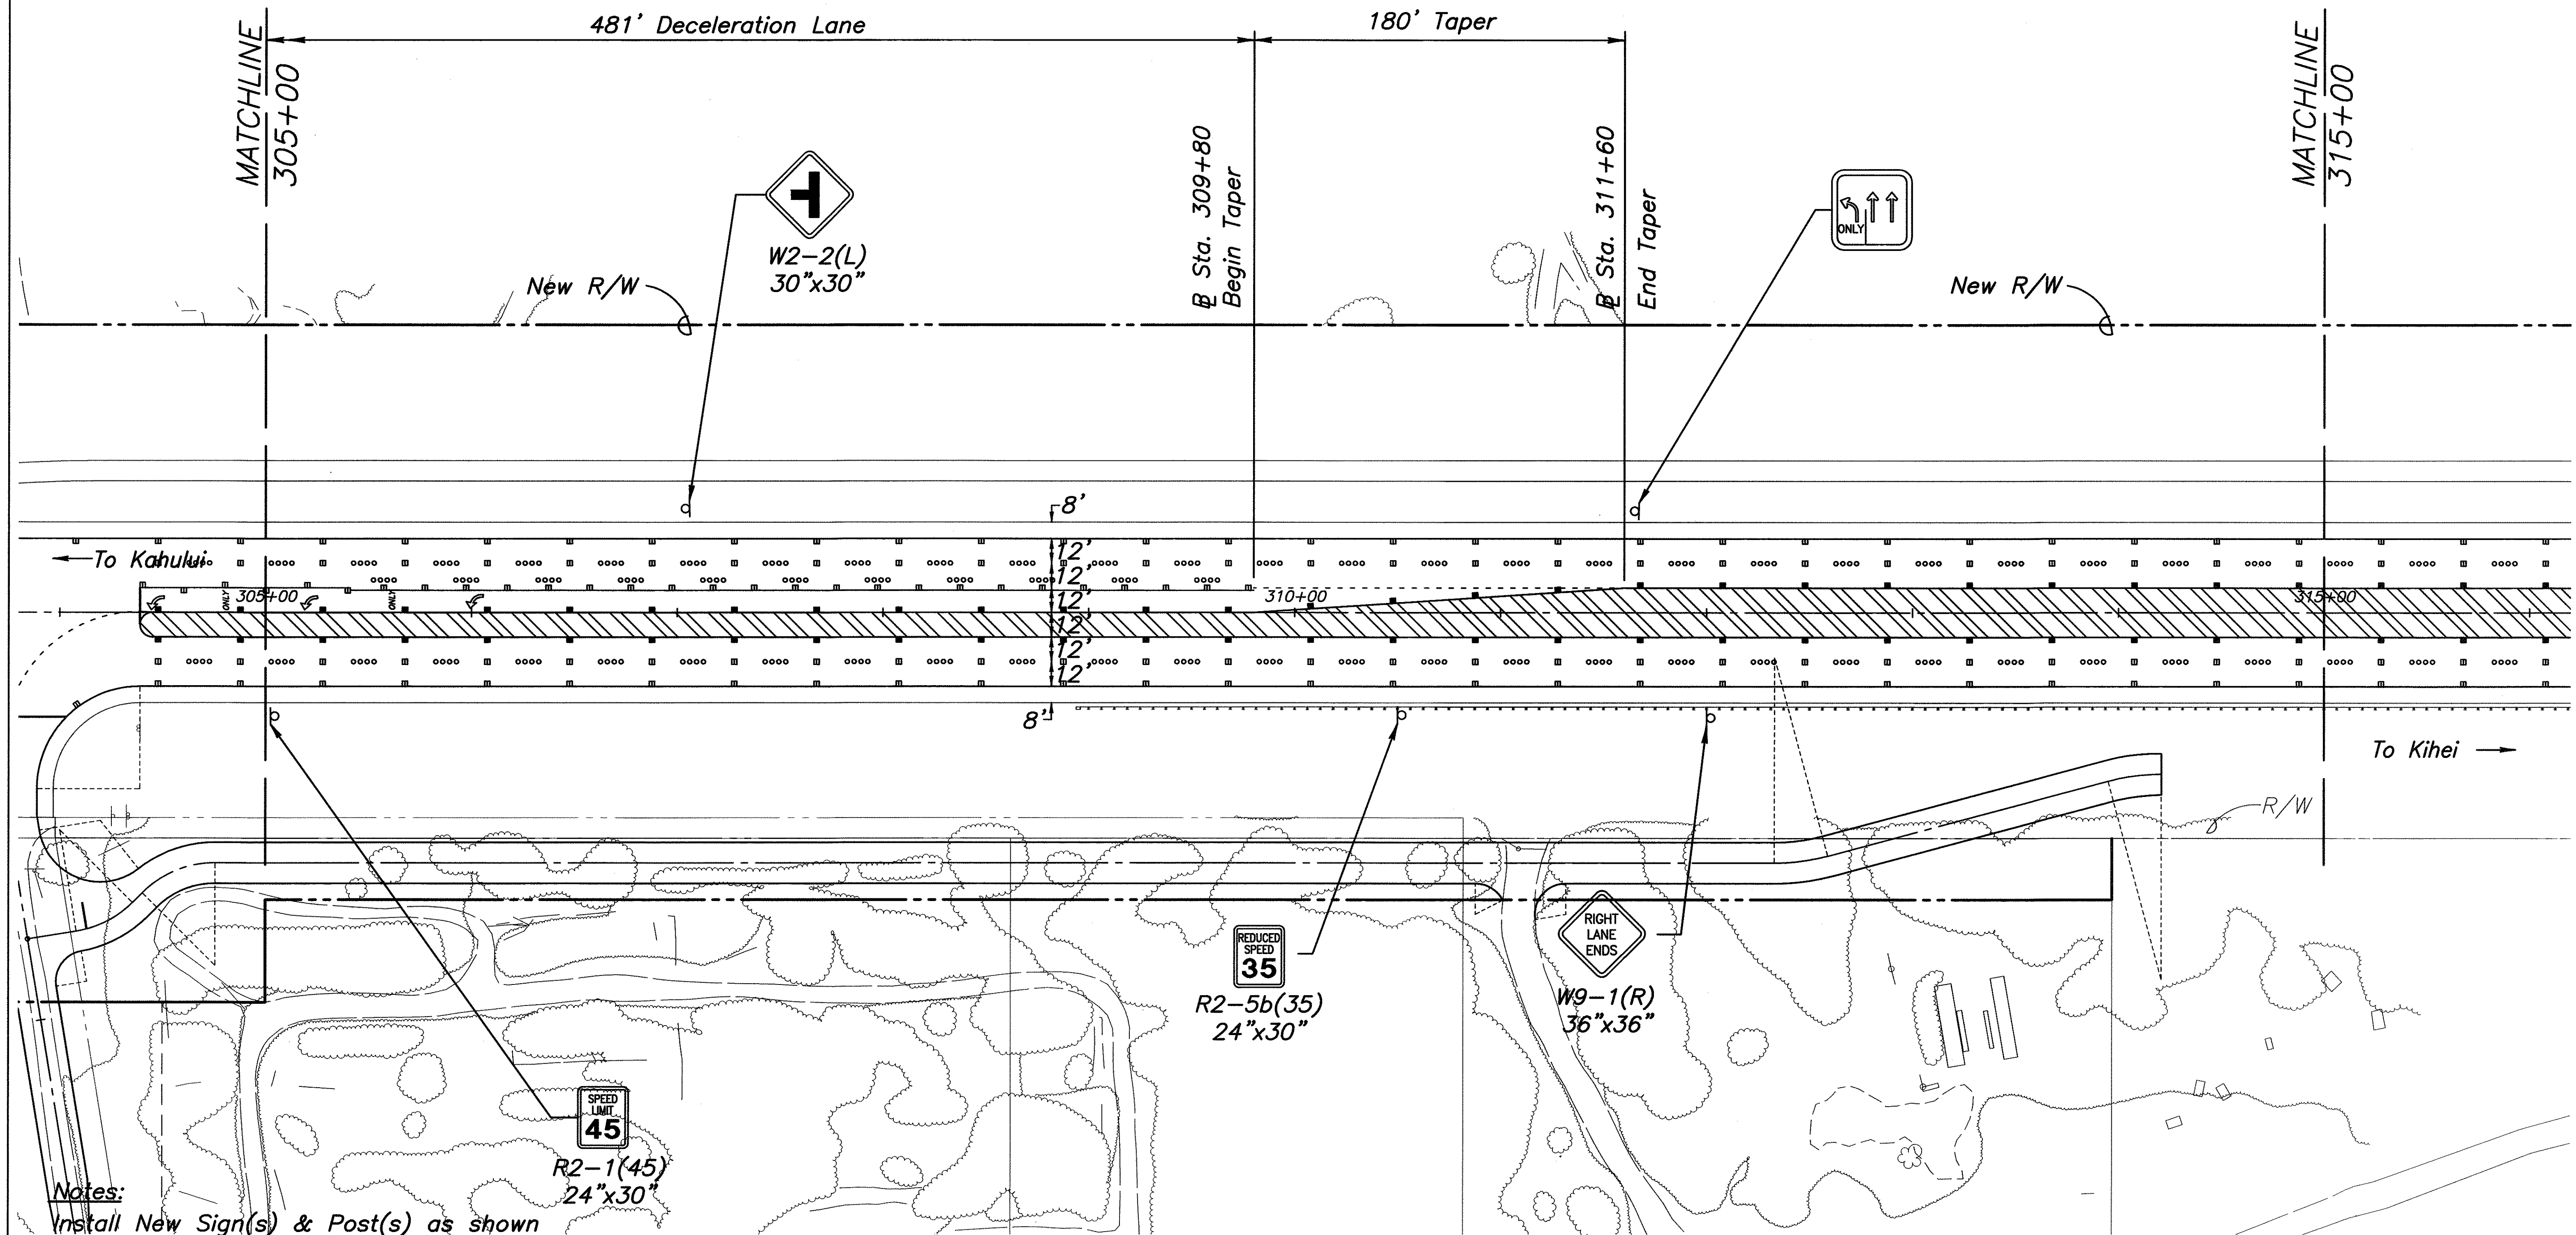

Notes:
Install New Sign(s) & Post(s) as shown unless otherwise specified (1)

- ① Existing sign(s) & post(s) to remain
- ② Remove existing sign(s) & post(s)
- ③ Remove existing & Install New Sign(s) & Post(s)
- ④ Relocate existing sign(s) & post(s)

Neatly bundle signs & posts to be removed and return to Highways Kahului Baseyard
For Details of Signs See Shts. 65

ORIGINAL PLAN	SURVEY PLOTTED BY	DATE
NOTE BOOK	DRAWN BY	
	DESIGNED BY	
	CHECKED BY	
	NO.	

DANIEL S. MIYASATO
LICENSED PROFESSIONAL ENGINEER
No. 3443-C
HAWAII U.S.A.

THIS WORK WAS PREPARED BY ME OR UNDER MY SUPERVISION
04/30/04
EXPIRATION DATE OF THE LICENSE

STATE OF HAWAII
DEPARTMENT OF TRANSPORTATION
HIGHWAYS DIVISION

STRIPING AND SIGNAGE PLAN

MOKULELE HIGHWAY WIDENING

Vicinity of Kolaloa Bridge
To
Vicinity of Kealia Pond Driveway
Federal - Aid Project No. NH-A311(7)
Scale: 1"=40' Date: August 2003


SHEET No. 6 OF 7 SHEETS

FED. ROAD DIST. NO.	STATE	FEDERAL — AID PROJ. NO.	FISCAL YEAR	SHEET NO.	TOTAL SHEETS
HAWAII	HAW.	NH-A311(7)	2004	74	138

True North
Scale: 1 inch = 40 feet

MATCHLINE
315+00

edge cane field

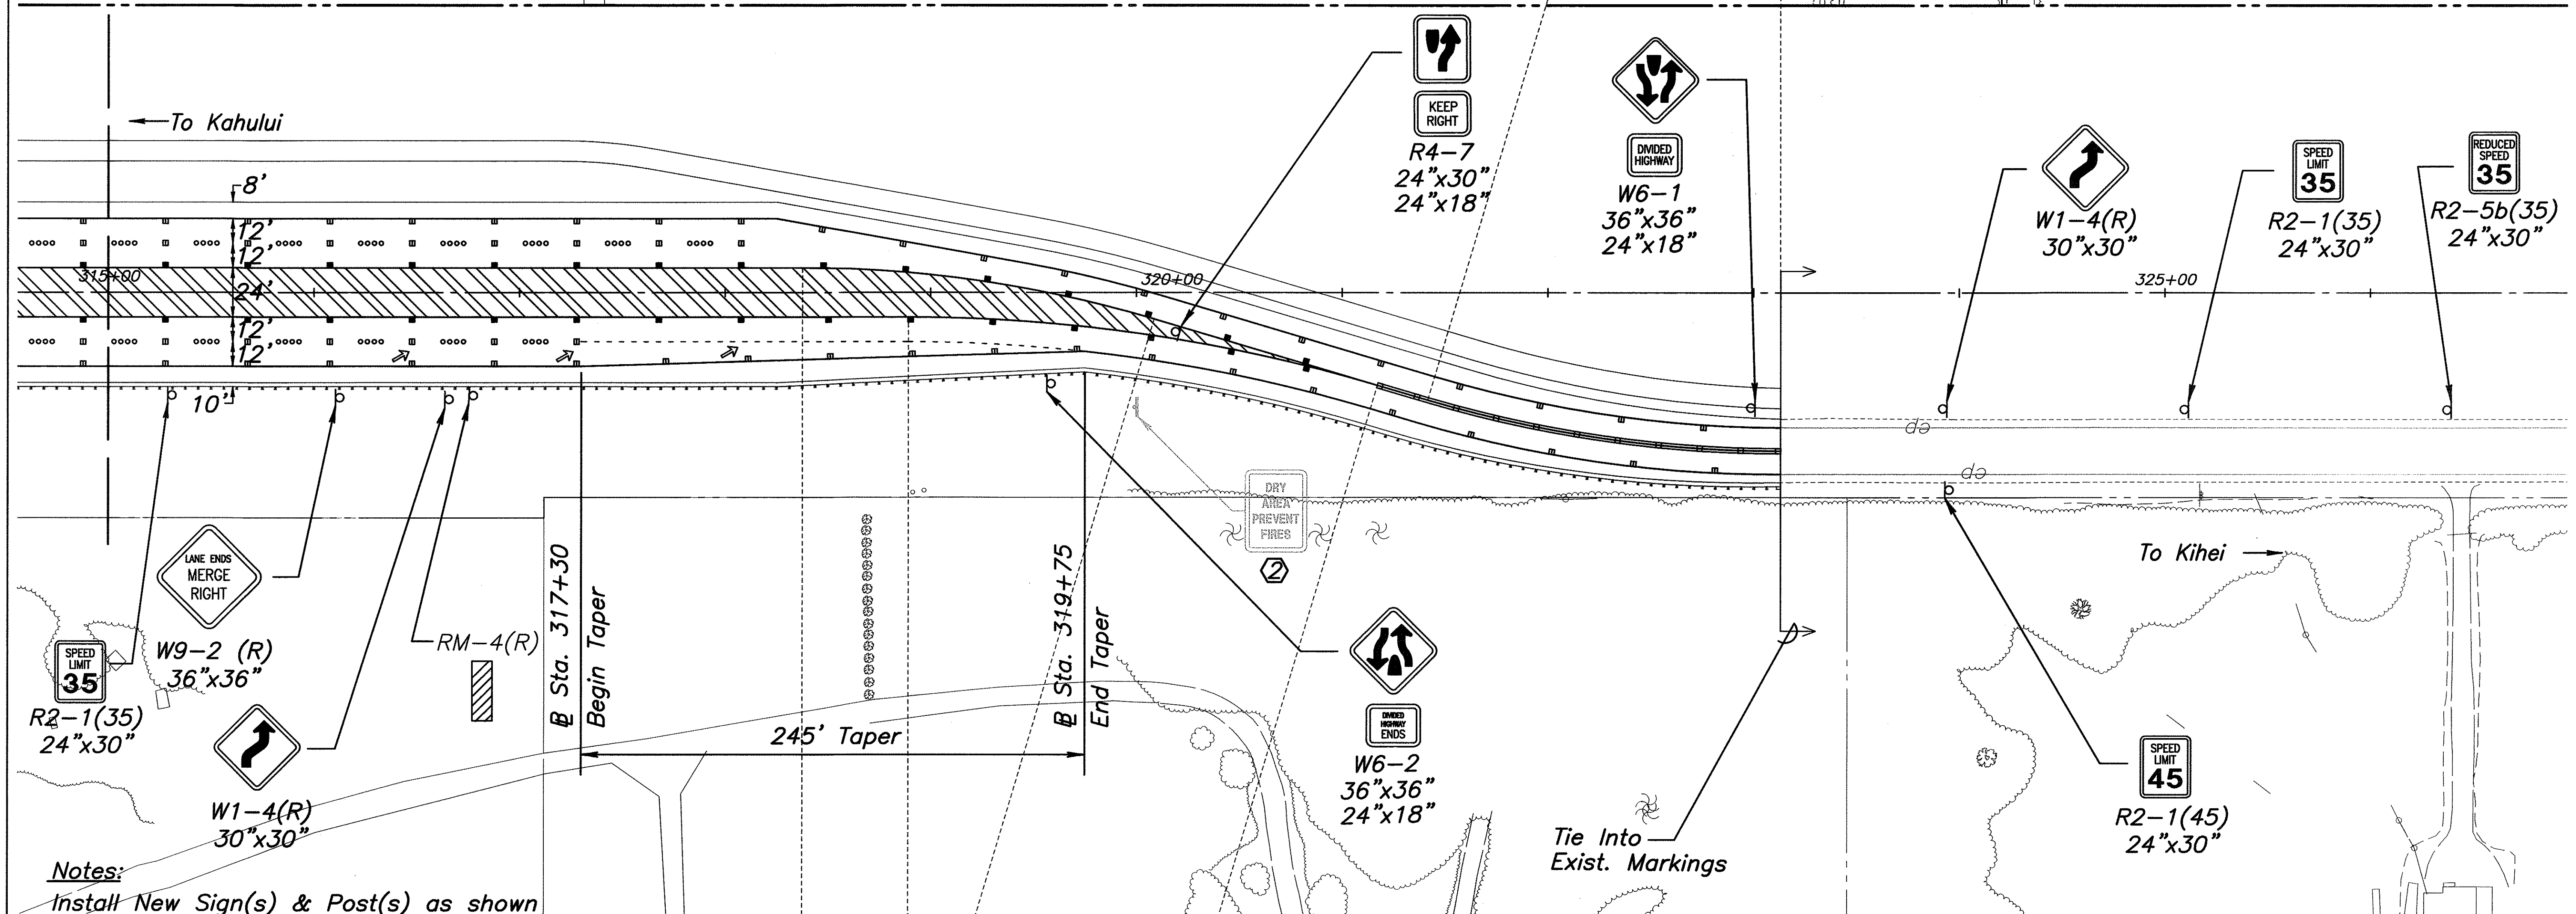


Notes:

Install New Sign(s) & Post(s) as shown unless otherwise specified (1)

- ① Existing sign(s) & post(s) to remain
- ② Remove existing sign(s) & post(s)
- ③ Remove existing & Install New Sign(s) & Post(s)
- ④ Relocate existing sign(s) & post(s)

*Neatly bundle signs & posts to be removed and
return to Highways Kahului Baseyard
For Details of Signs See Shts. 65*

ORIGINAL PLAN	SURVEY PLOTTED BY _____	DATE _____
NOTE BOOK	DRAWN BY _____	_____
	TRACED BY _____	_____
	DESIGNED BY _____	_____
	QUANTITIES BY _____	_____
No. _____	CHECKED BY _____	_____

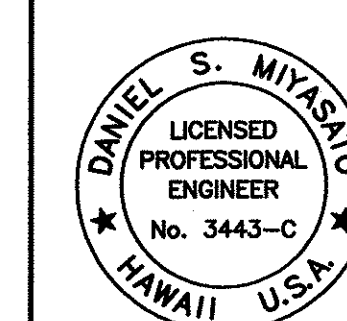

THIS WORK WAS PREPARED BY
ME OR UNDER MY SUPERVISION

04/30/04

EXPIRATION DATE OF THE LICENSE

STATE OF HAWAII
DEPARTMENT OF TRANSPORTATION
HIGHWAYS DIVISION

STRIPING AND SIGNAGE PLAN

MOKULELE HIGHWAY WIDENING

Vicinity of Kolaloa Bridge

To
Vicinity of Kealia Pond Driveway

Federal - Aid Project No. NH-A311(7)

Scale: 1"=40' Date: August 2003

SHEET No. 7 OF 7 SHEETS