
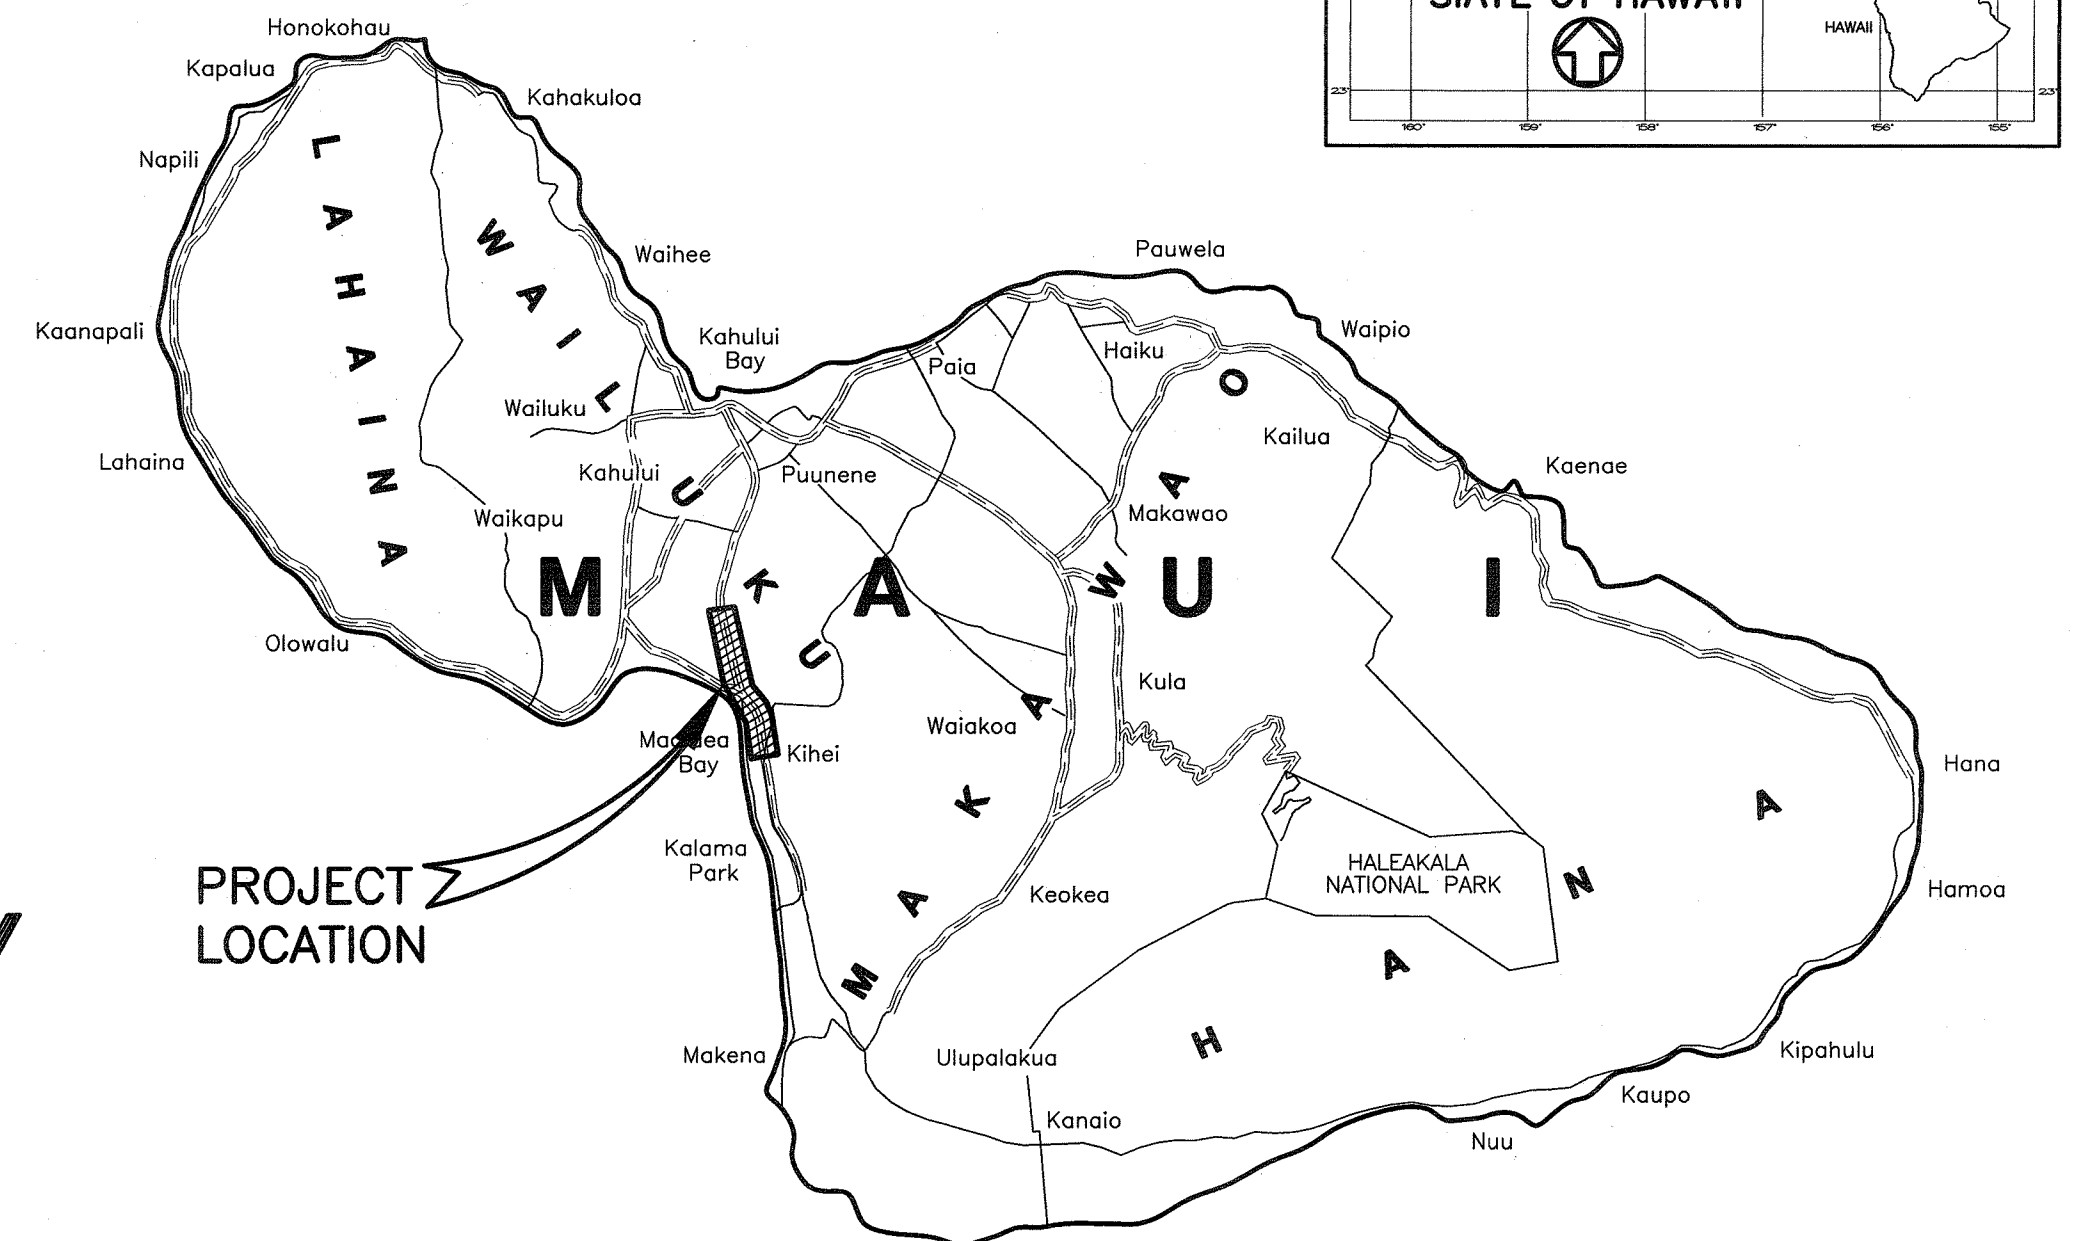


INDEX TO DRAWINGS	
SHEET NO.	DESCRIPTION
1	TITLE SHEET
2	STANDARD PLANS SUMMARY
3-5	CONSTRUCTION NOTES & LEGEND
6-8	TYPICAL ROAD SECTION
9-13	GUARDRAIL DETAILS
14-20	DEMOLITION PLAN
21-28	DETAIL PLAN OF ROADWAY
29-31	PLAN AND PROFILE
32	DRIVEWAY PROFILE
33-39	UTILITY PLAN
40-41	WATERLINES C AND D
42-43	WATERLINE E
44	WATERLINE F
45-47	WATER DETAILS
48-54	GRADING AND DRAINAGE PLAN
55	DRAINLINE PROFILE
56	DRAINAGE SUMMARY
57-60	MISCELLANEOUS DETAILS
61-62	CULVERT DETAILS
63	INTERSECTION PLAN
64-65	BORING LOGS
66-67	PAVEMENT MARKINGS & LEGEND
68-74	STRIPING AND SIGNAGE PLAN
75-76	STRIPING AND SIGNAGE SUMMARY
77-84	CONSTRUCTION PHASING PLAN
85-98	CROSS SECTIONS
99-119	STRUCTURAL PLANS
120-130	LANDSCAPE PLANS
131-138	OFFSITE WATERLINE IMPROVEMENTS

STATE OF HAWAII
DEPARTMENT OF TRANSPORTATION
HIGHWAYS DIVISION
HONOLULU, HAWAII
"AS-BUILT"
PLANS FOR
MOKULELE HIGHWAY WIDENING
VICINITY OF
KOLALOA BRIDGE
TO
VICINITY OF KEALIA POND DRIVEWAY
FEDERAL-AID PROJECT NO. NH-A311(7)

DISTRICT OF WAILUKU
ISLAND OF MAUI

FED. ROAD DIST. NO.	STATE	FEDERAL - AID PROJ. NO.	FISCAL YEAR	SHEET NO.	TOTAL SHEETS
HAWAII	HAW.	NH-A311(7)	2004	1	138

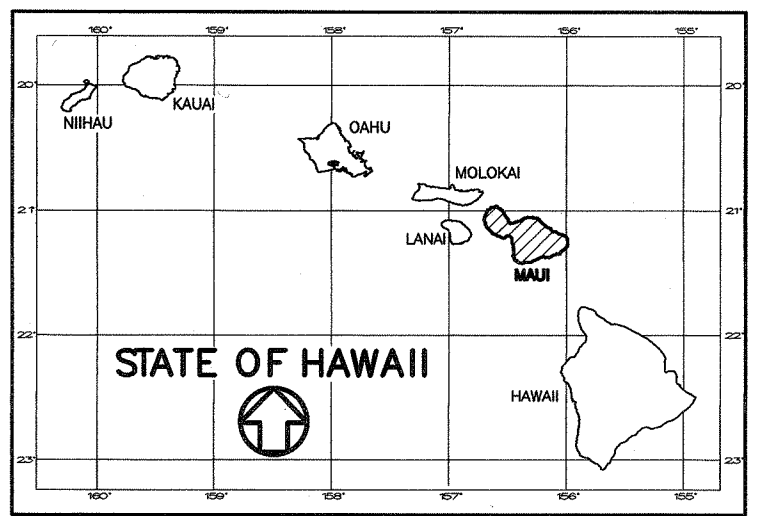


ISLAND OF MAUI



FEDERAL AID PROJECTS PREVIOUSLY CONSTRUCTED OR UNDER CONSTRUCTION


PUUNENE AVENUE/MOKULELE HIGHWAY MILE POST 5.25 TO MILE POST 6.25

DESIGN	DESIGNATION
	MOKULELE HWY.
ADT(2000)	25,000
ADT(2020)	40,650
DHV	3,250
K _{DES}	8%
D	52/48
T _{DES}	3.2%
T ₂₄	2.4%
V	55 MPH

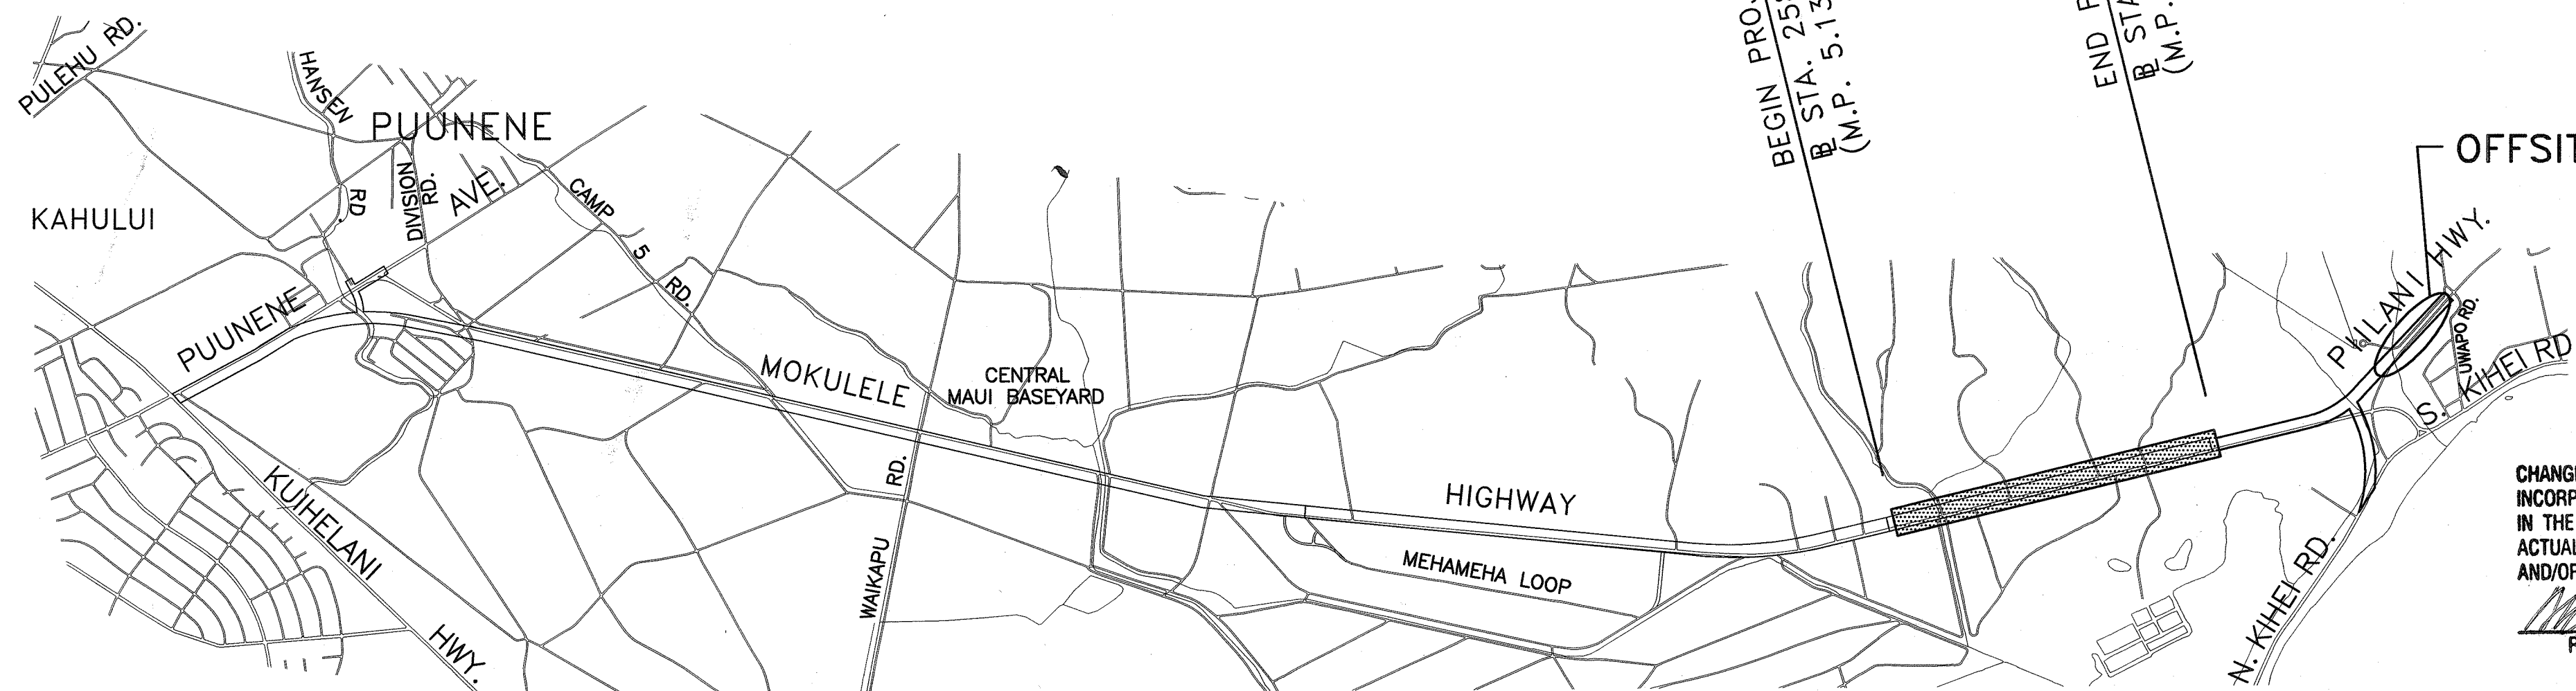

CHANGES MADE DURING CONSTRUCTION HAVE BEEN INCORPORATED ON THESE PLANS EXCEPT CHANGES IN THE ORIGINAL THEORETICAL QUANTITIES. FOR ACTUAL QUANTITIES, REFER TO PROJECT LEDGER AND/OR COMPUTATION BOOK.

RESIDENT ENGINEER
DATE 3-27-2011

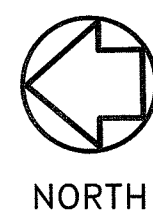

LAYOUT PLAN

GROSS LENGTH OF PROJECT 1.22 MILES
NET LENGTH OF PROJECT 1.22 MILES

DIRECTOR, DEPARTMENT OF WATER SUPPLY
COUNTY OF MAUI

9/5/03
DATE

DEPARTMENT OF TRANSPORTATION
STATE OF HAWAII
APPROVED:
DIR. OF TRANSPORTATION
DATE 11-13-03