


FED. ROAD DIST. NO.	STATE	FEDERAL - AID PROJ. NO.	FISCAL YEAR	SHEET NO.	TOTAL SHEETS
HAWAII	HAW.	NH-A311(7)	2004	42	138

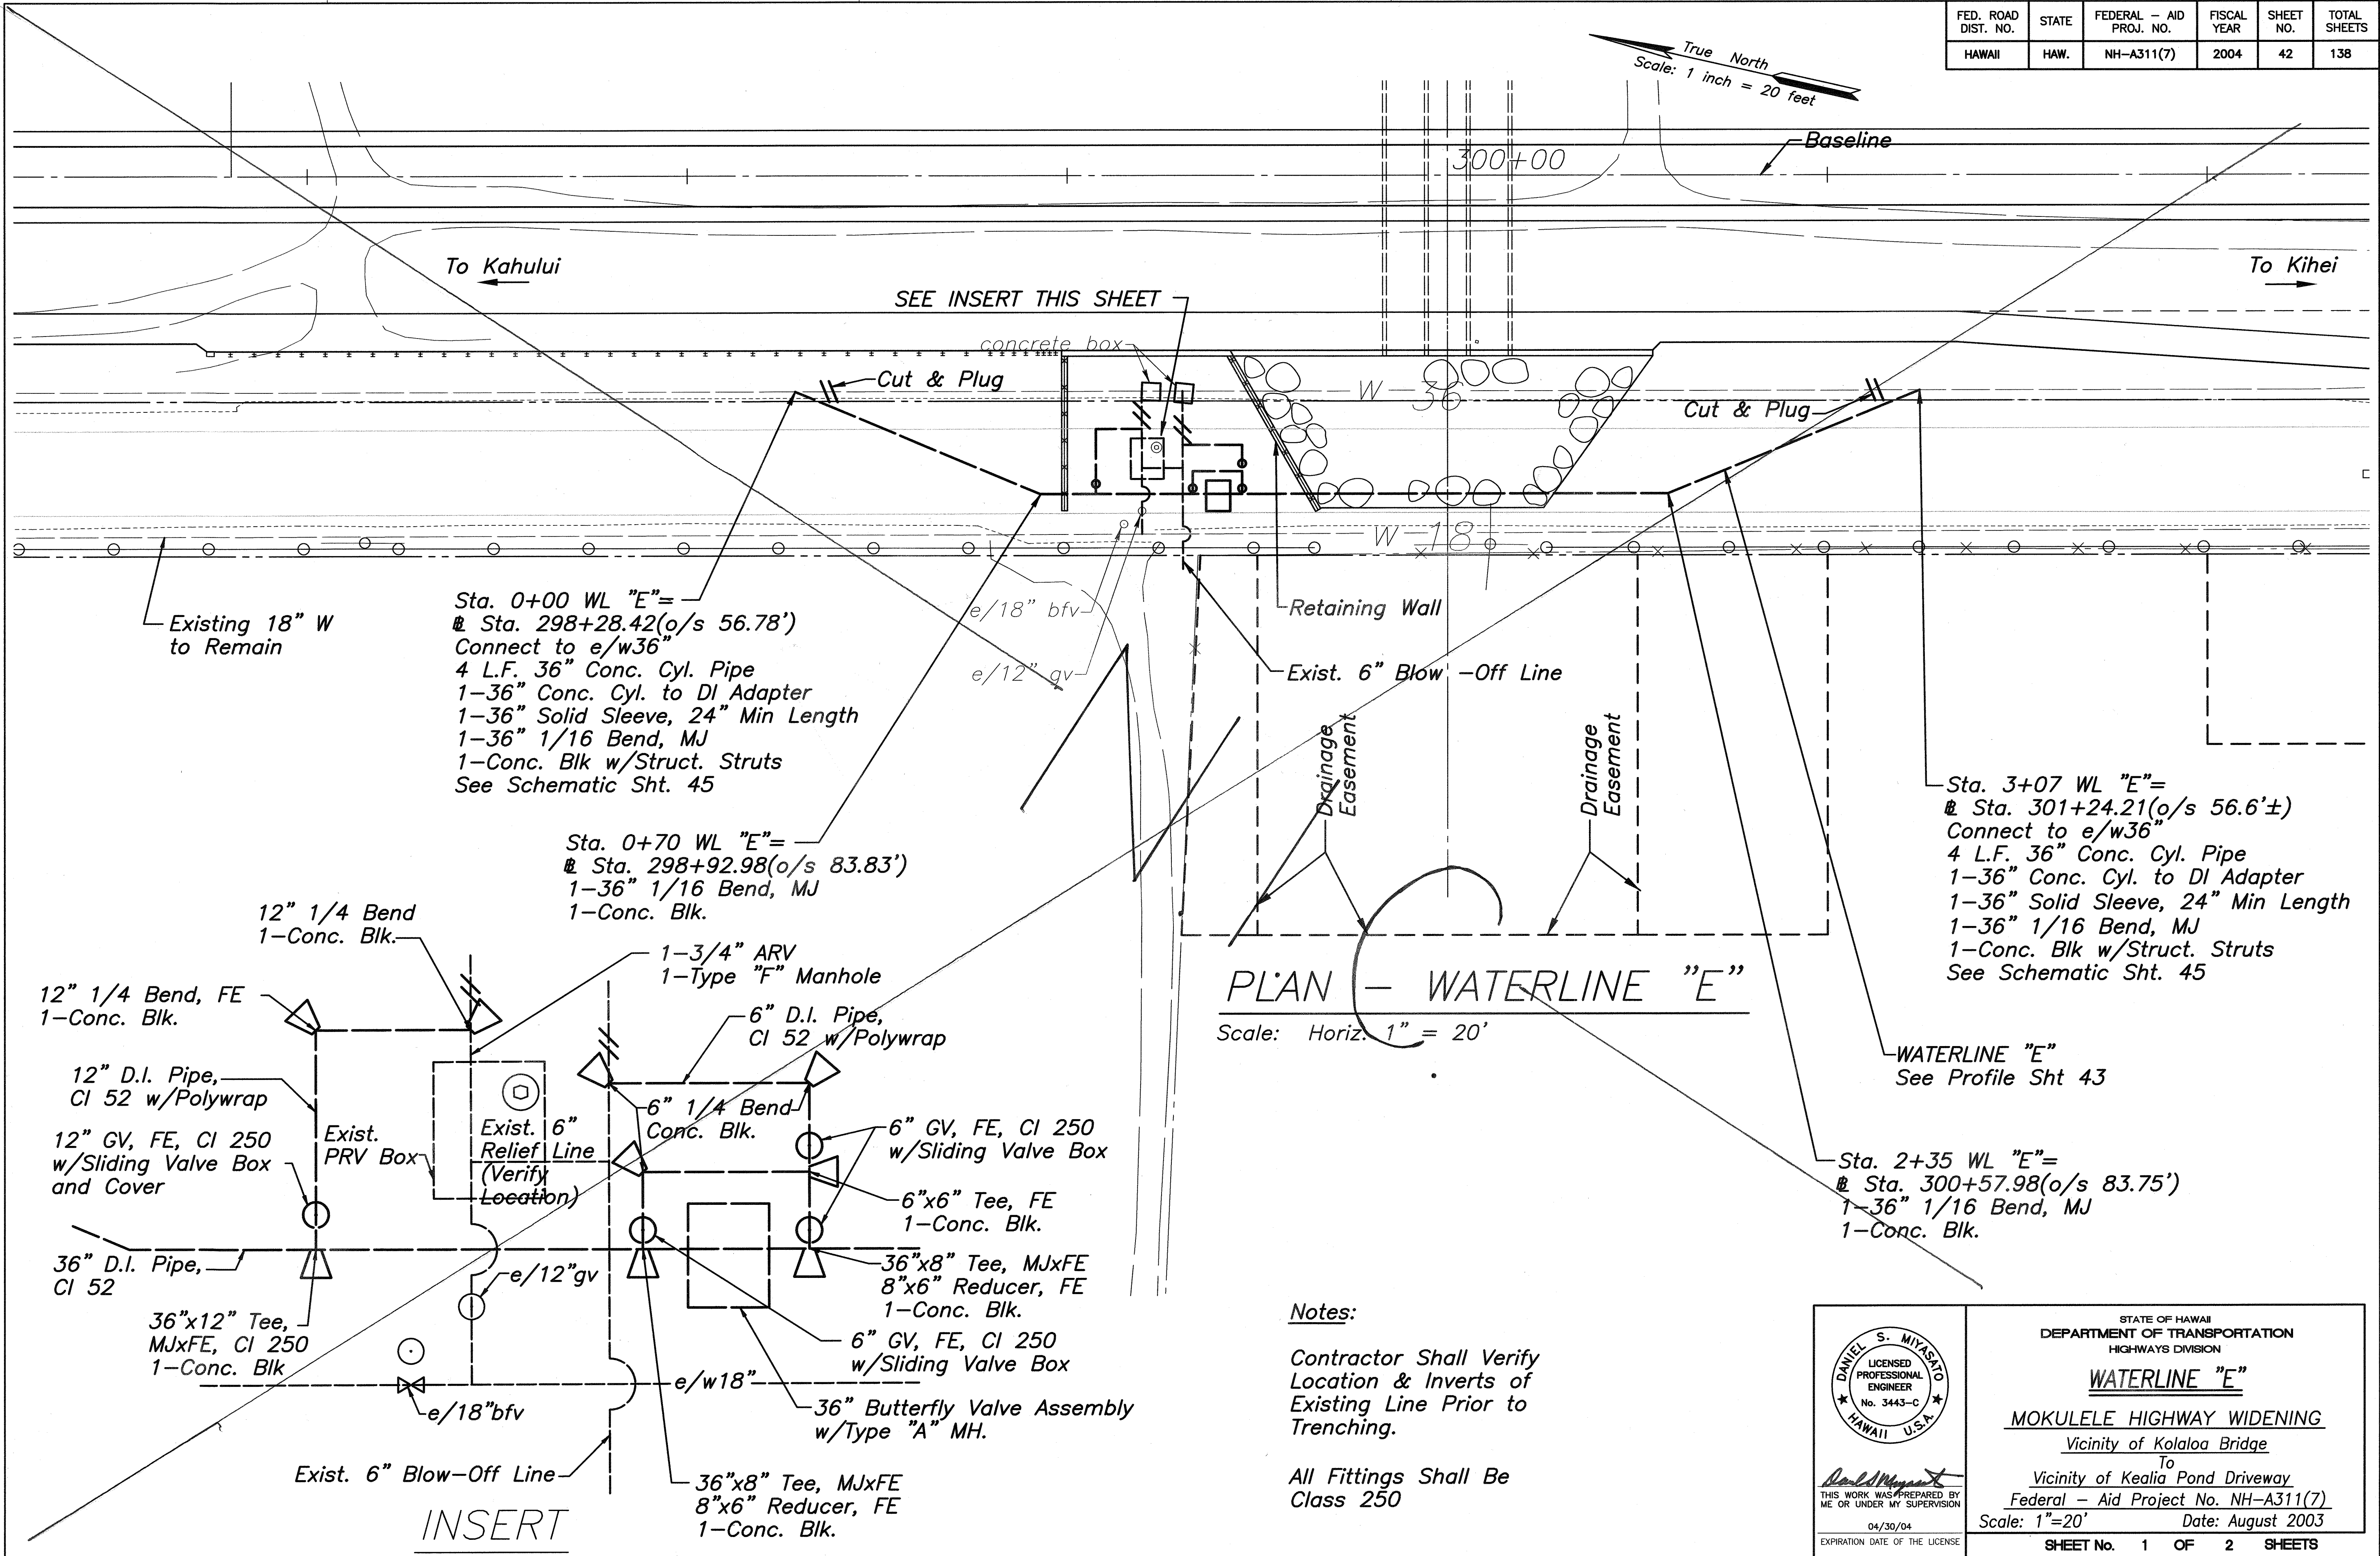

ORIGINAL PLAN	SURVEY PLOTTED BY	DATE
	DESIGNED BY	
	NOTED BY	
	CHECKED BY	
No.		

DANIEL S. MIYASATO
LICENSED PROFESSIONAL ENGINEER
No. 3443-C
HAWAII U.S.A.

THIS WORK WAS PREPARED BY ME OR UNDER MY SUPERVISION
04/30/04
EXPIRATION DATE OF THE LICENSE

STATE OF HAWAII
DEPARTMENT OF TRANSPORTATION
HIGHWAYS DIVISION


WATERLINE "E"

MOKULELE HIGHWAY WIDENING
Vicinity of Kolaloa Bridge
To
Vicinity of Kealia Pond Driveway
Federal - Aid Project No. NH-A311(7)
Scale: 1"=20' Date: August 2003


SHEET No. 1 OF 2 SHEETS

"AS-BUILT"

FED. ROAD DIST. NO.	STATE	FEDERAL - AID PROJ. NO.	FISCAL YEAR	SHEET NO.	TOTAL SHEETS
HAWAII	HAW.	NH-A311(7)	2004	43	138

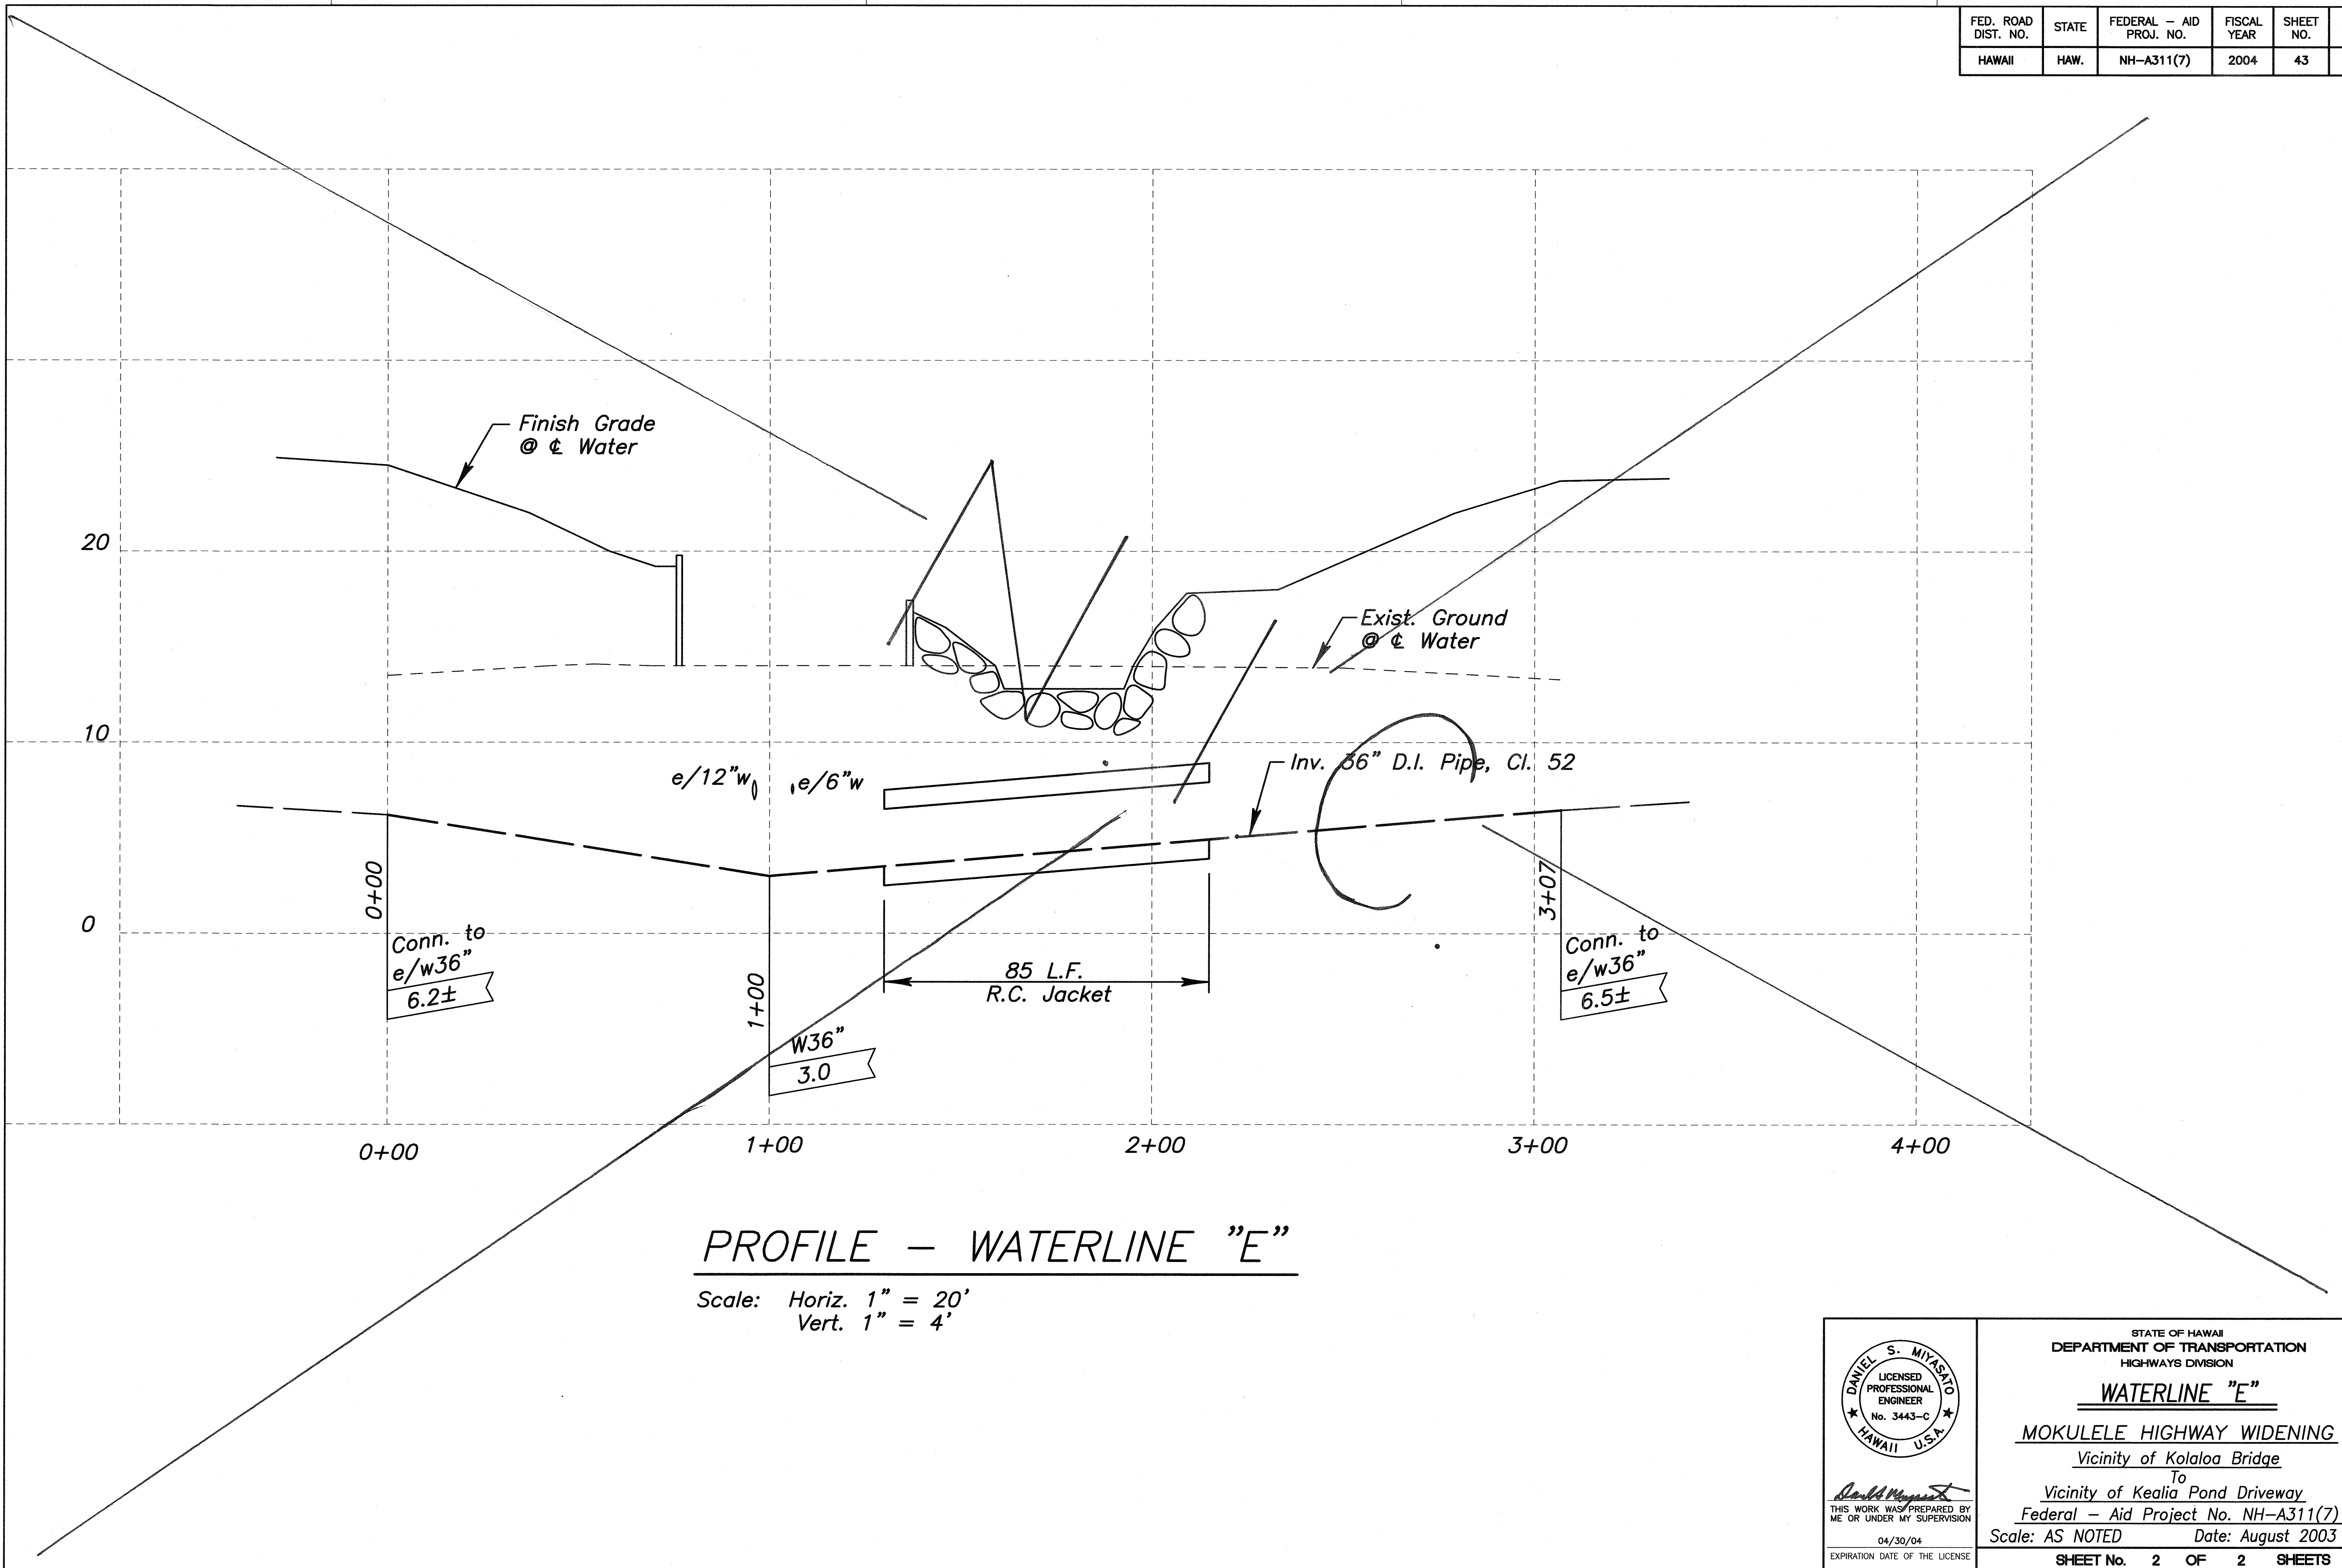

ORIGINAL PLAN	SURVEY PLOTTED BY	DATE
NOTE BOOK	DESIGNED BY	
QUANTITIES BY	CHECKED BY	
No.		

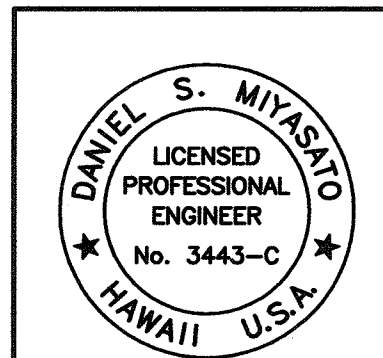

THIS WORK WAS PREPARED BY ME OR UNDER MY SUPERVISION
 EXPIRATION DATE OF THE LICENSE 04/30/04

STATE OF HAWAII
 DEPARTMENT OF TRANSPORTATION
 HIGHWAYS DIVISION
WATERLINE "E"
 MOKULELE HIGHWAY WIDENING
 Vicinity of Kolaloa Bridge
 To
 Vicinity of Kealia Pond Driveway
 Federal - Aid Project No. NH-A311(7)
 Scale: AS NOTED Date: August 2003
 SHEET No. 2 OF 2 SHEETS

"AS-BUILT"