



FED. ROAD DIST. NO.	STATE	FEDERAL - AID PROJ. NO.	FISCAL YEAR	SHEET NO.	TOTAL SHEETS
HAWAII	HAW.	NH-A311(7)	2004	44	138

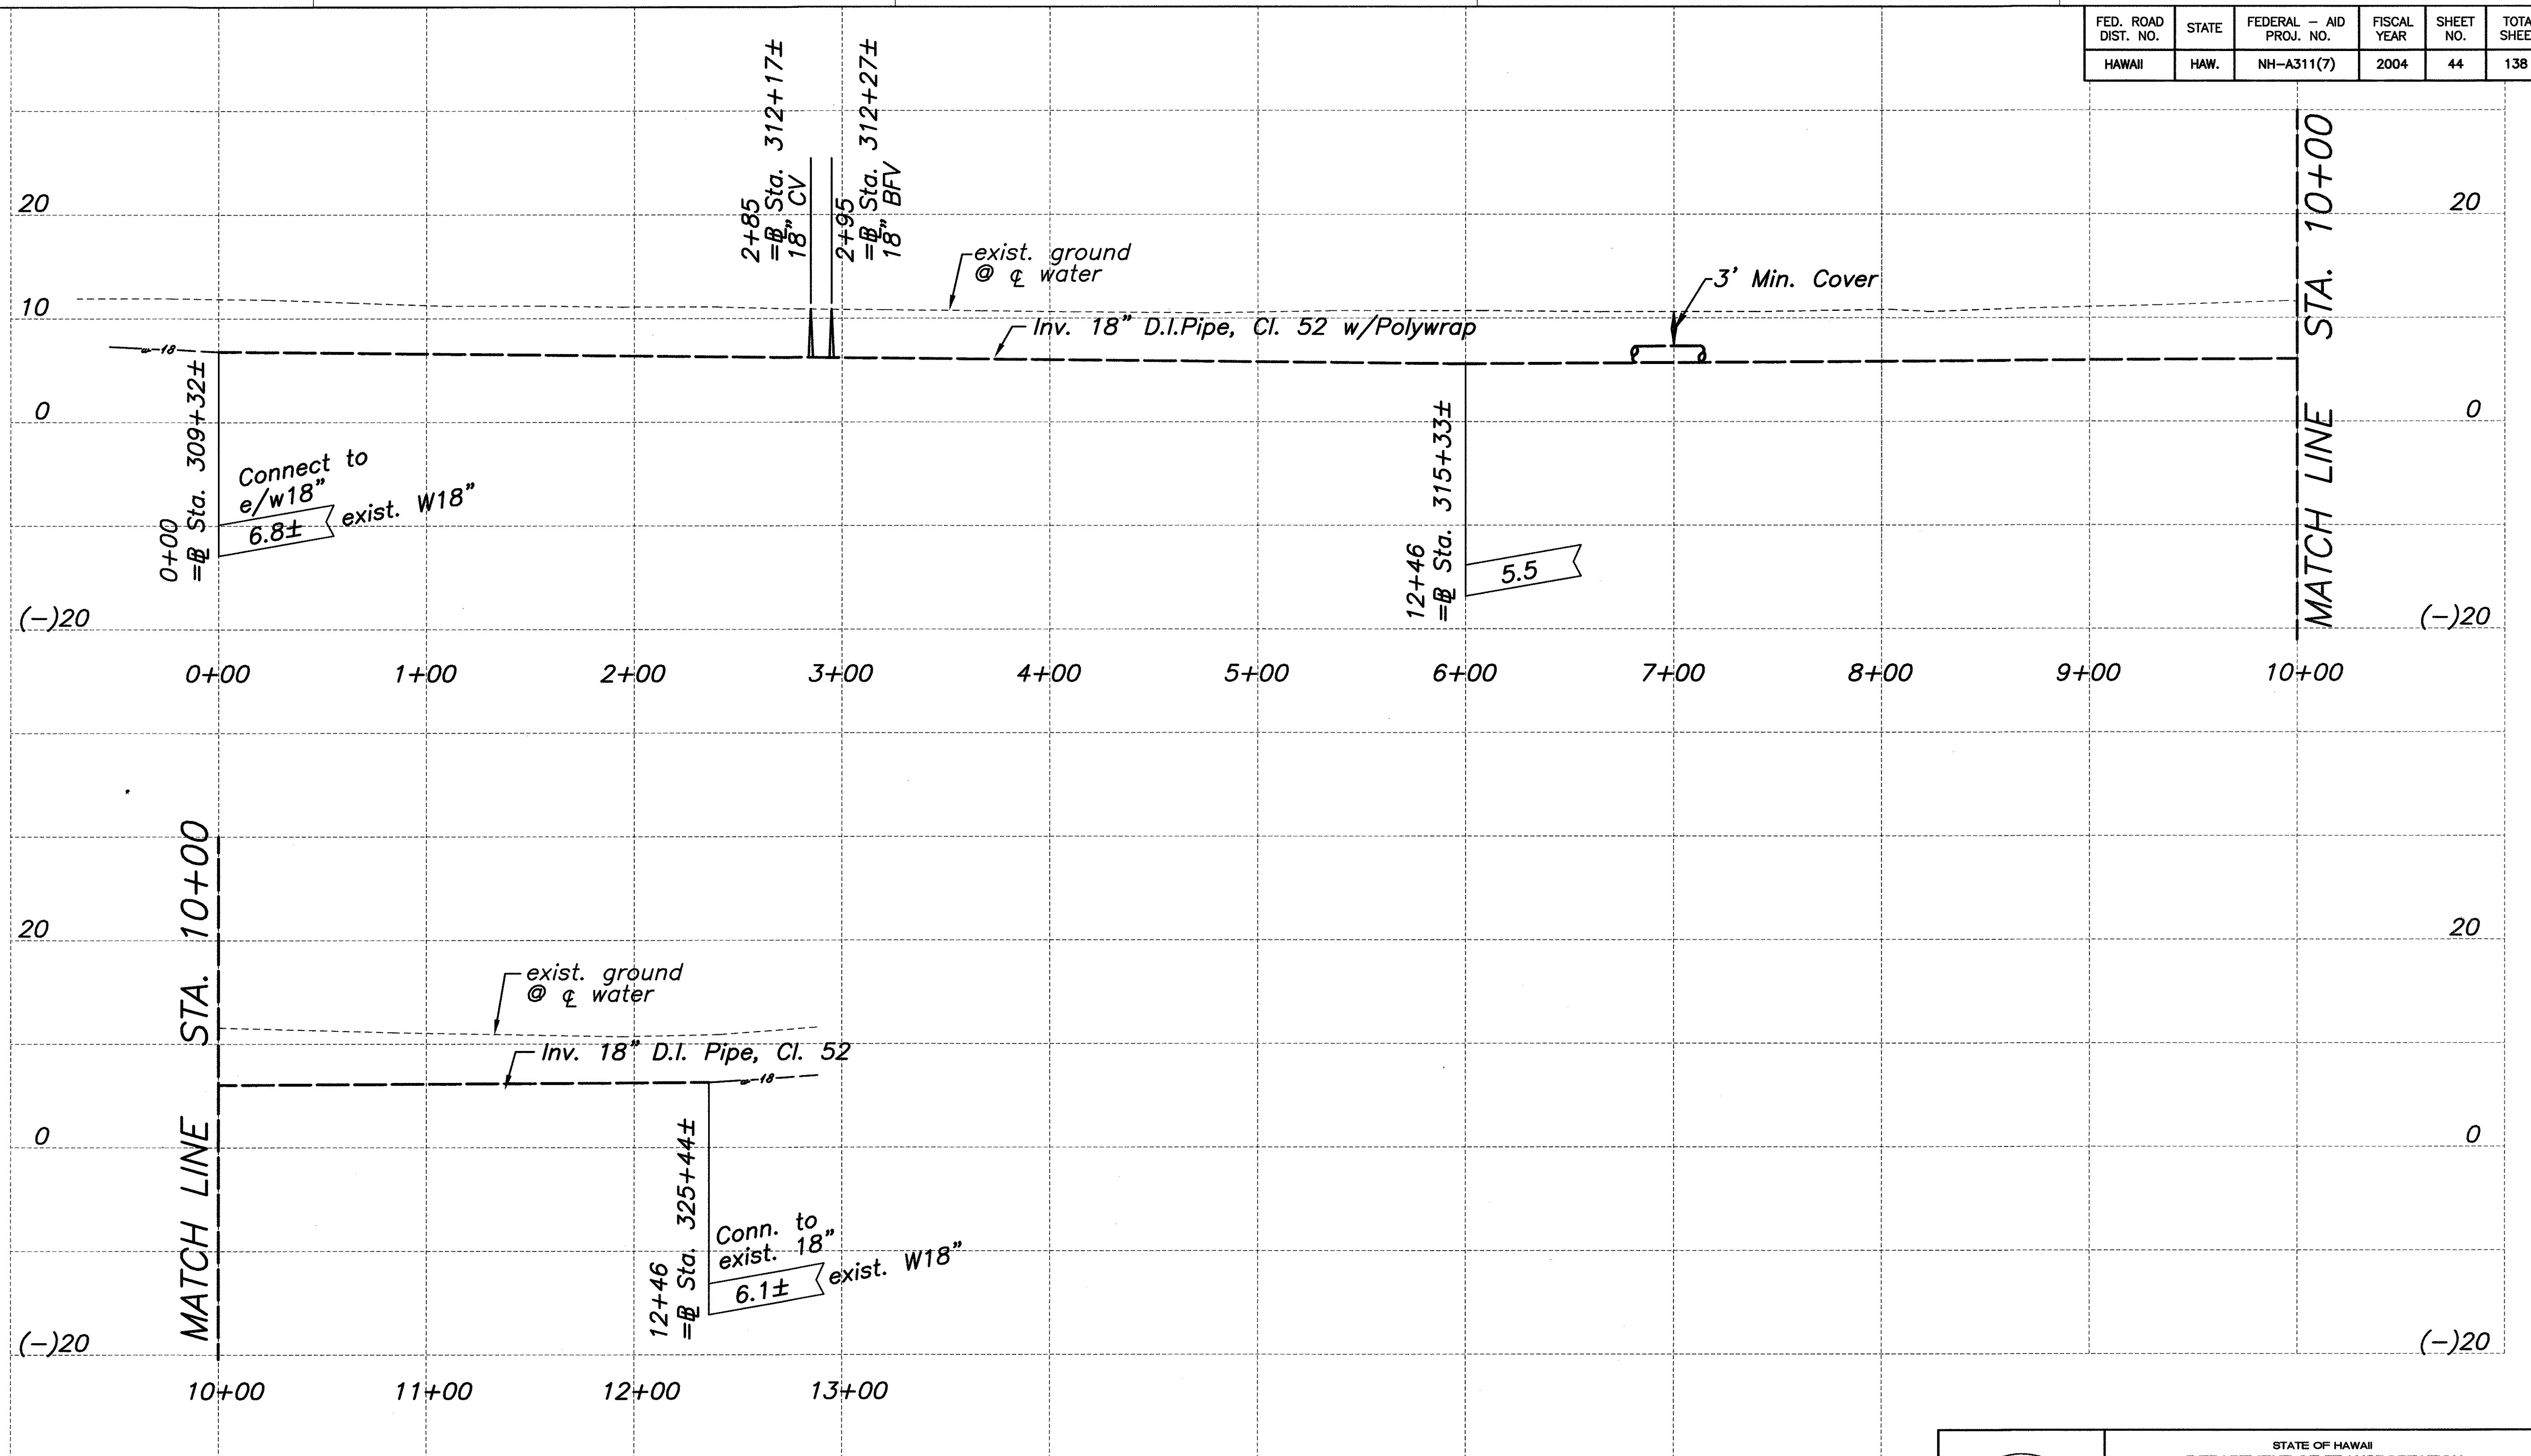

PROFILE - WATER LINE "F"
STA. 0+00 TO STA. 12+46

Scale: Horiz. 1" = 40'
Vert. 1" = 8'

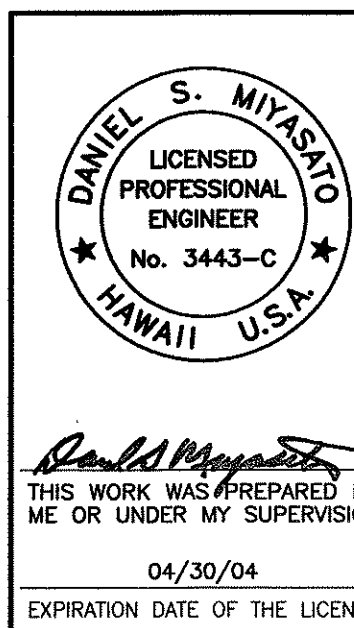

STATE OF HAWAII
DEPARTMENT OF TRANSPORTATION
HIGHWAYS DIVISION

WATERLINE "F"

MOKULELE HIGHWAY WIDENING
Vicinity of Kolaloa Bridge

To
Vicinity of Kealia Pond Driveway
Federal - Aid Project No. NH-A311(7)

Scale: AS NOTED Date: August 2003

SHEET No. 1 OF 1 SHEETS