


FED. ROAD DIST. NO.	STATE	FED. AID PROJ. NO.	FISCAL YEAR	SHEET NO.	TOTAL SHEETS
HAWAII	HAW.	NH-A311(008)	2014	ADD.11	32

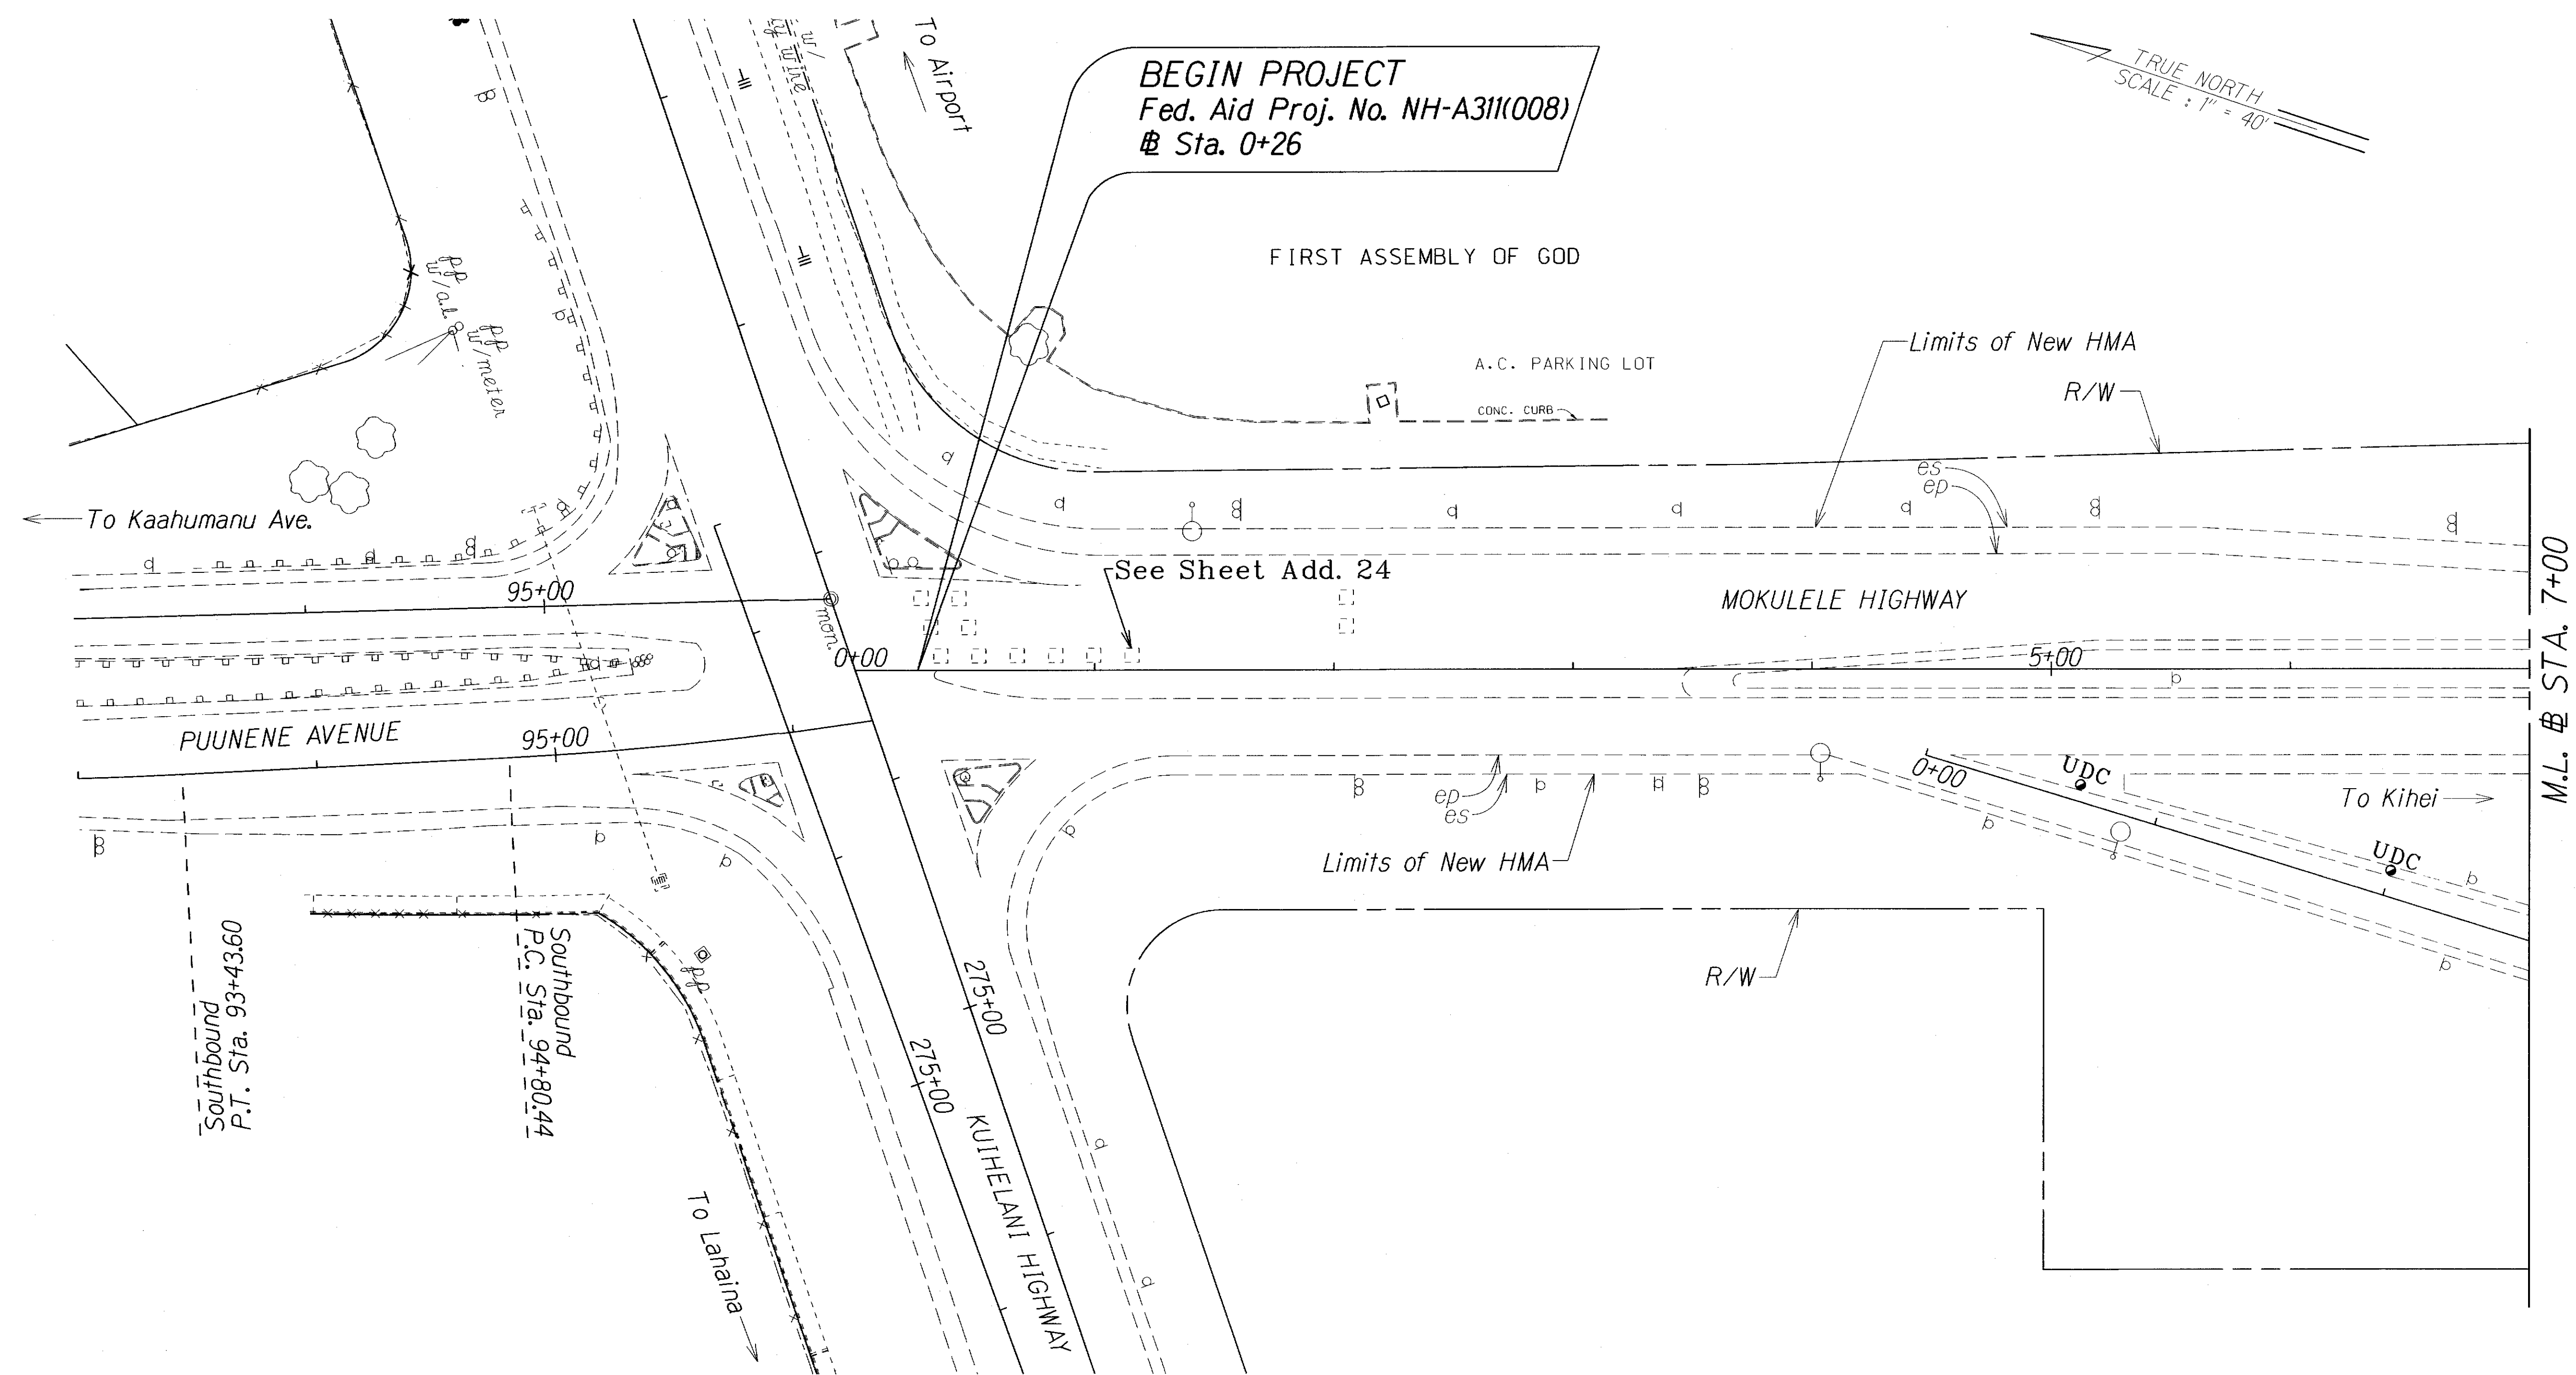

NOTES:

1. Seal all cracks as directed by the Engineer. Payment is subsidiary to Item 4011000.
2. Install Shoulder Milled Rumble Strips from Sta. 0+00 to Sta. 170+00 as directed by the Engineer. There are no Centerline Milled Rumble Strips for this project.

LEGEND FOR AS-BUILT POSTINGS	
	Squiggly line for as-built deletion
	Double line for as-built deletion
Roadway	Text for as-built posting

6-6-14	Revised Notes No. 2.
--------	----------------------


DATE	REVISION
------	----------

STATE OF HAWAII
DEPARTMENT OF TRANSPORTATION
HIGHWAYS DIVISION
ROADWAY PLAN
RTE 311 MOKULELE HIGHWAY
PAVEMENT PREVENTIVE MAINTENANCE
Kuihelani Highway to Maui Humane Society
Federal-Aid Project No. NH-A311(008)
Scale: 1" = 40' Date: January, 2014
SHEET No. 1 OF 9 SHEETS

"AS-BUILT"

ADD. 11

FED. ROAD DIST. NO.	STATE	FED. AID PROJ. NO.	FISCAL YEAR	SHEET NO.	TOTAL SHEETS
HAWAII	HAW.	NH-A311(008)	2014	ADD.12	32

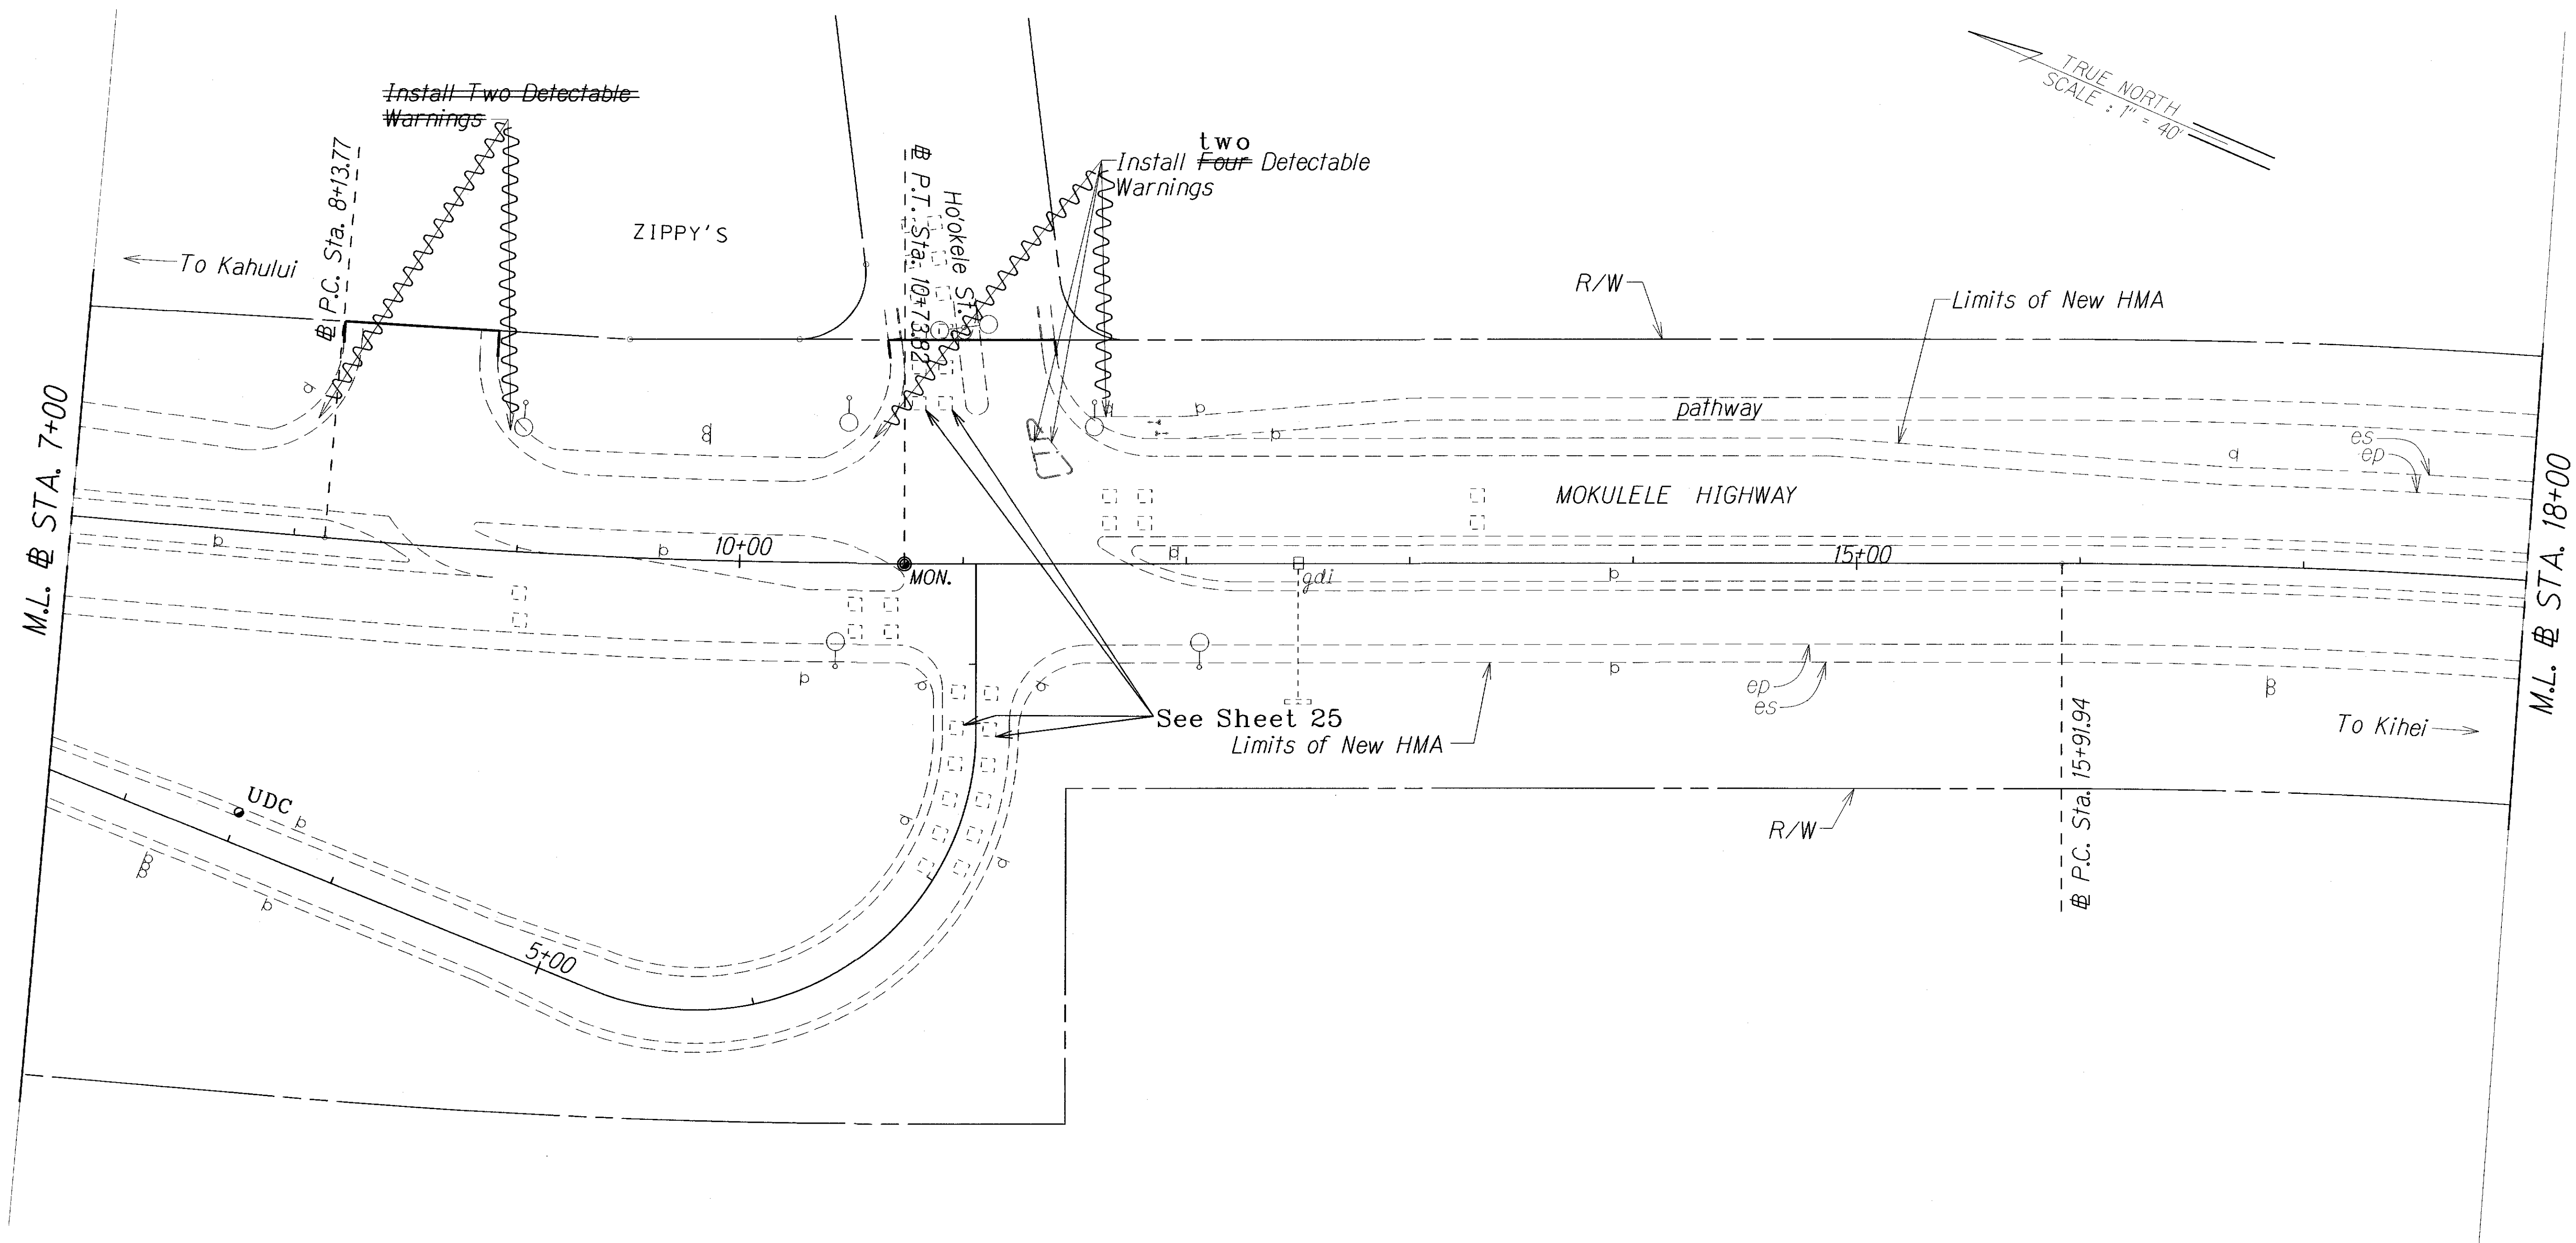

NOTES:

- ~~1. Seal all cracks as directed by the Engineer. Payment is subsidiary to Item 401.1000.~~
2. Install Shoulder Milled Rumble Strips from Sta. 0+00 to Sta. 170+00 as directed by the Engineer. There are no Centerline Milled Rumble Strips for this project.
3. Place Detectable Warnings as directed by the Engineer.

LEGEND FOR
AS-BUILT POSTINGS

	Squiggly line for as-built deletion
	Double line for as-built deletion
	Text for as-built posting

6-6-14 Revised Notes No. 2.

DATE REVISION


STATE OF HAWAII
DEPARTMENT OF TRANSPORTATION
HIGHWAYS DIVISION
ROADWAY PLAN
RTE 311 MOKULELE HIGHWAY
PAVEMENT PREVENTIVE MAINTENANCE
Kuihelani Highway to Maui Humane Society
Federal-Aid Project No. NH-A311(008)
Scale: 1" = 40' Date: January, 2014
SHEET No. 2 OF 9 SHEETS

SURVEY PLOTTED BY	DATE
DRAWN BY	
CHECKED BY	
NOTE BOOK	
CHECKED BY	
N.	

"AS-BUILT"

ADD. 12


FED. ROAD DIST. NO.	STATE	FED. AID PROJ. NO.	FISCAL YEAR	SHEET NO.	TOTAL SHEETS
HAWAII	HAW.	NH-A311(008)	2014	ADD.13	32

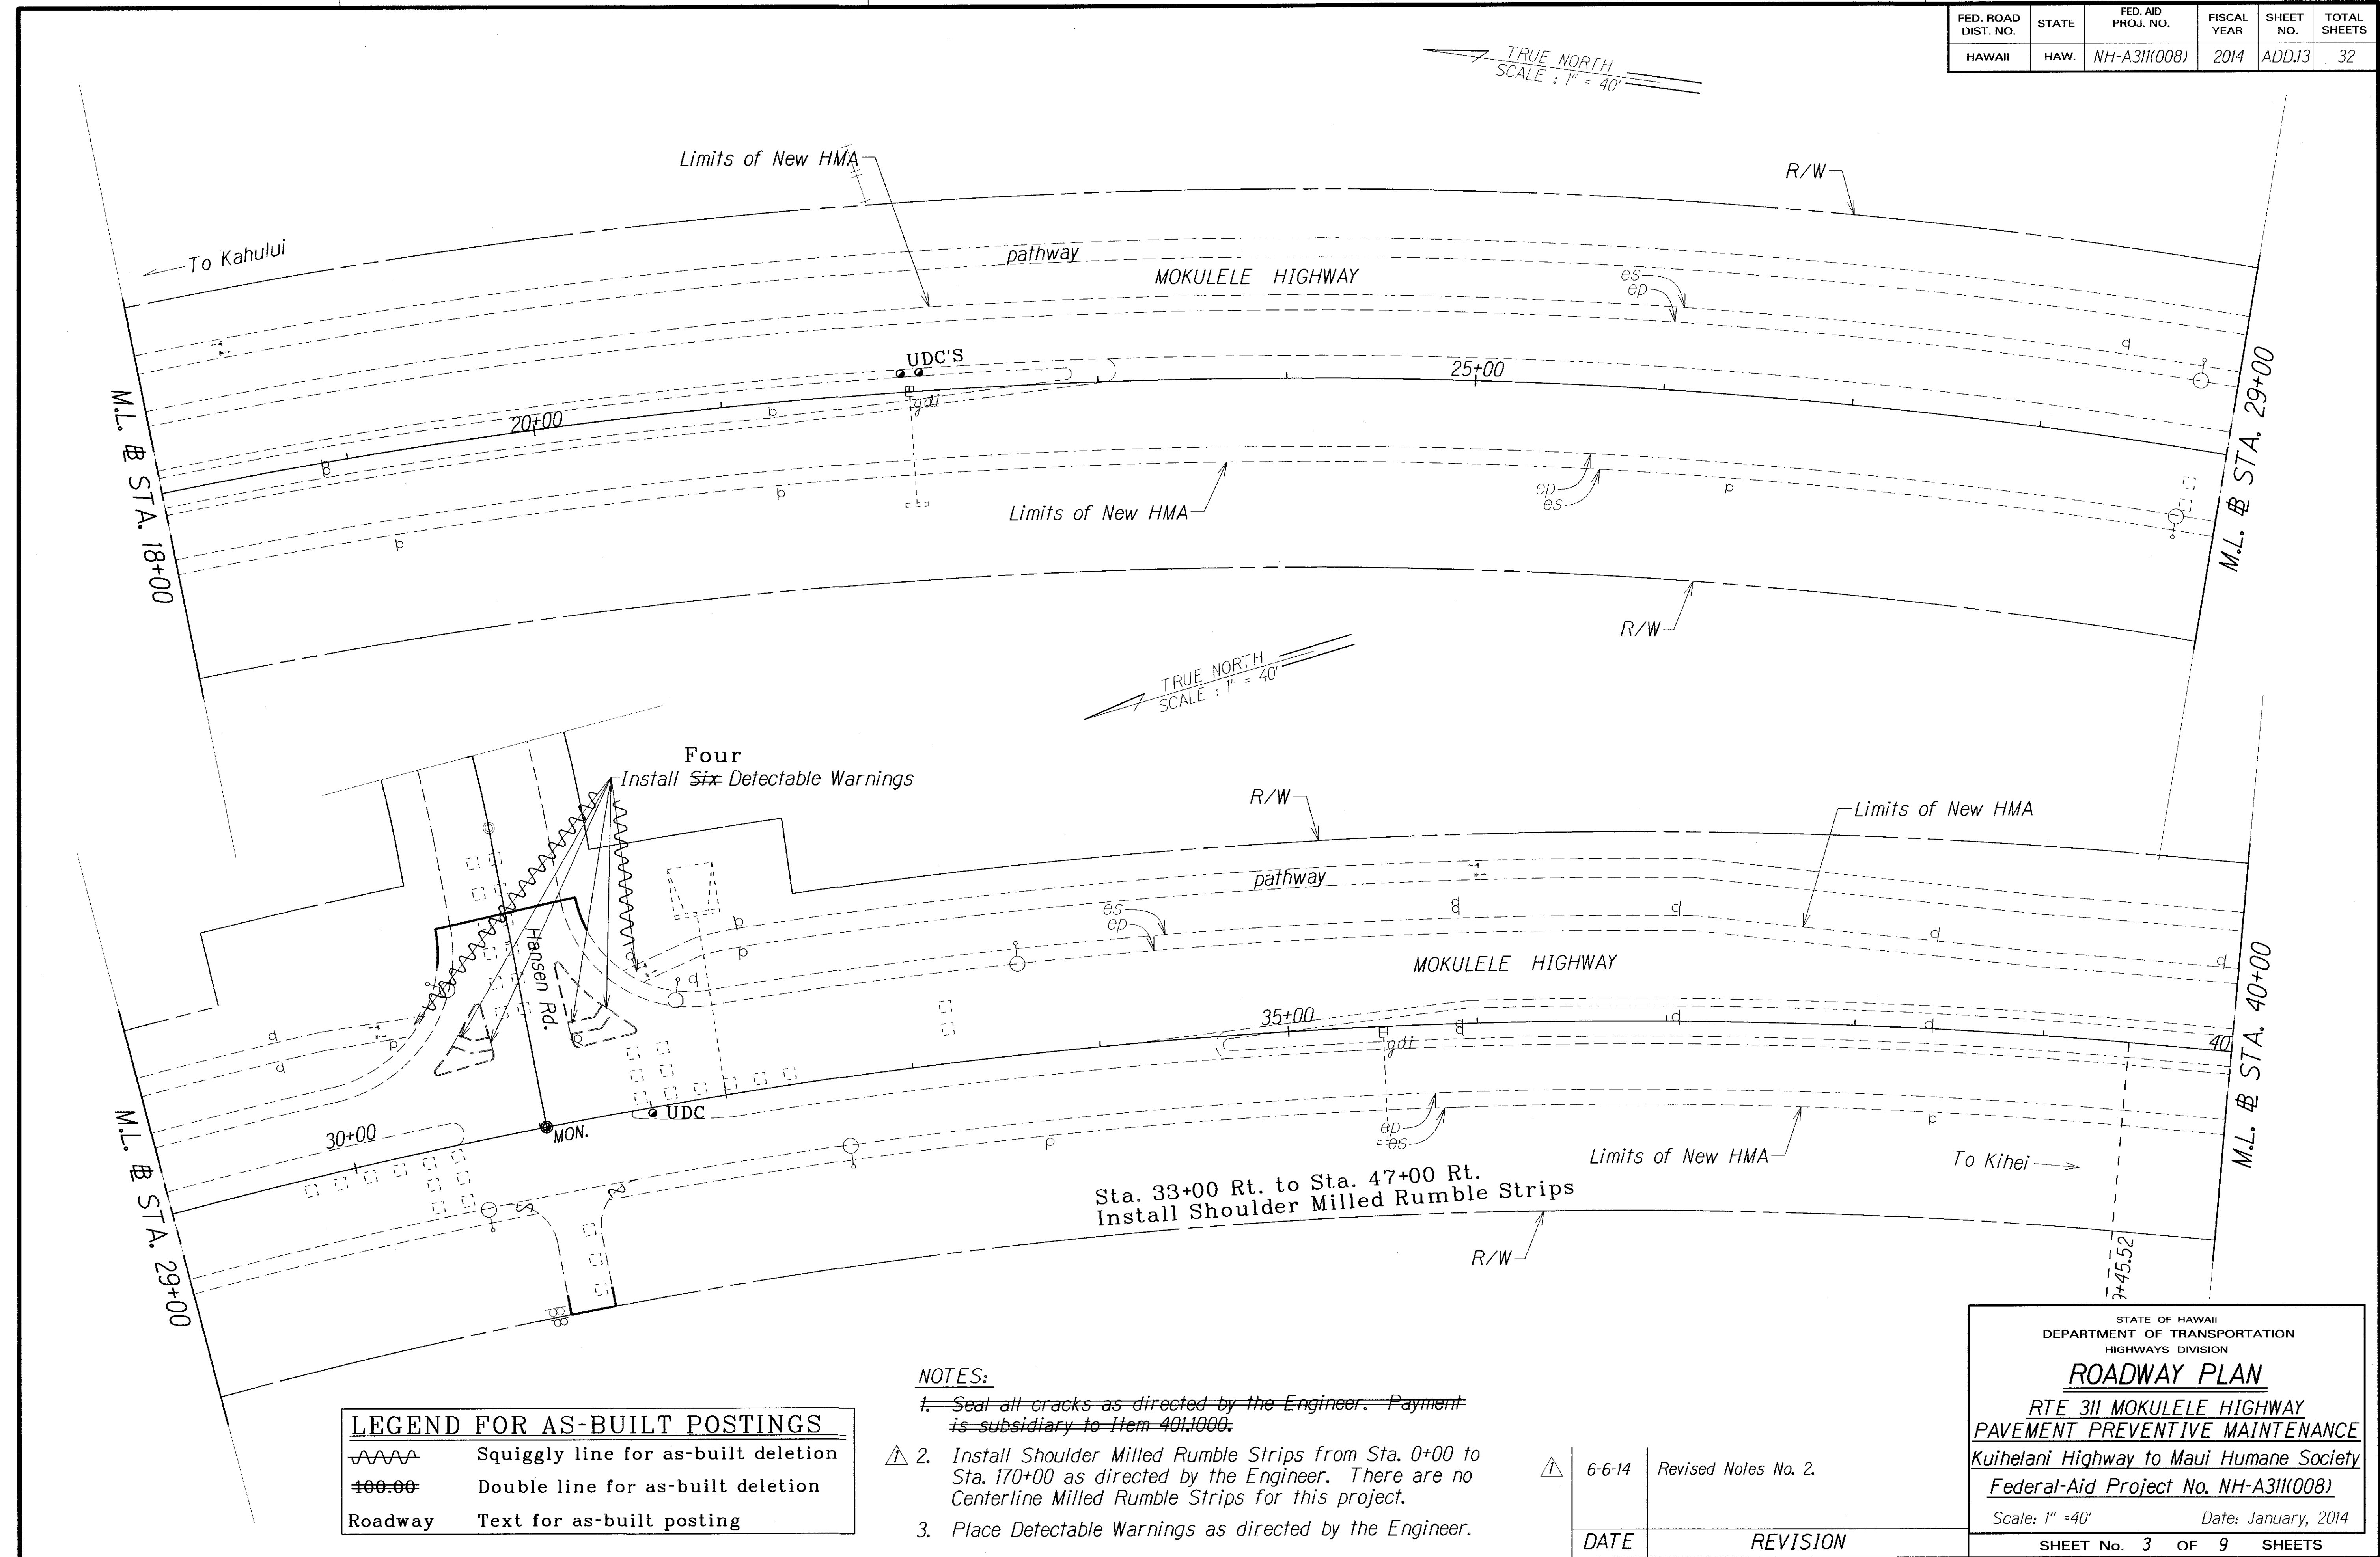

"AS-BUILT"

ADD. 13

FED. ROAD DIST. NO.	STATE	FED. AID PROJ. NO.	FISCAL YEAR	SHEET NO.	TOTAL SHEETS
HAWAII	HAW.	NH-A311(008)	2014	ADD.14	32

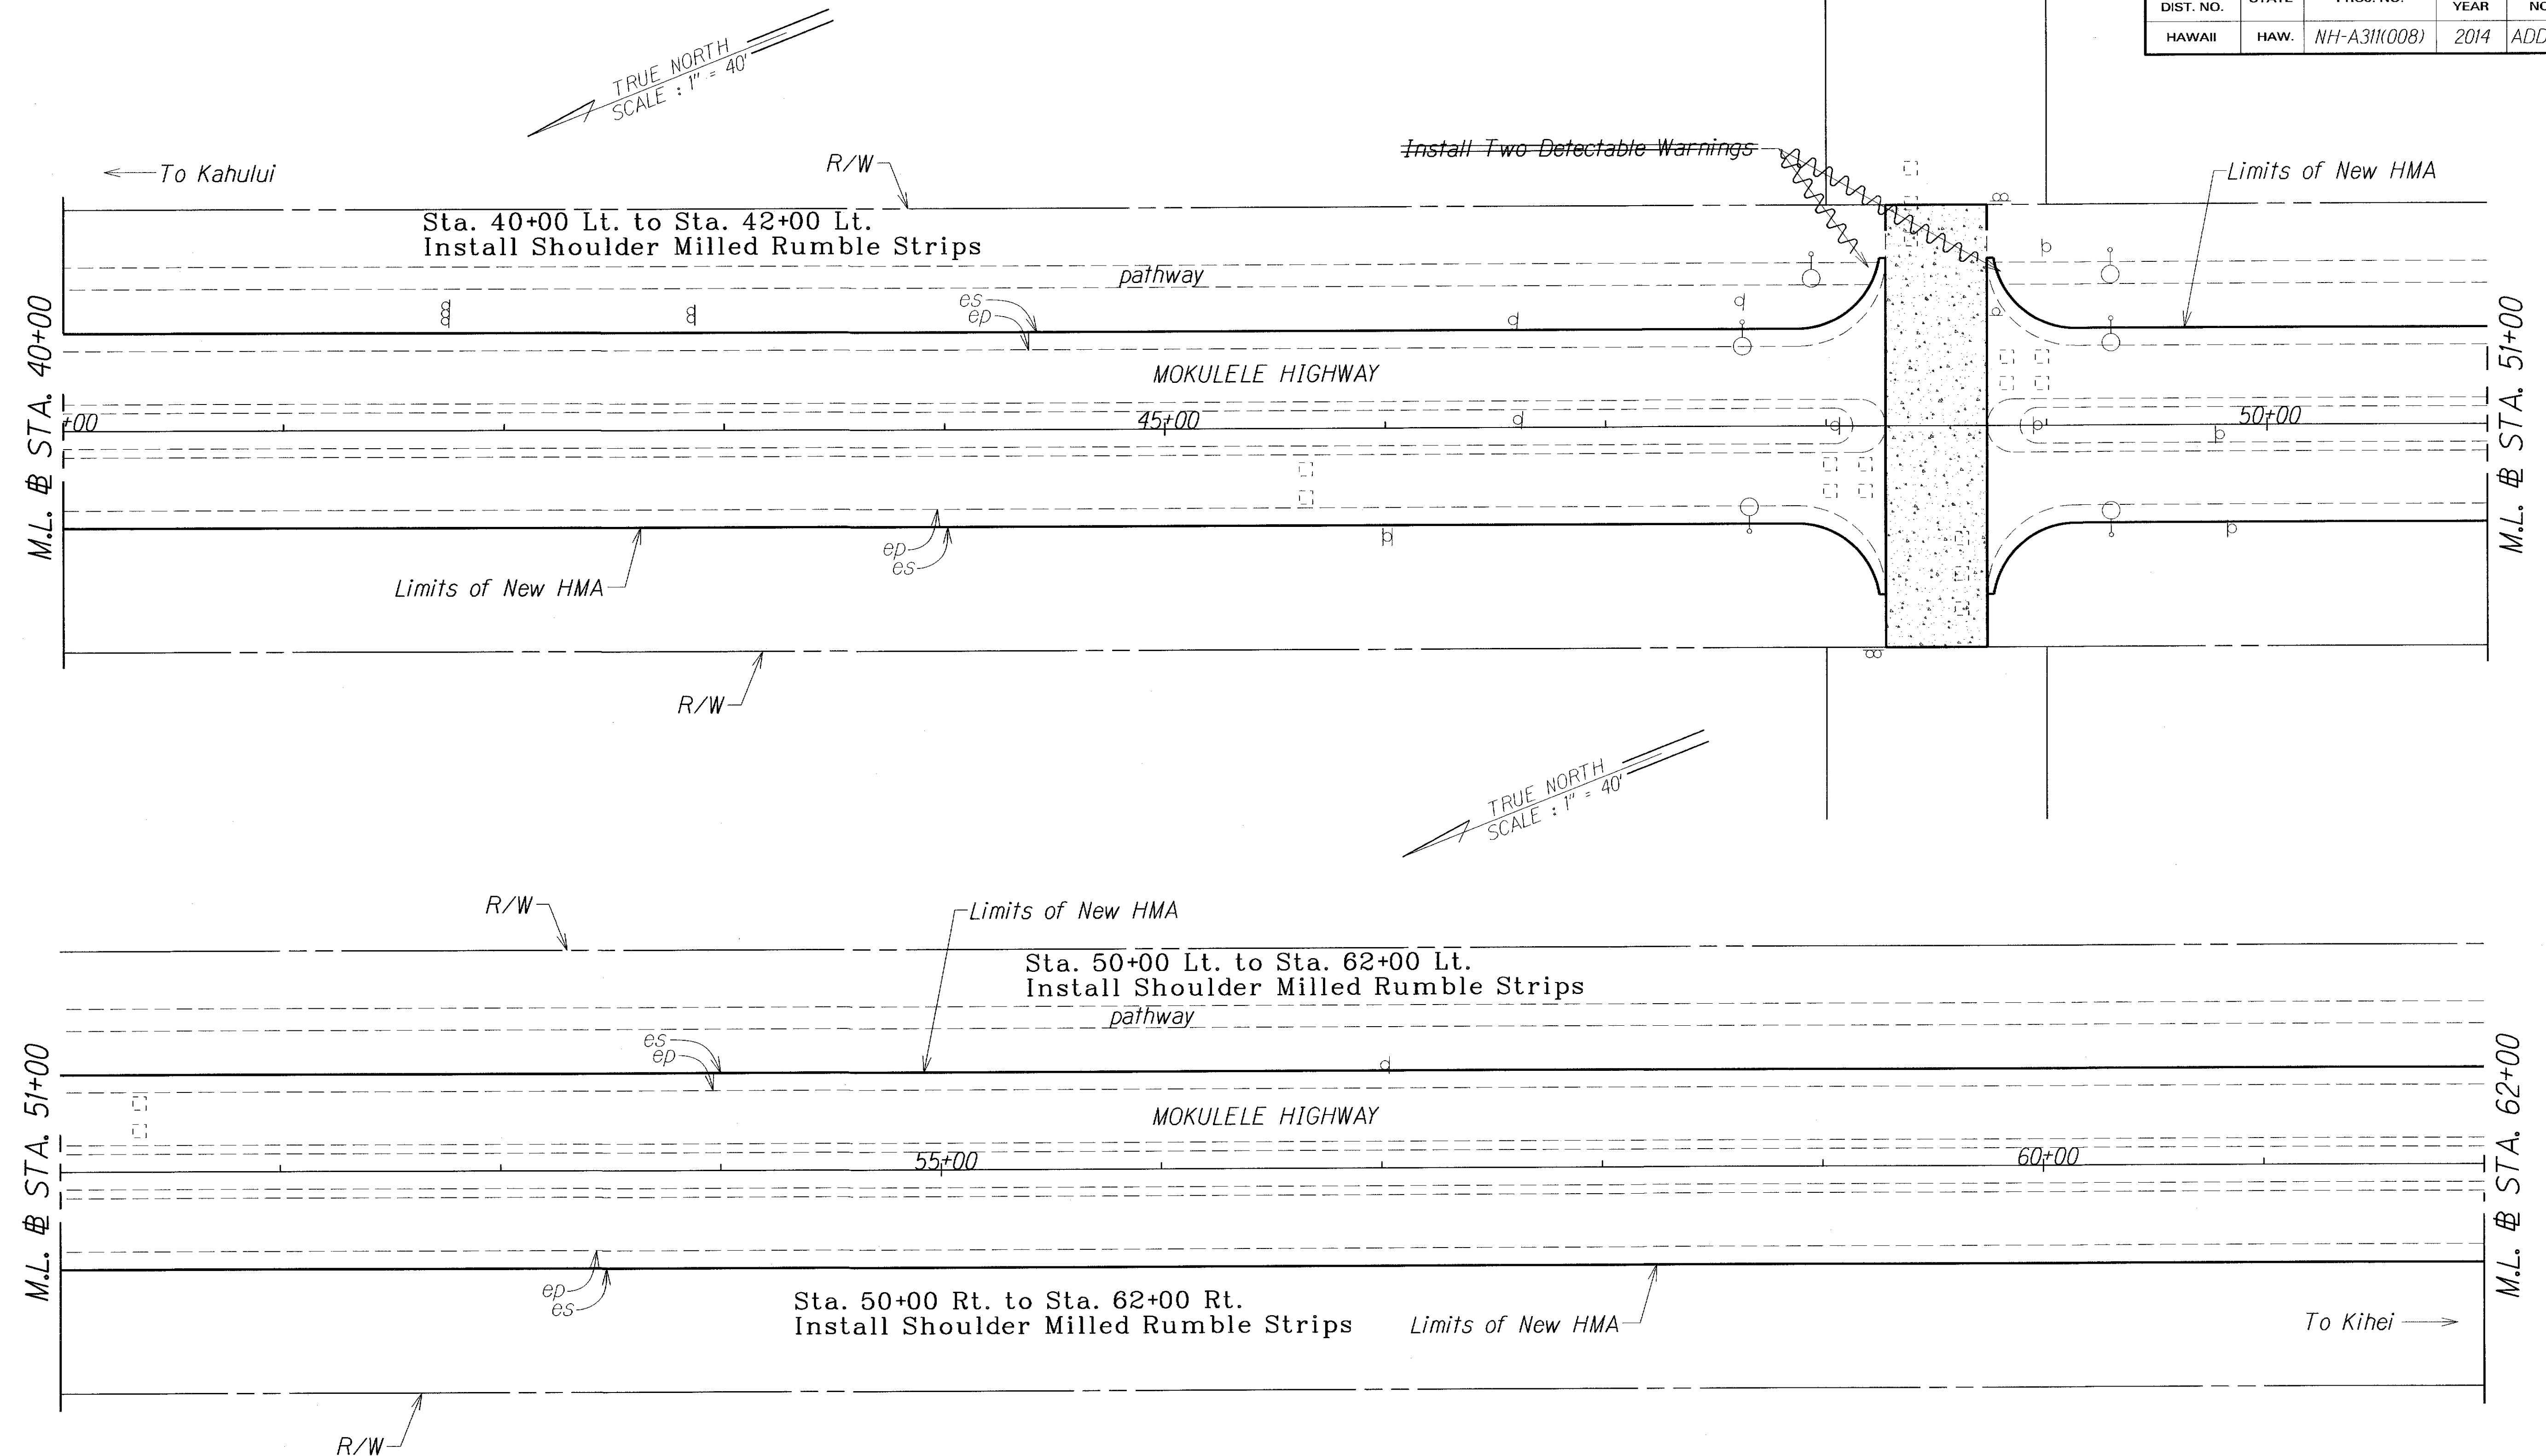

NOTES:

1. Seal all cracks as directed by the Engineer. Payment is subsidiary to Item 401.000.
2. Install Shoulder Milled Rumble Strips from Sta. 0+00 to Sta. 170+00 as directed by the Engineer. There are no Centerline Milled Rumble Strips for this project.
3. Place Detectable Warnings as directed by the Engineer.

LEGEND FOR AS-BUILT POSTINGS

~~~~~	Squiggly line for as-built deletion
==	Double line for as-built deletion
Roadway	Text for as-built posting

6-6-14 Revised Notes No. 2.


DATE REVISION

STATE OF HAWAII DEPARTMENT OF TRANSPORTATION HIGHWAYS DIVISION	
<b>ROADWAY PLAN</b>	
RTE 311 MOKULELE HIGHWAY PAVEMENT PREVENTIVE MAINTENANCE Kuihelani Highway to Maui Humane Society Federal-Aid Project No. NH-A311(008)	
Scale: 1" = 40'	Date: January, 2014
SHEET No. 4 OF 9 SHEETS	

"AS-BUILT"

ADD. 14

FED. ROAD DIST. NO.	STATE	FED. AID PROJ. NO.	FISCAL YEAR	SHEET NO.	TOTAL SHEETS
HAWAII	HAW.	NH-A311(008)	2014	ADD.15	32

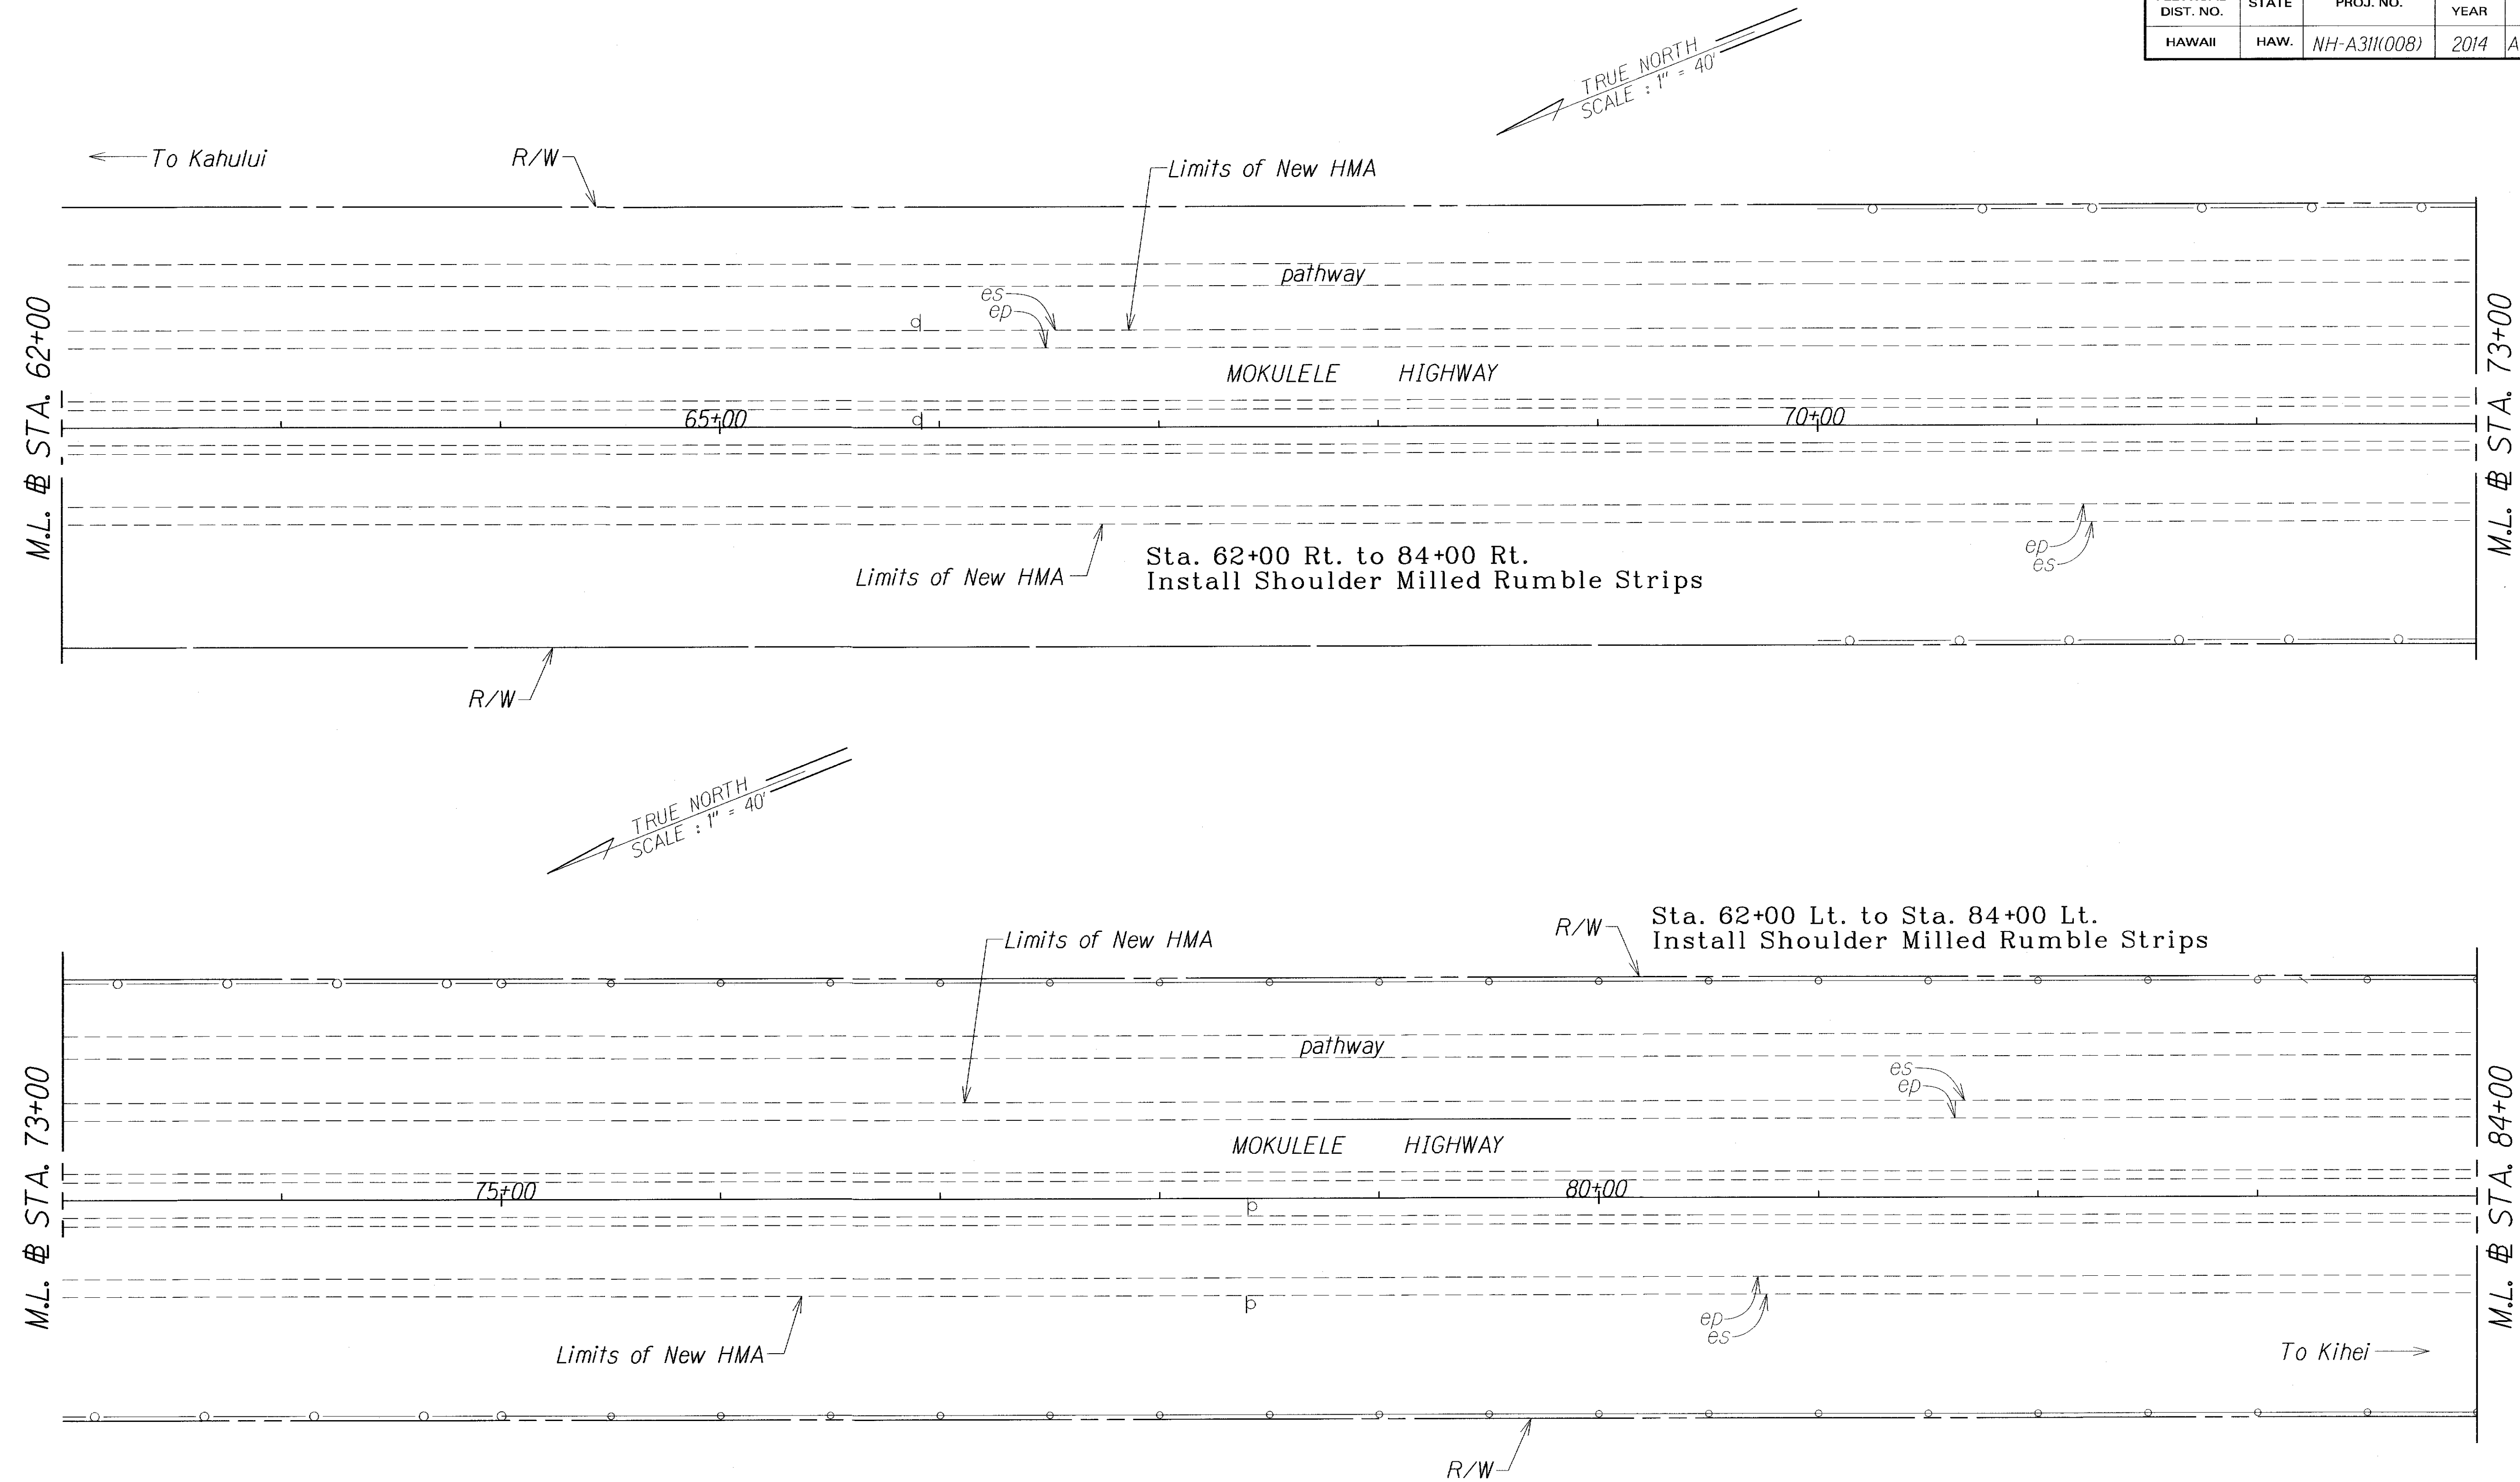

**NOTES:**

- ~~Seal all cracks as directed by the Engineer. Payment is subsidiary to Item 401.1000.~~
- △ 2. Install Shoulder Milled Rumble Strips from Sta. 0+00 to Sta. 170+00 as directed by the Engineer. There are no Centerline Milled Rumble Strips for this project.

**LEGEND FOR  
AS-BUILT POSTINGS**

	Squiggly line for as-built deletion
	Double line for as-built deletion
Roadway	Text for as-built posting

△ 6-6-14 Revised Notes No. 2.


DATE REVISION

STATE OF HAWAII DEPARTMENT OF TRANSPORTATION HIGHWAYS DIVISION	
<b>ROADWAY PLAN</b>	
RTE 311 MOKULELE HIGHWAY PAVEMENT PREVENTIVE MAINTENANCE	
Kuihelani Highway to Maui Humane Society Federal-Aid Project No. NH-A311(008)	
Scale: 1" = 40'	Date: January, 2014
SHEET No. 5 OF 9 SHEETS	

"AS-BUILT"

ADD. 15

FED. ROAD DIST. NO.	STATE	FED. AID PROJ. NO.	FISCAL YEAR	SHEET NO.	TOTAL SHEETS
HAWAII	HAW.	NH-A311(008)	2014	ADD.16	32

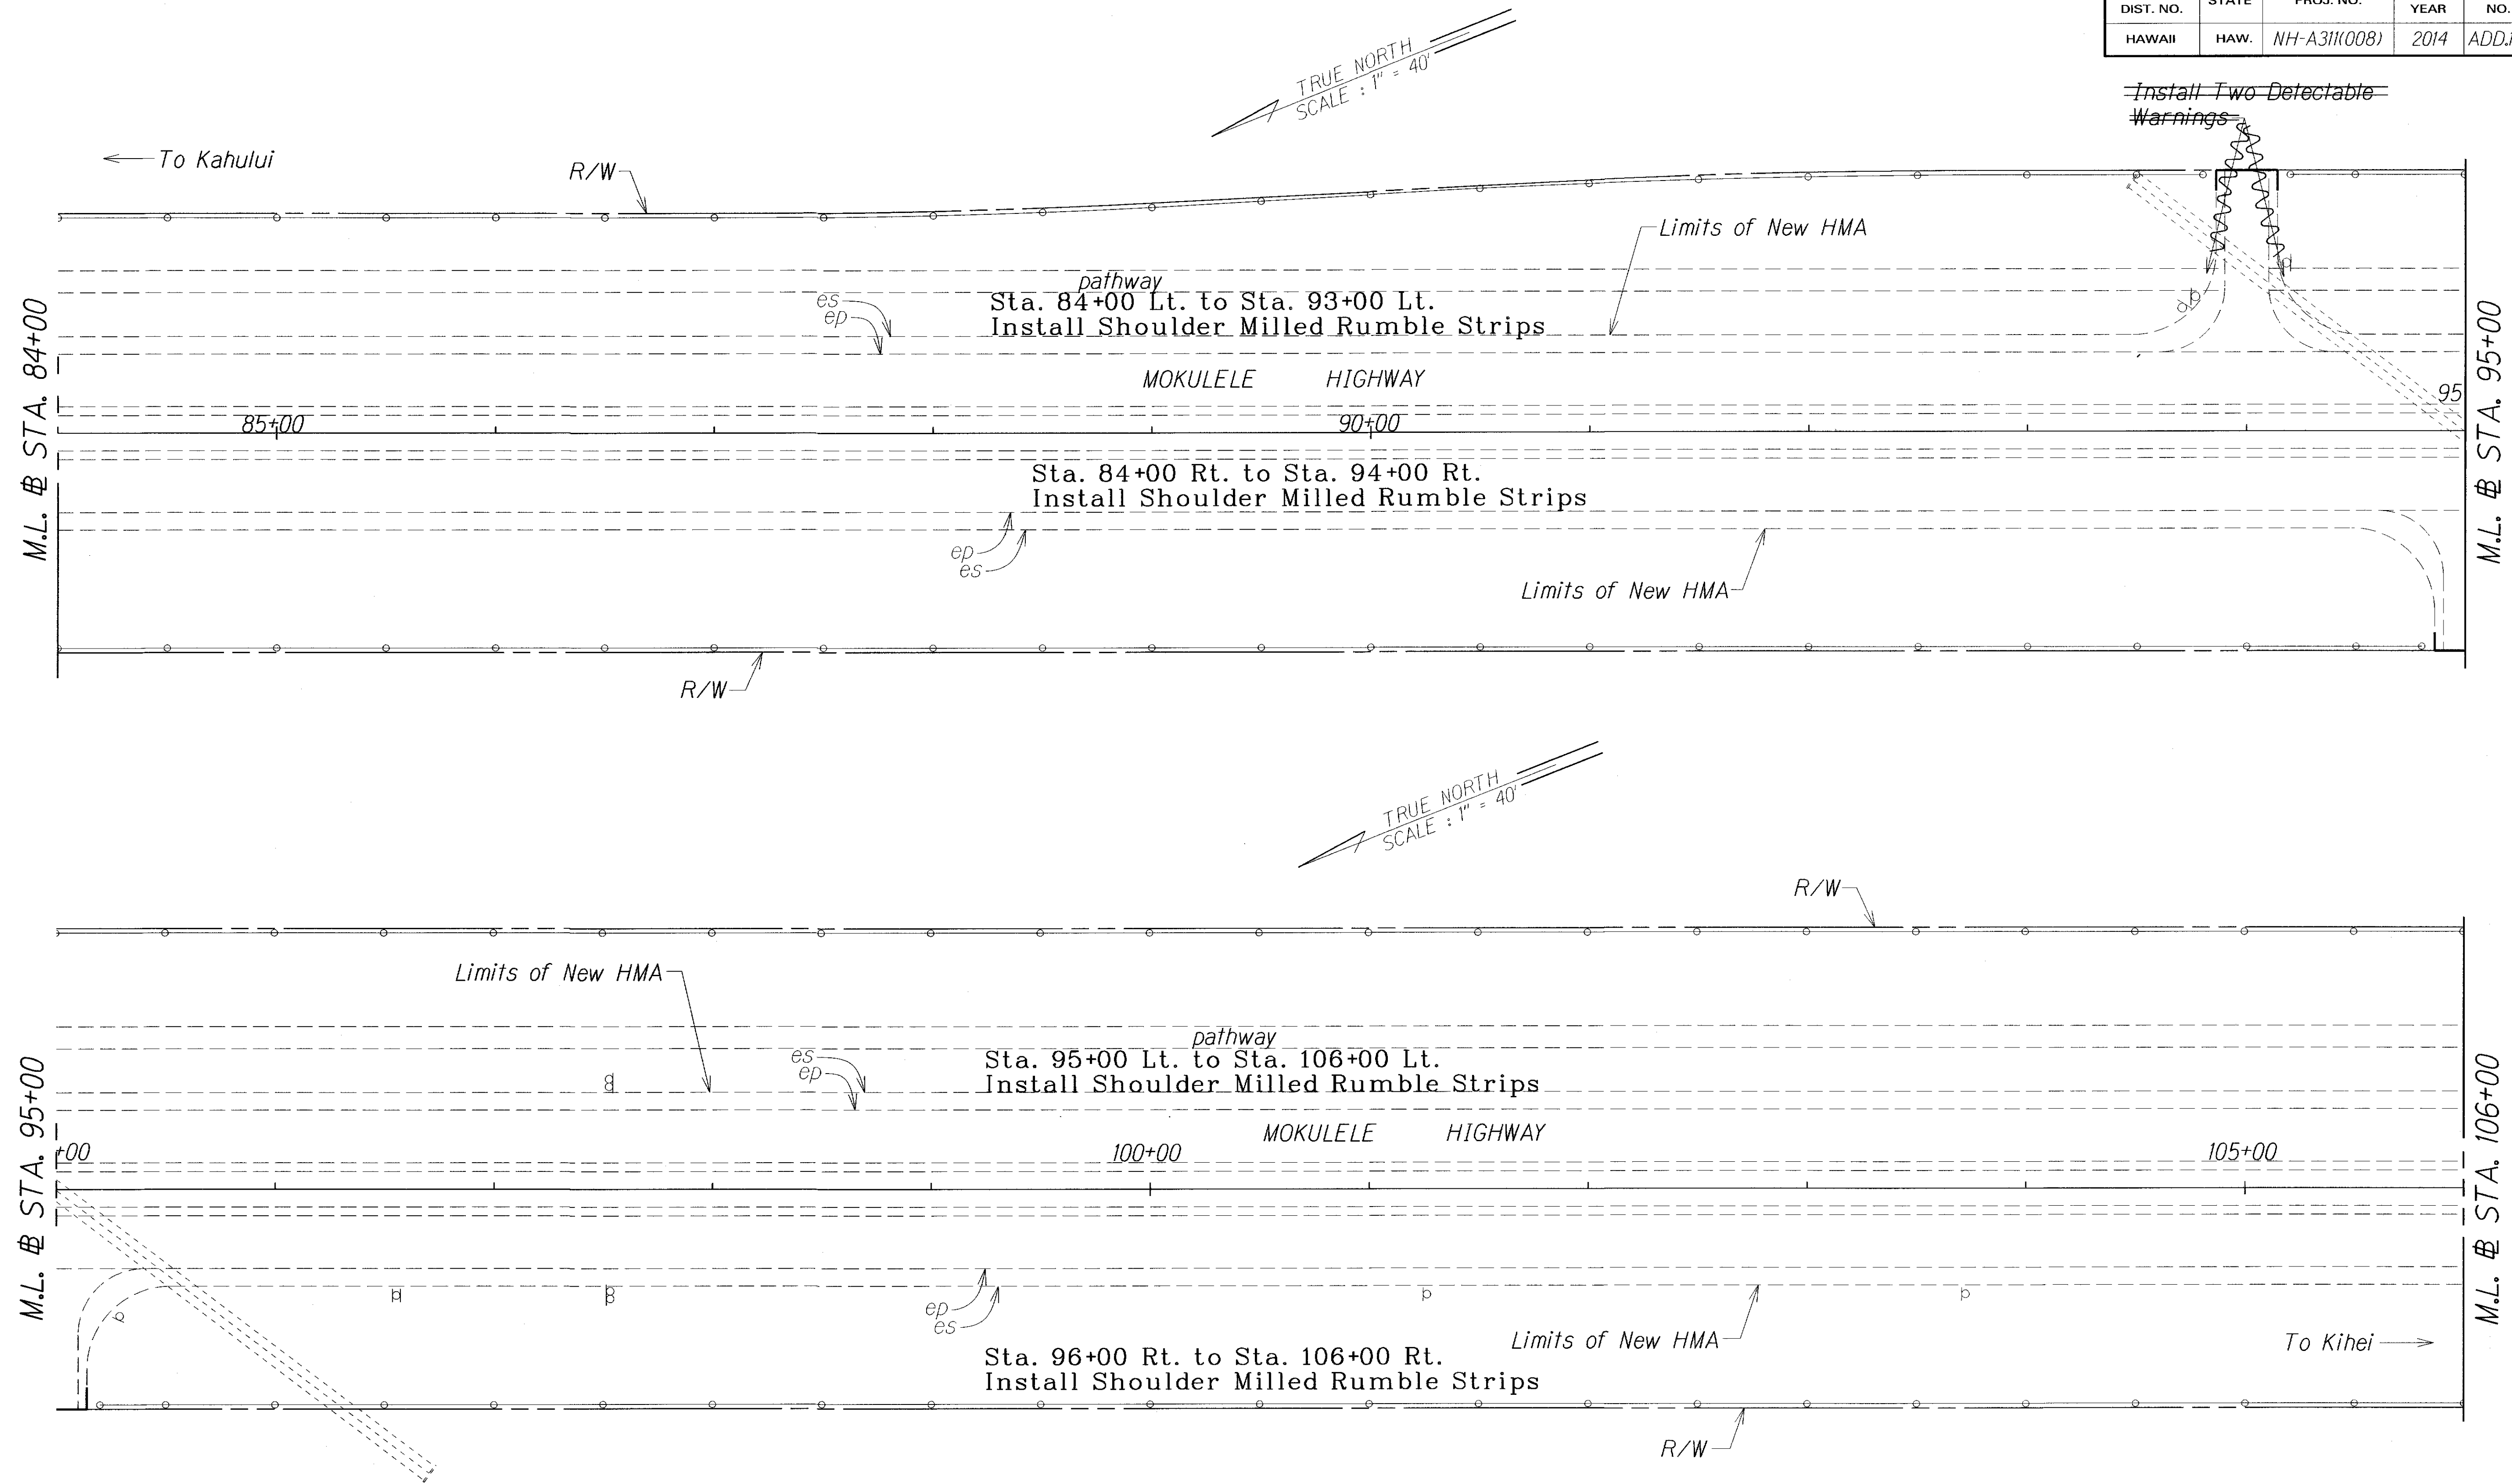

**NOTES:**

- ~~1. Seal all cracks as directed by the Engineer. Payment is subsidiary to Item 401.1000.~~
2. Install Shoulder Milled Rumble Strips from Sta. 0+00 to Sta. 170+00 as directed by the Engineer. There are no Centerline Milled Rumble Strips for this project.
3. Place Detectable Warnings as directed by the Engineer.

**LEGEND FOR AS-BUILT POSTINGS**

	Squiggly line for as-built deletion
	Double line for as-built deletion
Roadway	Text for as-built posting

6-6-14 Revised Notes No. 2.


DATE REVISION

STATE OF HAWAII DEPARTMENT OF TRANSPORTATION HIGHWAYS DIVISION	
<b>ROADWAY PLAN</b>	
RTE 311 MOKULELE HIGHWAY	
PAVEMENT PREVENTIVE MAINTENANCE	
Kuihelani Highway to Maui Humane Society	
Federal-Aid Project No. NH-A311(008)	
Scale: 1" = 40'	Date: January, 2014
SHEET No. 6 OF 9 SHEETS	

"AS-BUILT"

ADD. 16

FED. ROAD DIST. NO.	STATE	FED. AID PROJ. NO.	FISCAL YEAR	SHEET NO.	TOTAL SHEETS
HAWAII	HAW.	NH-A311(008)	2014	ADD.17	32

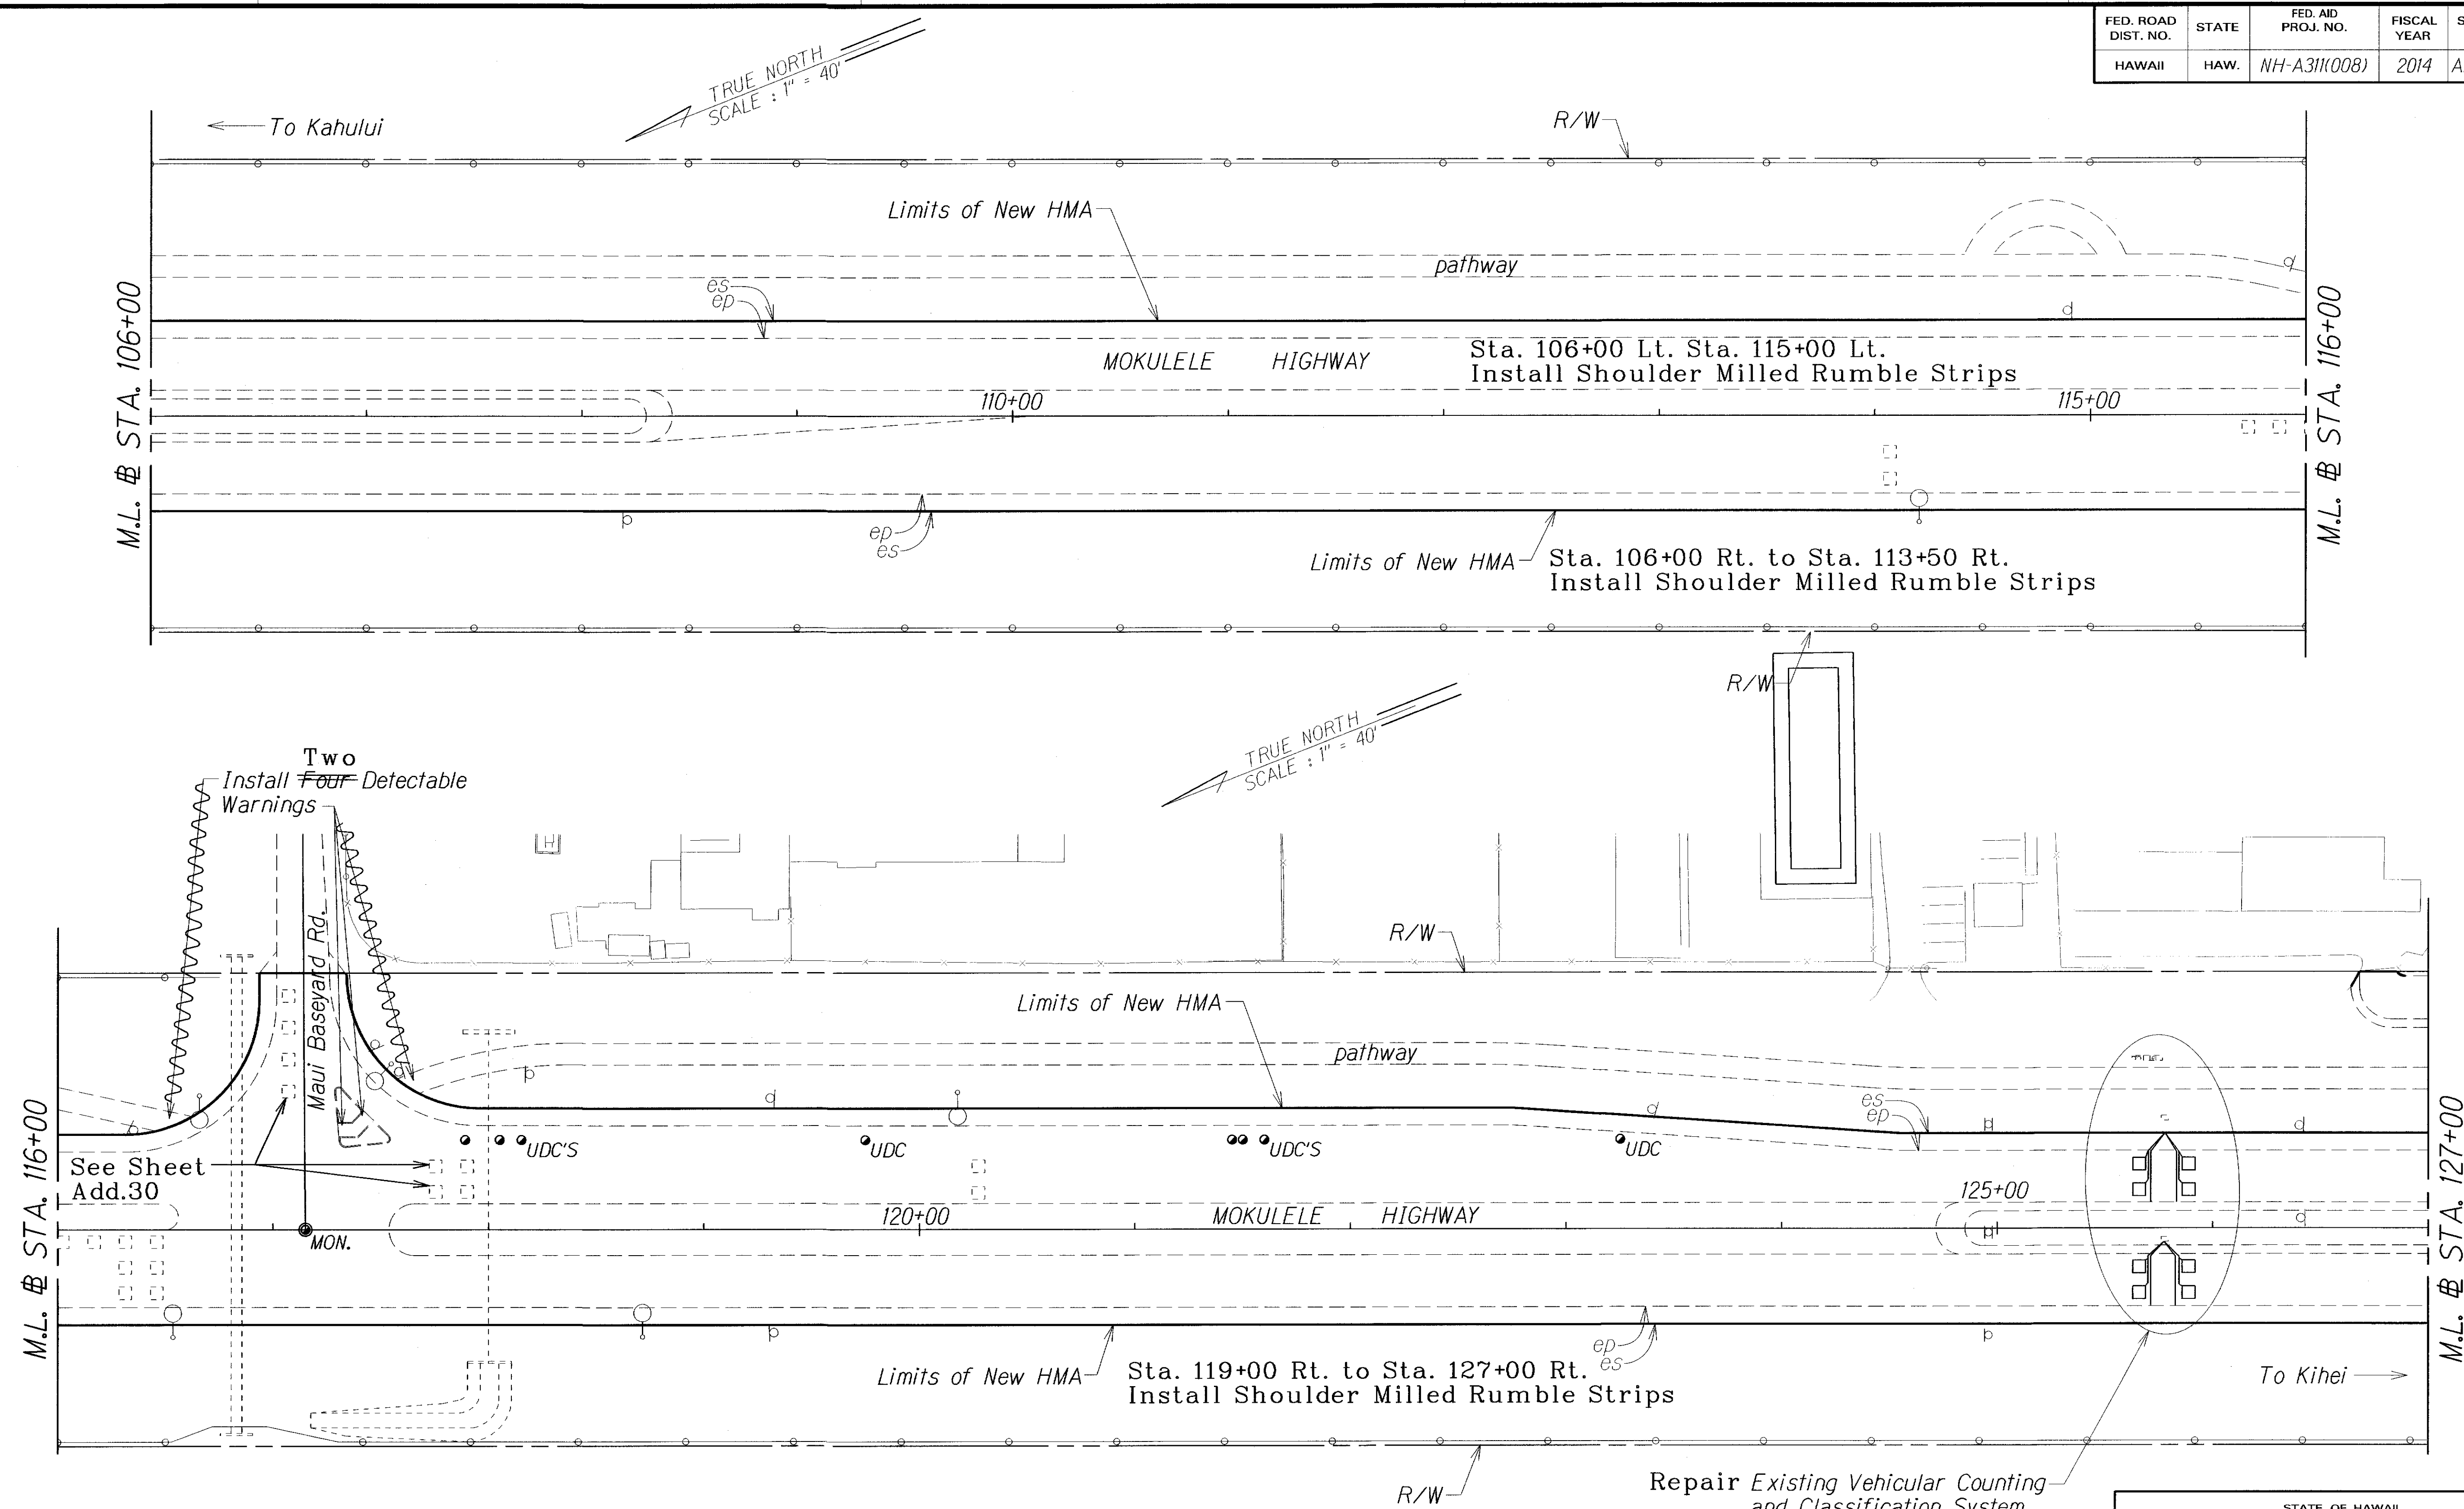

**NOTES:**

1. Seal all cracks as directed by the Engineer. Payment is subsidiary to Item 401.1000.
2. Install Shoulder Milled Rumble Strips from Sta. 0+00 to Sta. 170+00 as directed by the Engineer. There are no Centerline Milled Rumble Strips for this project.
3. Place Detectable Warnings as directed by the Engineer.

4. Test equipment at the Vehicular Counting and Classification Station after construction to ensure proper functionality, fix if necessary at the direction of the Engineer. Payment to be made under Item 623.1000.

**LEGEND FOR AS-BUILT POSTINGS**

	Squiggly line for as-built deletion
	Double line for as-built deletion
Roadway	Text for as-built posting

6-6-14 Revised Notes No. 2.


DATE REVISION

STATE OF HAWAII DEPARTMENT OF TRANSPORTATION HIGHWAYS DIVISION	
<b>ROADWAY PLAN</b>	
RTE 311 MOKULELE HIGHWAY	
PAVEMENT PREVENTIVE MAINTENANCE	
Kuihelani Highway to Maui Humane Society	
Federal-Aid Project No. NH-A311(008)	
Scale: 1" = 40'	Date: January, 2014
SHEET No. 7 OF 9 SHEETS	

"AS-BUILT"

ADD. 17

FED. ROAD DIST. NO.	STATE	FED. AID PROJ. NO.	FISCAL YEAR	SHEET NO.	TOTAL SHEETS
HAWAII	HAW.	NH-A311(008)	2014	ADD.18	32

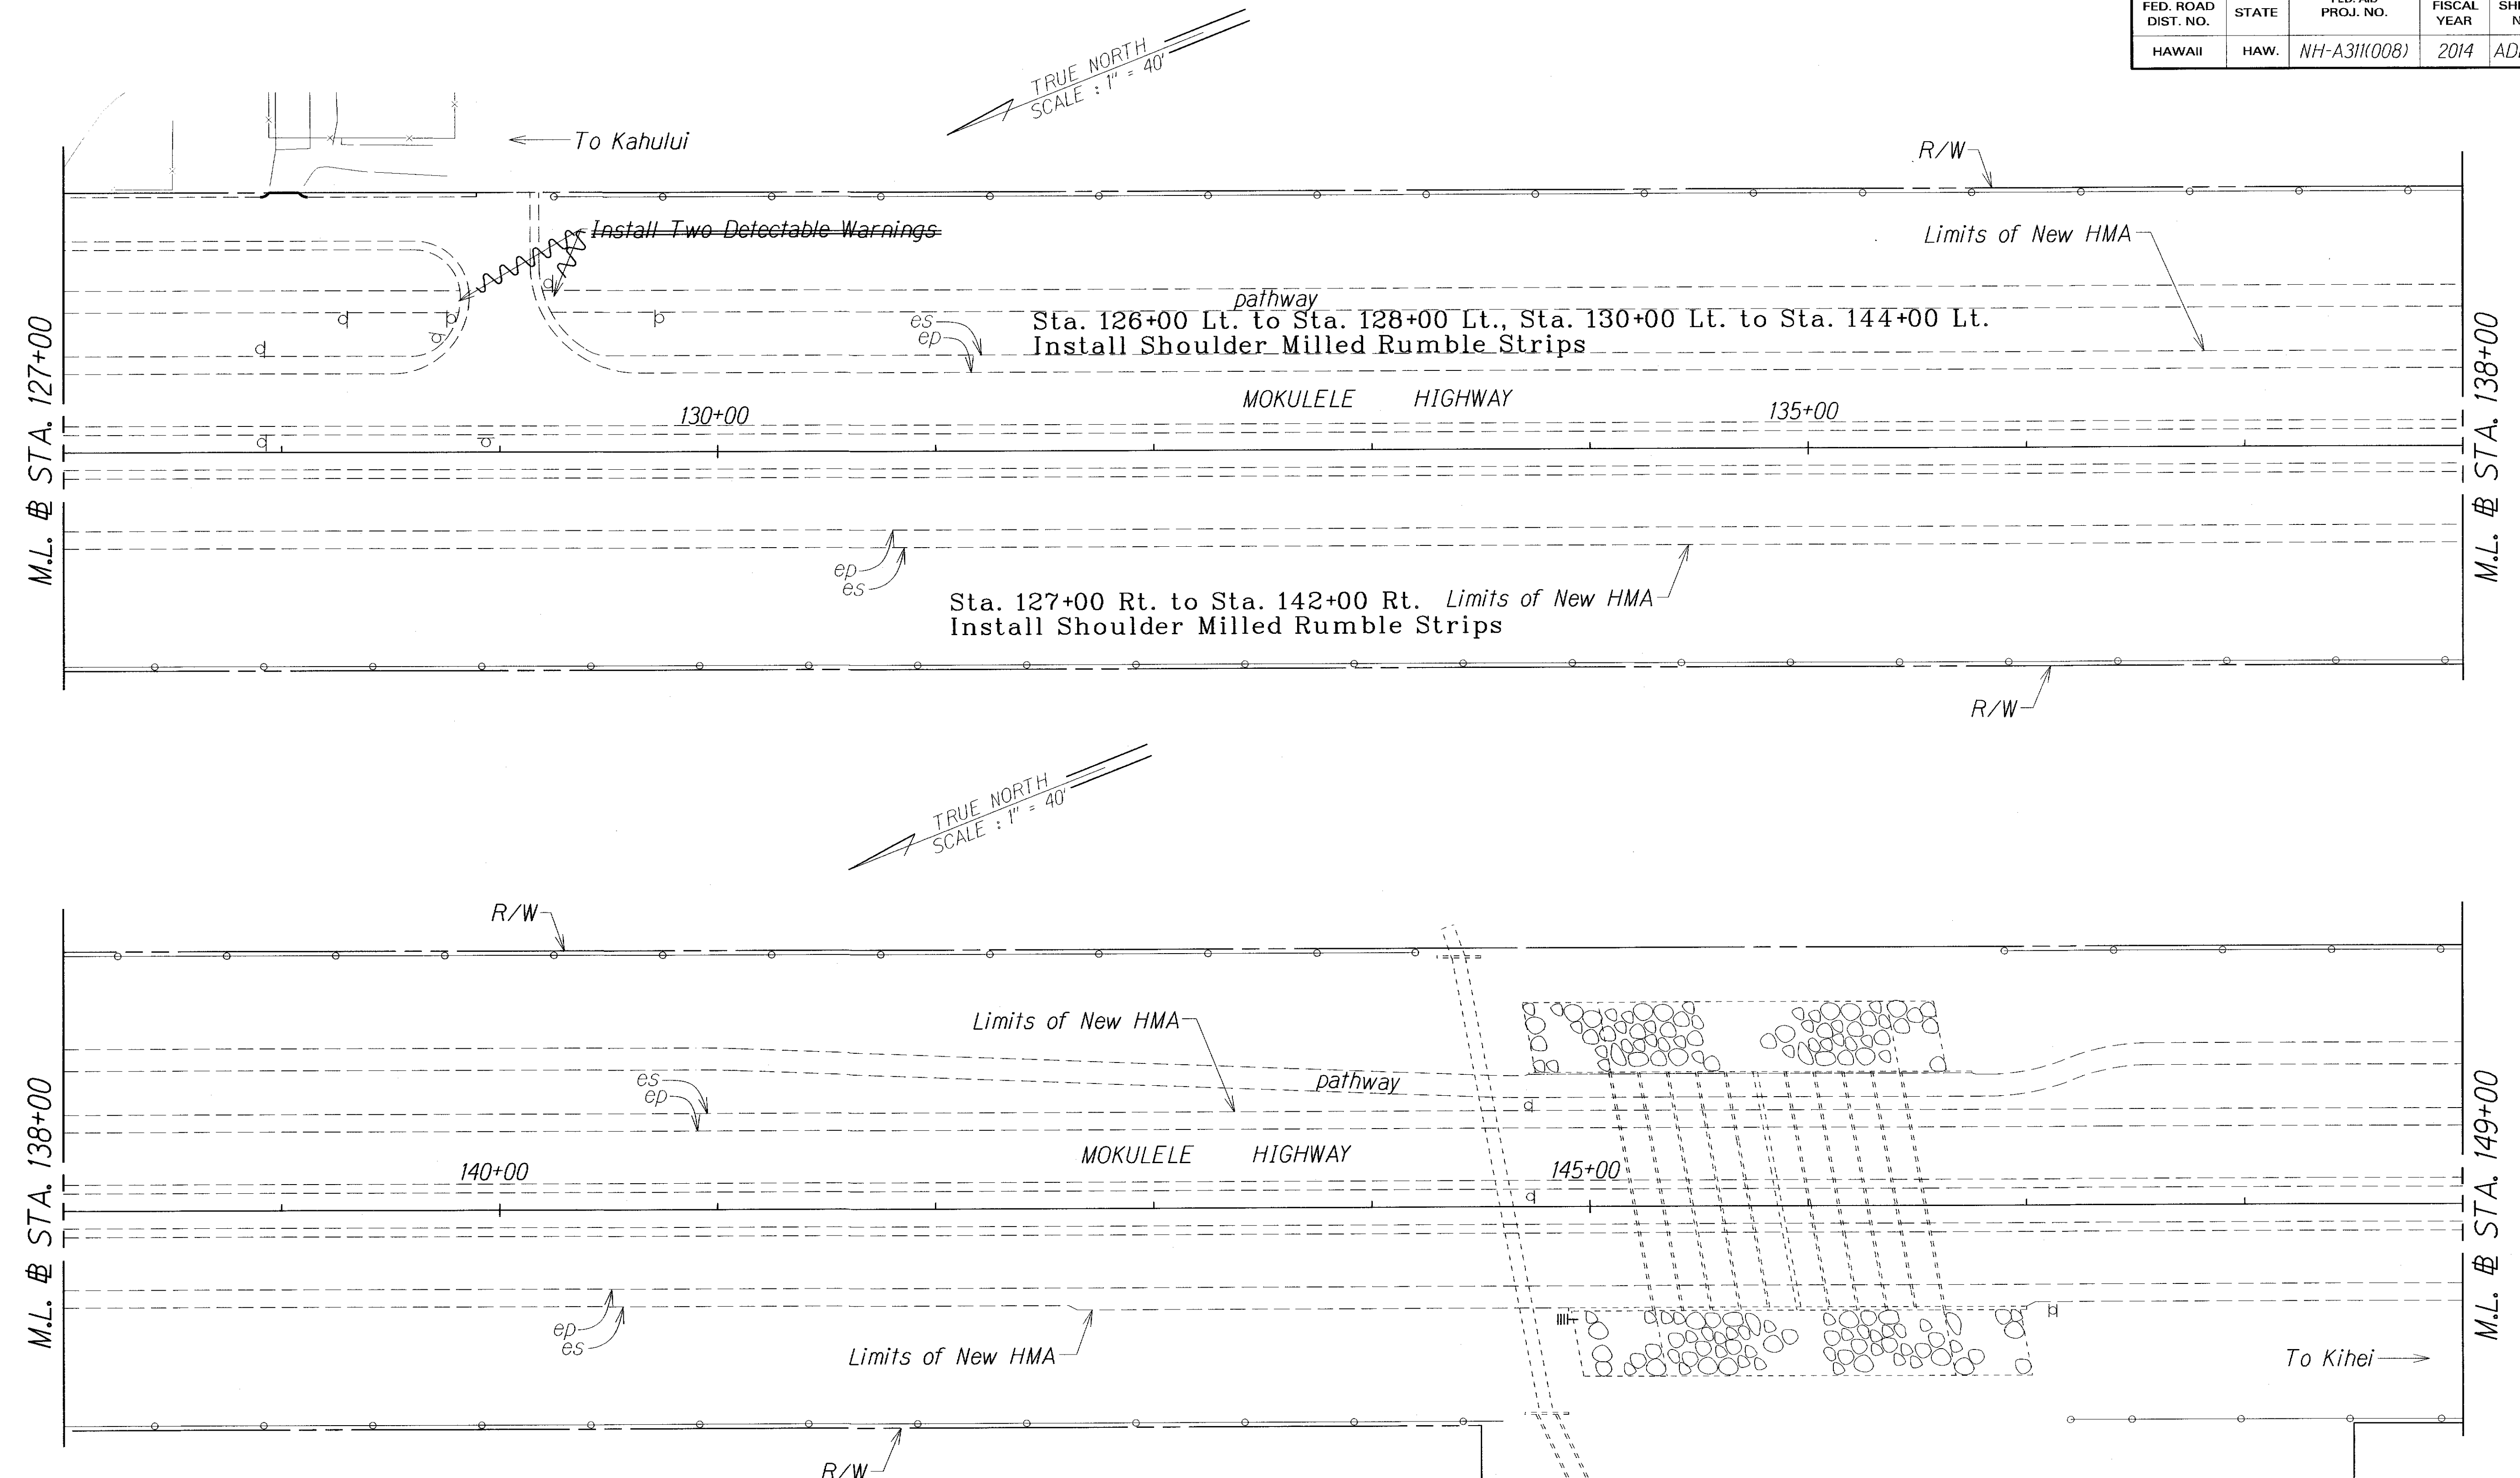

#### NOTES:

1. Seal all cracks as directed by the Engineer. Payment is subsidiary to Item 401.1000.
2. Install Shoulder Milled Rumble Strips from Sta. 0+00 to Sta. 170+00 as directed by the Engineer. There are no Centerline Milled Rumble Strips for this project.
3. Place Detectable Warnings as directed by the Engineer.

#### LEGEND FOR AS-BUILT POSTINGS

	Squiggly line for as-built deletion
	Double line for as-built deletion
Roadway	Text for as-built posting

6-6-14 Revised Notes No. 2.

DATE REVISION


STATE OF HAWAII DEPARTMENT OF TRANSPORTATION HIGHWAYS DIVISION	
<b>ROADWAY PLAN</b>	
RTE 311 MOKULELE HIGHWAY	
PAVEMENT PREVENTIVE MAINTENANCE	
Kuihelani Highway to Maui Humane Society	
Federal-Aid Project No. NH-A311(008)	
Scale: 1" = 40'	Date: January, 2014
SHEET No. 8 OF 9 SHEETS	

"AS-BUILT"

ADD. 18

ORIGINAL PLAN	SURVEY PLOTTED BY	DATE
NOTE BOOK	DRAWN BY	
	DESIGNED BY	
	CHECKED BY	

FED. ROAD DIST. NO.	STATE	FED. AID PROJ. NO.	FISCAL YEAR	SHEET NO.	TOTAL SHEETS
HAWAII	HAW.	NH-A311(008)	2014	ADD.19	32

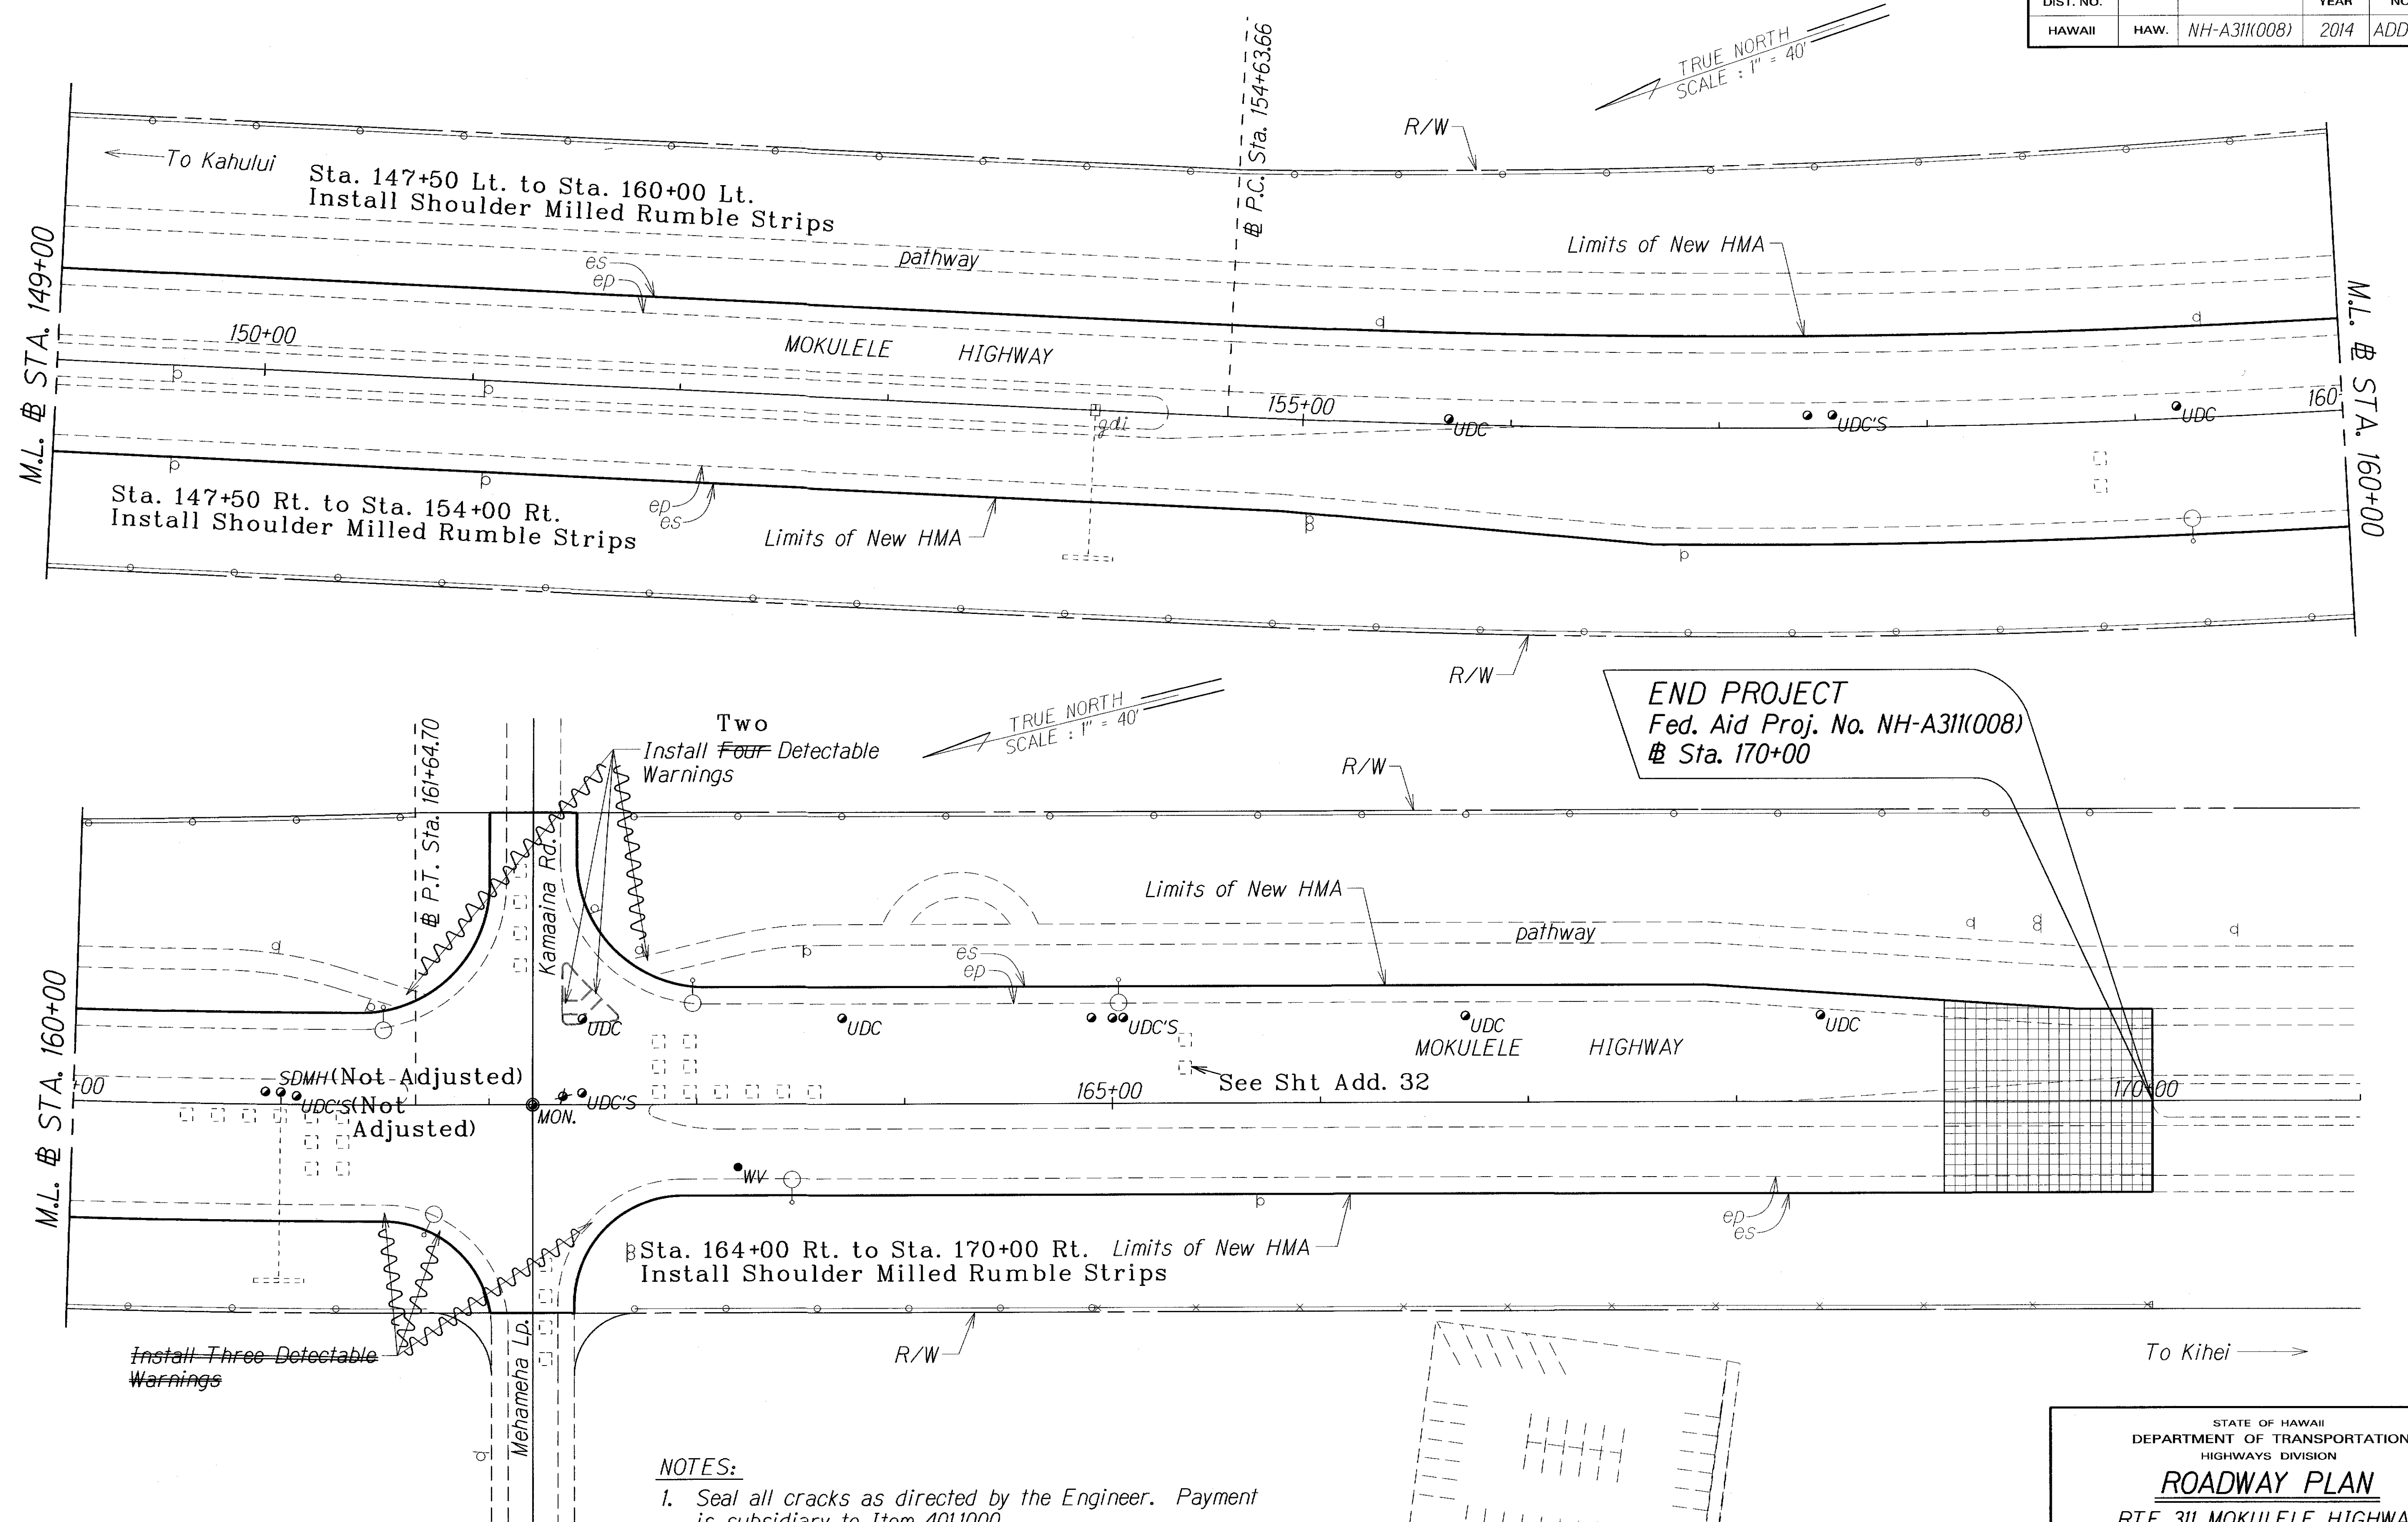

SURVEY PLOTTED BY	DATE
DRAWN BY	
TRACED BY	
CHECKED BY	
ORIGINAL PLAN	
NOTE BOOK	
CHECKED BY	

LEGEND FOR AS-BUILT POSTINGS	
	Squiggly line for as-built deletion
	Double line for as-built deletion
Roadway	Text for as-built posting

**NOTES:**

1. Seal all cracks as directed by the Engineer. Payment is subsidiary to Item 401.1000.
2. Install Shoulder Milled Rumble Strips from Sta. 0+00 to Sta. 170+00 as directed by the Engineer. There are no Centerline Milled Rumble Strips for this project.
3. Place Detectable Warnings as directed by the Engineer.

6-6-14 Revised Notes No. 2.

DATE REVISION

STATE OF HAWAII DEPARTMENT OF TRANSPORTATION HIGHWAYS DIVISION	
<b>ROADWAY PLAN</b>	
RTE 311 MOKULELE HIGHWAY PAVEMENT PREVENTIVE MAINTENANCE Kuihelani Highway to Maui Humane Society Federal-Aid Project No. NH-A311(008)	
Scale: 1" = 40'	Date: January, 2014
SHEET No. 9 OF 9 SHEETS	

"AS-BUILT"

ADD. 19