


INDEX TO DRAWINGS	
SHEET NO	DESCRIPTION
1	TITLE SHEET
2	TYPICAL SECTION & GEN. NOTES
3 - 4	HONOAPIILANI HWY. RESURF. PLAN
5	WHARF ST. RESURFACING PLAN

STATE OF HAWAII
DEPARTMENT OF TRANSPORTATION
LAND TRANSPORTATION FACILITIES DIVISION
HONOLULU, HAWAII
"AS - BUILT "
PLANS FOR
RESURFACING
HONOAPIILANI HIGHWAY (FAP 30)
(PALI TUNNEL TOWARDS MAALAEA)
AND WHARF STREET (SR 361)
PROJECT NO. LT-M-01-78M
DISTRICTS OF LAHAINA AND WAILUKU
ISLAND OF MAUI

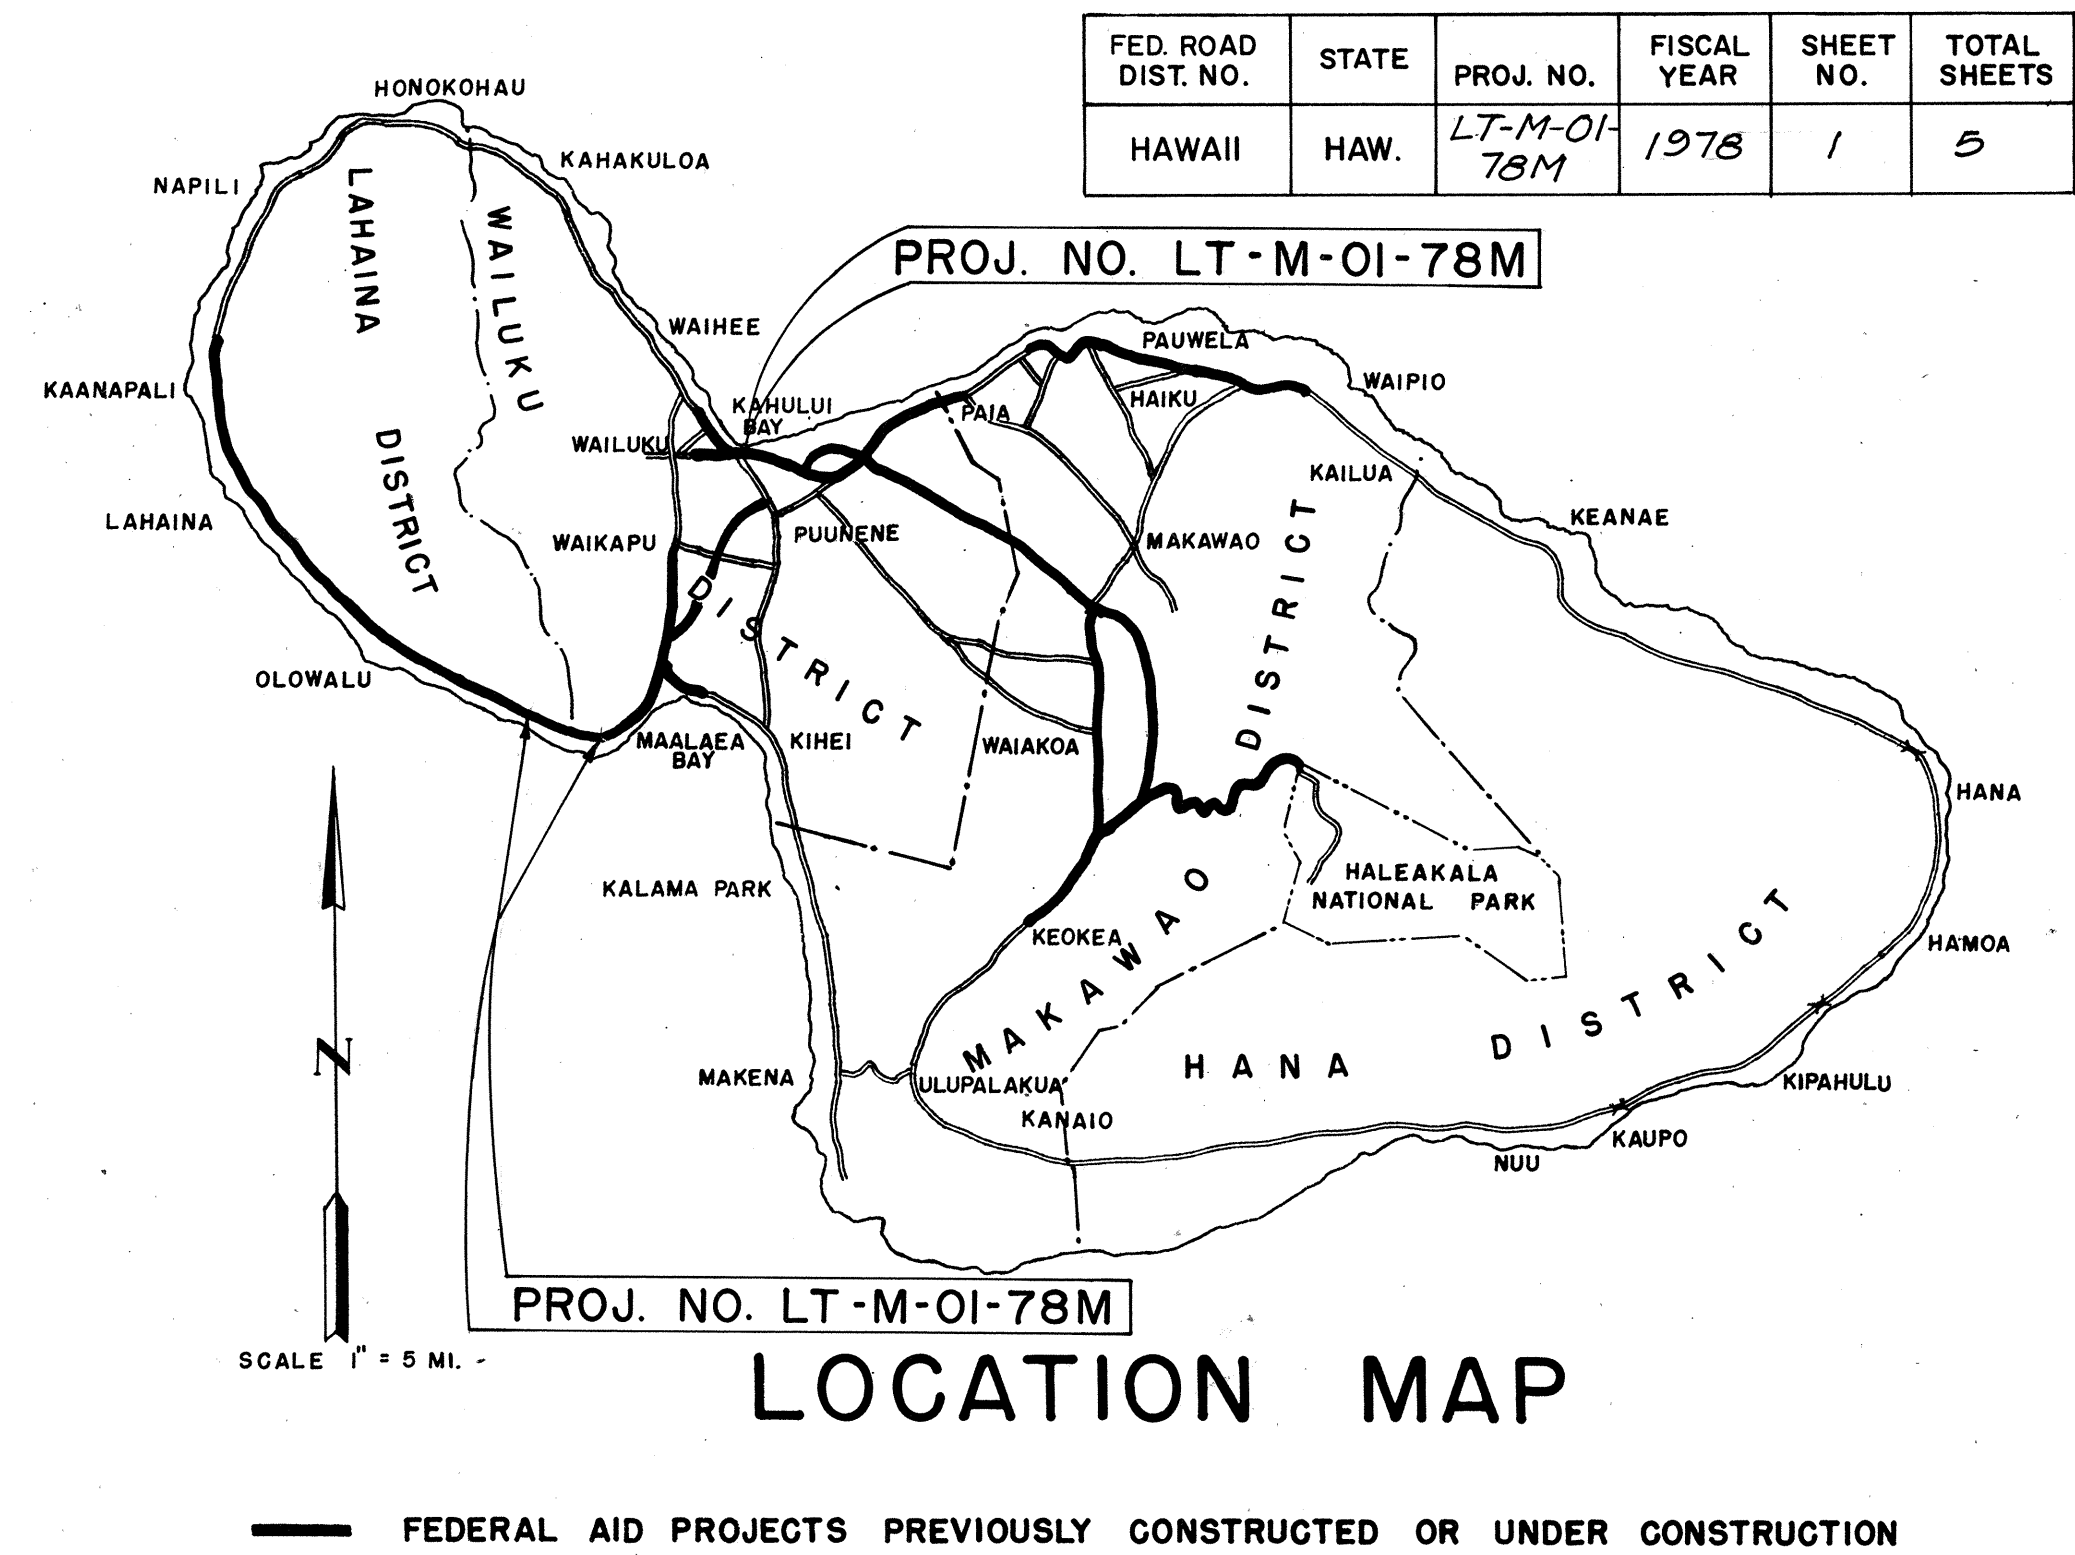

Maui District

DESIGNED BY

Mike Miura

P.S. & E. BY

"C"



HWY. DESIGN UNIT

548-7490

PHONE

Nov. 1977

DATE

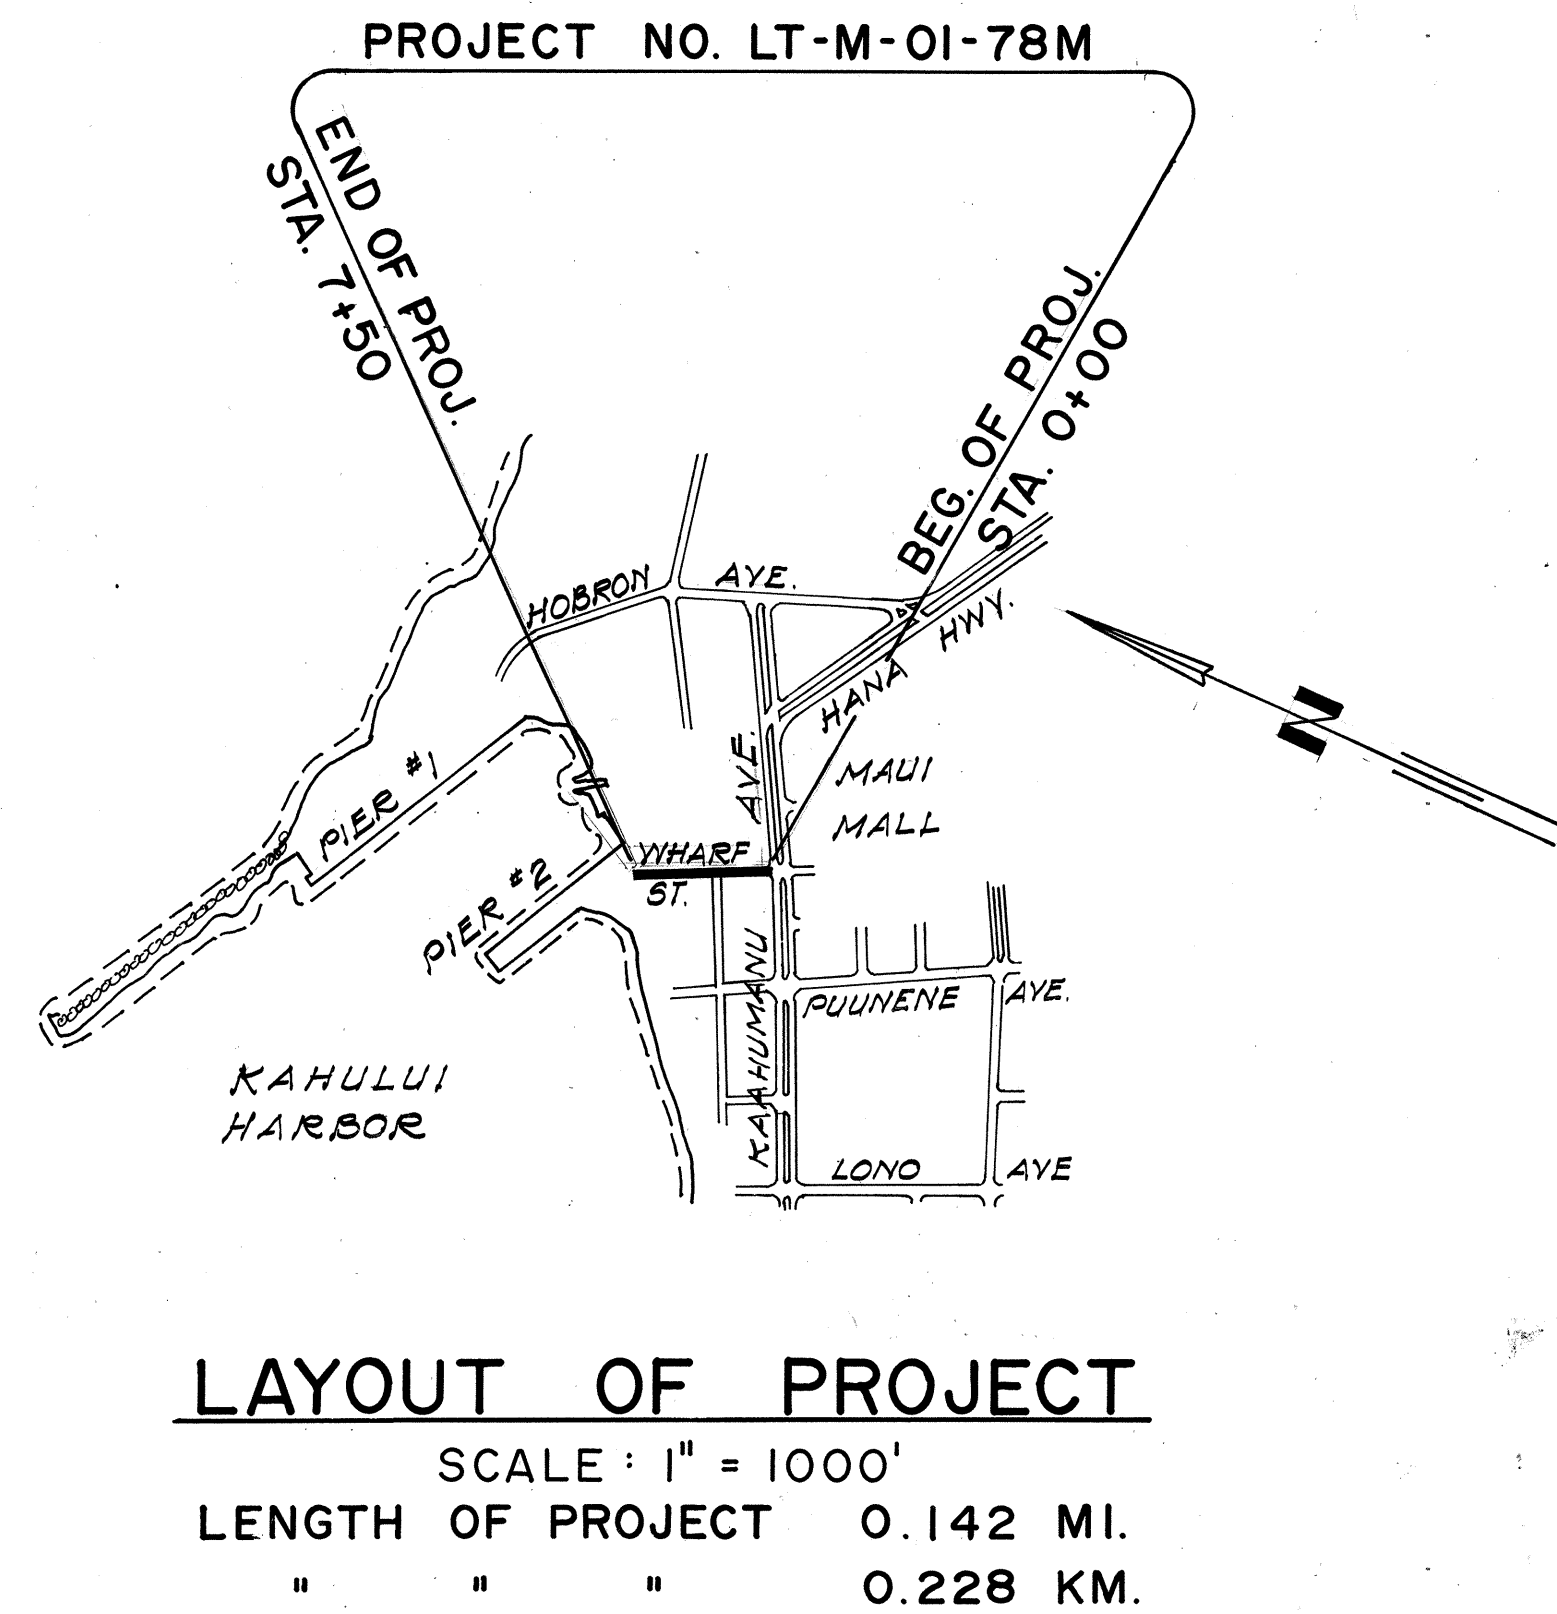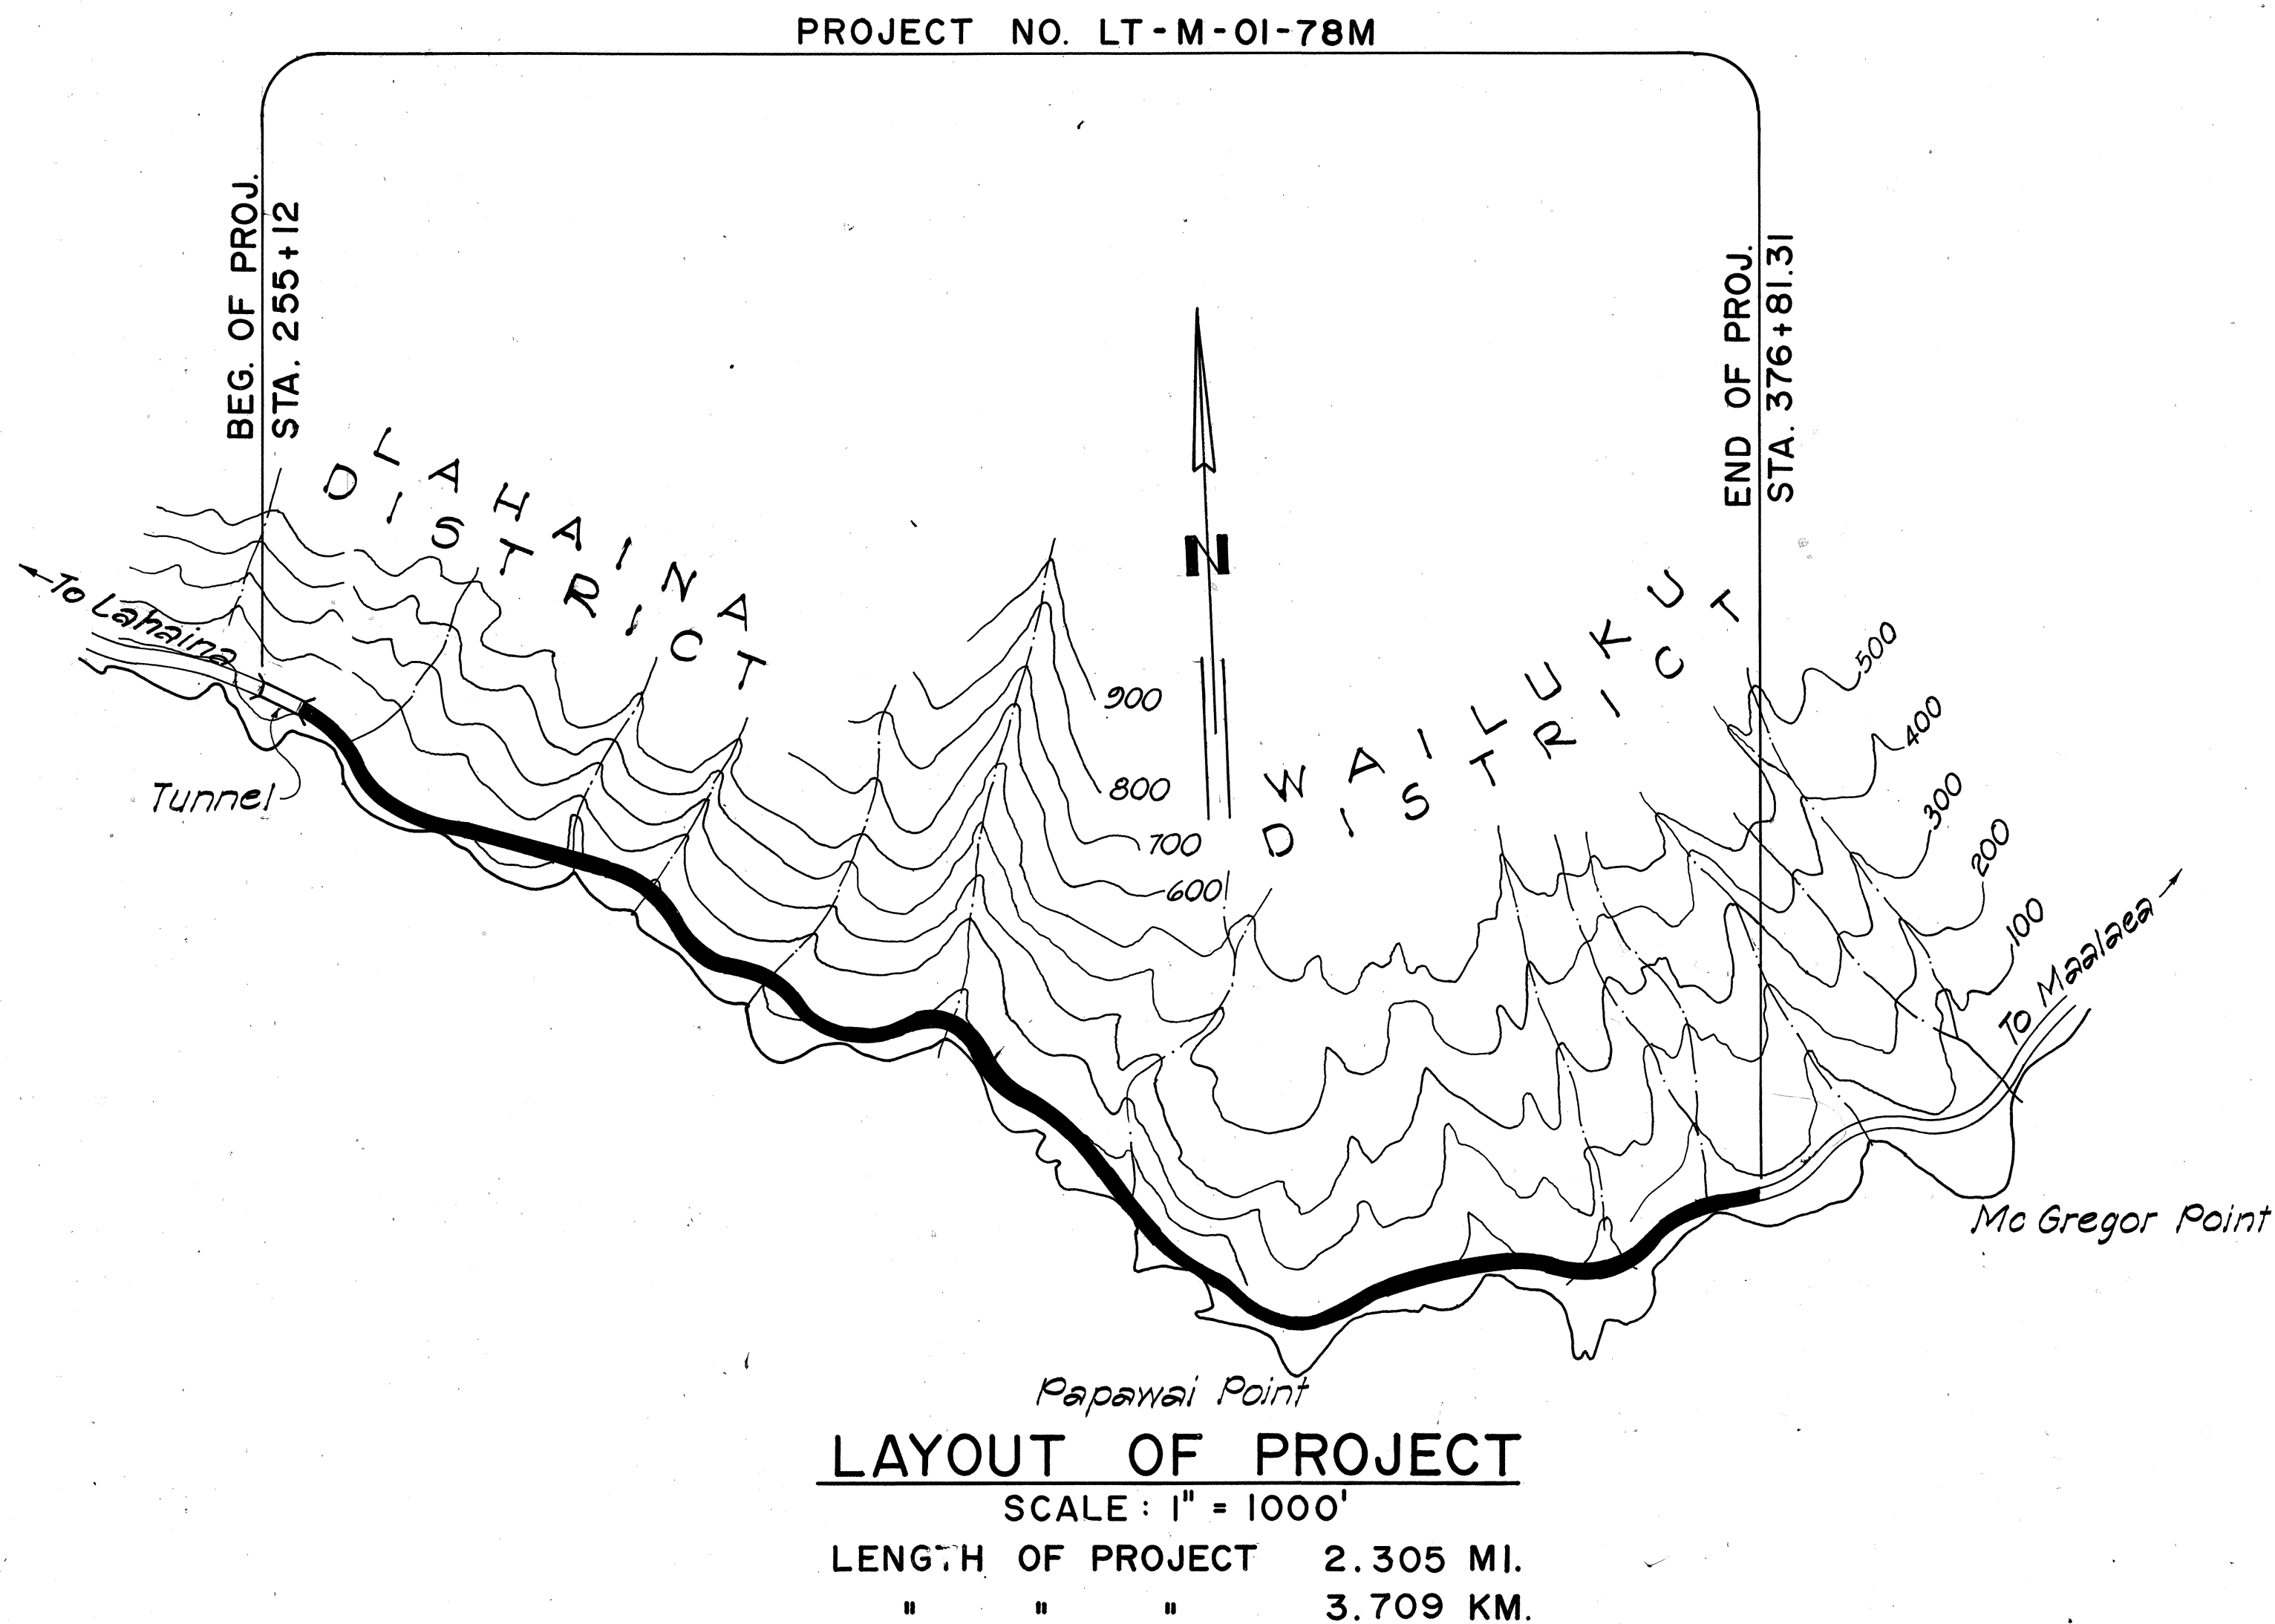

NO CHANGES WERE MADE DURING CONSTRUCTION ON THESE PLANS EXCEPT CHANGES IN THE ORIGINAL THEORETICAL QUANTITIES. FOR ACTUAL QUANTITIES, REFER TO PROJECT LEDGER AND/OR COMPUTATION BOOK.

George N. Kaya

RESIDENT ENGINEER

9-24-79

DATE

DEPARTMENT OF TRANSPORTATION

STATE OF HAWAII

APPROVED:

R. Higashionna

2/27/78

DATE

DIR. OF TRANSPORTATION