
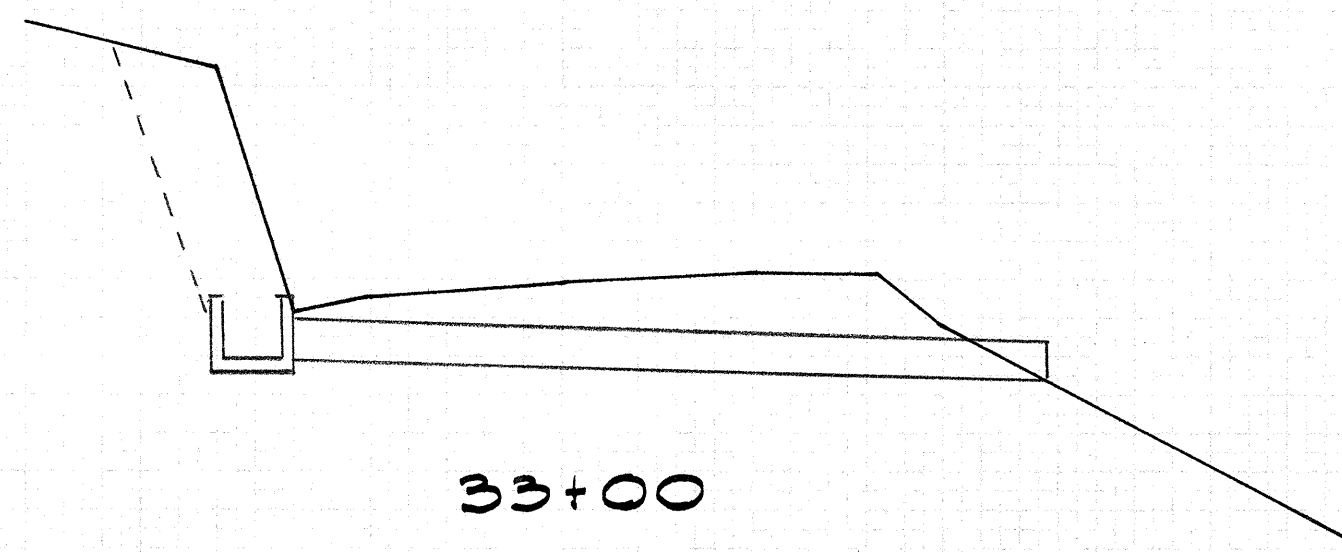
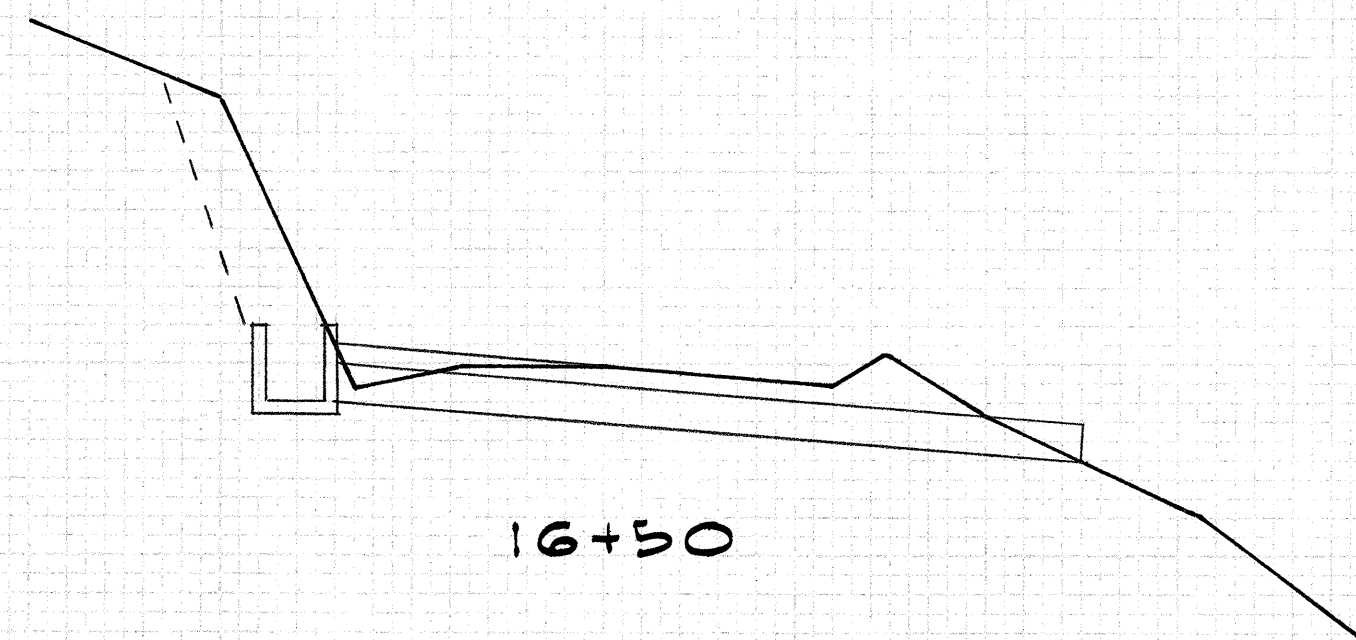
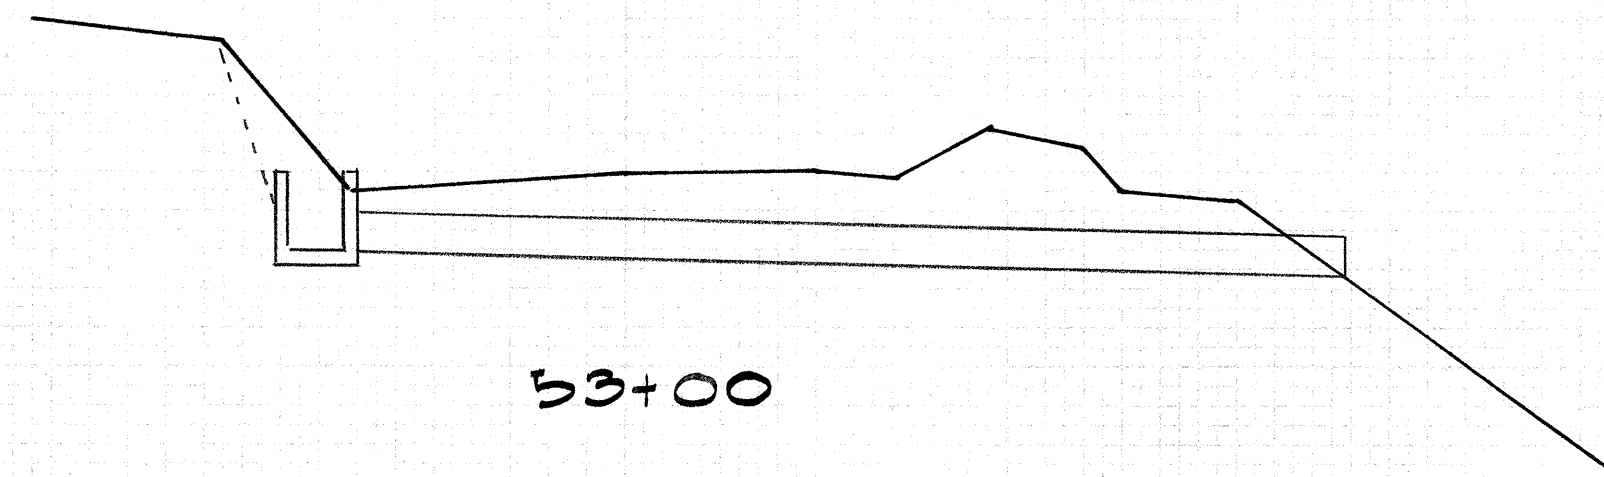
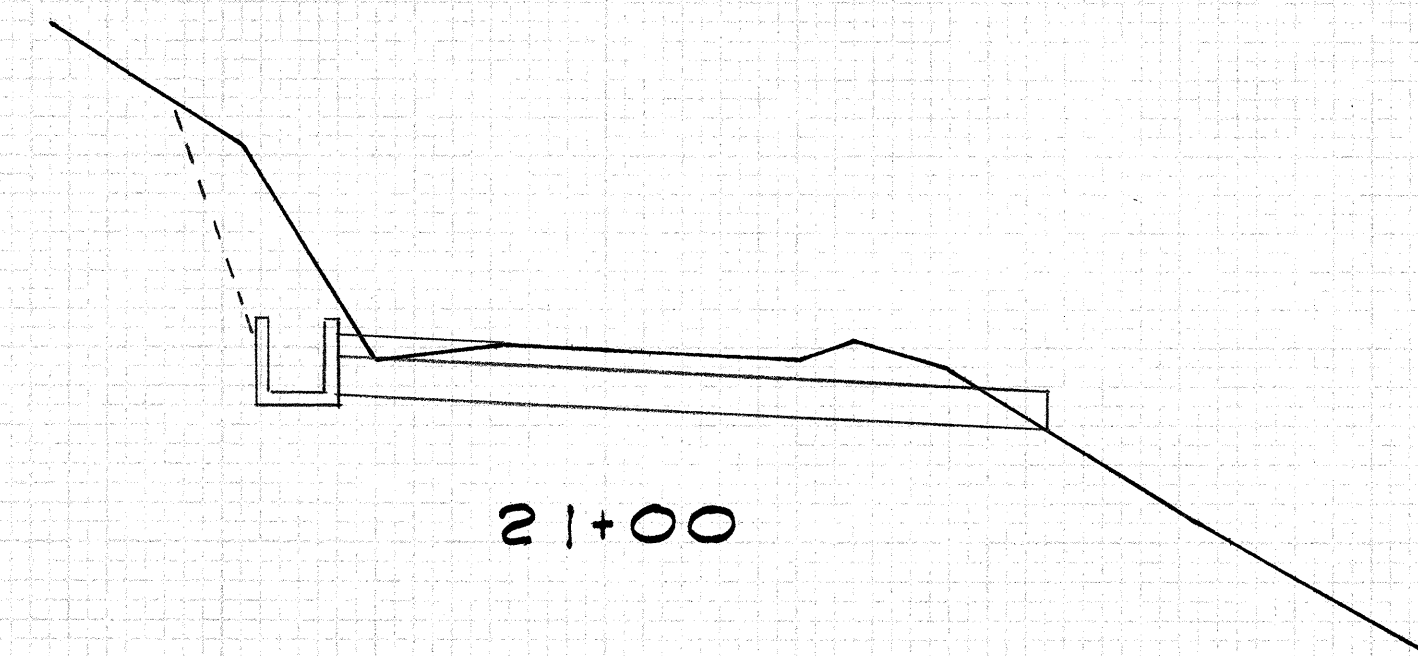
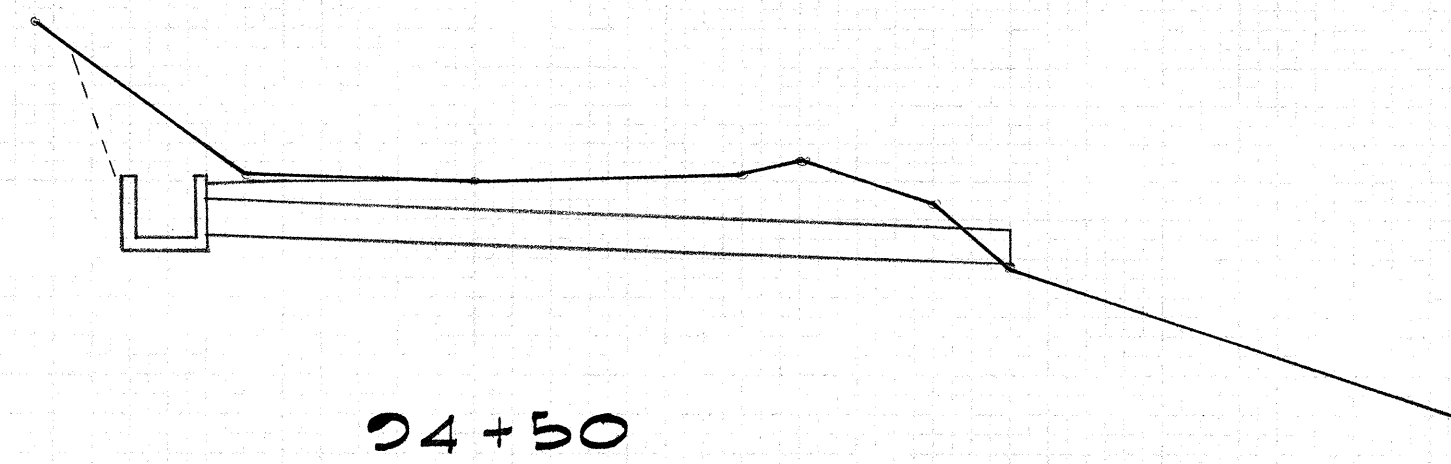


DATE	
BY	
REVISION	
NO.	
DATE	
BY	
REVISION	
NO.	

DATE	
BY	
REVISION	
NO.	
DATE	
BY	
REVISION	
NO.	

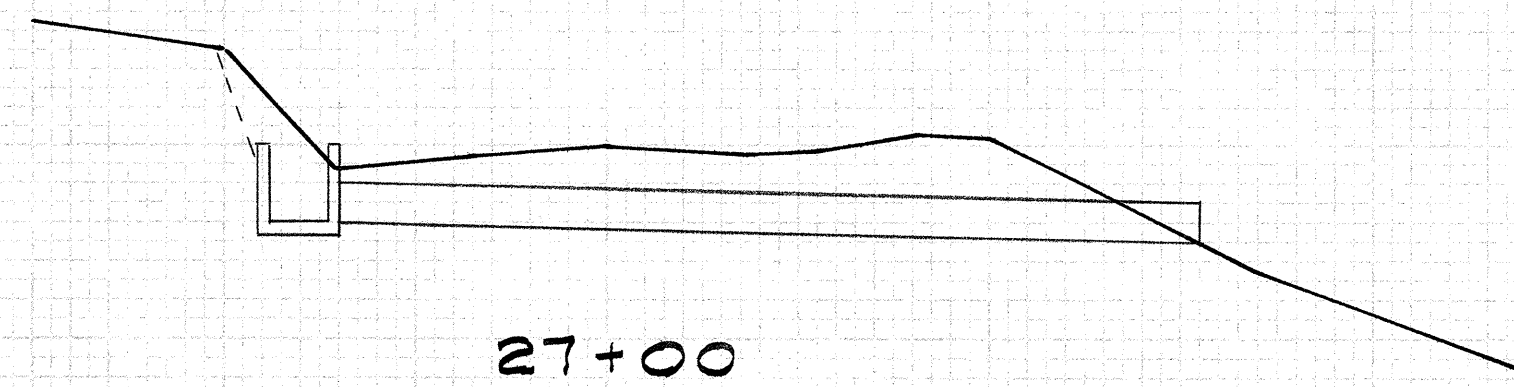

Date : Sept. 8, 1967

PROJ. NO. 330C-02-67