
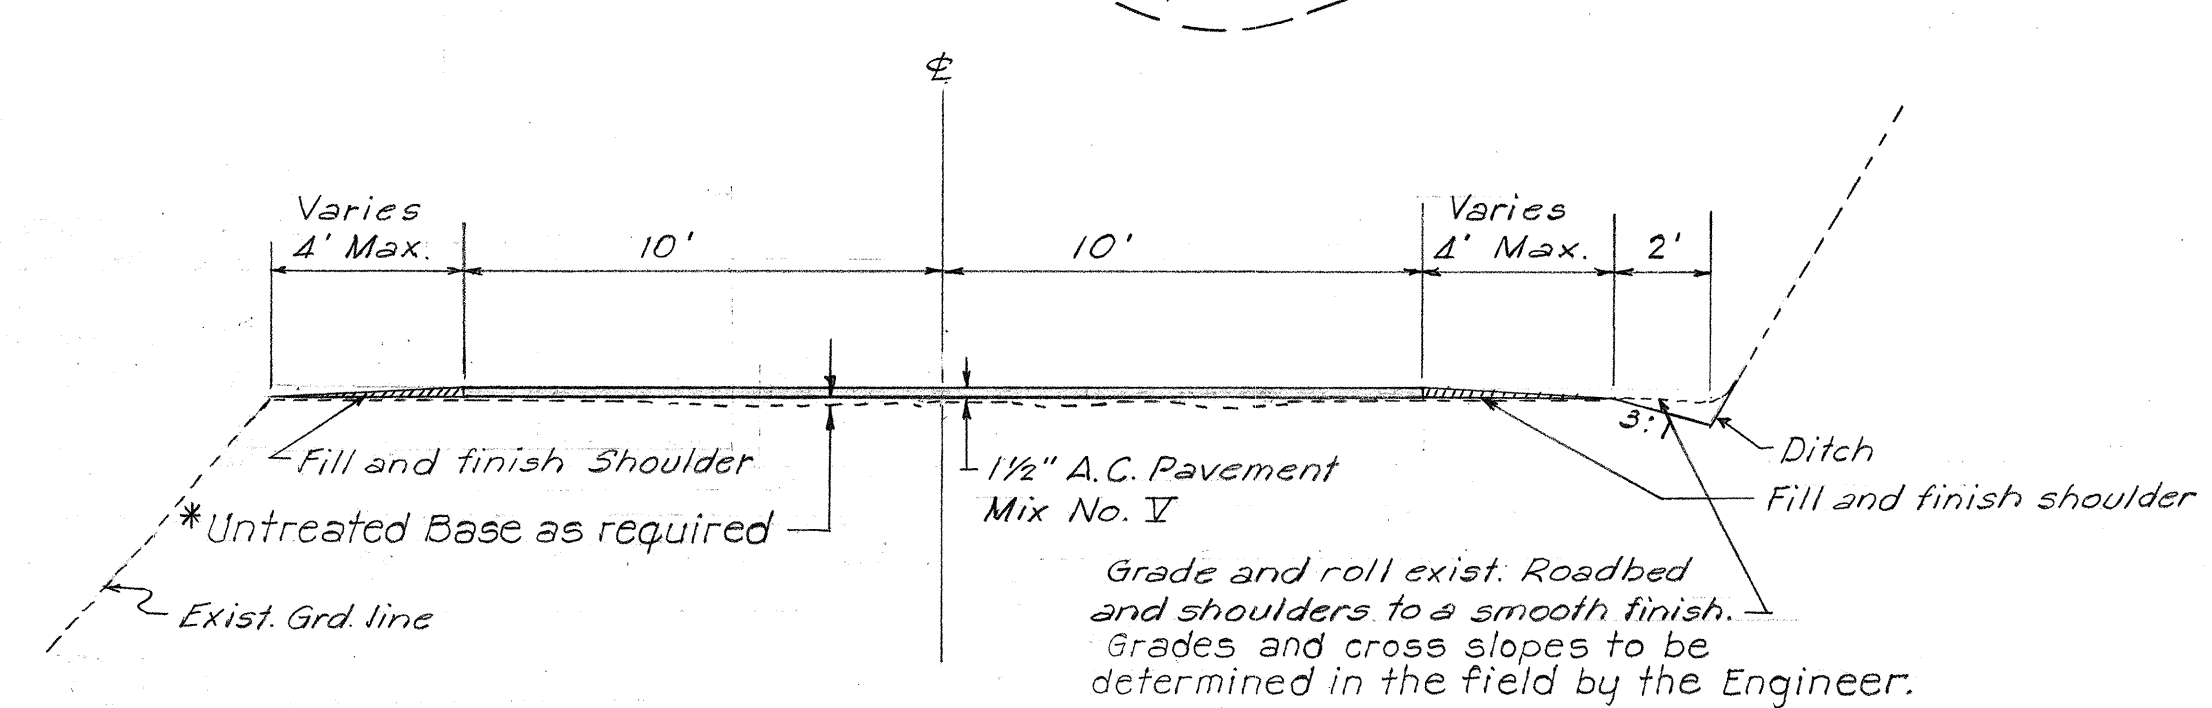


FED. ROAD DIST. NO.	STATE	FED. AID PROJ. NO.	FISCAL YEAR	SHEET NO.	TOTAL SHEETS
HAWAII	HAW.				

General Notes.

1. Exact location of improvement to be determined in field by Engineer.
2. Exact location of culverts to be determined in field by Engineer. Struc. Exc. and Backfill, for installing culverts will not be measured and paid for directly, but will be considered incidental to the contract item for culverts. Minimum cover over culvert shall be 18 inches. Minimum slope of culverts shall be one percent.
3. Struc. Exc. and Backfill for conc. Drop Intakes will be considered incidental to the contract item for Class B-1 Concrete.
4. Excavation for reshaping the roadway including shoulders and ditches, removing objectionable material from ditches, inlets and outlets of culverts, and excavation for recesses at all drop intakes shall be incidental to the contract item for Reshaping Road Surface.
5. The wooden bridge across Waihee River is rated at a 5-Ton safe load. The Contractor shall make necessary arrangements to take necessary precautions that the bridge is not damaged. All costs to repair any damage due to his operations shall be borne by him.

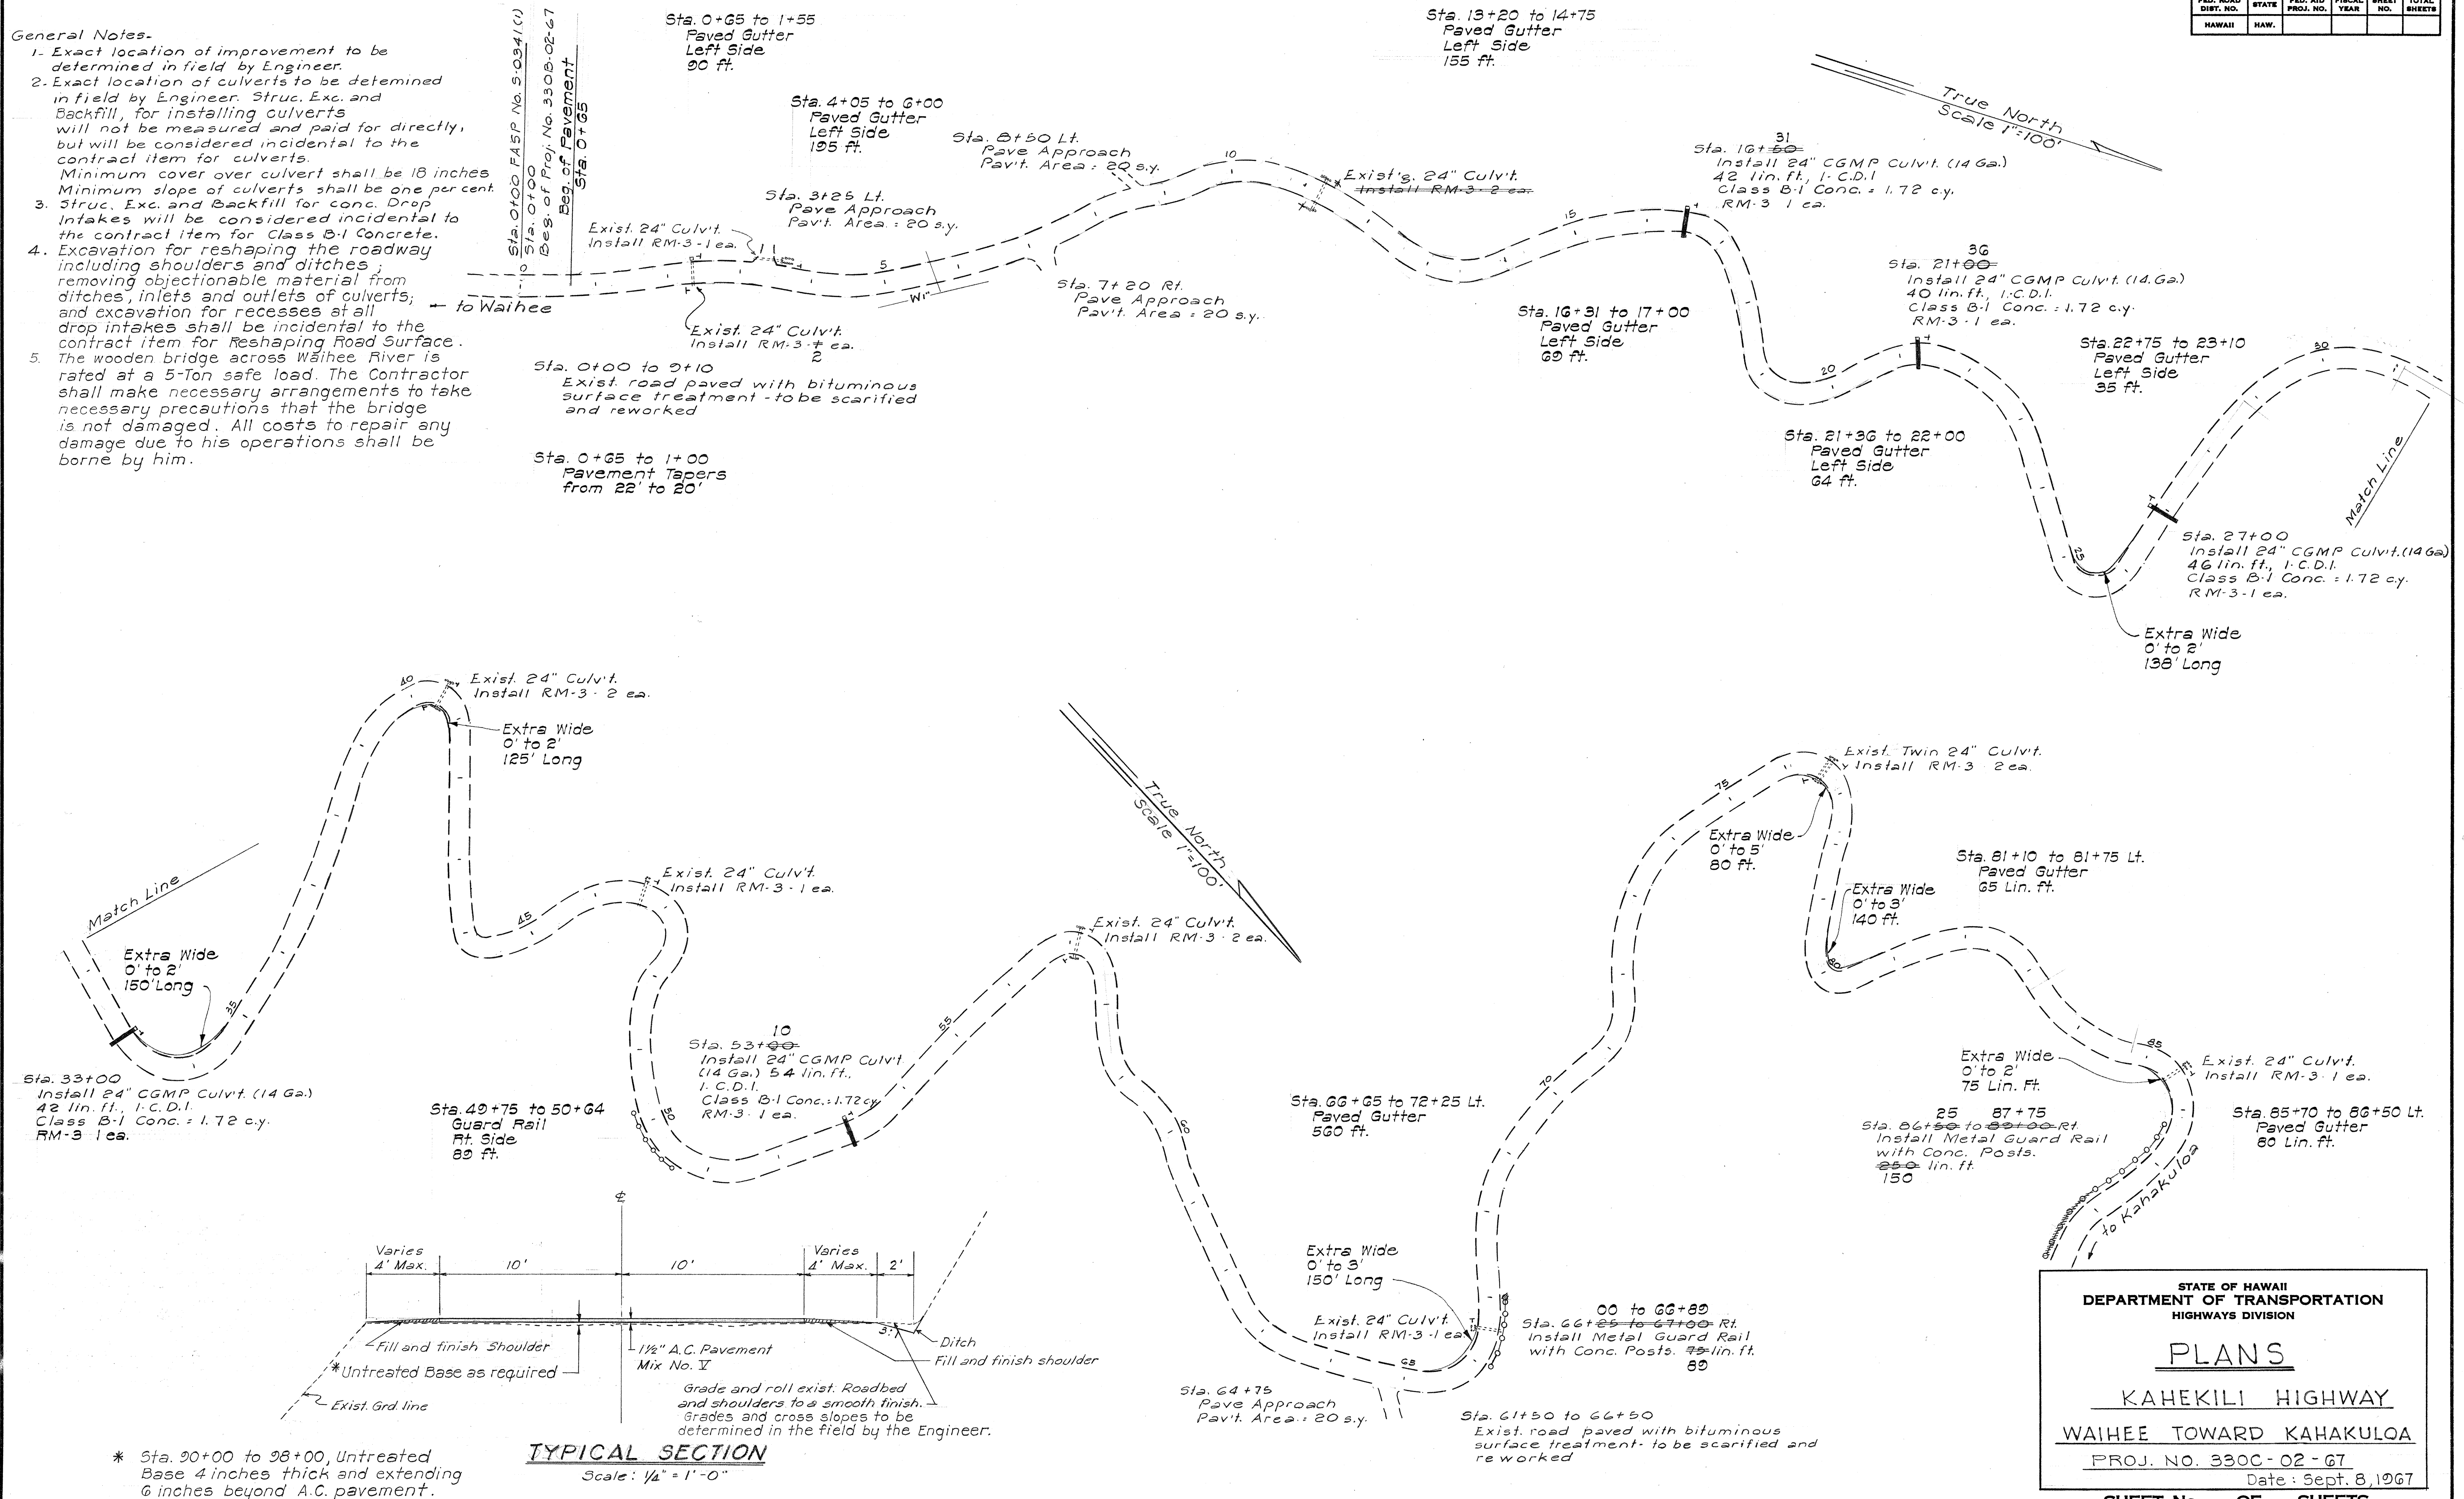

* Sta. 90+00 to 98+00, Untreated Base 4 inches thick and extending 6 inches beyond A.C. pavement.

STATE OF HAWAII
DEPARTMENT OF TRANSPORTATION
HIGHWAYS DIVISION

PLANS

KAHEKILI HIGHWAY

WAIHEE TOWARD KAHAKULOA


PROJ. NO. 330C-02-67
Date: Sept. 8, 1967

SHEET No. OF SHEETS

SURVEY PLOTTED BY	DATE
DRAWN BY	
DESIGNED BY	
QUANTITIES BY	
CHECKED BY	
ORIGINAL PLAN	
NOTE BOOK	
No.	

FED. ROAD DIST. NO.	STATE	FED. AID PROJ. NO.	FISCAL YEAR	SHEET NO.	TOTAL SHEETS
HAWAII	HAW.				

ORIGINAL PLAN	SURVEY PLOTTED BY	DATE
NOTE BOOK	DRAWN BY	" "
No.	DESIGNED BY	" "
	QUANTITIES BY	" "
	CHECKED BY	" "

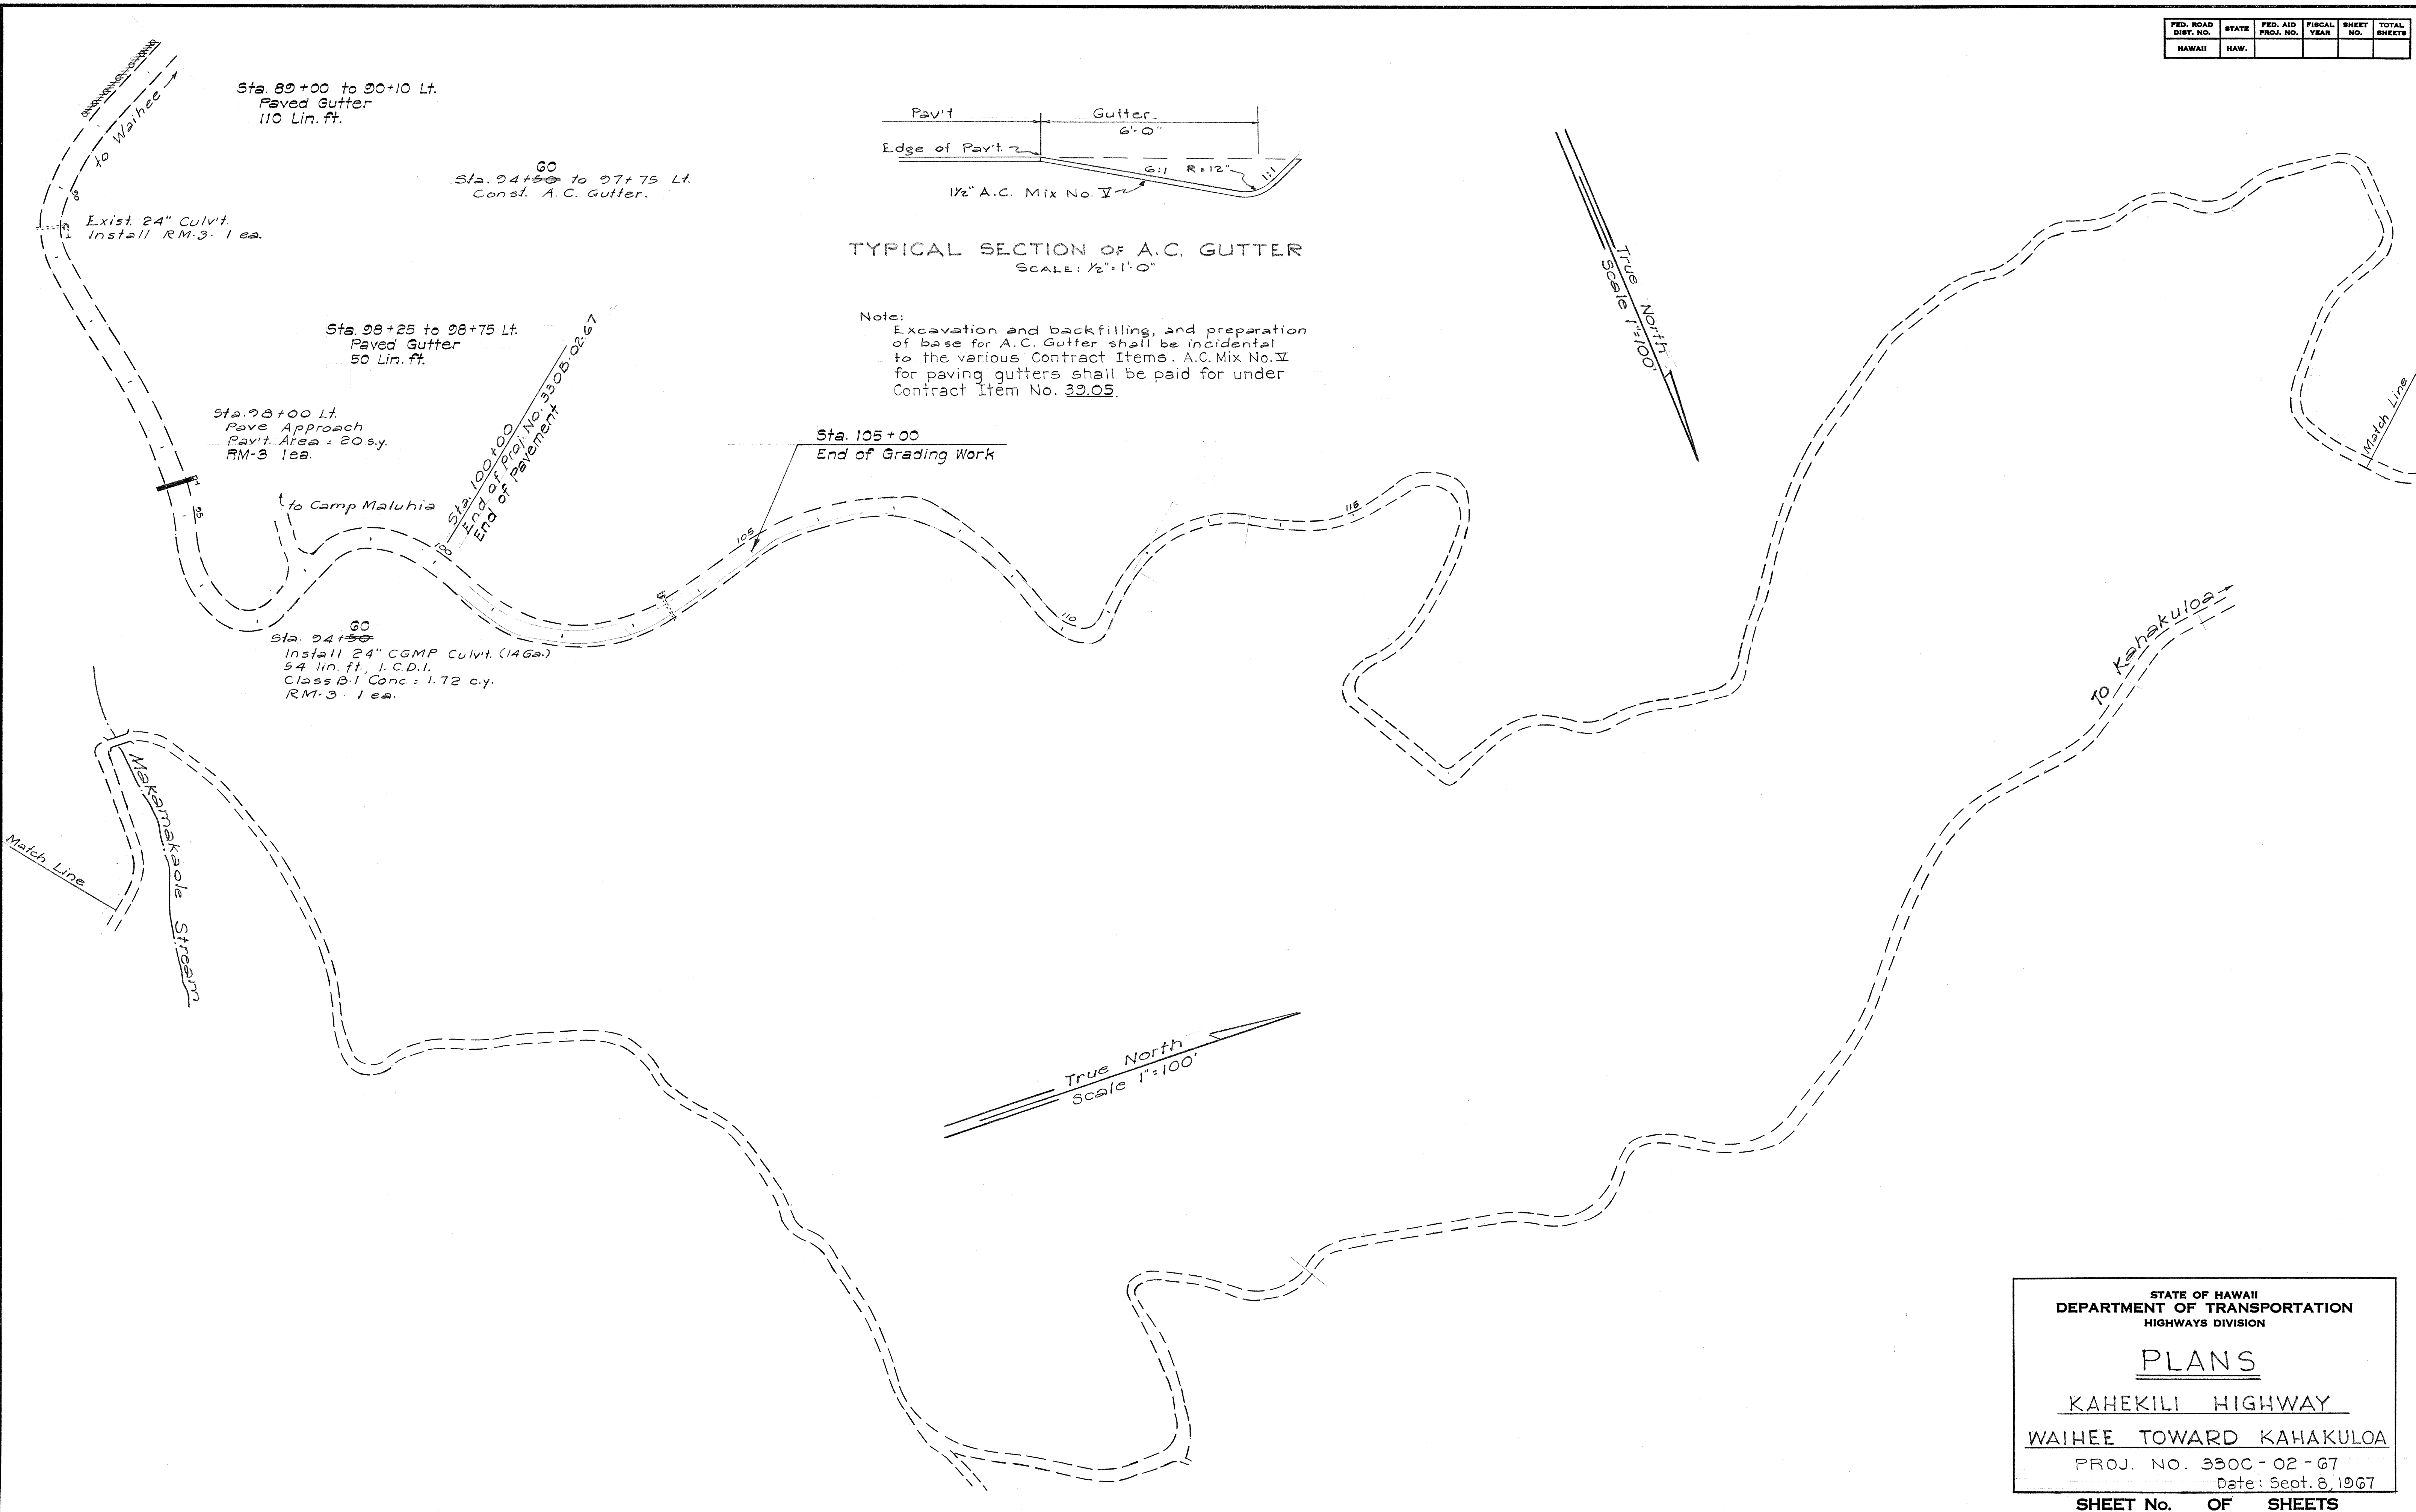

TYPICAL SECTION OF A.C. GUTTER
SCALE: 1/2"=1'-0"

Note:
Excavation and backfilling, and preparation of base for A.C. Gutter shall be incidental to the various Contract Items. A.C. Mix No. V for paving gutters shall be paid for under Contract Item No. 32.05.

STATE OF HAWAII
DEPARTMENT OF TRANSPORTATION
HIGHWAYS DIVISION

PLANS

KAHEKILI HIGHWAY

WAIHEE TOWARD KAHAKULOA

PROJ. NO. 330C - 02 - 67
Date: Sept. 8, 1967

SHEET No. OF SHEETS