
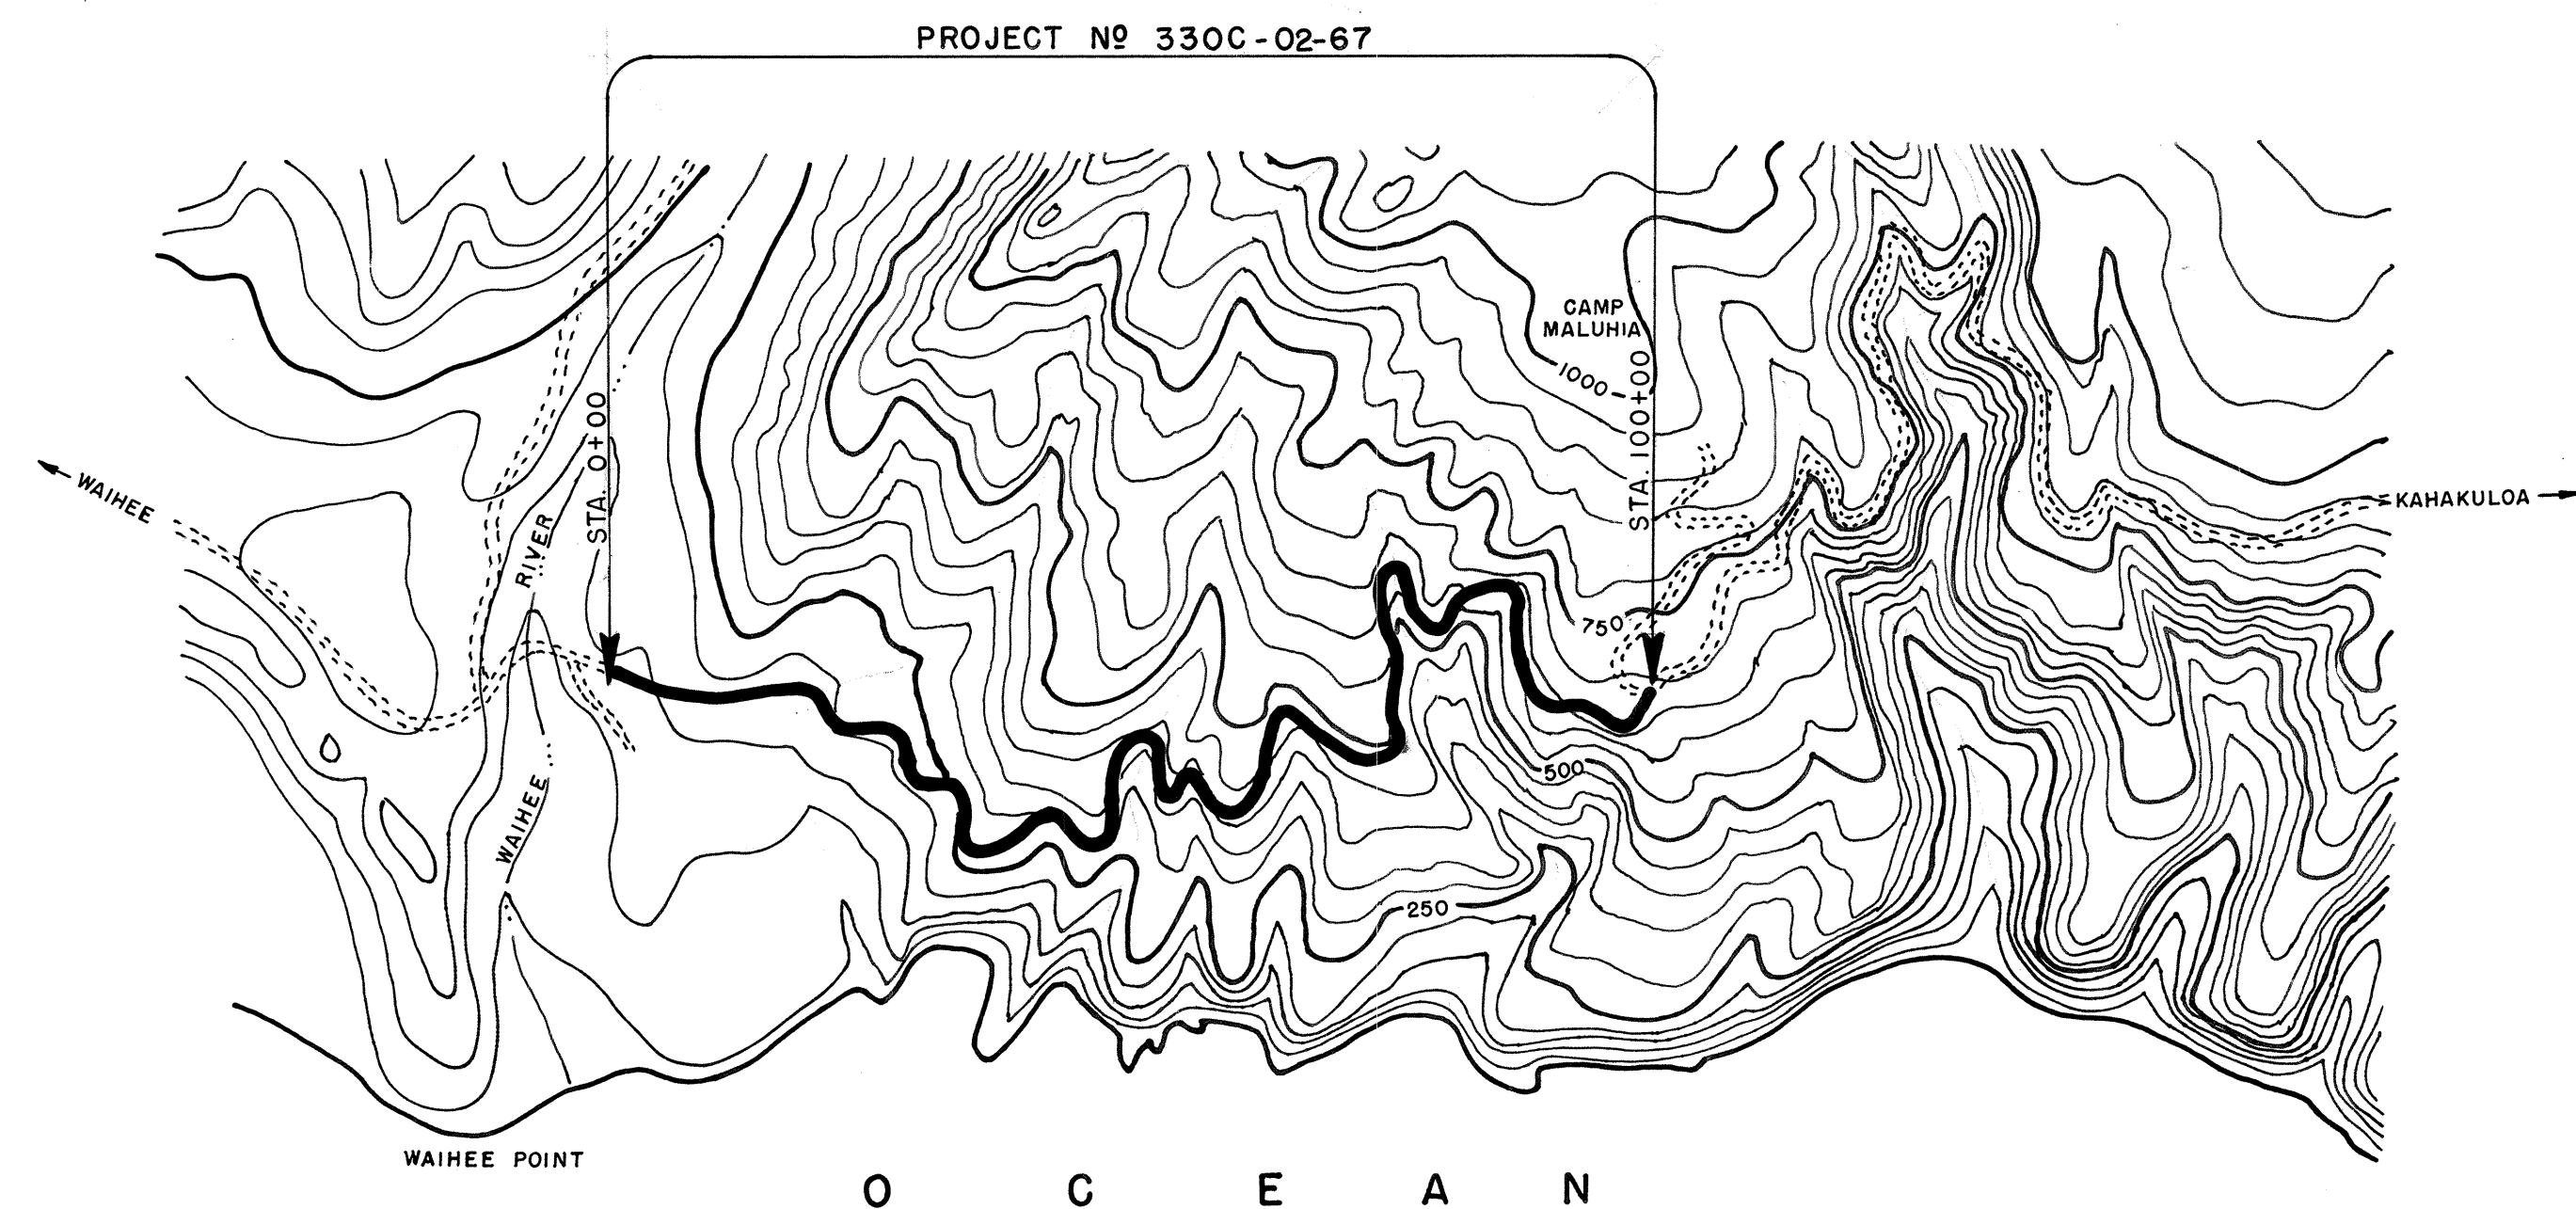


INDEX TO DRAWINGS	
SHEET NO	DESCRIPTION
1	Title Sheet
2-3	Detail Roadway Plans
4	Cross Sections
5-8	Standard Details

STATE OF HAWAII
DEPARTMENT OF TRANSPORTATION
HIGHWAYS DIVISION
HONOLULU, HAWAII

"AS BUILT" PLANS FOR
RESHAPING, PAVING & IMPROVING A PORTION OF
KAHEKILI HIGHWAY
WAIHEE TOWARD KAHAKULOLOA
PROJ. NO 330C-02-67
DISTRICT OF WAILUKU
ISLAND OF MAUI

SCALES	
PLAN	1 IN. = 100 FT.
PROFILE	HOR. 1 IN. = - FT.
	VER. 1 IN. = - FT.
X-SECTIONS	HOR. 1 IN. = - FT.
	VER. 1 IN. = - FT.

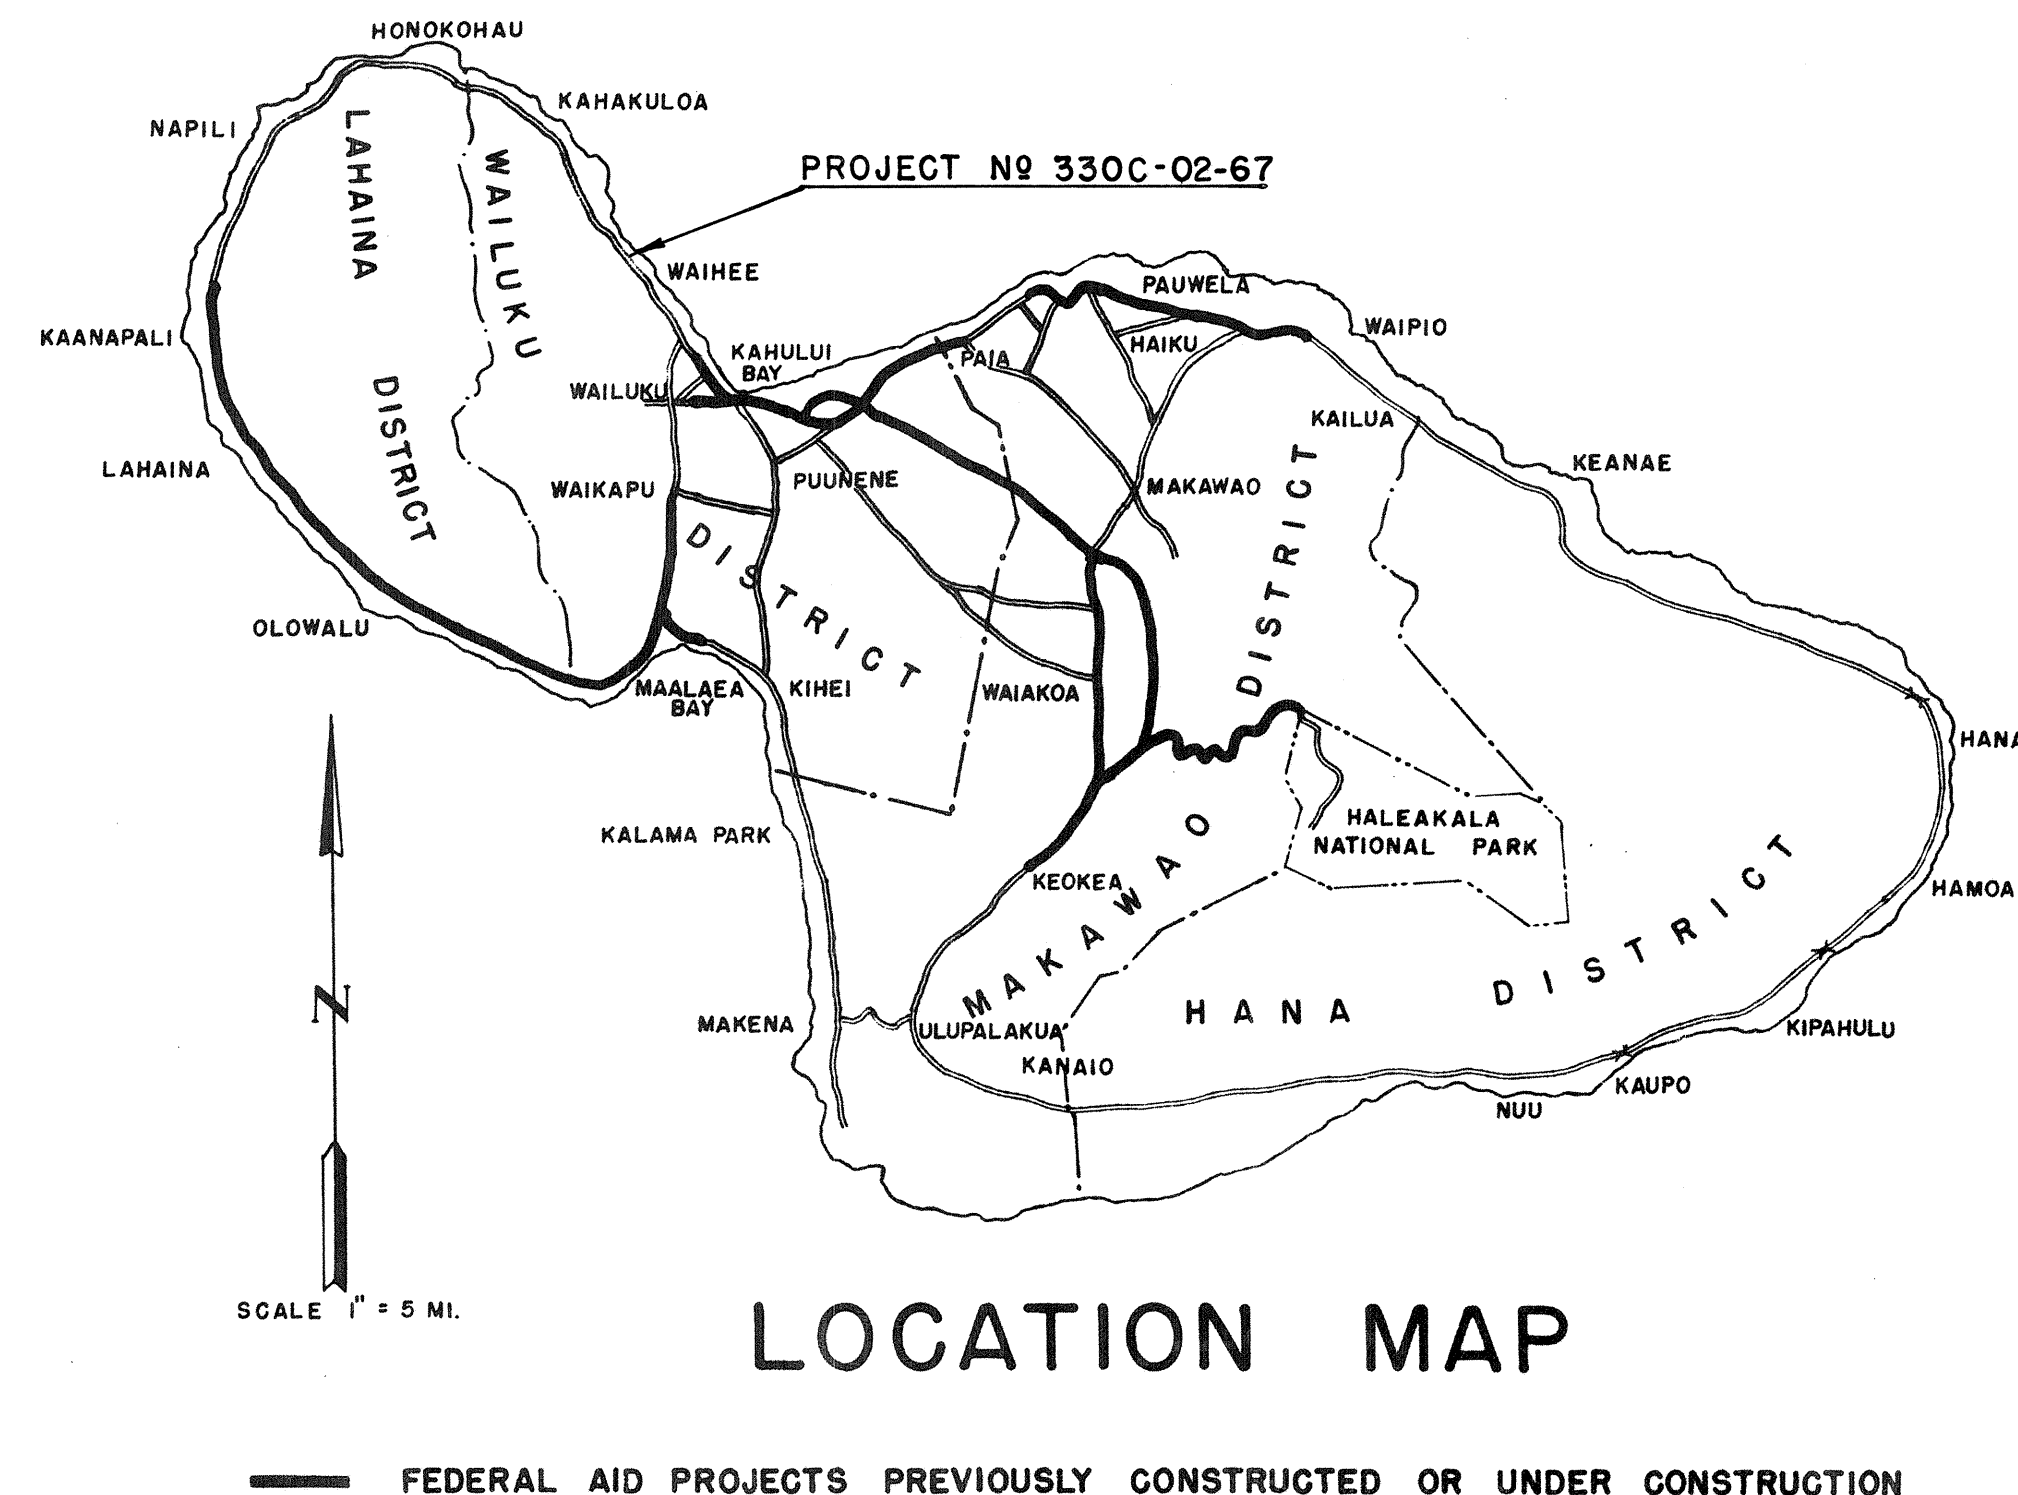

LAYOUT OF PROJECT
SCALE: 1" = 1000'
LENGTH OF PROJECT 1.894 MI.

NOTE :
ALL CHANGES MADE DURING CONSTRUCTION
HAVE BEEN NOTED ON THESE TRACINGS IN
RED AND CHECKED BY :

[Signature]

PROJECT ENGINEER

5/23/68

DATE

APPROVED: *[Signature]*

DATE 9/12/67

DIRECTOR OF TRANSPORTATION