	INDEX TO DRAWINGS
SHEET NO.	DESCRIPTION
1	TITLE SHEET
2-4	DRAINAGE DETAILS
5	CONSTRUCTION SIGN DETAIL
¢	
·	

R. MIKAMI P. S. & E. BY



STATE OF HAWAII

of Marini

DEPARTMENT OF TRANSPORTATION

HIGHWAYS DIVISION

HONOLULU, HAWAII


AS BUILT"

PLANS FOR

KAHEKILI HIGHWAY


DRAINAGE IMPROVEMENTS AT WAIEHU STREAM FEDERAL AID SECONDARY PROJECT NO. RS-0340(2)

DISTRICT OF WAILUKU
ISLAND OF MAUI

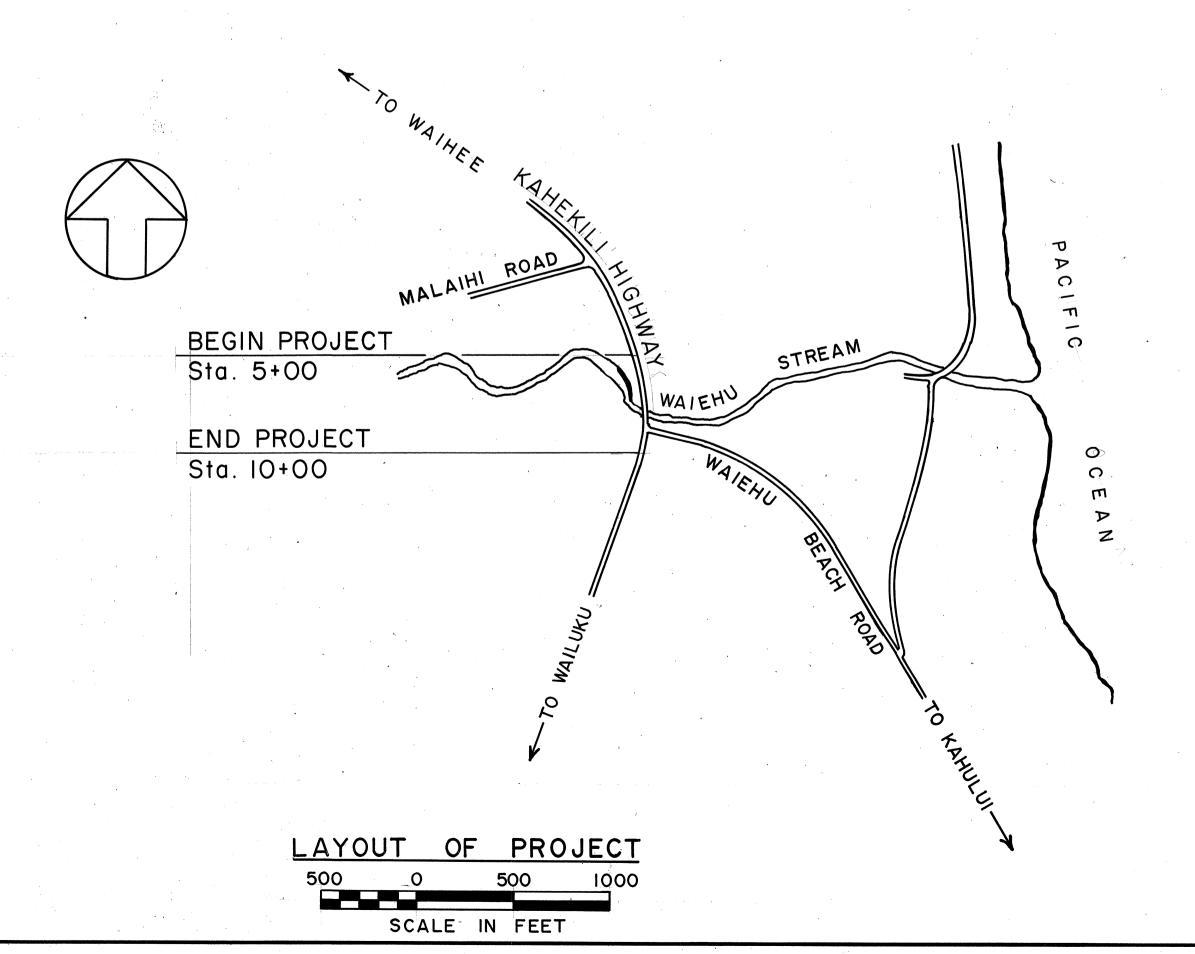

FED. ROAD DIST. NO. STATE PROJ. NO. FISCAL SHEET NO. SHEETS

HAWAII HAW. RS-0340(2) 1980 1 5

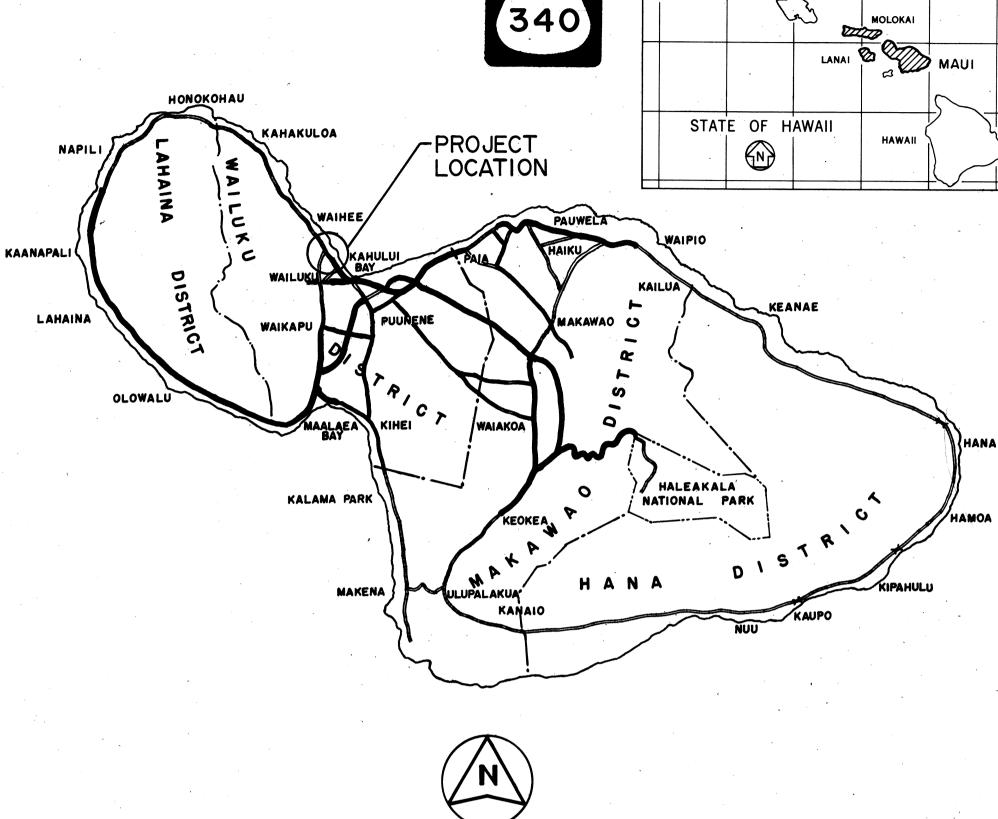

FEDERAL AID PROJECTS PREVIOUSLY CONSTRUCTED OR UNDER CONSTRUCTION

DESIGN CLASSIFICATION

CURRENT ADT (1980)	1,960
DESIGN ADT (2000)	2,720
DHV	270
T24	5.5%

ALL CHANGES MADE DURING CONSTRUCTION
HAVE BEEN INCORPORATED ON THESE PLANS
EXCEPT CHANGES IN THE ORIGINAL THEORETICAL
QUANTITIES

Manuelf. Silva 7 Nov 80
PROJECT ENGINEER DATE

DEPARTMENT OF TRANSPORTATION
STATE OF HAWAII

APPROVED:
Carras 5/29/80

DIR. OF TRANSPORTATION

5729/80 DATE