

FED. ROAD DIST. NO.	STATE	PROJ. NO.	FISCAL YEAR	SHEET NO.	TOTAL SHEETS
HAWAII	HAW.	340D-01-93M	1993	6	22

Begin Proj. No. 340D-01-93M
Waiehu Bch. Rd. to Camp Maluhia
Sta. 23+00

Sta. 41+10± Rt. to Sta. 47+10± Rt.
Roadway recently widened. Therefore, no
new resurfacing shall be done within this
limit or as determined by the Engineer.

91+00± 95+50±
Sta. 90+65± Lt. to Sta. 95+95± Lt.
Roadway recently widened. Therefore, no
new resurfacing shall be done within this
limit or as determined by the Engineer.


LEGEND FOR AS-BUILT POSTINGS	
	Squiggly line for as-built deletion
	Double line for as-built deletion
Roadway	Text for as-built posting

STATE OF HAWAII
DEPARTMENT OF TRANSPORTATION
HIGHWAYS DIVISION
ROADWAY PLAN
KAHEKILI HIGHWAY RESURFACING
Waiehu Beach Road to Camp Maluhia
Project No. 340D-01-93M

Scale: 1"=100' Date: April, 1993
SHEET No. 1 OF 6 SHEETS

6

FED. ROAD DIST. NO.	STATE	PROJ. NO.	FISCAL YEAR	SHEET NO.	TOTAL SHEETS
HAWAII	HAW.	340D-01-93M	1993	7	22

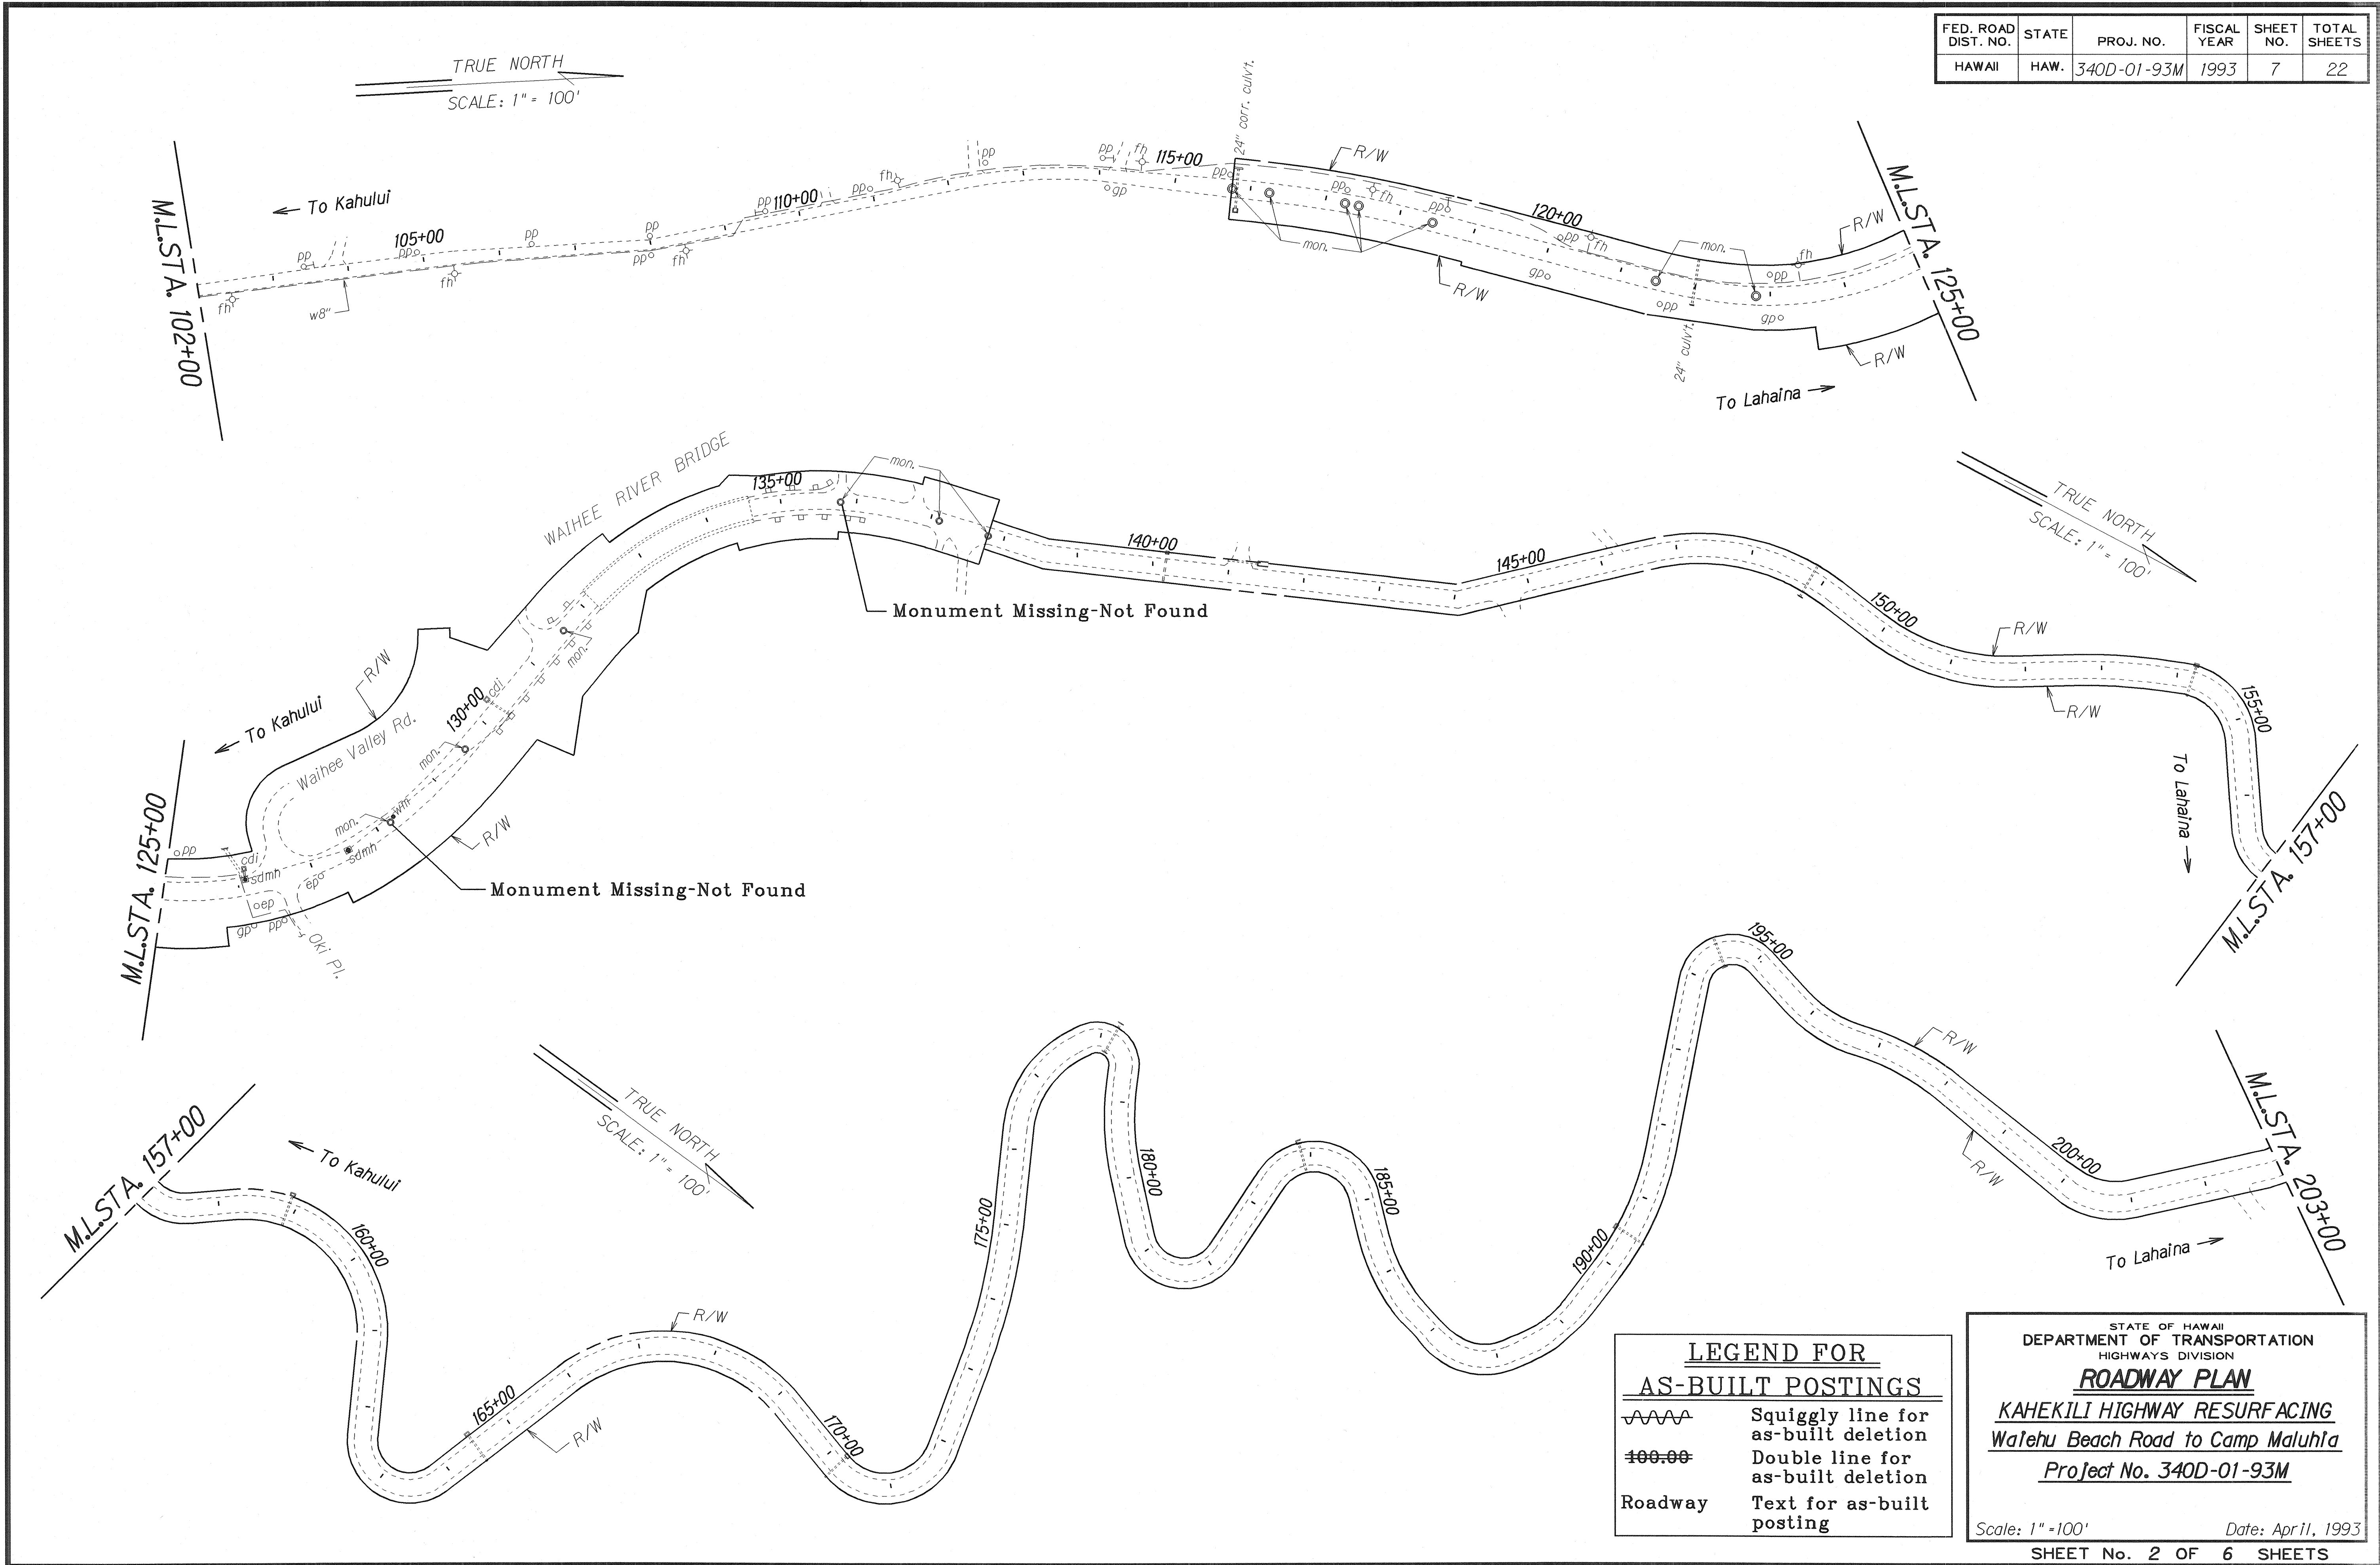

TRUE NORTH
SCALE: 1" = 100'

TRUE NORTH
SCALE: 1" = 100'

TRUE NORTH
SCALE: 1" = 100'

LEGEND FOR AS-BUILT POSTINGS	
	Squiggly line for as-built deletion
	Double line for as-built deletion
Roadway	Text for as-built posting


STATE OF HAWAII
DEPARTMENT OF TRANSPORTATION
HIGHWAYS DIVISION
ROADWAY PLAN
KAHEKILI HIGHWAY RESURFACING
Waiehu Beach Road to Camp Maluhia
Project No. 340D-01-93M

Scale: 1" = 100' Date: April, 1993
SHEET No. 2 OF 6 SHEETS

ORIGINAL PLAN	SURVEY PLOTTED BY	DATE
NOTE BOOK	DRAWN BY	
DESIGNED BY		
CHECKED BY		
NO. 111102		

"AS-BUILT"

FED. ROAD DIST. NO.	STATE	PROJ. NO.	FISCAL YEAR	SHEET NO.	TOTAL SHEETS
HAWAII	HAW.	340D-01-93M	1993	8	22

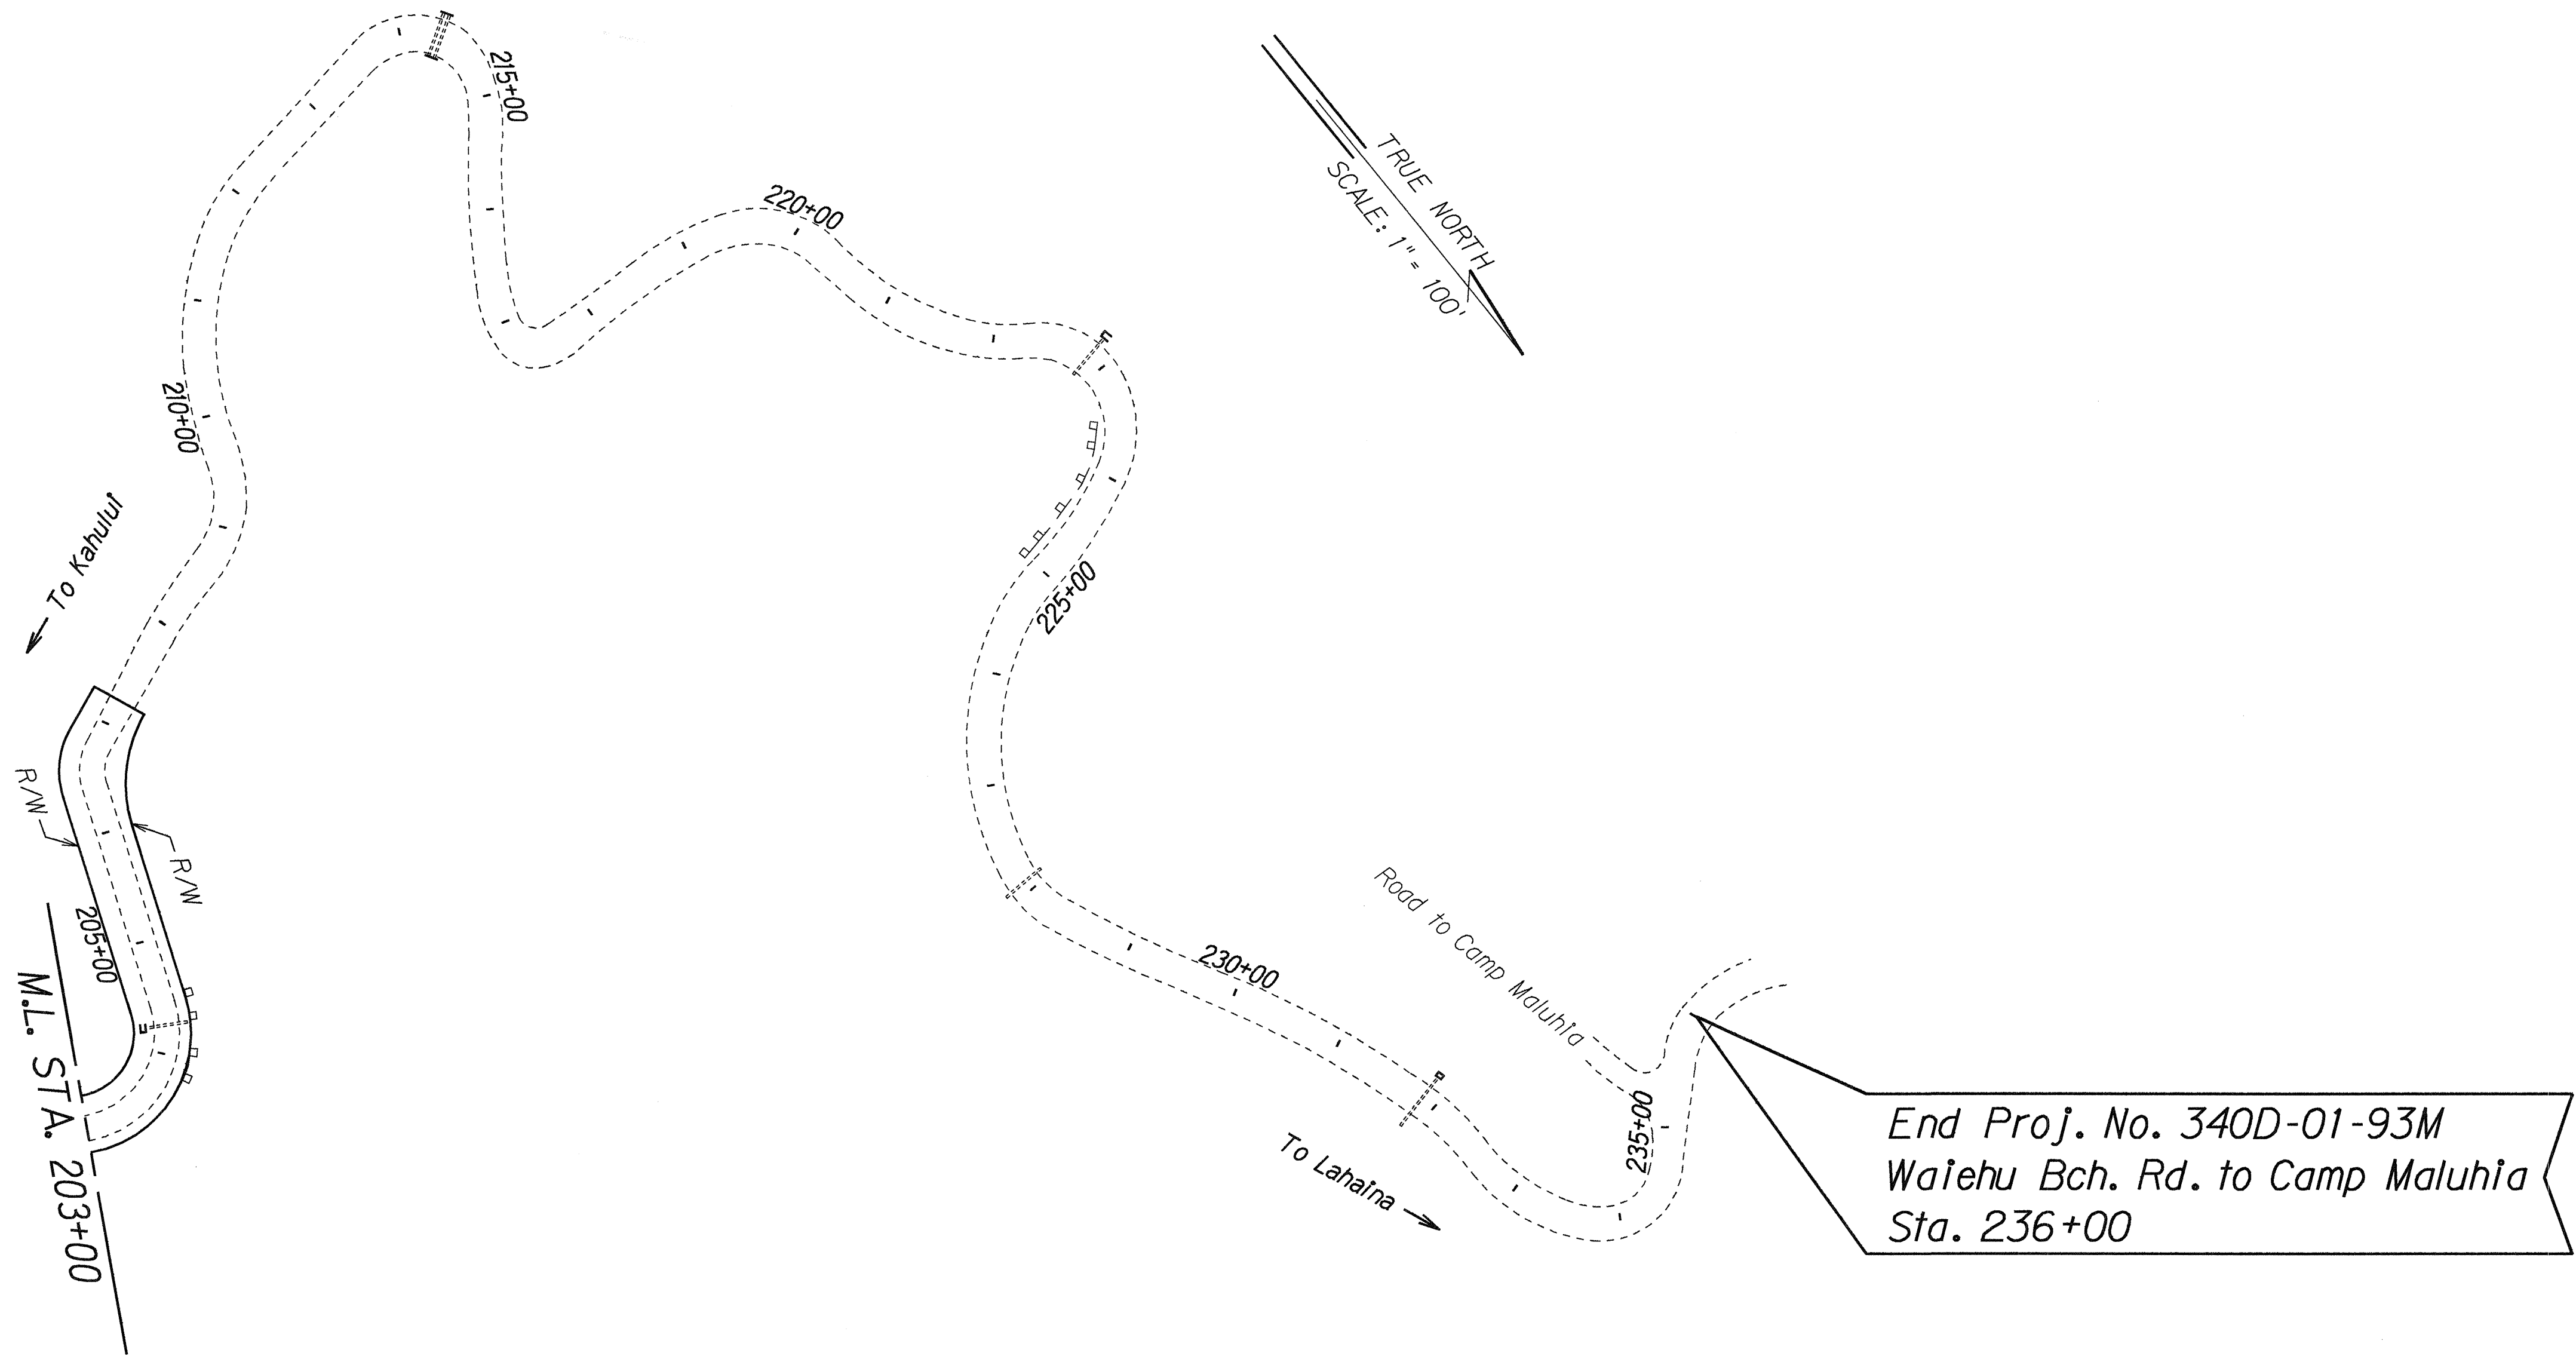

ORIGINAL PLAN	SURVEY PLOTTED BY	DATE
NOTE BOOK	DRAWN BY	
109116 Jason	DESIGNED BY	
N. 109116	CHECKED BY	

STATE OF HAWAII
DEPARTMENT OF TRANSPORTATION
HIGHWAYS DIVISION

ROADWAY PLAN

KAHEKILI HIGHWAY RESURFACING


Waiehu Beach Road to Camp Maluhia

Project No. 340D-01-93M

Scale: 1" = 100' Date: April 11, 1993

SHEET No. 3 OF 6 SHEETS

FED. ROAD DIST. NO.	STATE	PROJ. NO.	FISCAL YEAR	SHEET NO.	TOTAL SHEETS
HAWAII	HAW.	340D-01-93M	1993	9	22

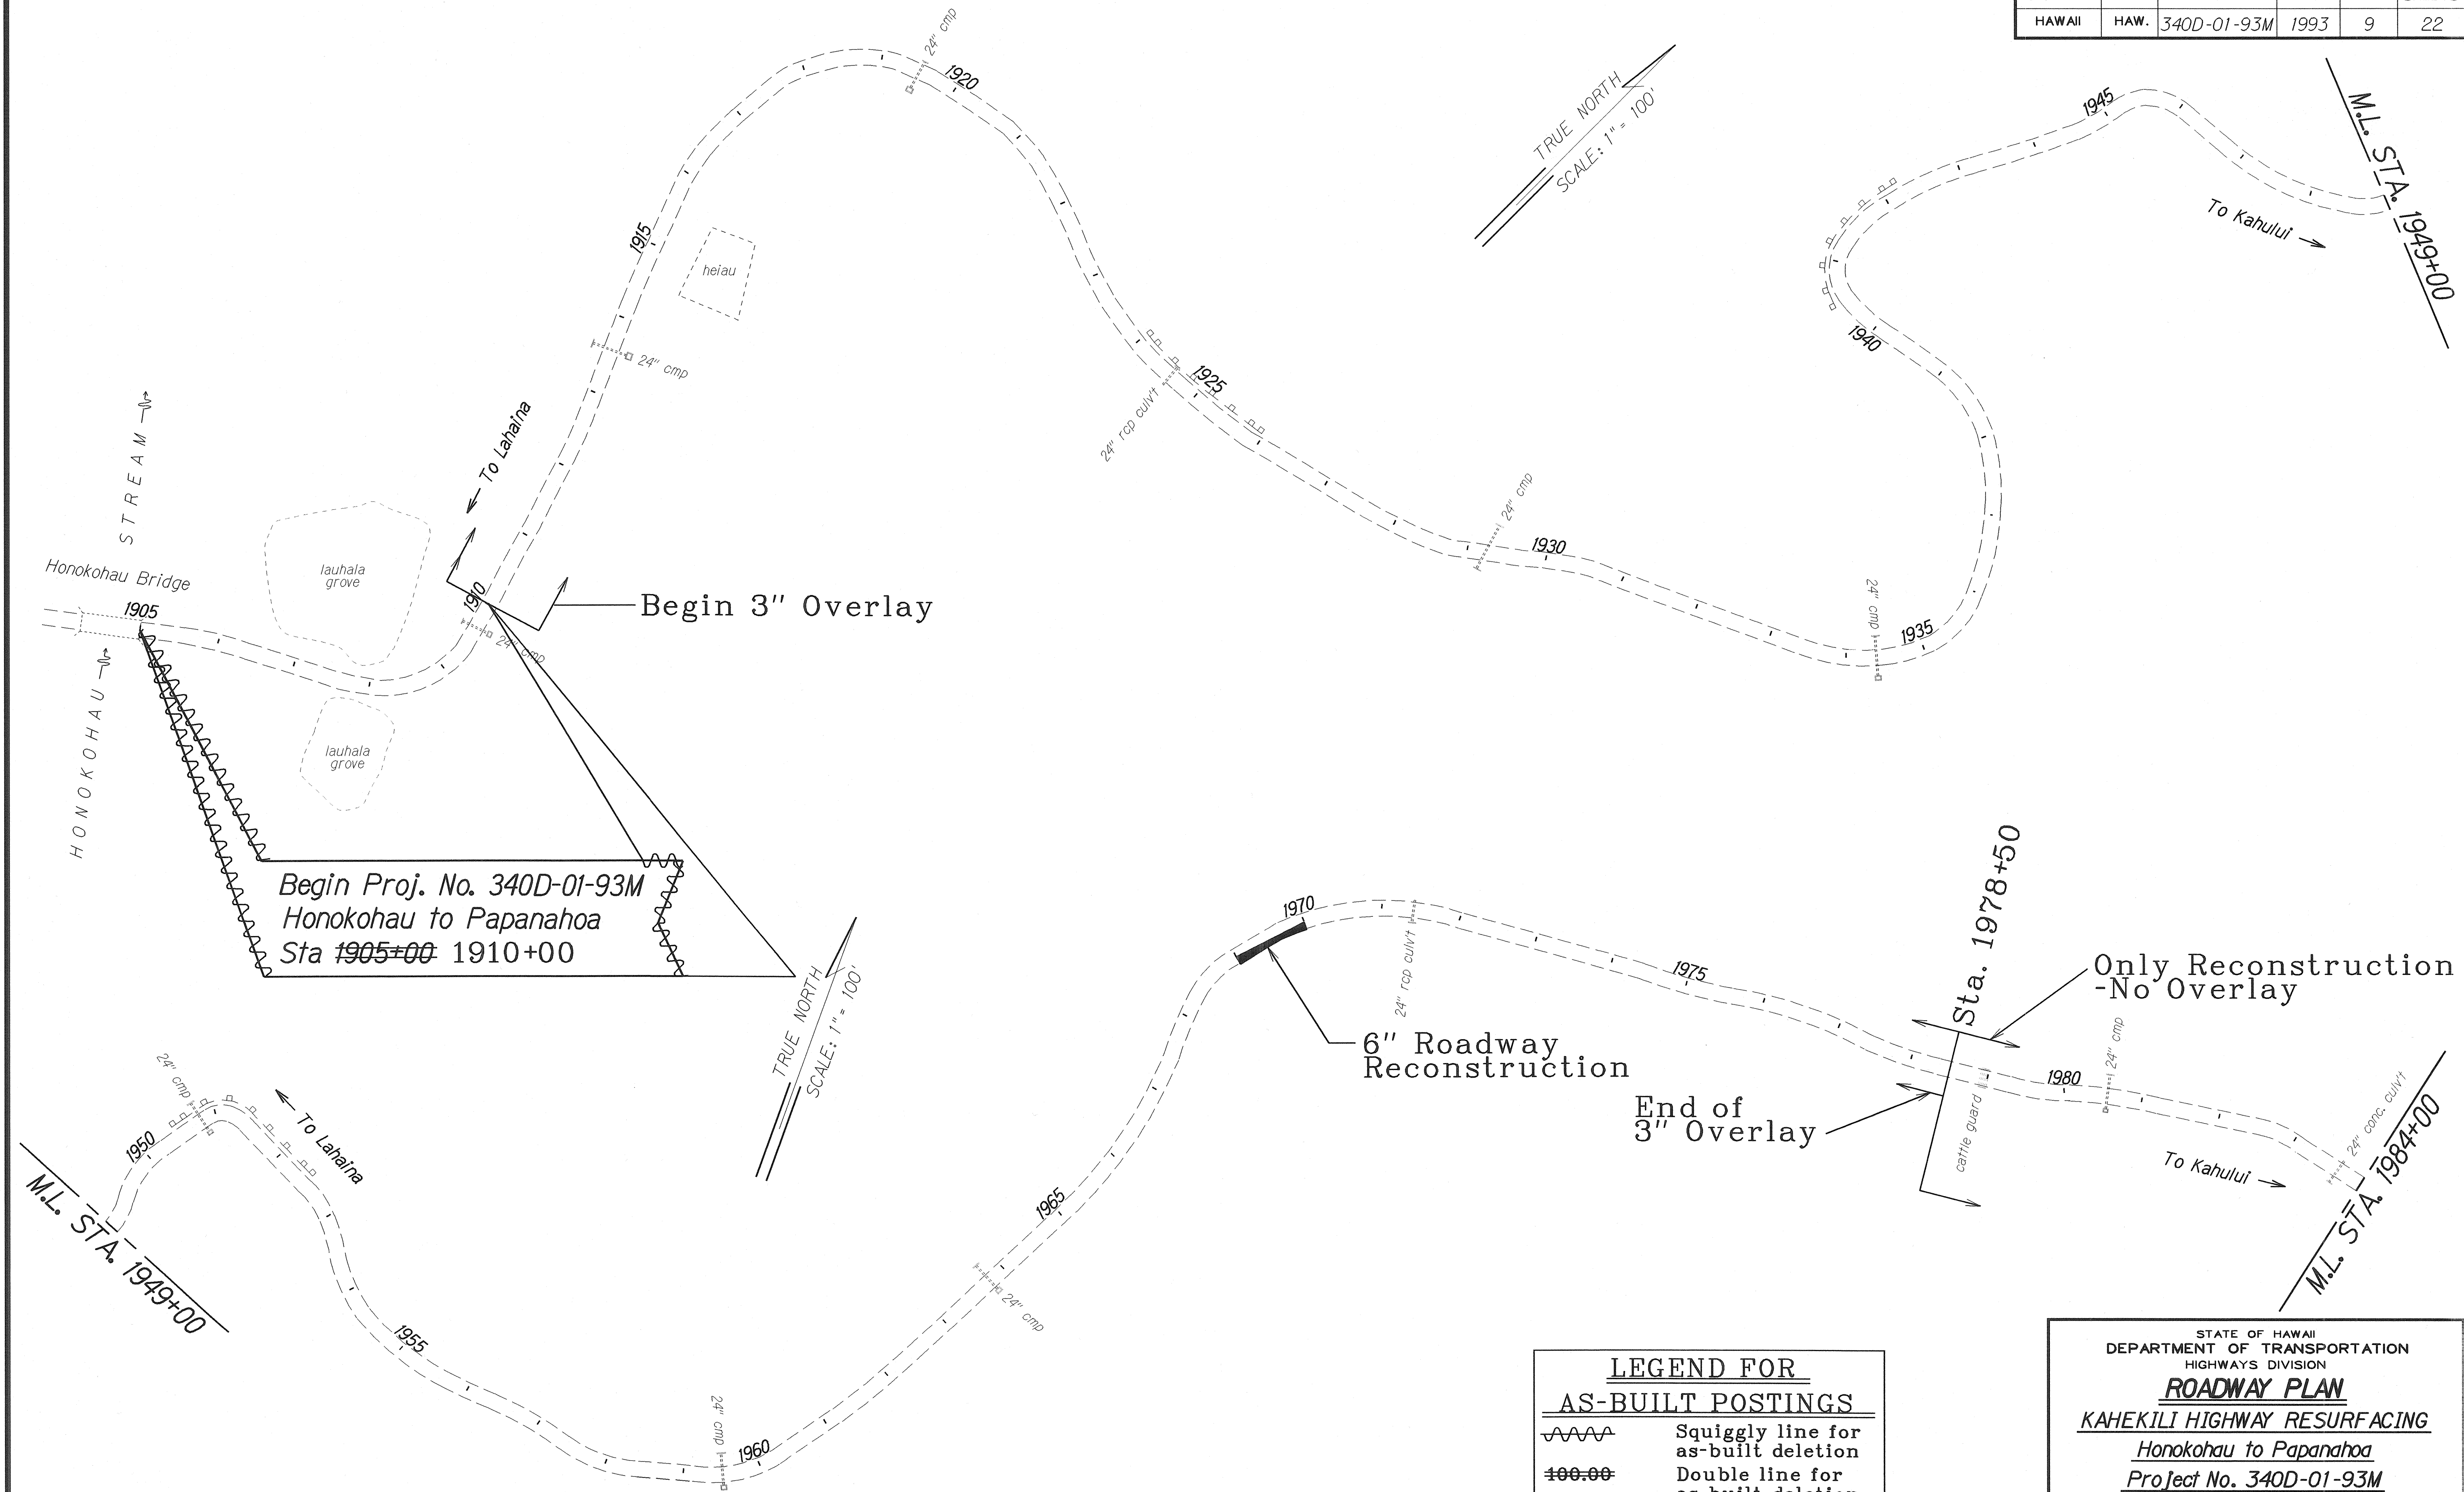


ORIGINAL PLAN	SURVEY PLOTTED BY	DATE
NOTE BOOK	DRAWN BY	
DESIGNED BY	TRACED BY	
CHECKED BY	DESIGNED BY	
	CHECKED BY	

LEGEND FOR AS-BUILT POSTINGS	
	Squiggly line for as-built deletion
	Double line for as-built deletion
Roadway	Text for as-built posting

STATE OF HAWAII
DEPARTMENT OF TRANSPORTATION
HIGHWAYS DIVISION
ROADWAY PLAN
KAHEKILI HIGHWAY RESURFACING
Honokohau to Papanahoa
Project No. 340D-01-93M

Scale: 1" = 100'
Date: April, 1993
SHEET No. 4 OF 6 SHEETS

FED. ROAD DIST. NO.	STATE	PROJ. NO.	FISCAL YEAR	SHEET NO.	TOTAL SHEETS
HAWAII	HAW.	340D-01-93M	1993	10	22

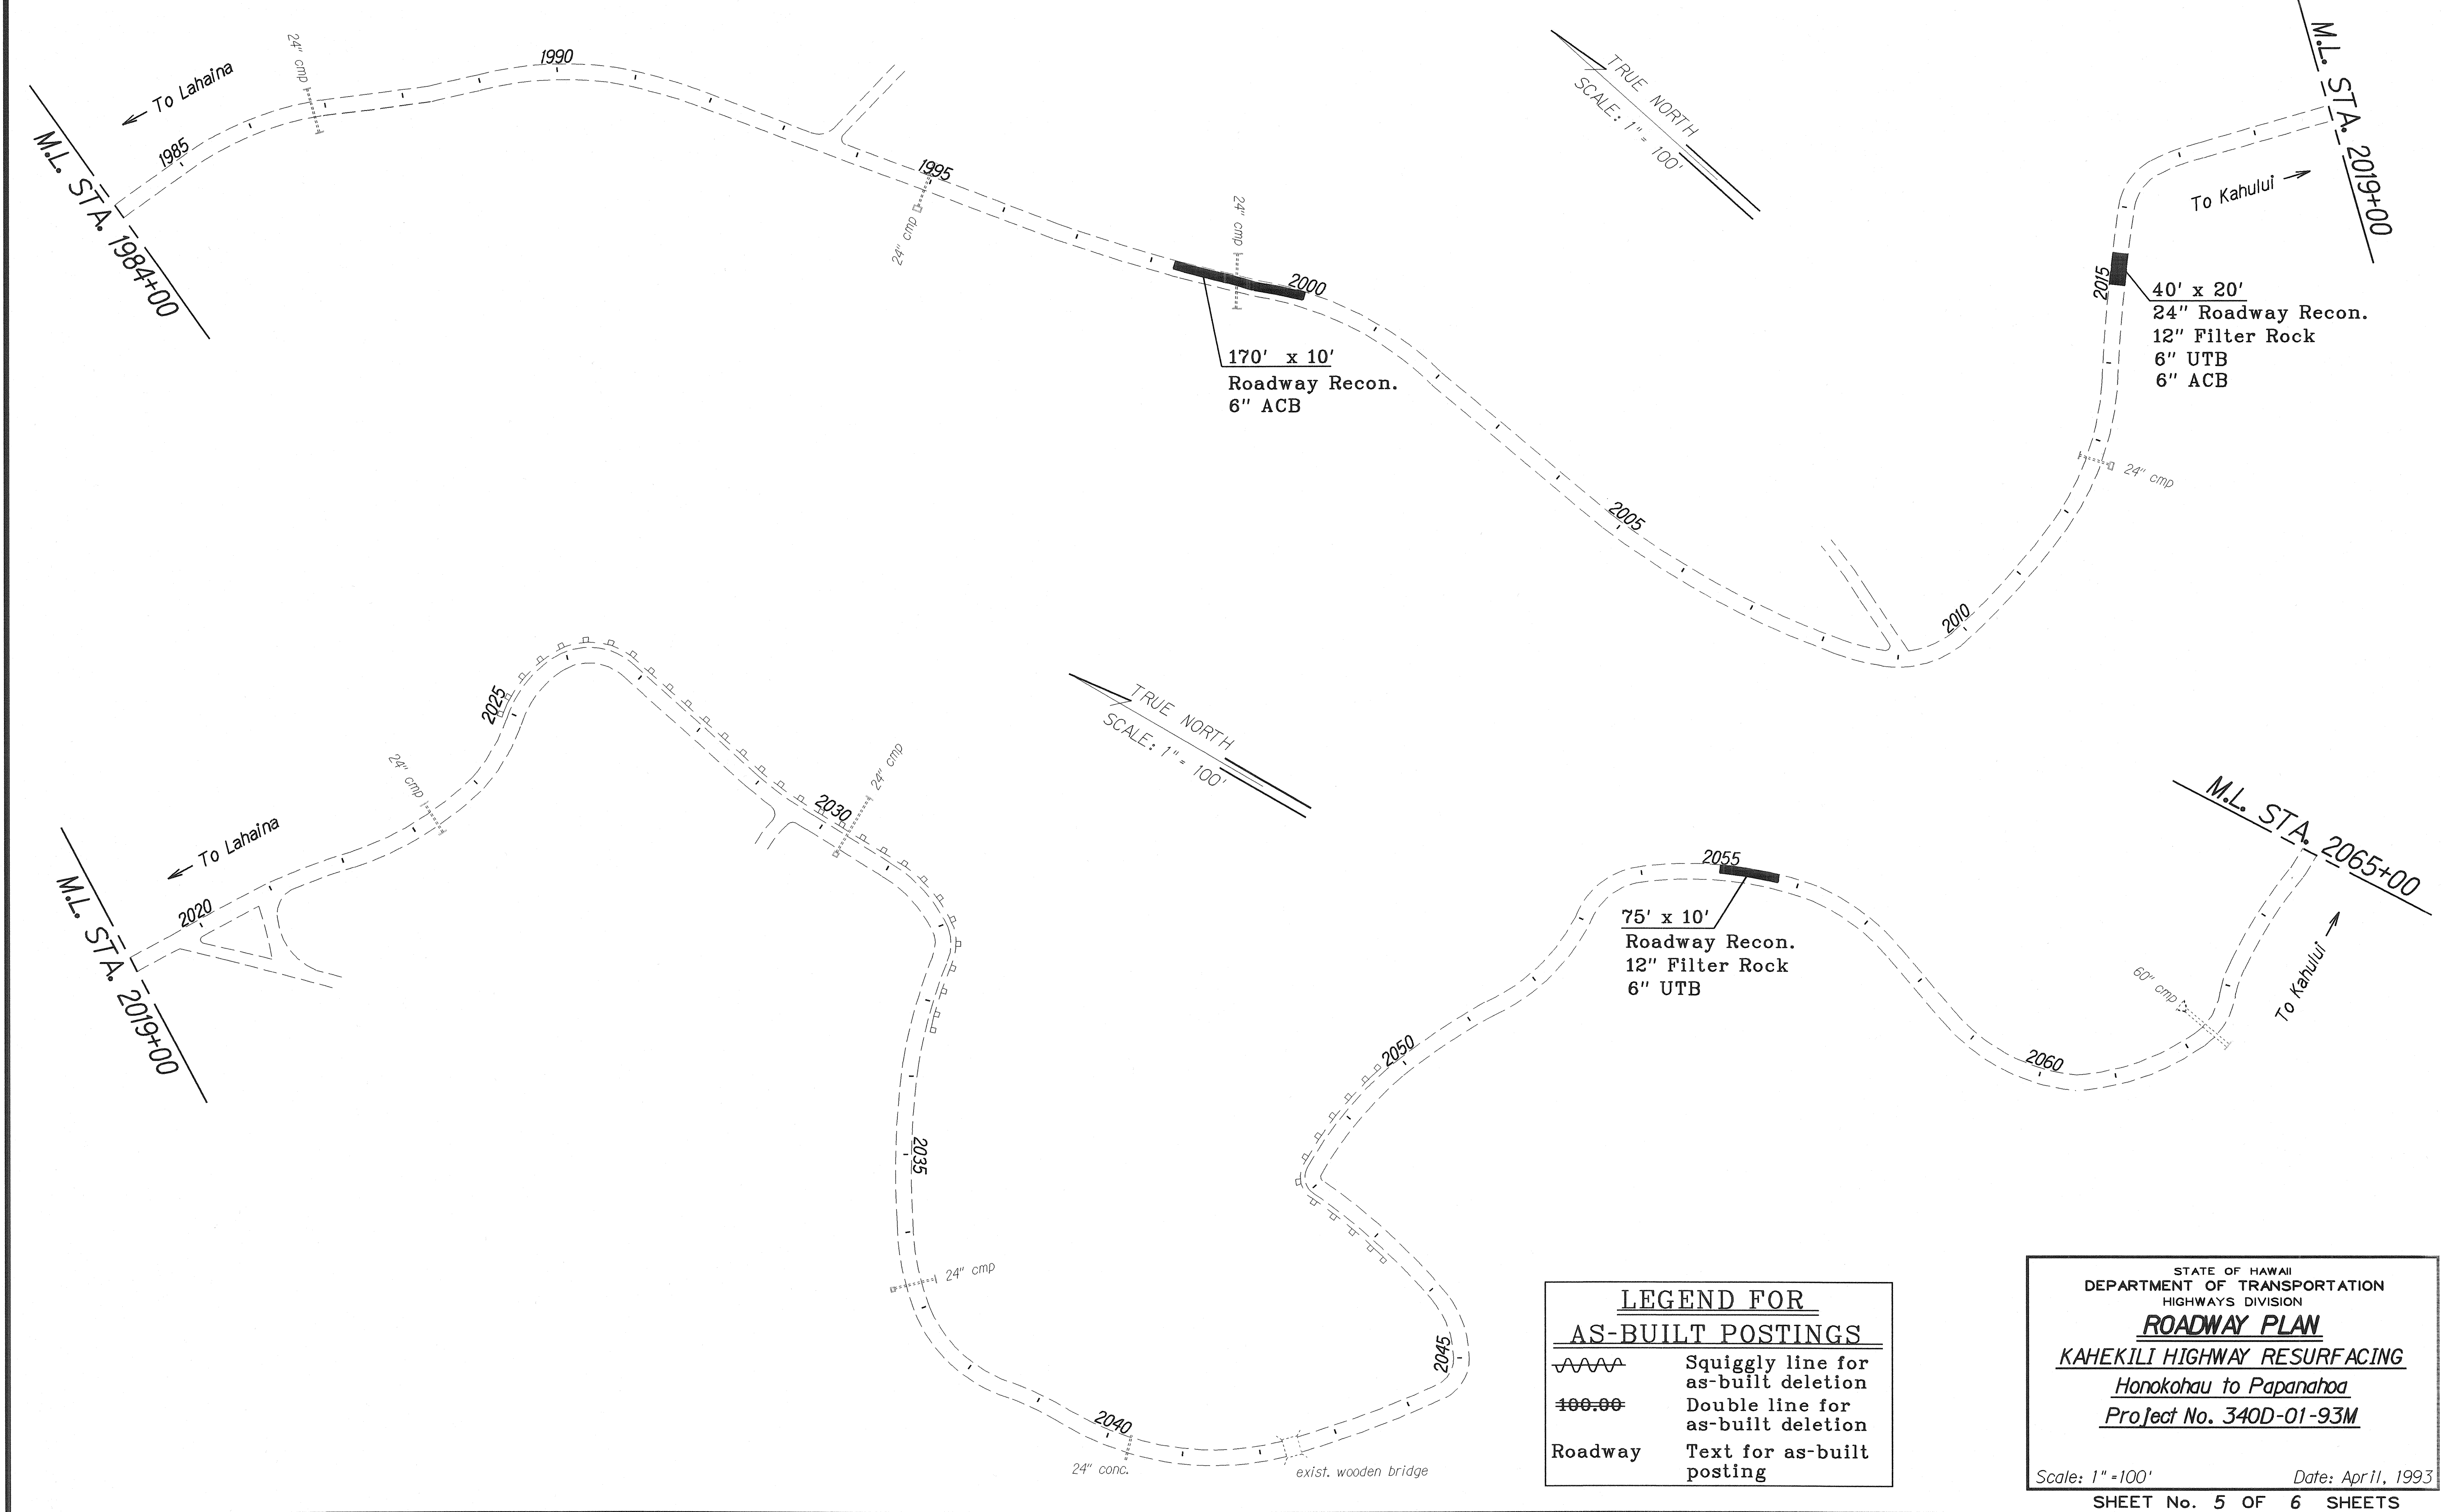

ORIGINAL PLAN	SURVEY PLOTTED BY	DATE
NOTE BOOK	DRAWN BY	
DESIGNED BY	TRACED BY	
CHECKED BY	CHECKED BY	
N. M. H. 10/10/93		


LEGEND FOR AS-BUILT POSTINGS	
	Squiggly line for as-built deletion
	Double line for as-built deletion
Roadway	Text for as-built posting

STATE OF HAWAII
DEPARTMENT OF TRANSPORTATION
HIGHWAYS DIVISION
ROADWAY PLAN
KAHEKILI HIGHWAY RESURFACING
Honokohau to Papanahoa
Project No. 340D-01-93M

Scale: 1"=100'
Date: April, 1993
SHEET No. 5 OF 6 SHEETS

FED. ROAD DIST. NO.	STATE	PROJ. NO.	FISCAL YEAR	SHEET NO.	TOTAL SHEETS
HAWAII	HAW.	340D-01-93M	1993	11	22

TRUE NORTH
SCALE: 1" = 100'

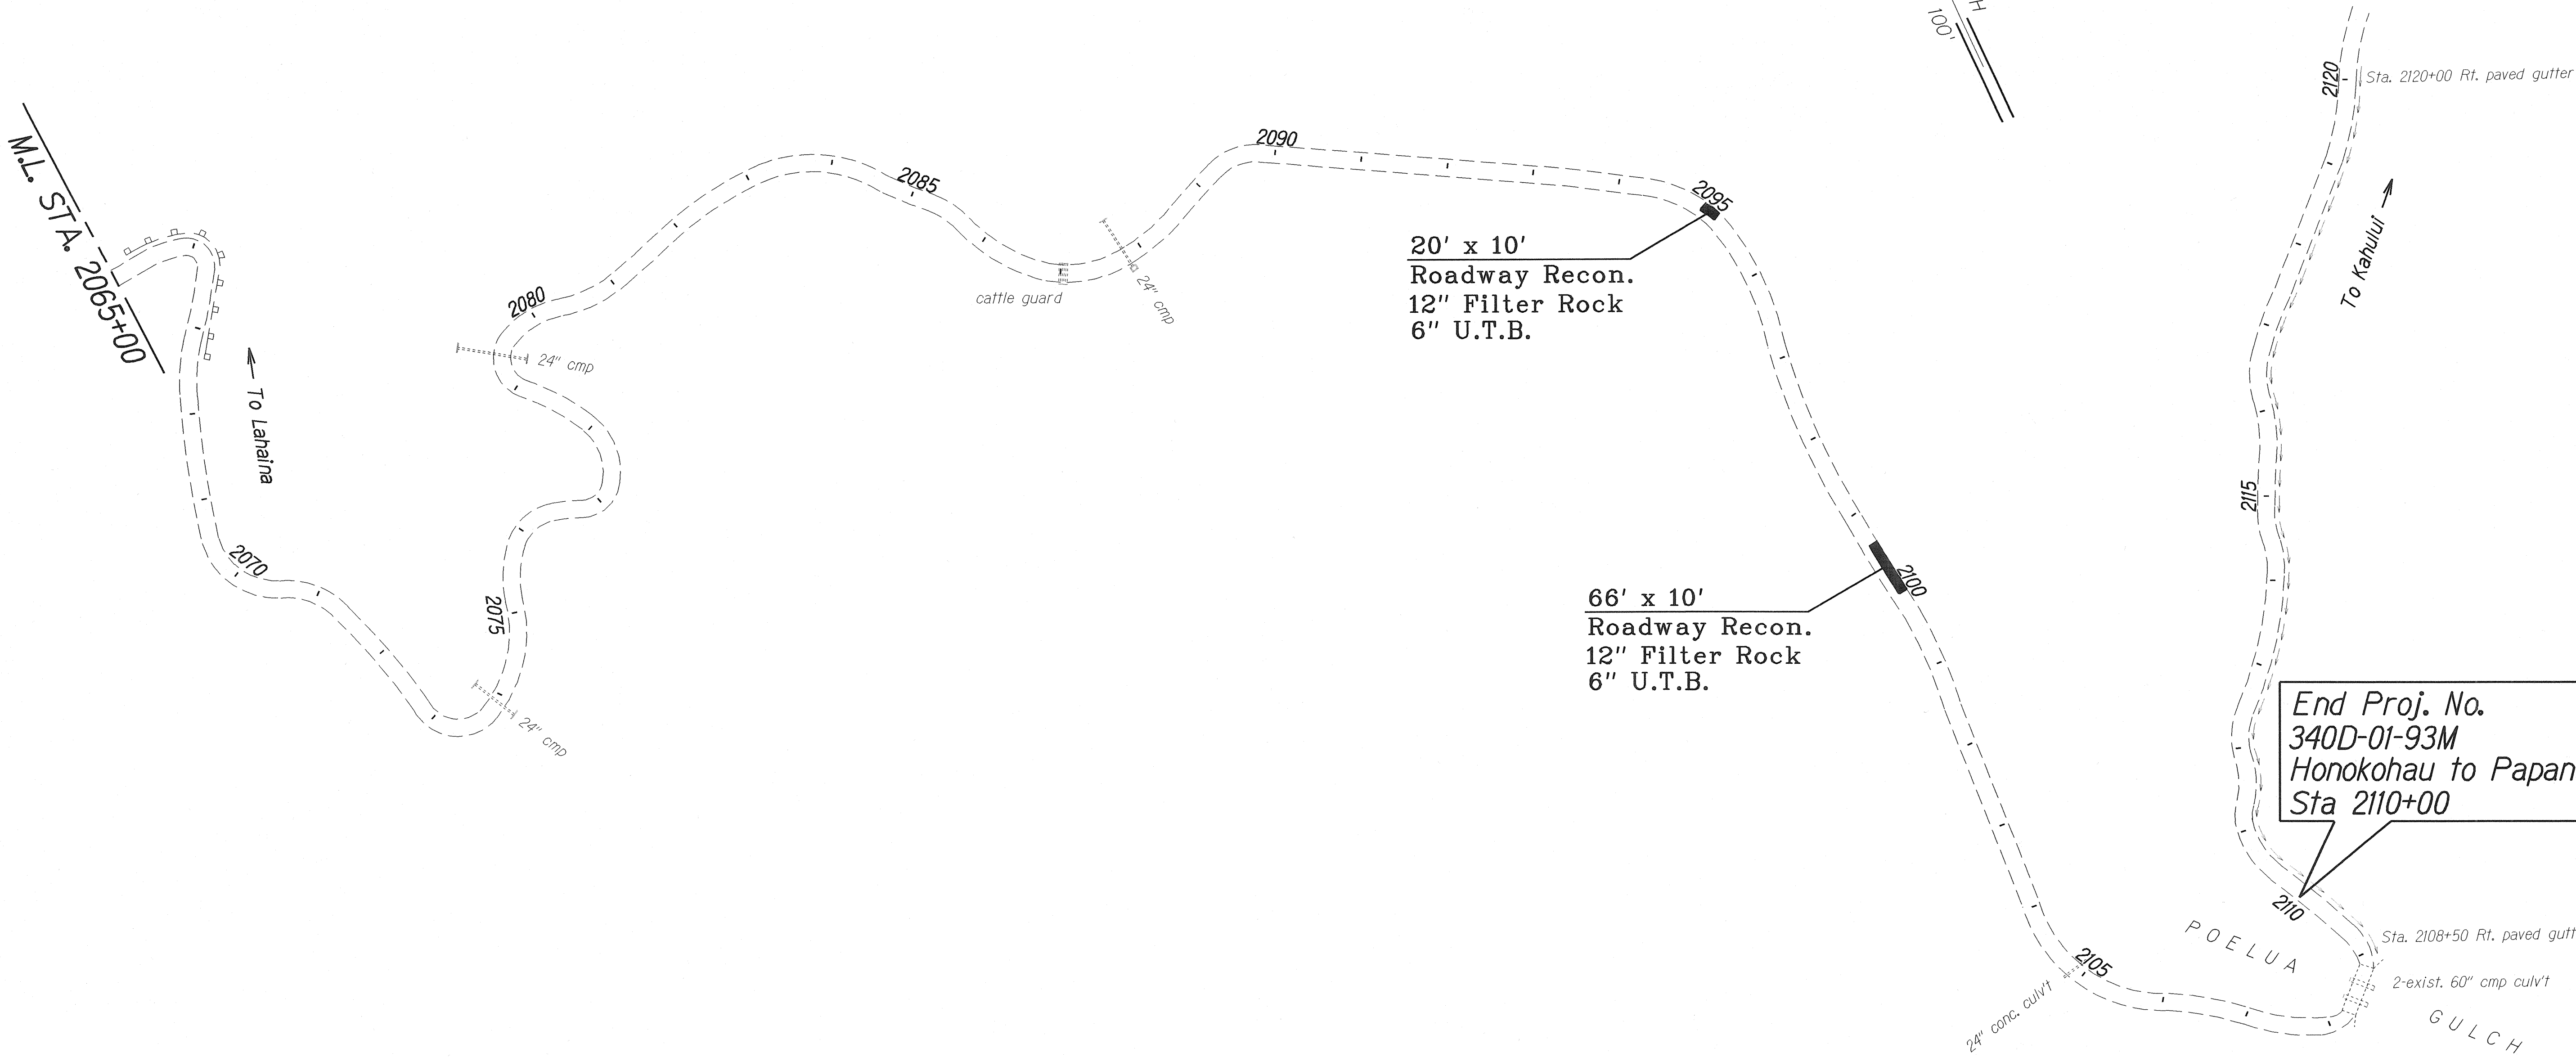

End Proj. No.
340D-01-93M
Honokohau to Papanahoa
Sta 2110+00

LEGEND FOR AS-BUILT POSTINGS	
	Squiggly line for as-built deletion
	Double line for as-built deletion
Roadway	Text for as-built posting

STATE OF HAWAII
DEPARTMENT OF TRANSPORTATION
HIGHWAYS DIVISION
ROADWAY PLAN
KAHEKILI HIGHWAY RESURFACING
Honokohau to Papanahoa
Project No. 340D-01-93M

Scale: 1" = 100'
Date: Apr 11, 1993
SHEET No. 6 OF 6 SHEETS

ORIGINAL PLAN	SURVEY PLOTTED BY	DATE
NOTE BOOK	DRAWN BY	
100% DESIGN	TRACED BY	
NO. 111016	CHECKED BY	