INDEX TO DRAWINGS SHEET NO. DESCRIPTION TITLE SHEET BMP DETAILS LAYOUT PLAN CHANNEL SECTIONS AND ELEVATIONS DRAINAGE DETAILS

STATE OF HAWAII

DEPARTMENT OF TRANSPORTATION

HIGHWAYS DIVISION HONOLULU, HAWAII


"AS-BUILT"
PLANS FOR

KAHEKILI HIGHWAY

WAIEHU TWIN CULVERT REPAIR PROJECT NO. 340C-01-96M


DISTRICT OF WAILUKU ISLAND OF MAUI

SCALE IN HUNDRED FEET

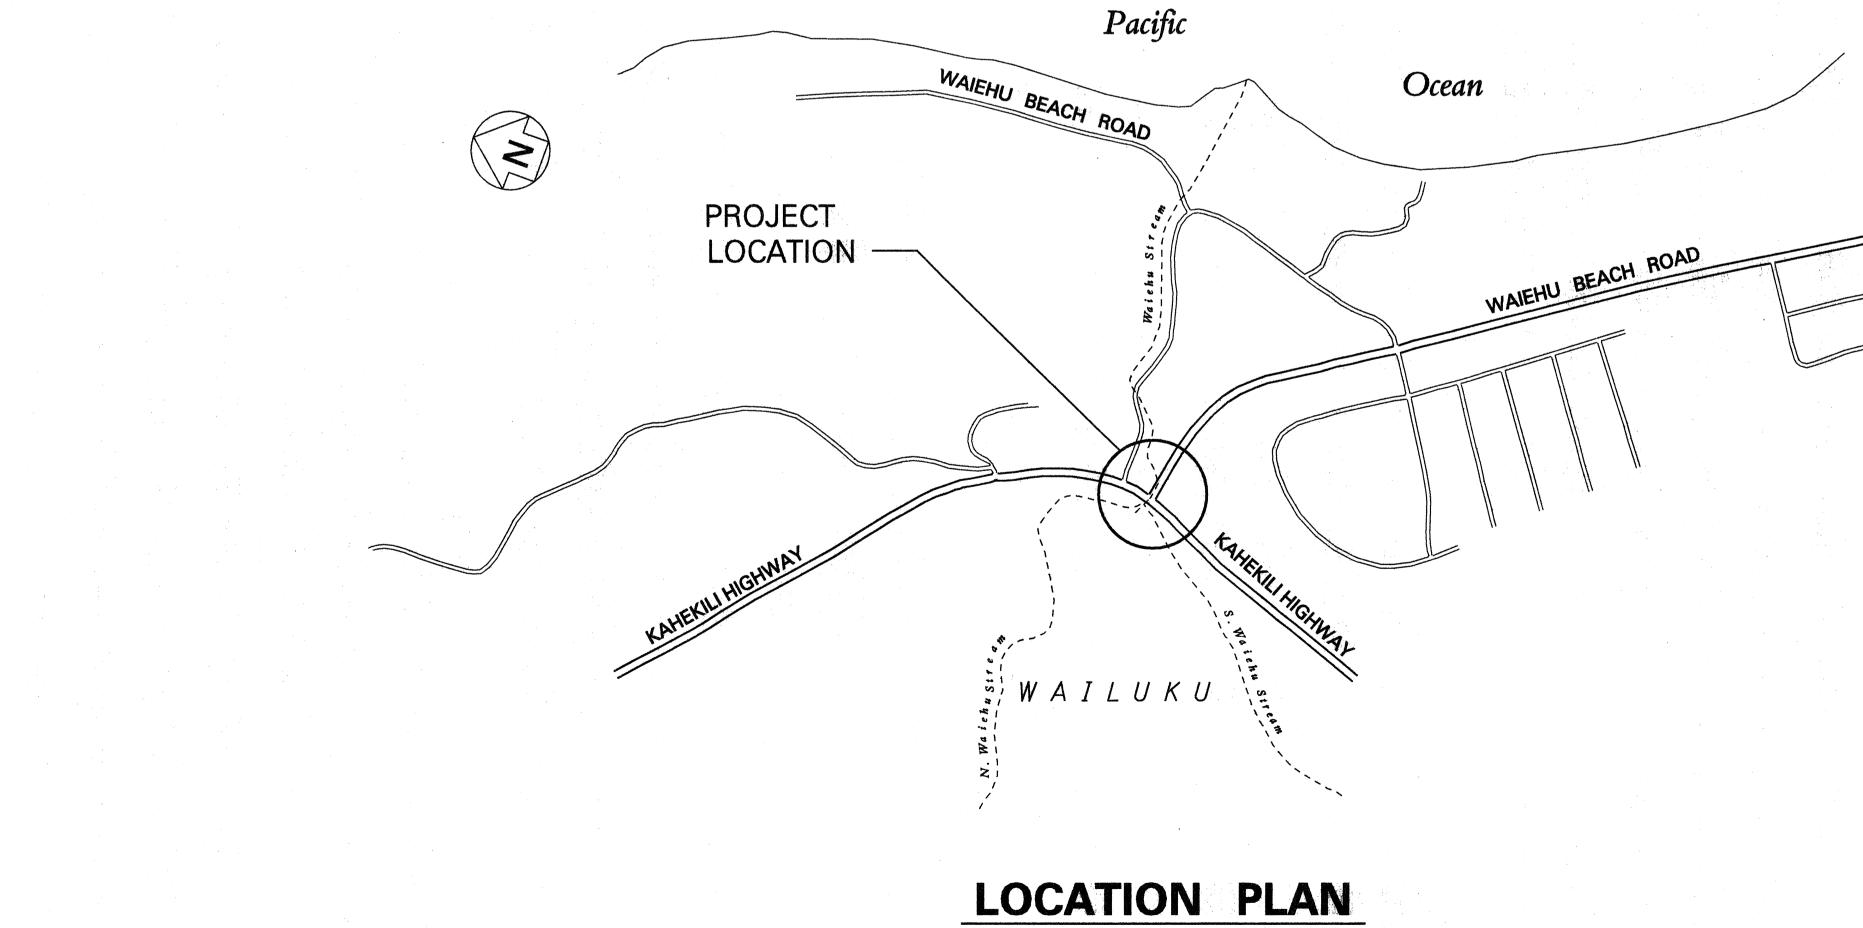

FED. ROAD DIST. NO. STATE PROJ. NO. FISCAL YEAR NO. SHEETS

HAWAII HAW. 340C-01-96M 1996 1 6

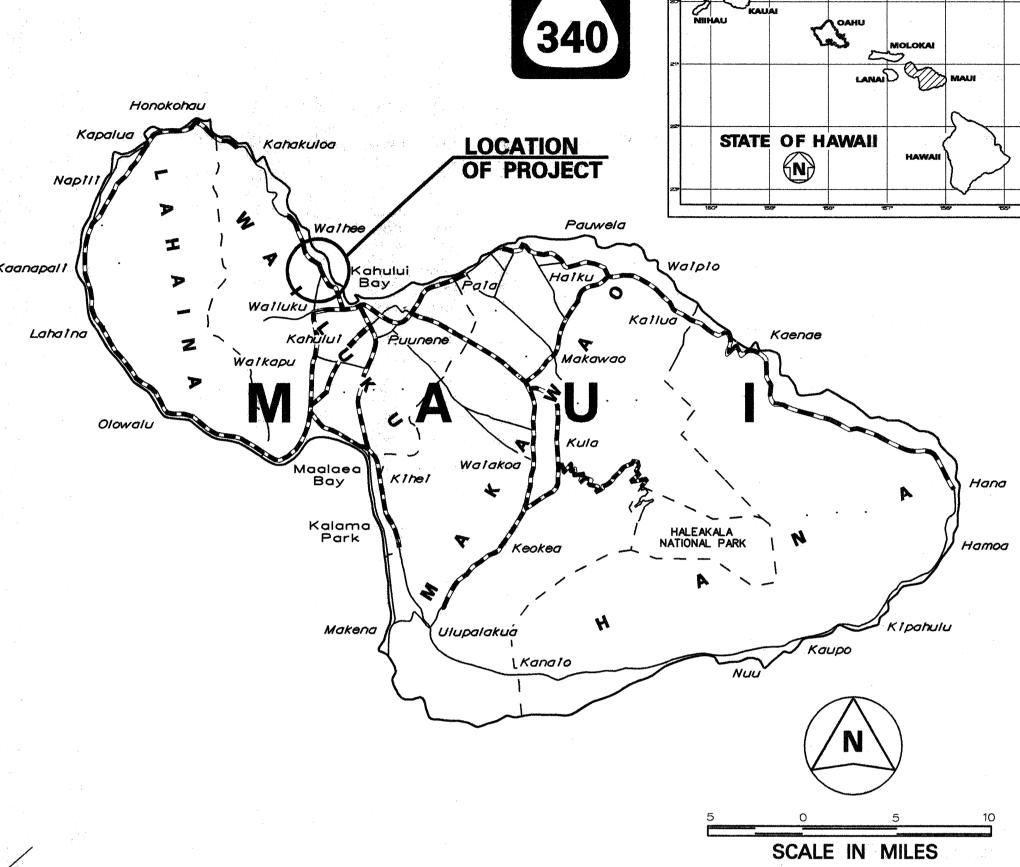

OR UNDER CONSTRUCTION

MILE POST 0.020 TO MILE POST 0.020

CHANGES MADE DURING CONSTRUCTION HAVE BEEN INCORPORATED ON THESE PLANS EXCEPT CHANGES IN THE ORIGINAL THEORETICAL QUANTITIES. FOR ACTUAL QUANTITIES, REFER TO PROJECT LEDGER AND OR SOMPUTATION ROOK.

1-10-02

DEPARTMENT OF TRANSPORTATION STATE OF HAWAII

APPROVED:

DIR. OF TRANSPORTATION DATE

DEC., 1994 **DATE**

R. HIRONAKA P. S. & E. BY