




FED. ROAD DIST. NO.	STATE	PROJ. NO.	FISCAL YEAR	SHEET NO.	TOTAL SHEETS
HAWAII	HAW.	340D-01-97	1998	5	5

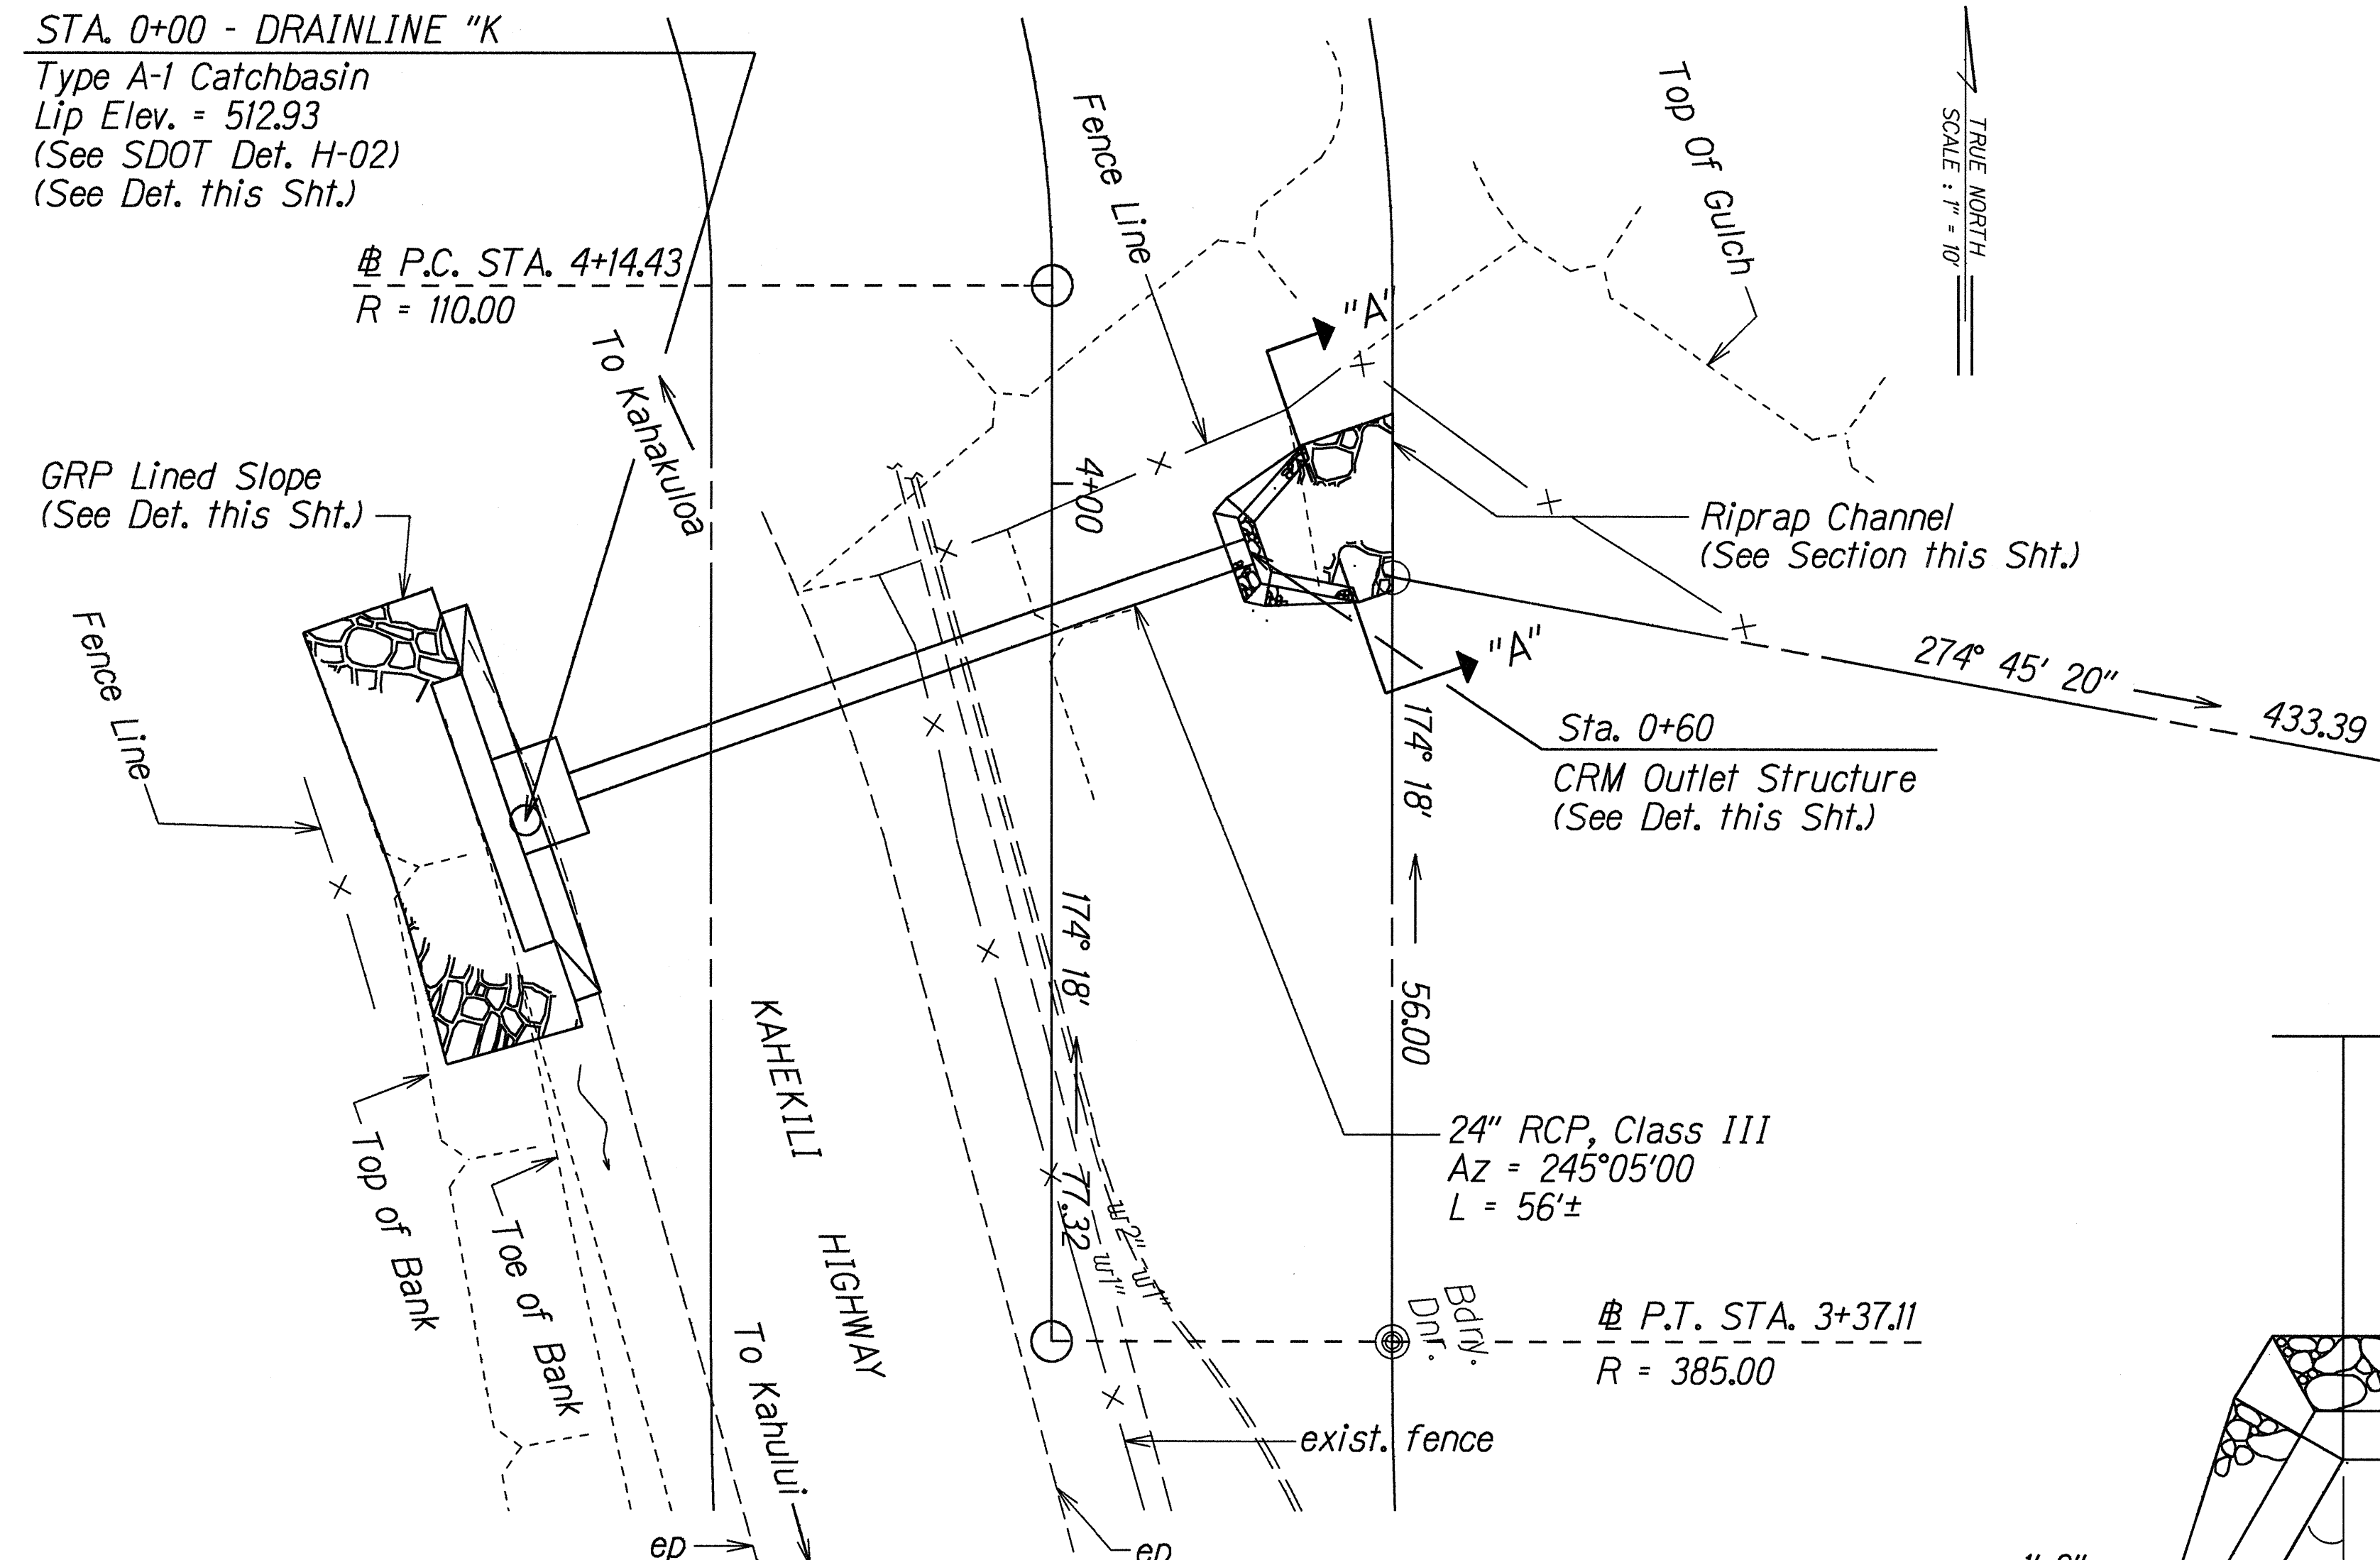


PLAN
Scale: 1" = 10'-0"

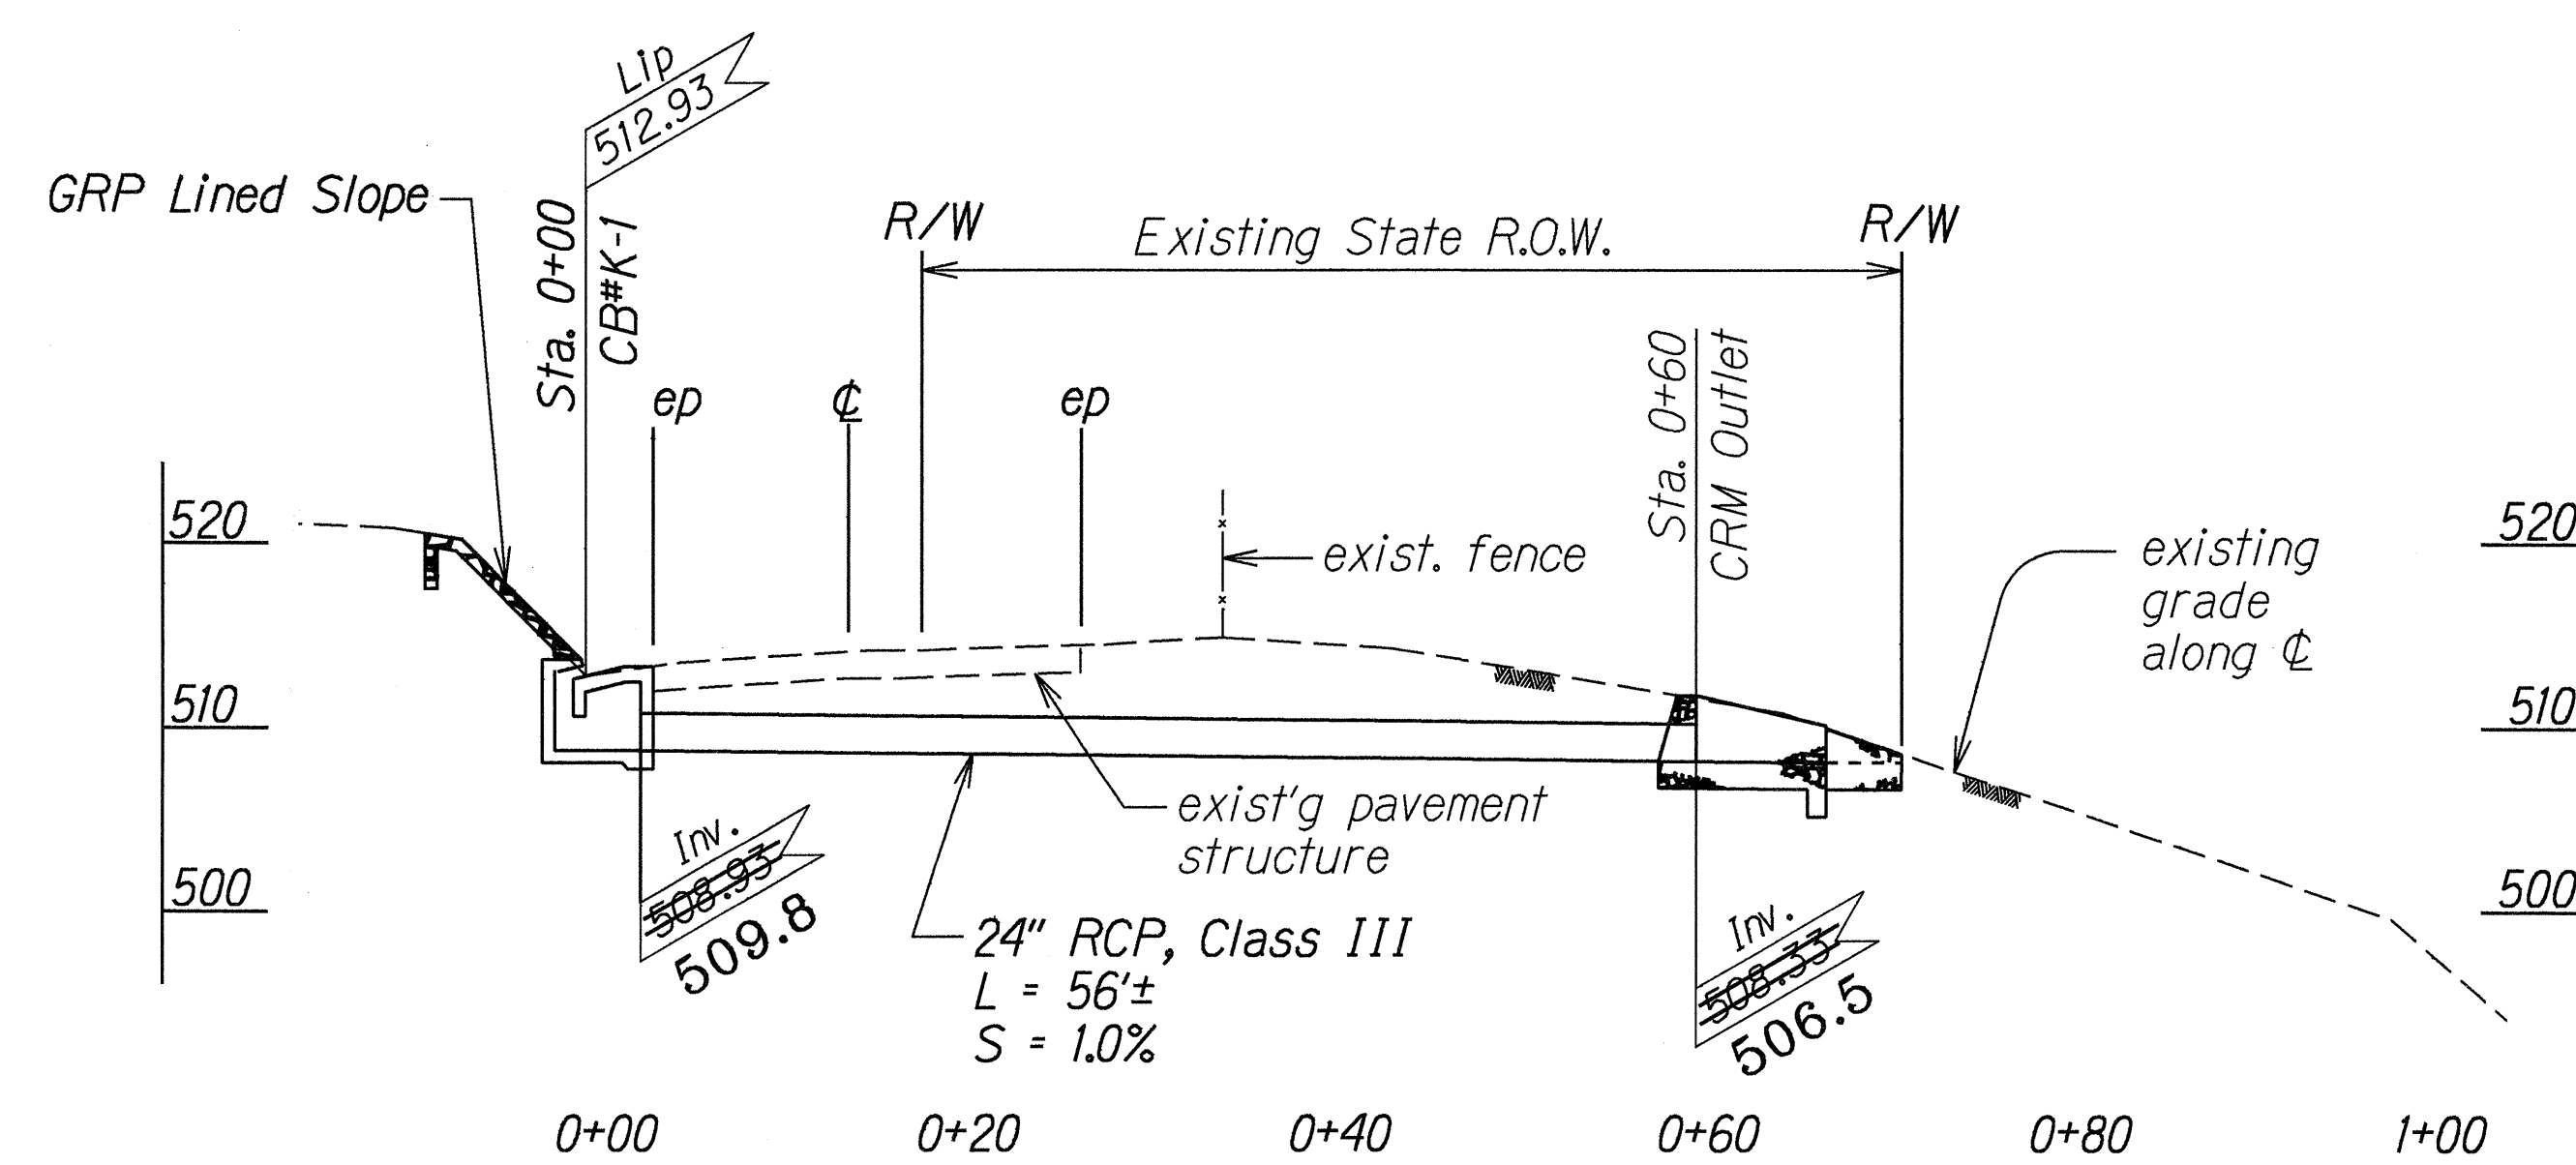


PROFILE - DRAINLINE "K"
Scale: Horiz. 1" = 10'-0"
Vert. 1" = 10'-0"

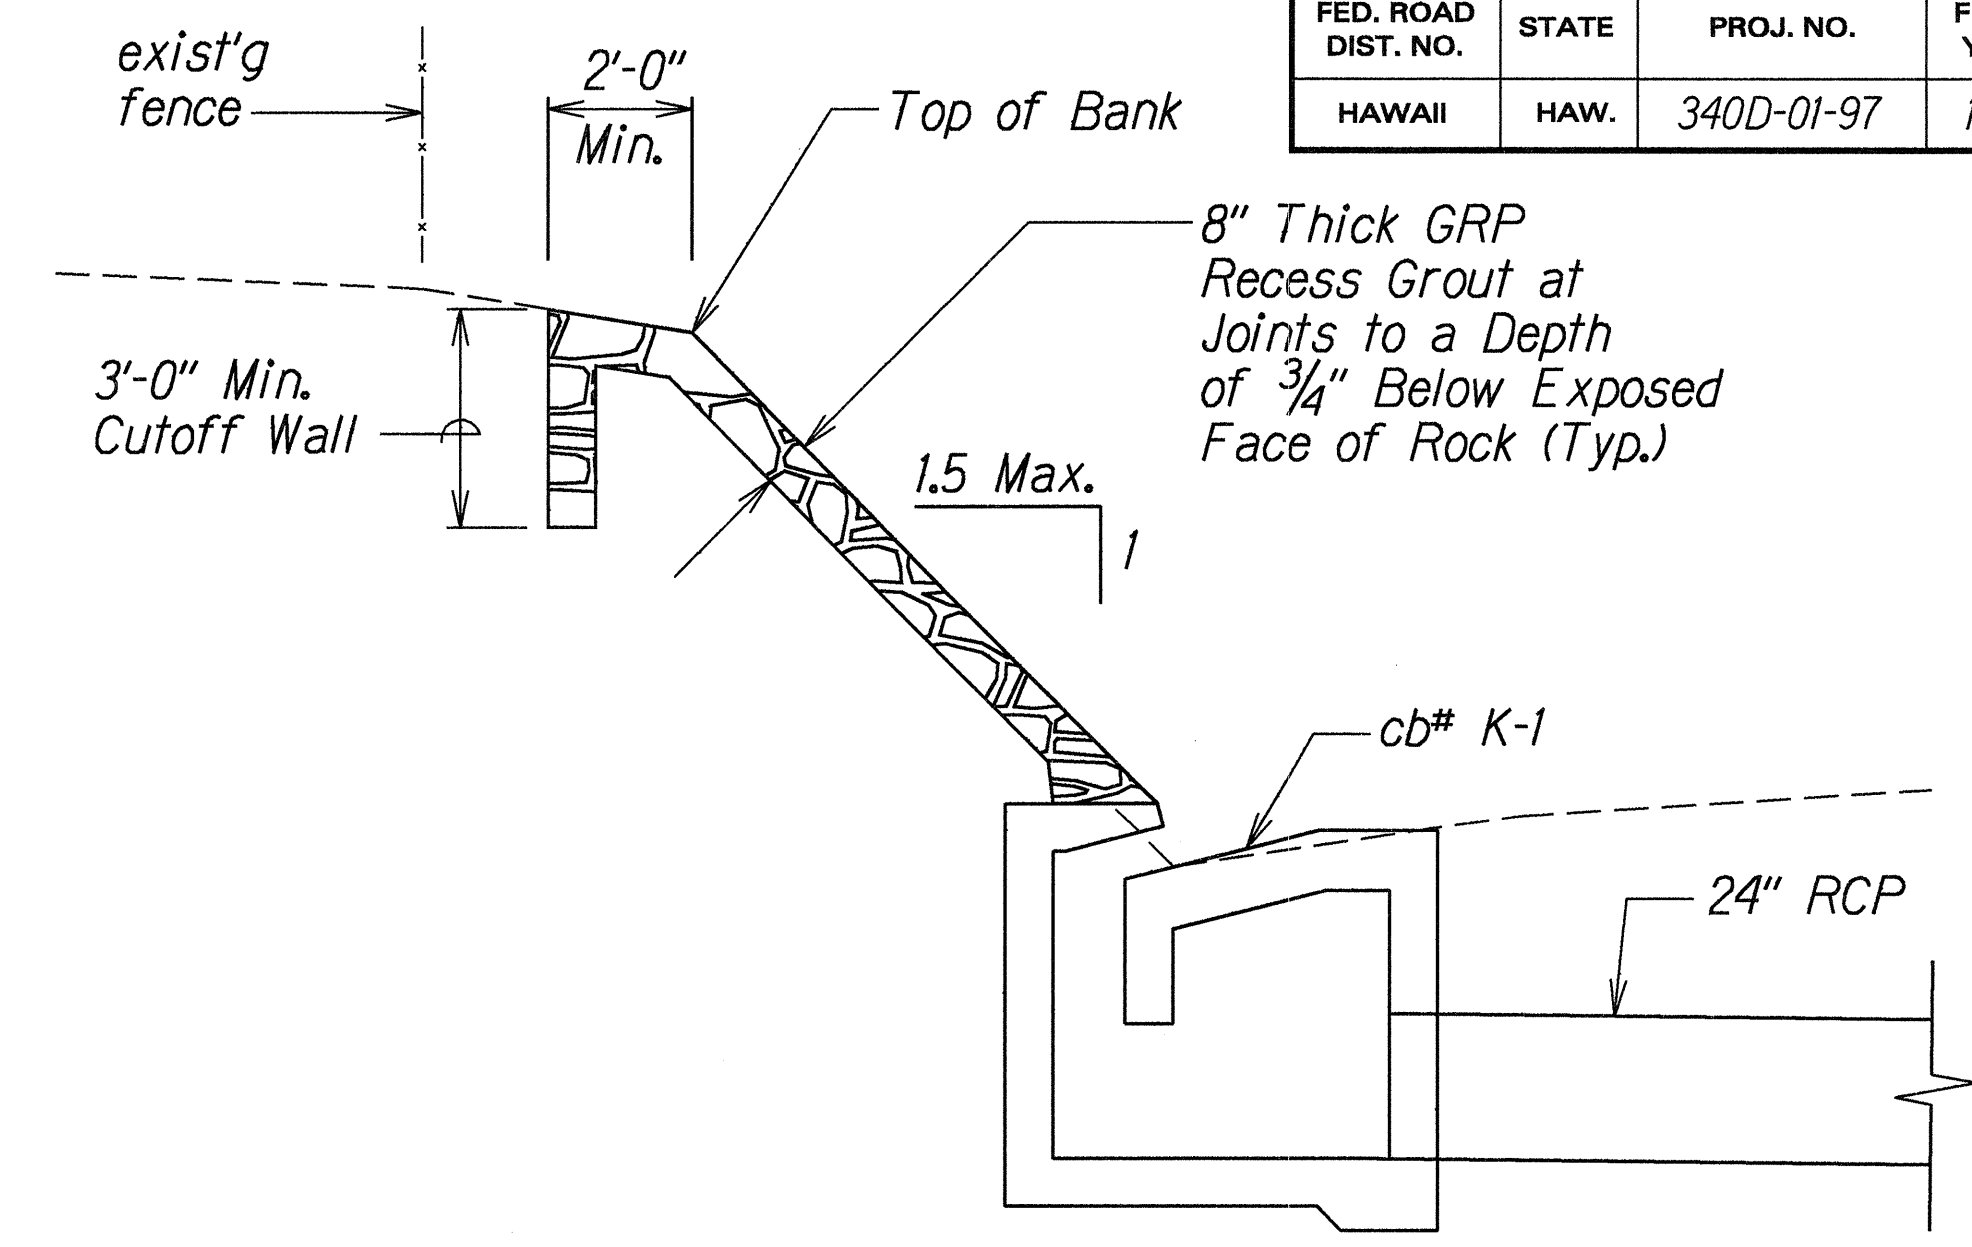


GRP LINED SLOPE
Scale: 3/8" = 1'-0"

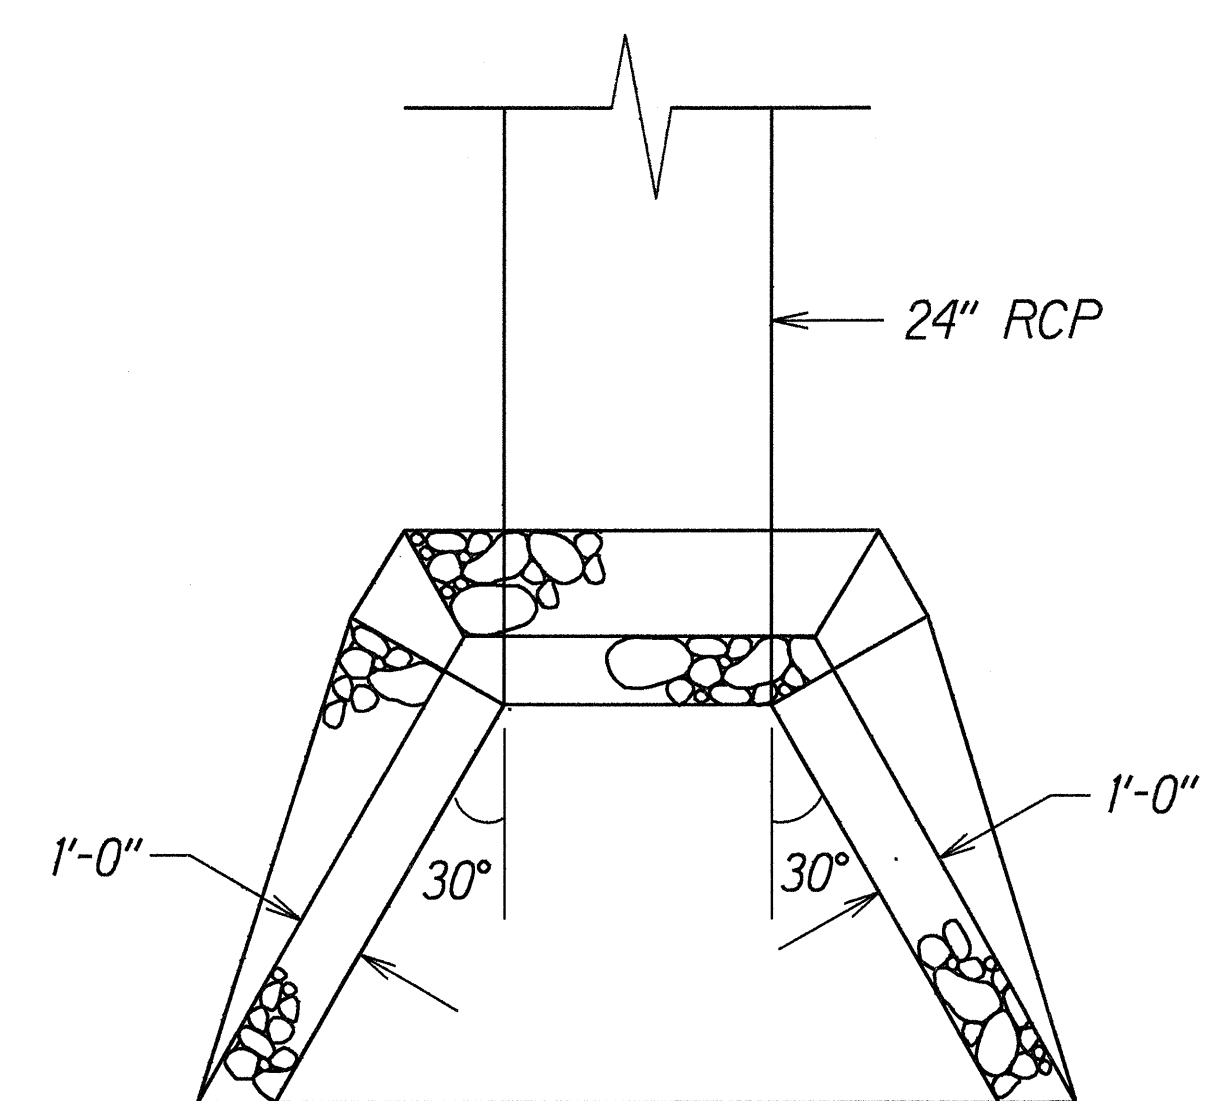


PLAN
Not to Scale

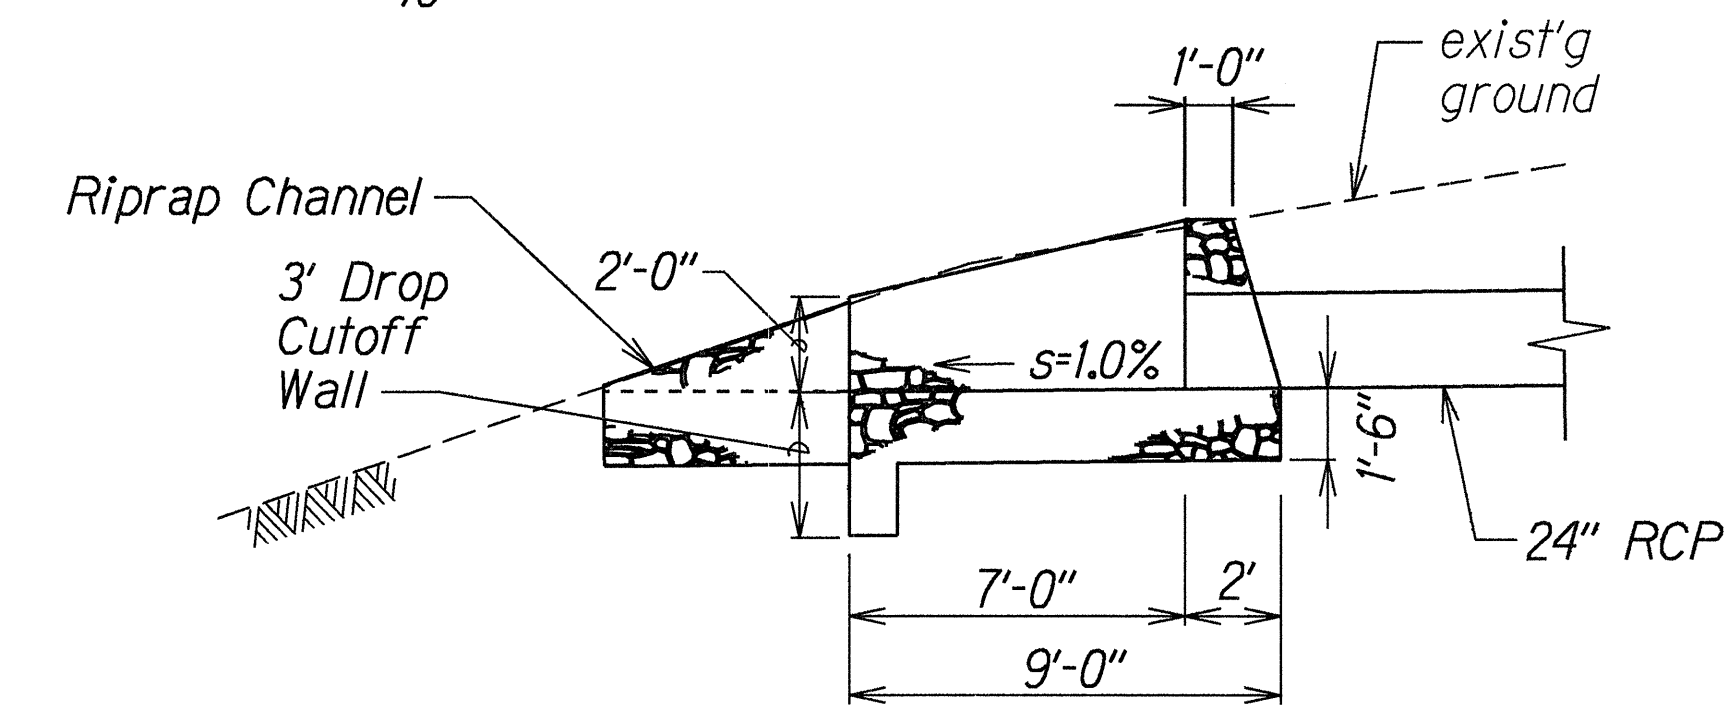

SIDE ELEVATION
Scale: 1/4" = 1'-0"

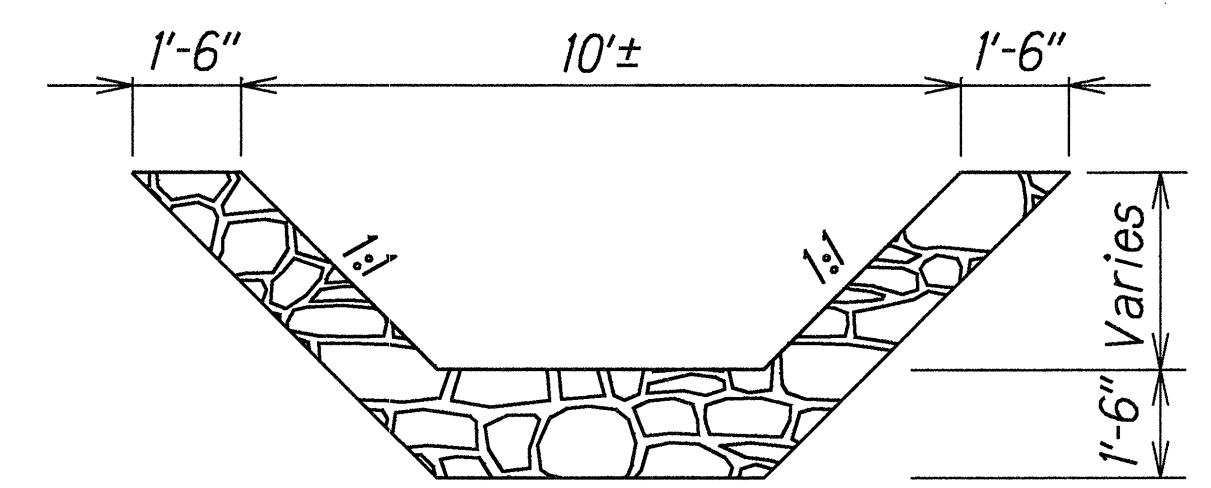

SECTION "A-A" (RIPRAP CHANNEL)
Scale: 3/8" = 1'-0"

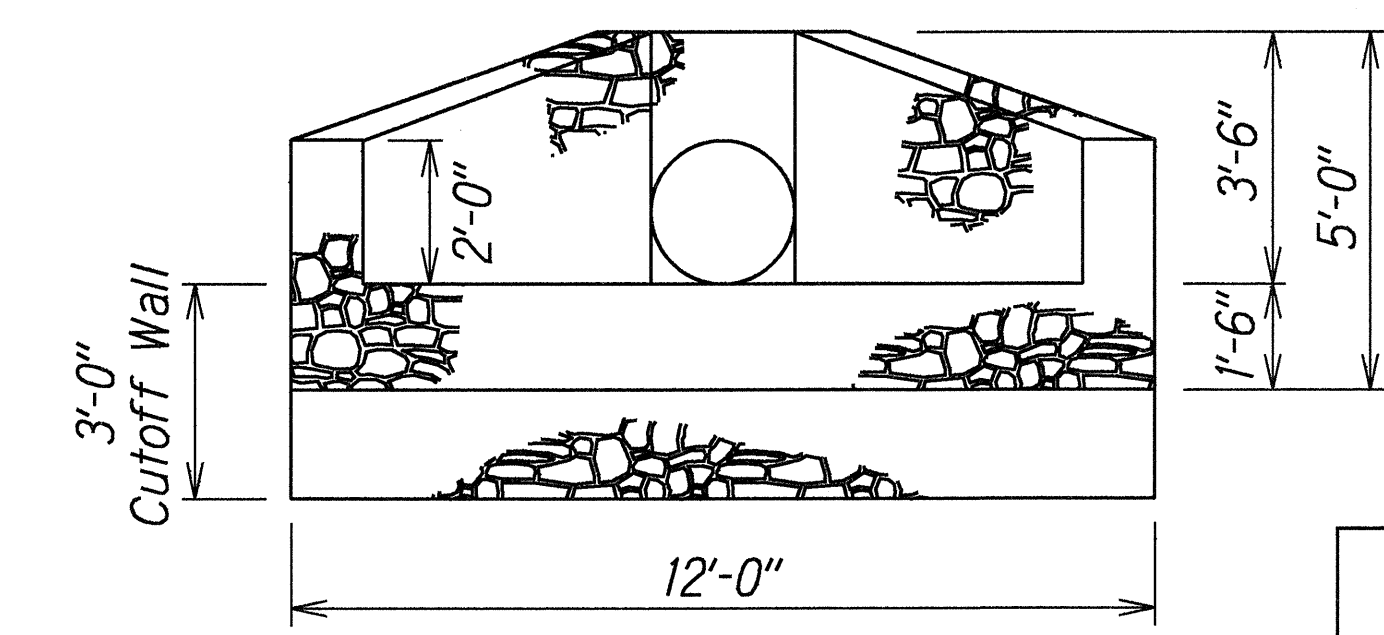

FRONT ELEVATION
Scale: 3/8" = 1'-0"

LEGEND FOR
AS-BUILT POSTINGS

	Squiggly line for as-built deletion
	Double line for as-built deletion
Roadway	Text for as-built posting

STATE OF HAWAII
DEPARTMENT OF TRANSPORTATION
HIGHWAYS DIVISION

PLAN, PROFILE & DRAINAGE DETAILS

KAHEKILI HIGHWAY

DRAINAGE AND SAFETY IMPROVEMENTS

Vicinity of Camp Maluhia

Project No. 340D-01-97

Scale: As Shown Date: March, 1998

SHEET No. 1 OF 1 SHEETS

SURVEY PLOTTED BY	DATE	Mar. 1998
DRAWN BY		
TRACED BY		
NOTES RECDY		
REVISIONS BY		
CHECKED BY		

ORIGINAL PLAN

NOTES RECDY

REVISIONS BY

CHECKED BY