



FED. ROAD DIST. NO.	STATE	PROJ. NO.	FISCAL YEAR	SHEET NO.	TOTAL SHEETS
HAWAII	HAW.	340CD-01-02M	2002	19	33

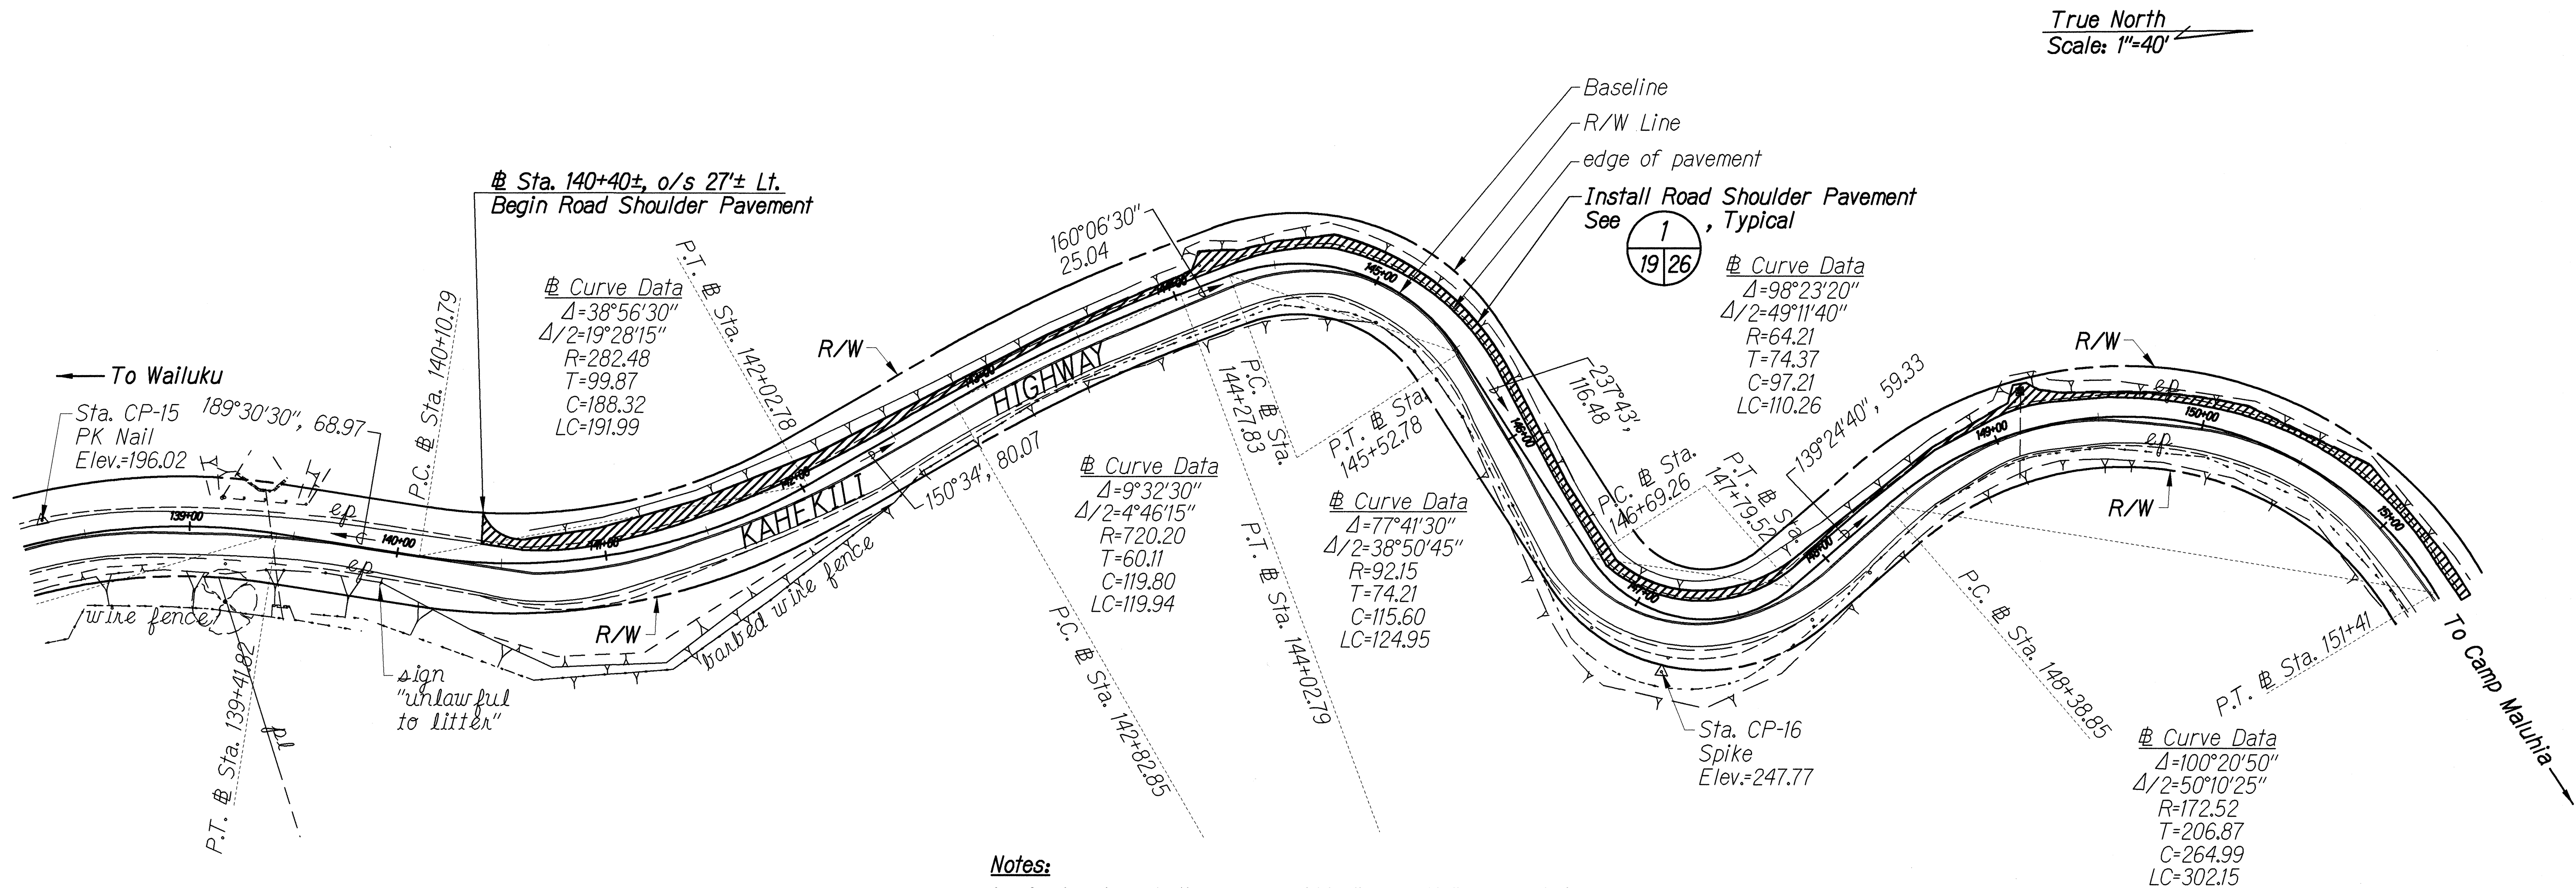

- Notes:
- Contractor shall remove rubble "Build Up" and debris that has accumulated at the bottom of slope and along the road shoulder area, prior to installation of Road Shoulder Pavement.
 - Contractor shall install Type "D" Pavement Markers wherever missing within the centerline stripe of the road between Sta. 140+00 to Sta. 224+00. Type "D" Pavement Markers are to be installed at 20' o.c.
 - Contractor shall install Type "C" Pavement Markers along the edge stripe of the road in both directions between Sta. 140+00 to Sta. 224+00. Type "C" Pavement Markers are to be installed at 40' o.c.

ROAD SHOULDER PAVING PLAN STA. 139+00 TO STA. 151+00
SCALE: 1"=40'

SURVEY PLOTTED BY	DATE
DRAWN BY	
DESIGNED BY	
QUANTITIES BY	
CHECKED BY	

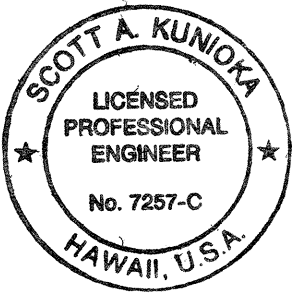

THIS WORK WAS PREPARED BY ME
OR UNDER MY SUPERVISION
Scott A. Kuno
SHINABUKURO, ENDO & YOSHIZAKI, INC.
1126 12TH AVENUE
HONOLULU, HAWAII 96816

STATE OF HAWAII
DEPARTMENT OF TRANSPORTATION
HIGHWAYS DIVISION

ROAD SHOULDER PAVING PLAN
STA. 139+00 TO STA. 151+00


Kahekili Hwy. Repairs and Maintenance
Waiehu Beach Road to Camp Maluhia
Project No. 340CD-01-02M

Scale: 1"=40' Date: March 21, 2002

SHEET No. 1 OF 6 SHEETS


FED. ROAD DIST. NO.	STATE	PROJ. NO.	FISCAL YEAR	SHEET NO.	TOTAL SHEETS
HAWAII	HAW.	340CD-01-02M	2002	20	33

- Notes:**
- Contractor shall remove rubble "Build Up" and debris that has accumulated at the bottom of slope and along the road shoulder area, prior to installation of Road Shoulder Pavement.
 - Contractor shall install Type "D" Pavement Markers wherever missing within the centerline stripe of the road between Sta. 140+00 to Sta. 224+00. Type "D" Pavement Markers are to be installed at 20' o.c.
 - Contractor shall install Type "C" Pavement Markers along the edge stripe of the road in both directions between Sta. 140+00 to Sta. 224+00. Type "C" Pavement Markers are to be installed at 40' o.c.

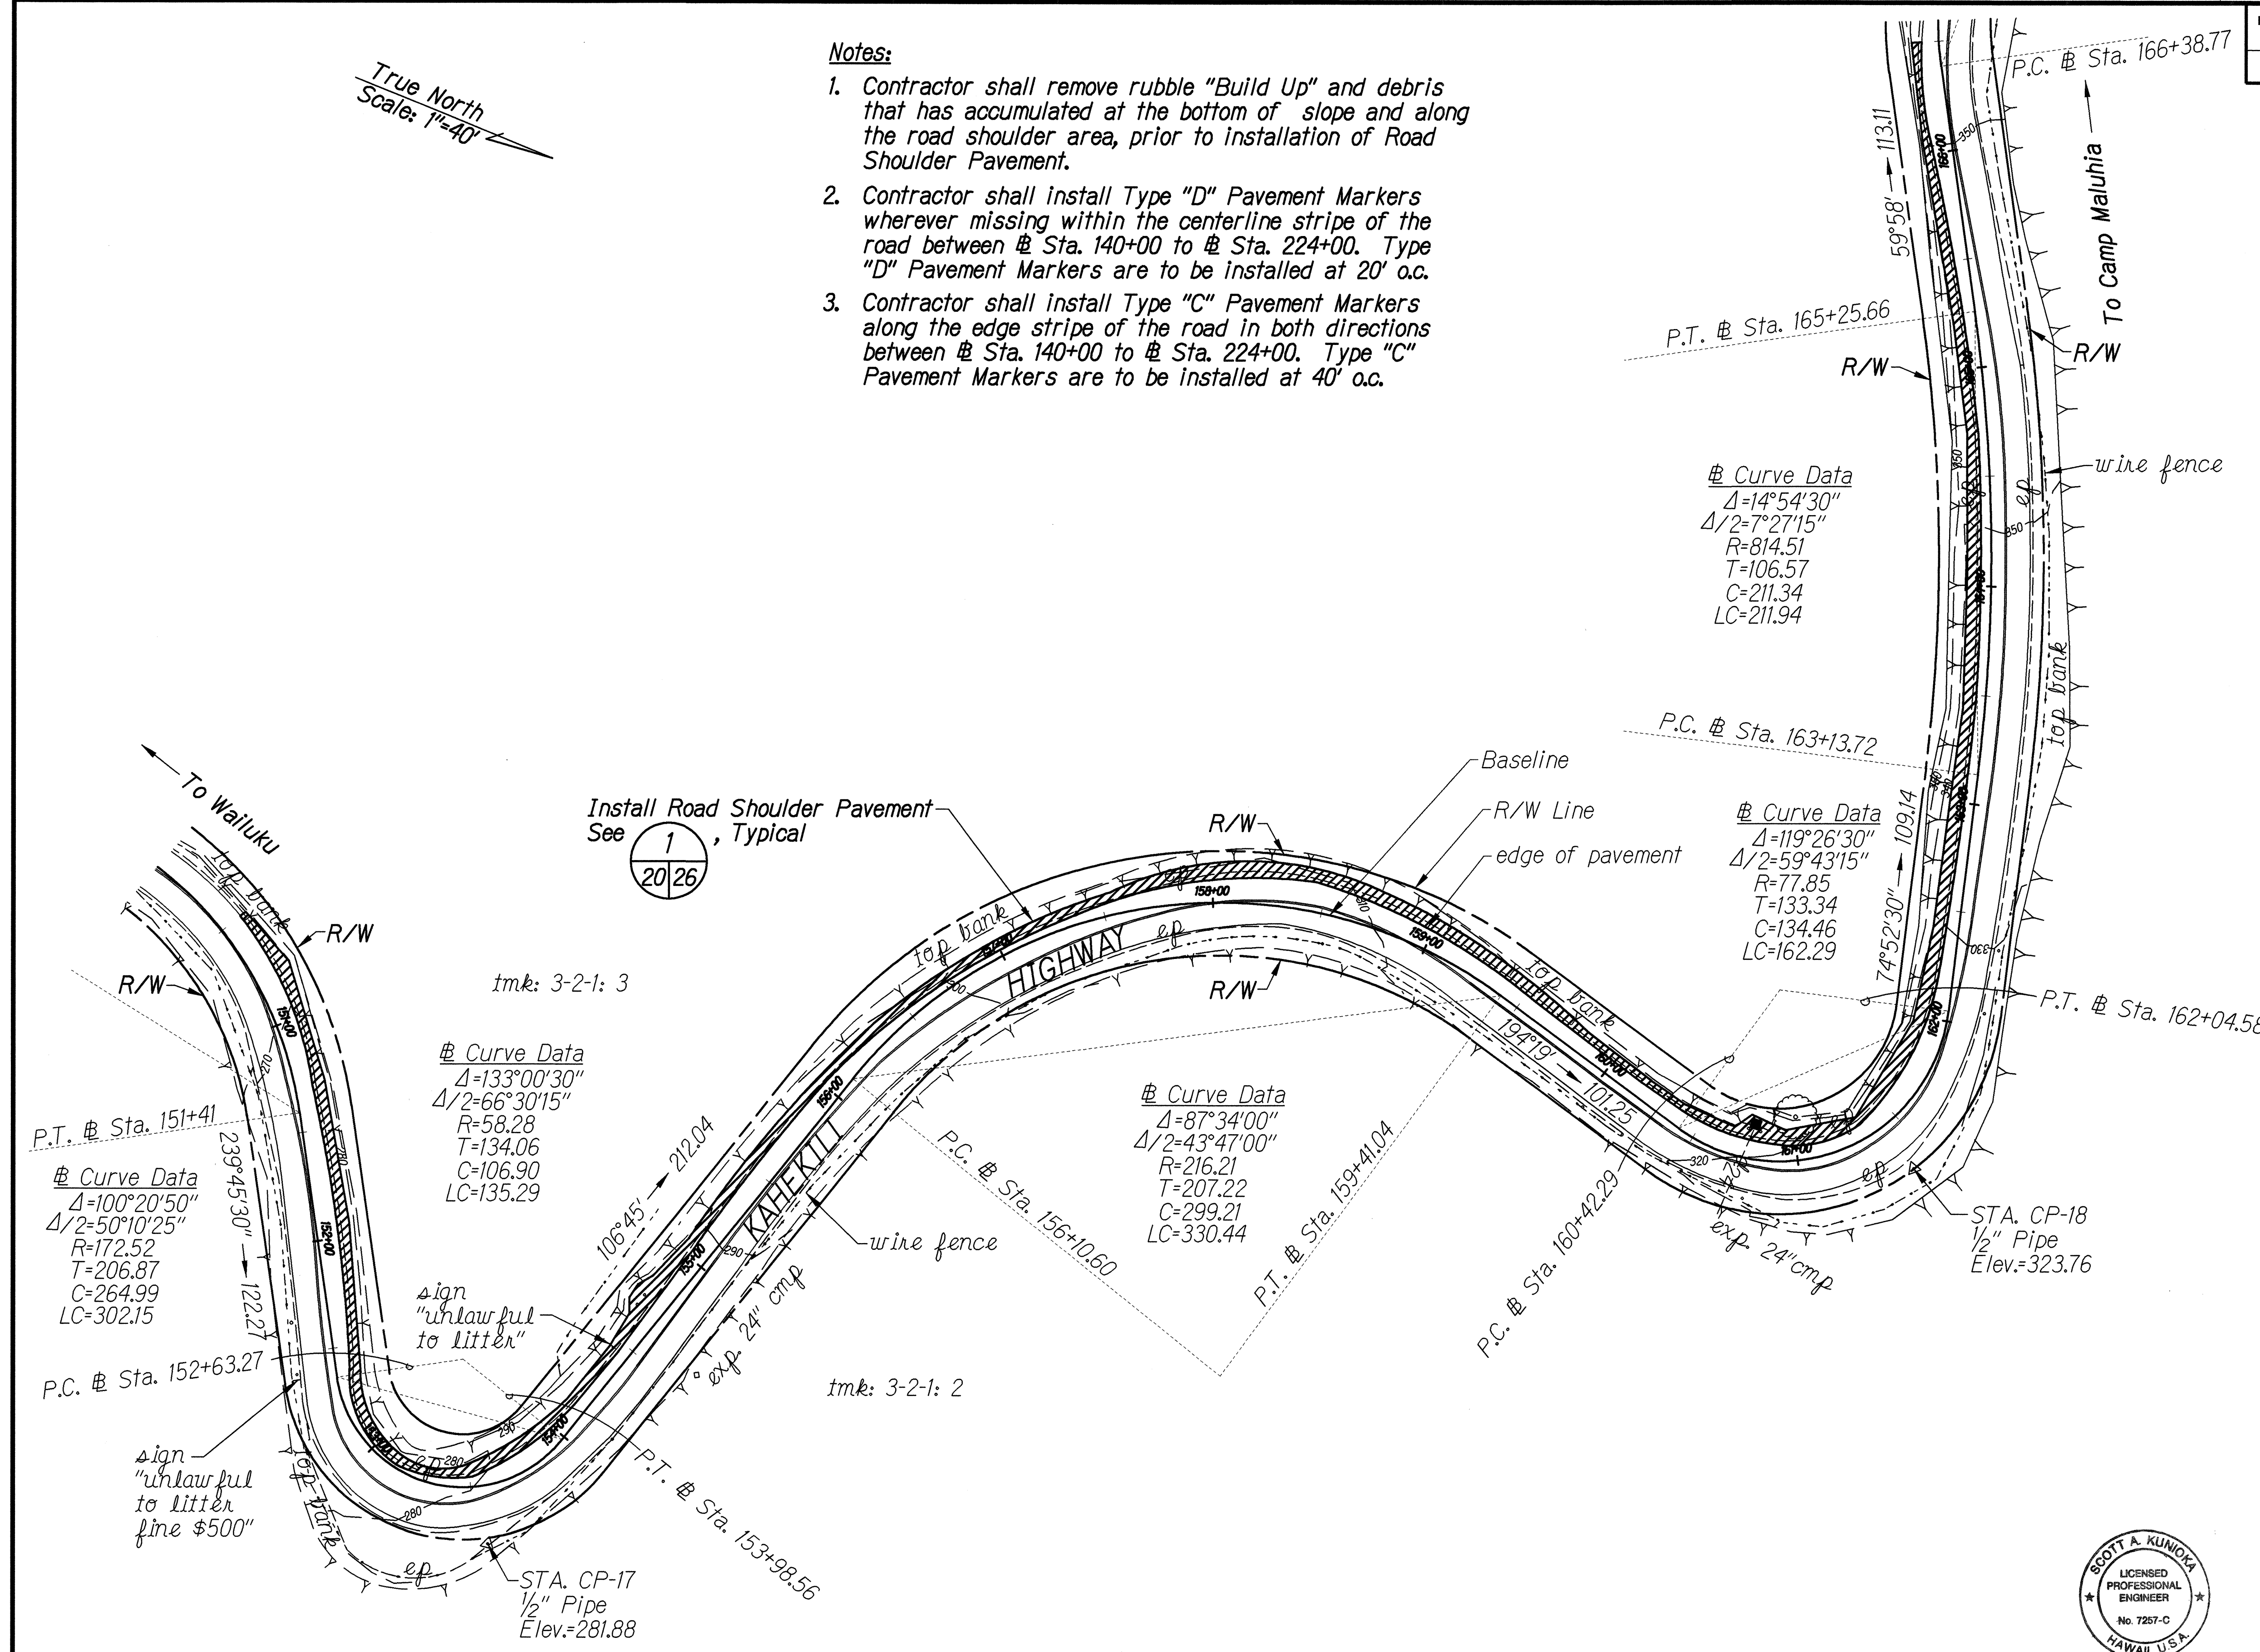

SURVEY PLOTTED BY	DATE
DRAWN BY	
TRACED BY	
QUANTITIES BY	
CHECKED BY	
ORIGINAL PLAN	
NOTE BOOK	
N.	

ROAD SHOULDER PAVING PLAN Sta. 151+00 TO Sta. 166+00 SCALE: 1"=40'

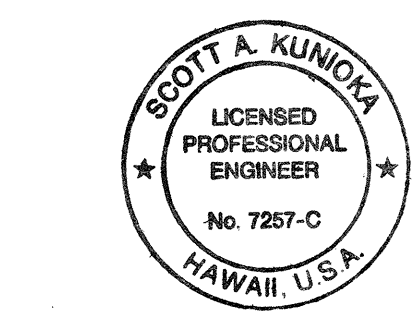

THIS WORK WAS PREPARED BY ME OR UNDER MY SUPERVISION
Scott A. Kunio
 SHIMABUKURO, ENDO & YOSHIZAKI, INC.
 1126 12TH Avenue
 Honolulu, Hawaii 96816

STATE OF HAWAII
 DEPARTMENT OF TRANSPORTATION
 HIGHWAYS DIVISION


ROAD SHOULDER PAVING PLAN
Sta. 151+00 TO Sta. 166+00
 Kahekili Hwy. Repairs and Maintenance
 Walehu Beach Road to Camp Maluhia
 Project No. 340CD-01-02M
 Scale: 1"=40' Date: March 21, 2002

SHEET No. 2 OF 6 SHEETS


FED. ROAD DIST. NO.	STATE	PROJ. NO.	FISCAL YEAR	SHEET NO.	TOTAL SHEETS
HAWAII	HAW.	340CD-01-02M	2002	21	33

Notes:

- Contractor shall remove rubble "Build Up" and debris that has accumulated at the bottom of slope and along the road shoulder area, prior to installation of Road Shoulder Pavement.
- Contractor shall install Type "D" Pavement Markers wherever missing within the centerline stripe of the road between Sta. 140+00 to Sta. 224+00. Type "D" Pavement Markers are to be installed at 20' o.c.
- Contractor shall install Type "C" Pavement Markers along the edge stripe of the road in both directions between Sta. 140+00 to Sta. 224+00. Type "C" Pavement Markers are to be installed at 40' o.c.

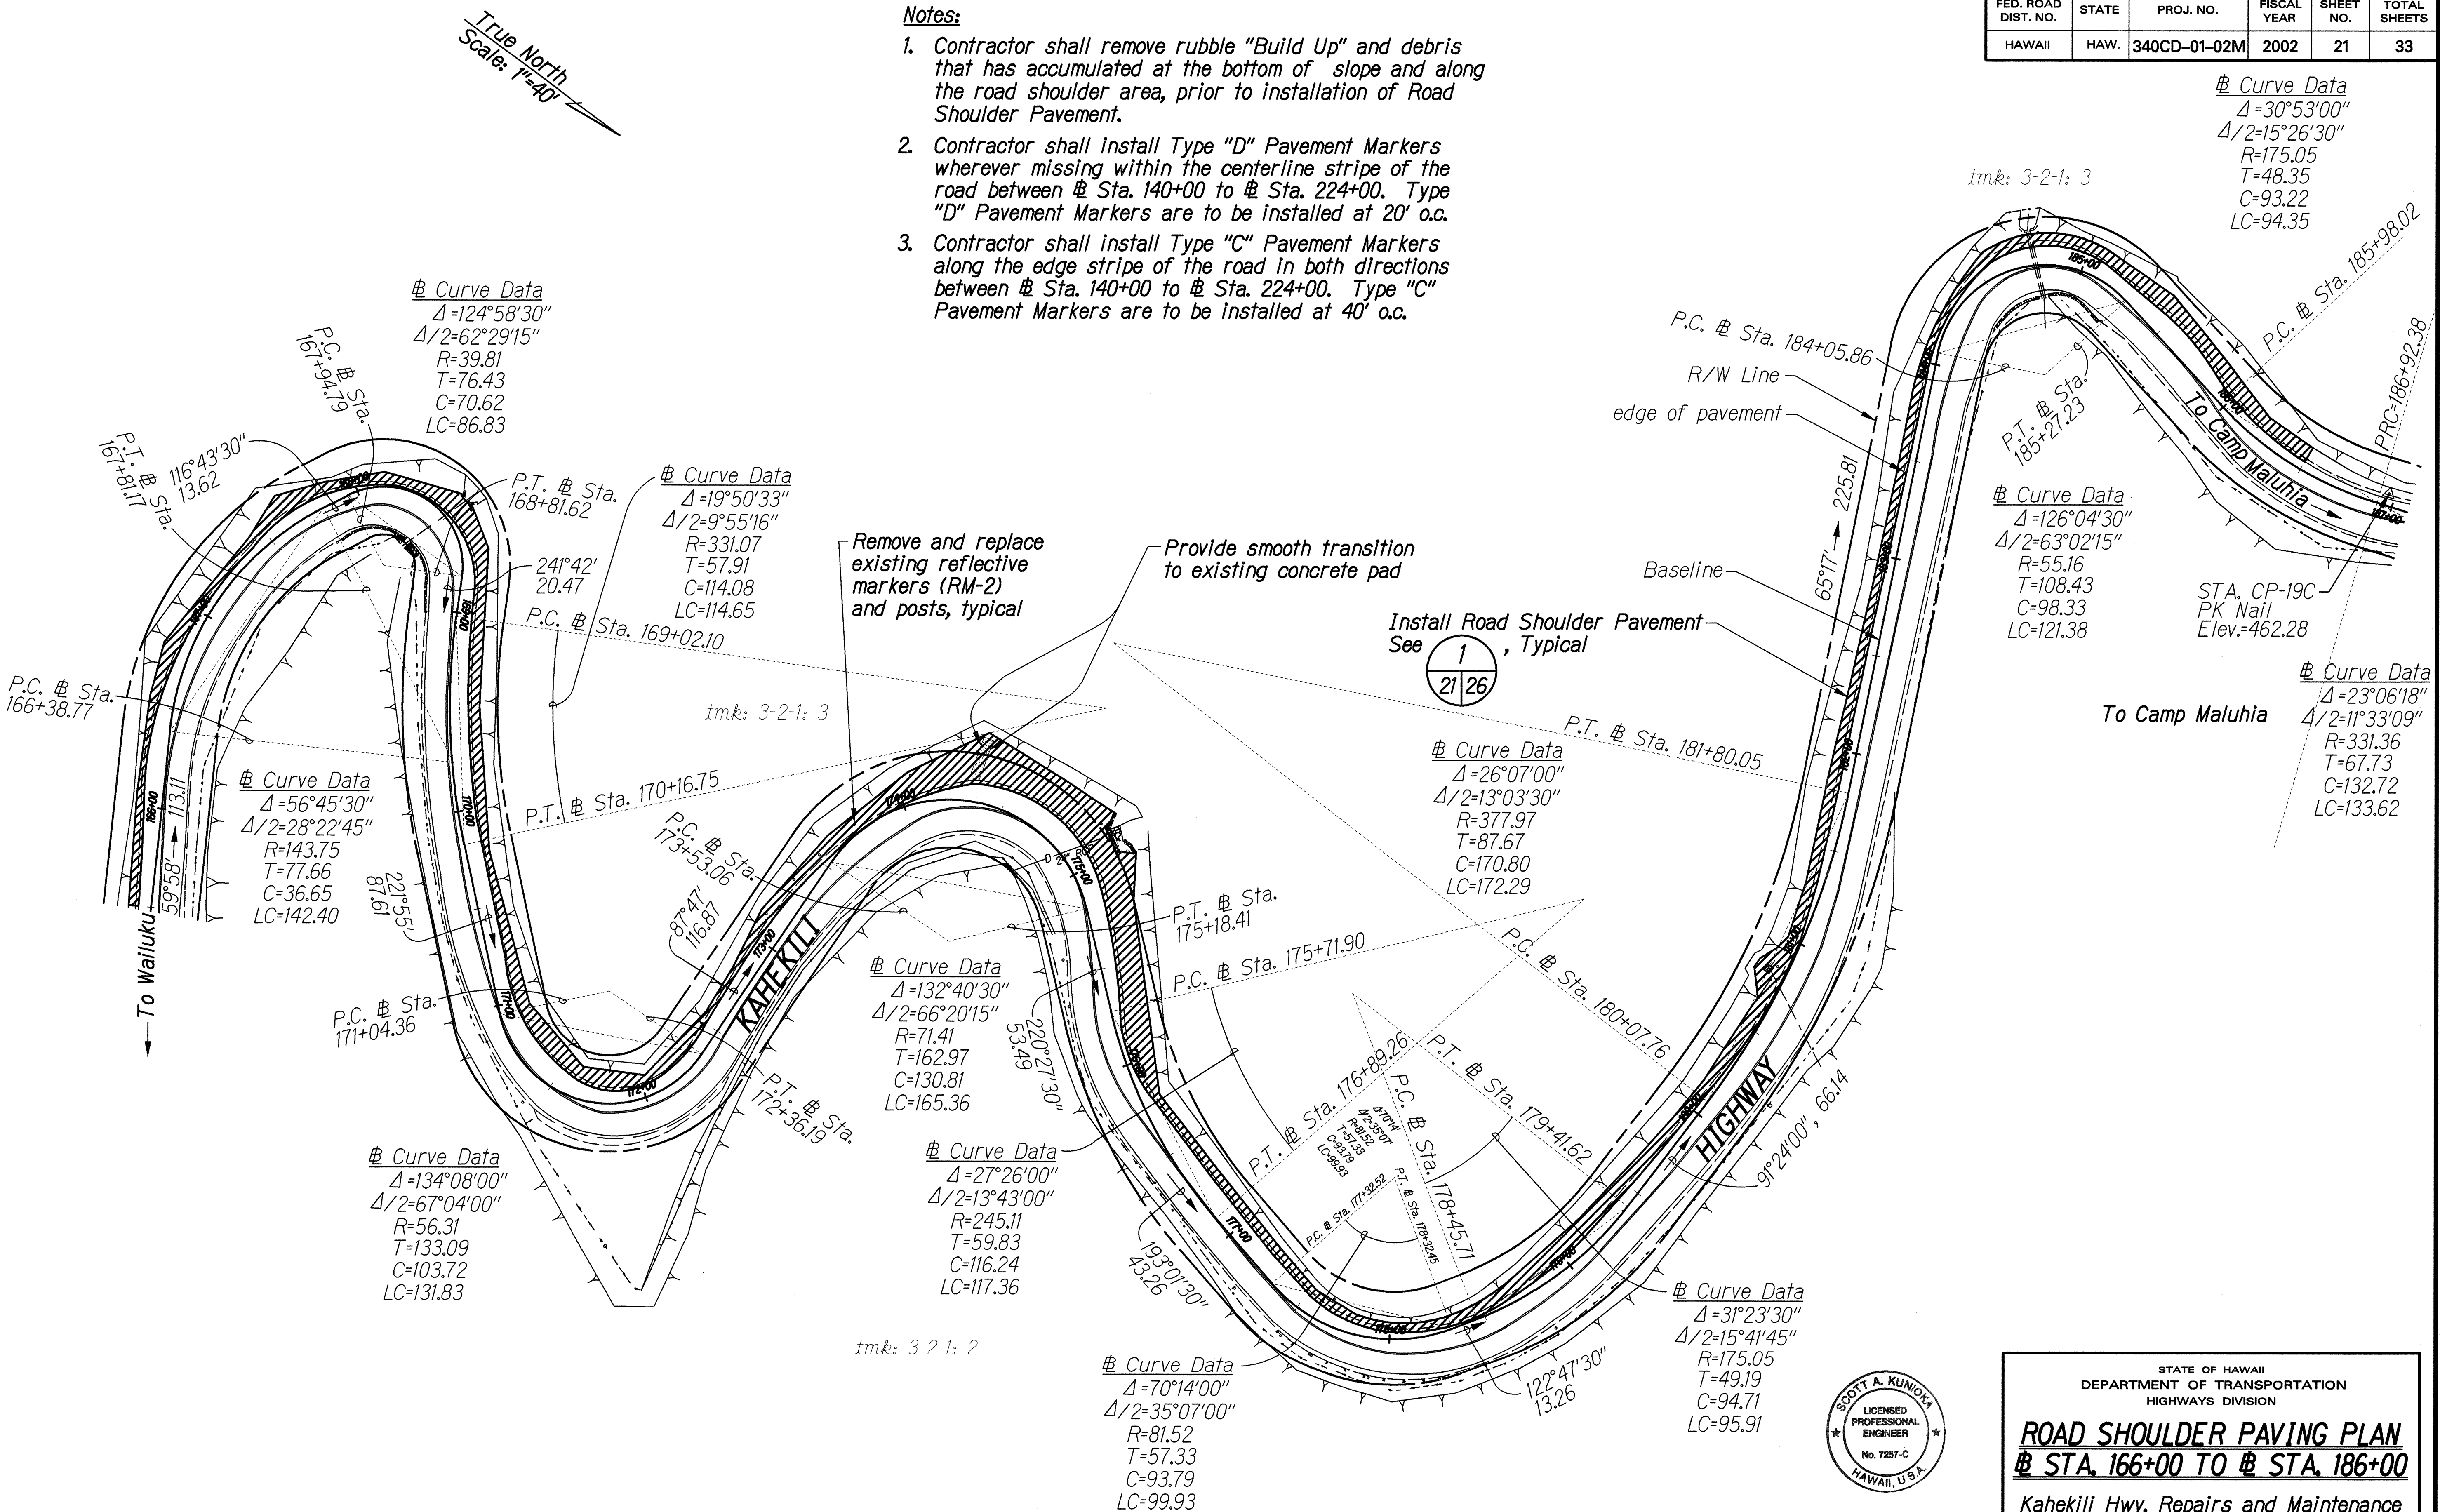

ROAD SHOULDER PAVING PLAN # STA. 166+00 TO # STA. 186+00 SCALE: 1"=40'

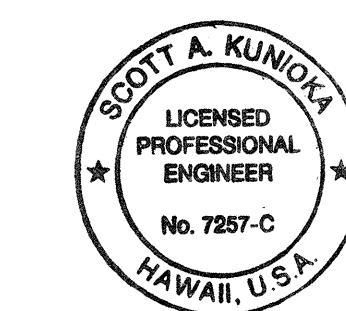

THIS WORK WAS PREPARED BY ME OR UNDER MY SUPERVISION

Scott A. Kunka

SHIMABUKURO, ENDO & YOSHIZAKI, INC.
1126 12TH AVENUE
HONOLULU, HAWAII 96816


STATE OF HAWAII
DEPARTMENT OF TRANSPORTATION
HIGHWAYS DIVISION

ROAD SHOULDER PAVING PLAN
STA. 166+00 TO # STA. 186+00
Kahekili Hwy. Repairs and Maintenance
Walehu Beach Road to Camp Maluhia
Project No. 340CD-01-02M
Scale: 1"=40' Date: March 21, 2002


SHEET No. 3 OF 6 SHEETS

FED. ROAD DIST. NO.	STATE	PROJ. NO.	FISCAL YEAR	SHEET NO.	TOTAL SHEETS
HAWAII	HAW.	340CD-01-02M	2002	22	33

- Notes:**
- Contractor shall remove rubble "Build Up" and debris that has accumulated at the bottom of slope and along the road shoulder area, prior to installation of Road Shoulder Pavement.
 - Contractor shall install Type "D" Pavement Markers wherever missing within the centerline stripe of the road between Sta. 140+00 to Sta. 224+00. Type "D" Pavement Markers are to be installed at 20' o.c.
 - Contractor shall install Type "C" Pavement Markers along the edge stripe of the road in both directions between Sta. 140+00 to Sta. 224+00. Type "C" Pavement Markers are to be installed at 40' o.c.

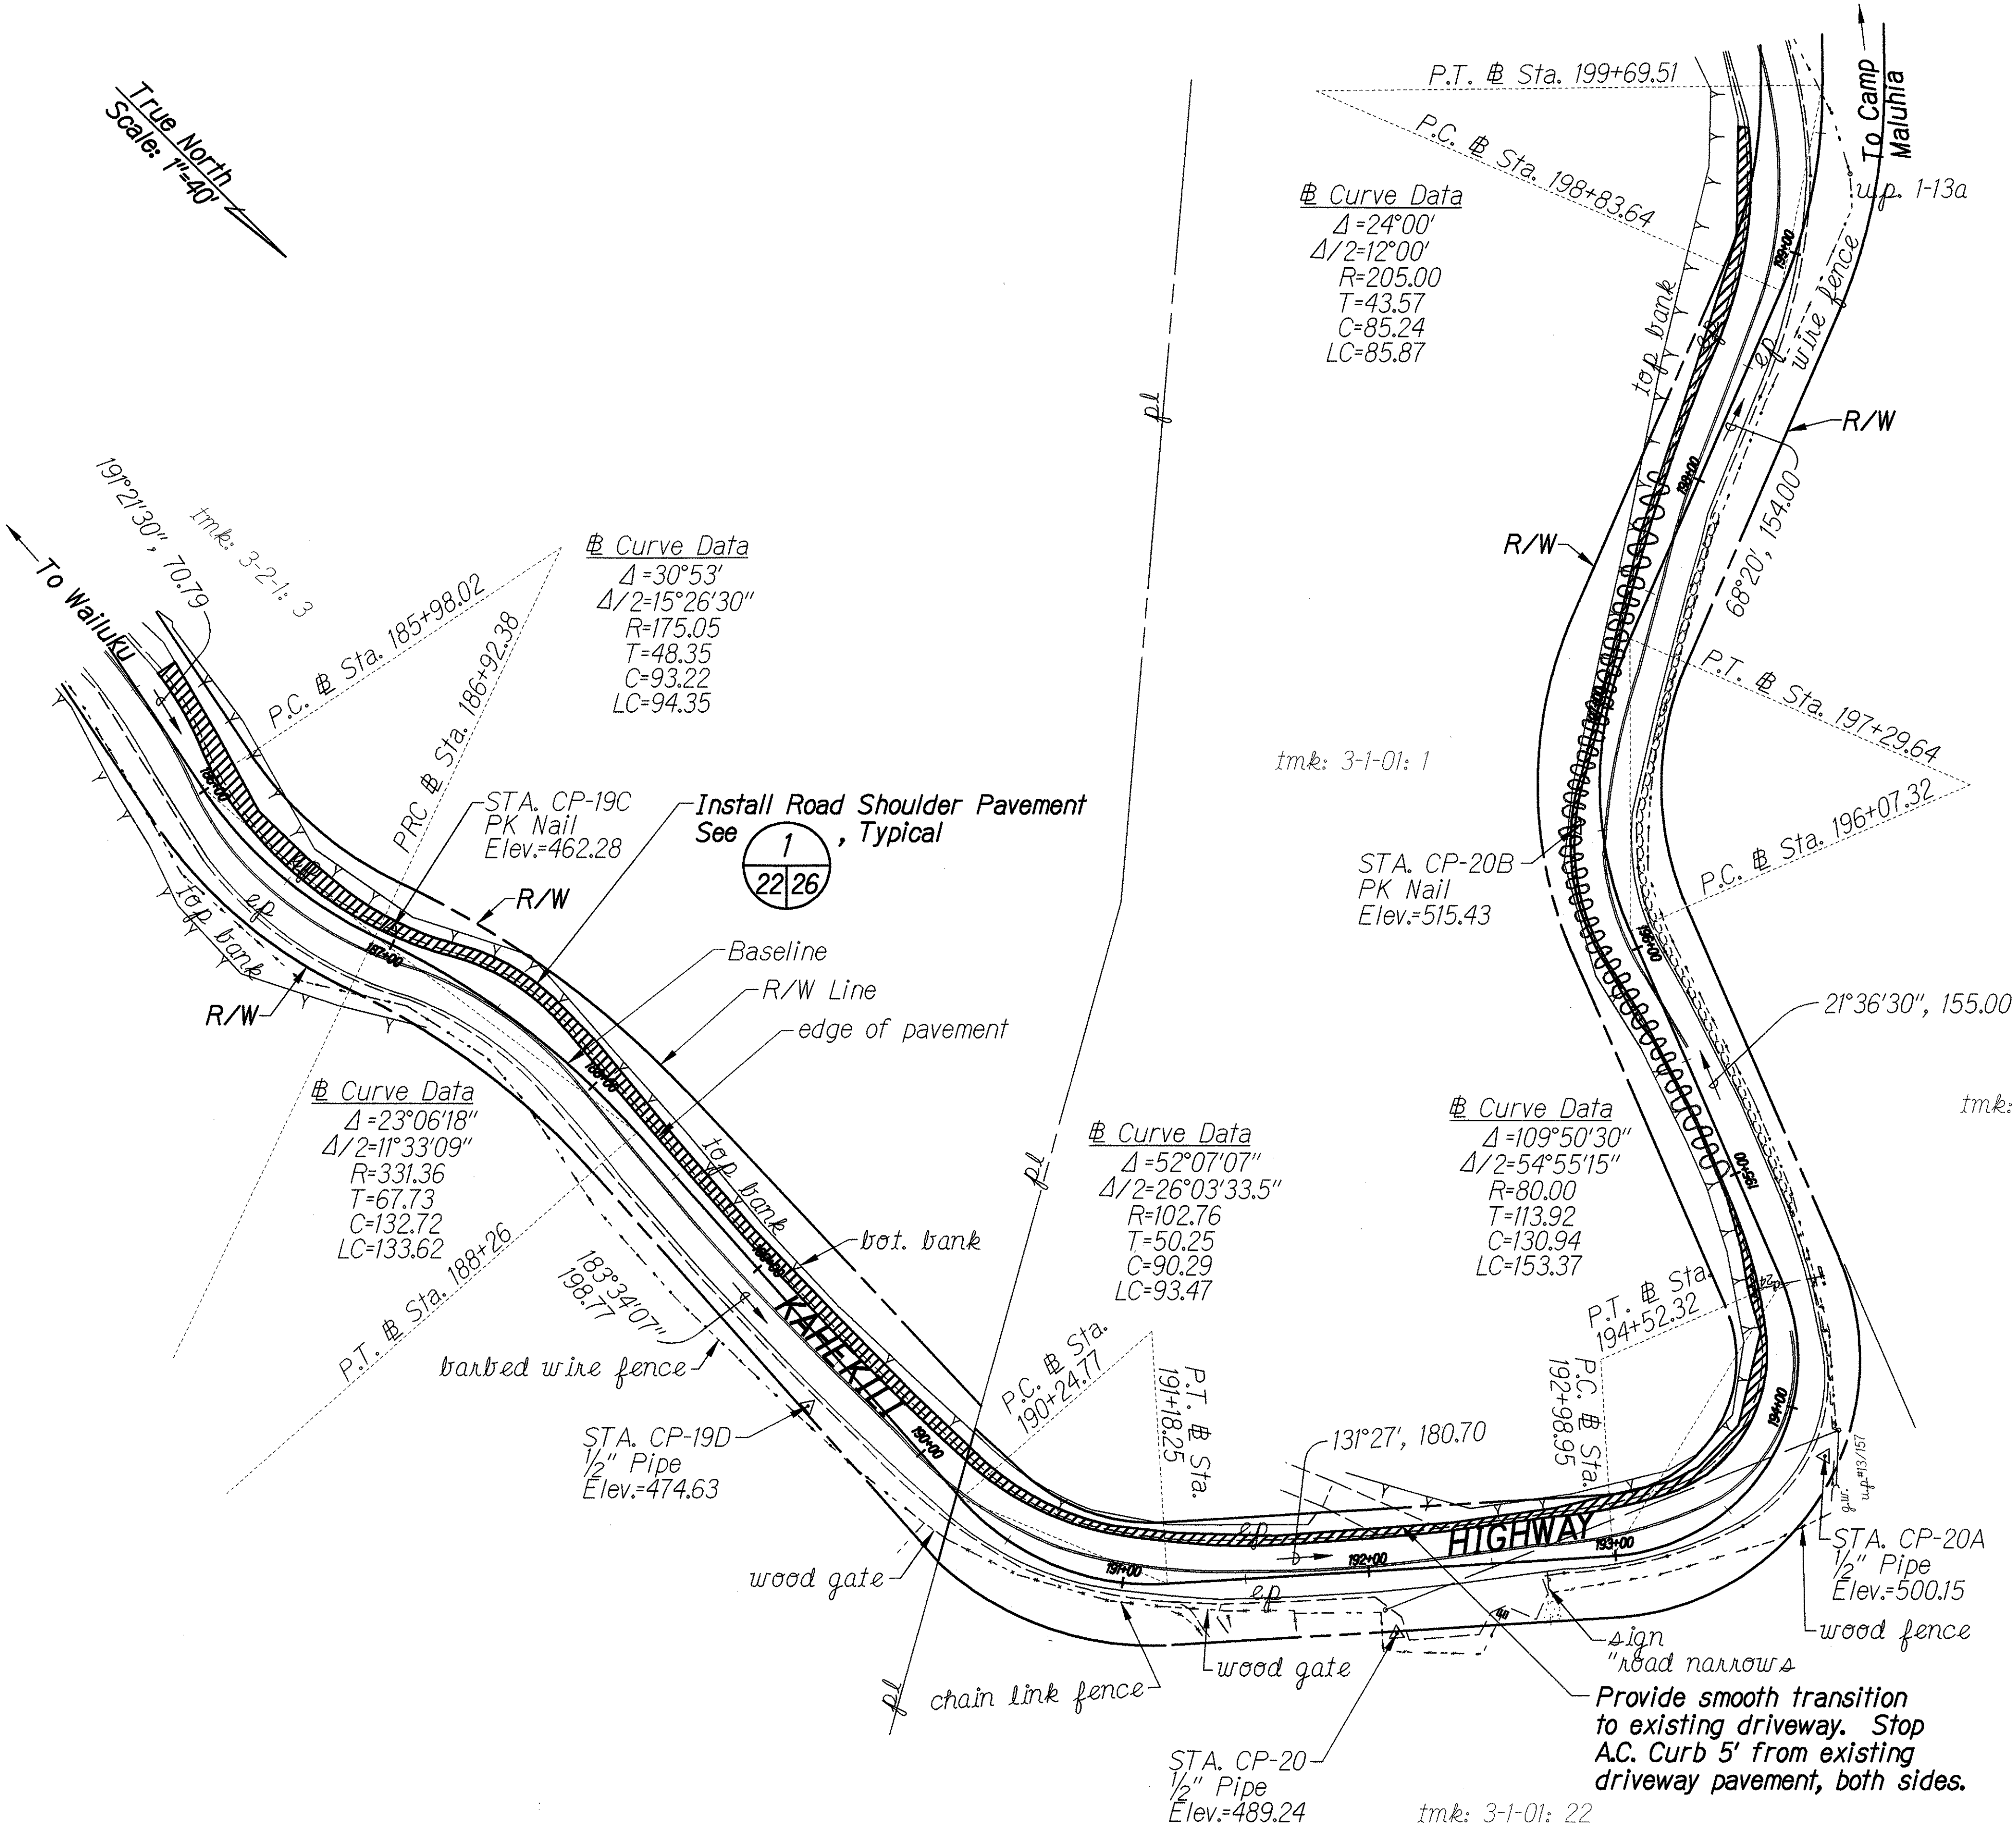

ROAD SHOULDER PAVING PLAN STA. 186+00 TO STA. 199+00
 SCALE: 1"=40'

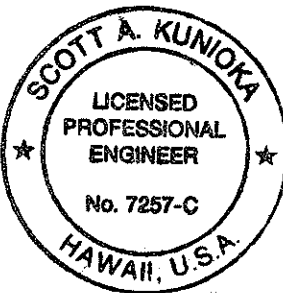

THIS WORK WAS PREPARED BY ME
 OR UNDER MY SUPERVISION
Scott A. Kunooka
 SHIMABUKURO, ENDO & YOSHIKAWA, INC.
 1126 12TH AVENUE
 HONOLULU, HAWAII 96816

STATE OF HAWAII
 DEPARTMENT OF TRANSPORTATION
 HIGHWAYS DIVISION


ROAD SHOULDER PAVING PLAN
STA. 186+00 TO STA. 199+00
 Kahekili Hwy. Repairs and Maintenance
 Waiehu Beach Road to Camp Maluhia
 Project No. 340CD-01-02M
 Scale: 1"=40' Date: March 21, 2002

SHEET No. 4 OF 6 SHEETS
 22

SURVEY PLANNED BY	DATE
DRAWN BY	
TRACED BY	
QUANTITIES BY	
CHECKED BY	
ORIGINAL PLAN	
NOTE BOOK	
NO.	

"AS-BUILT"


FED. ROAD DIST. NO.	STATE	PROJ. NO.	FISCAL YEAR	SHEET NO.	TOTAL SHEETS
HAWAII	HAW.	340CD-01-02M	2002	23	33

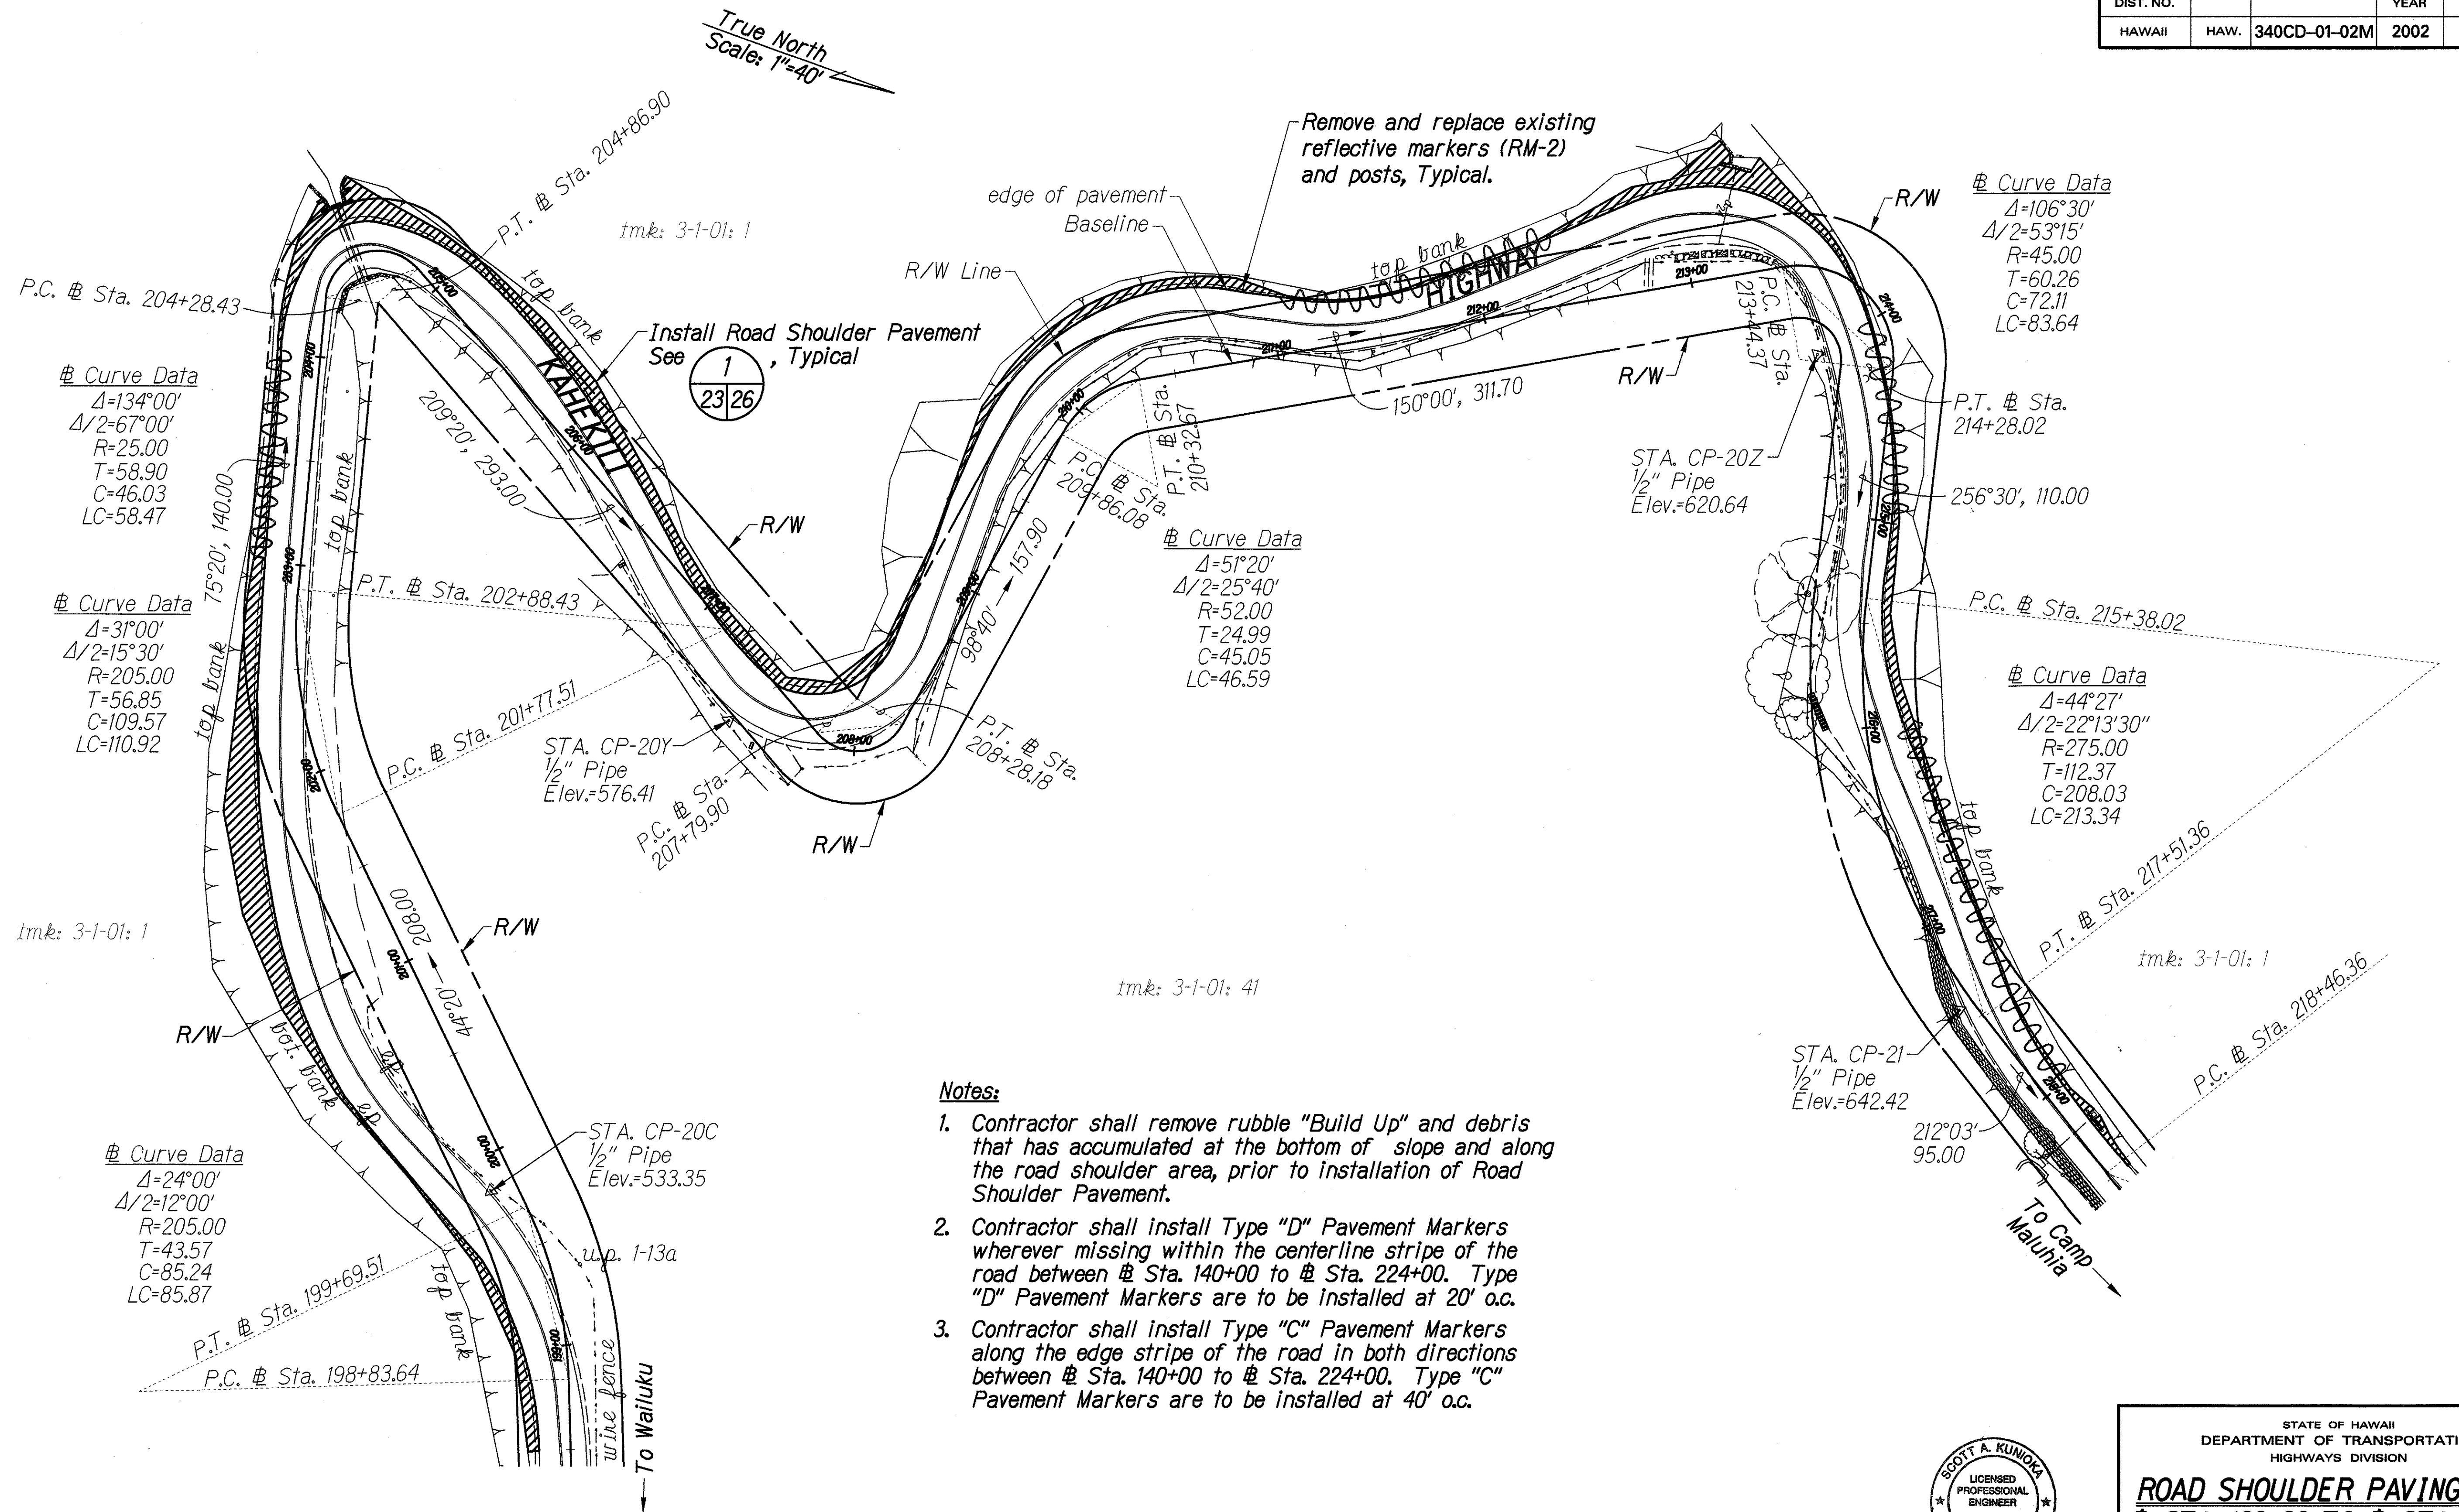

Notes:

- Contractor shall remove rubble "Build Up" and debris that has accumulated at the bottom of slope and along the road shoulder area, prior to installation of Road Shoulder Pavement.
- Contractor shall install Type "D" Pavement Markers wherever missing within the centerline stripe of the road between Sta. 140+00 to Sta. 224+00. Type "D" Pavement Markers are to be installed at 20' o.c.
- Contractor shall install Type "C" Pavement Markers along the edge stripe of the road in both directions between Sta. 140+00 to Sta. 224+00. Type "C" Pavement Markers are to be installed at 40' o.c.

ROAD SHOULDER PAVING PLAN # STA. 199+00 TO # STA. 218+00
SCALE: 1"=40'

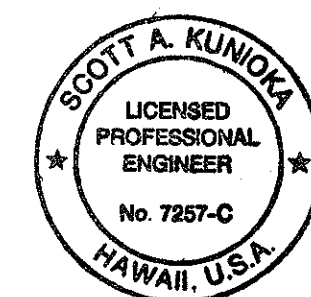

THIS WORK WAS PREPARED BY ME
OR UNDER MY SUPERVISION
Scott A. Kunooka
SHIMIZUKU, ENDO & YOSHIZAKI, INC.
1126 12TH Avenue
Honolulu, Hawaii 96816

STATE OF HAWAII
DEPARTMENT OF TRANSPORTATION
HIGHWAYS DIVISION

ROAD SHOULDER PAVING PLAN
STA. 199+00 TO # STA. 218+00


Kahikili Hwy. Repairs and Maintenance
Waiehu Beach Road to Camp Maluhia
Project No. 340CD-01-02M

Scale: 1"=40' Date: March 21, 2002

SHEET No. 5 OF 6 SHEETS

"AS-BUILT"

FED. ROAD DIST. NO.	STATE	PROJ. NO.	FISCAL YEAR	SHEET NO.	TOTAL SHEETS
HAWAII	HAW.	340CD-01-02M	2002	24	33

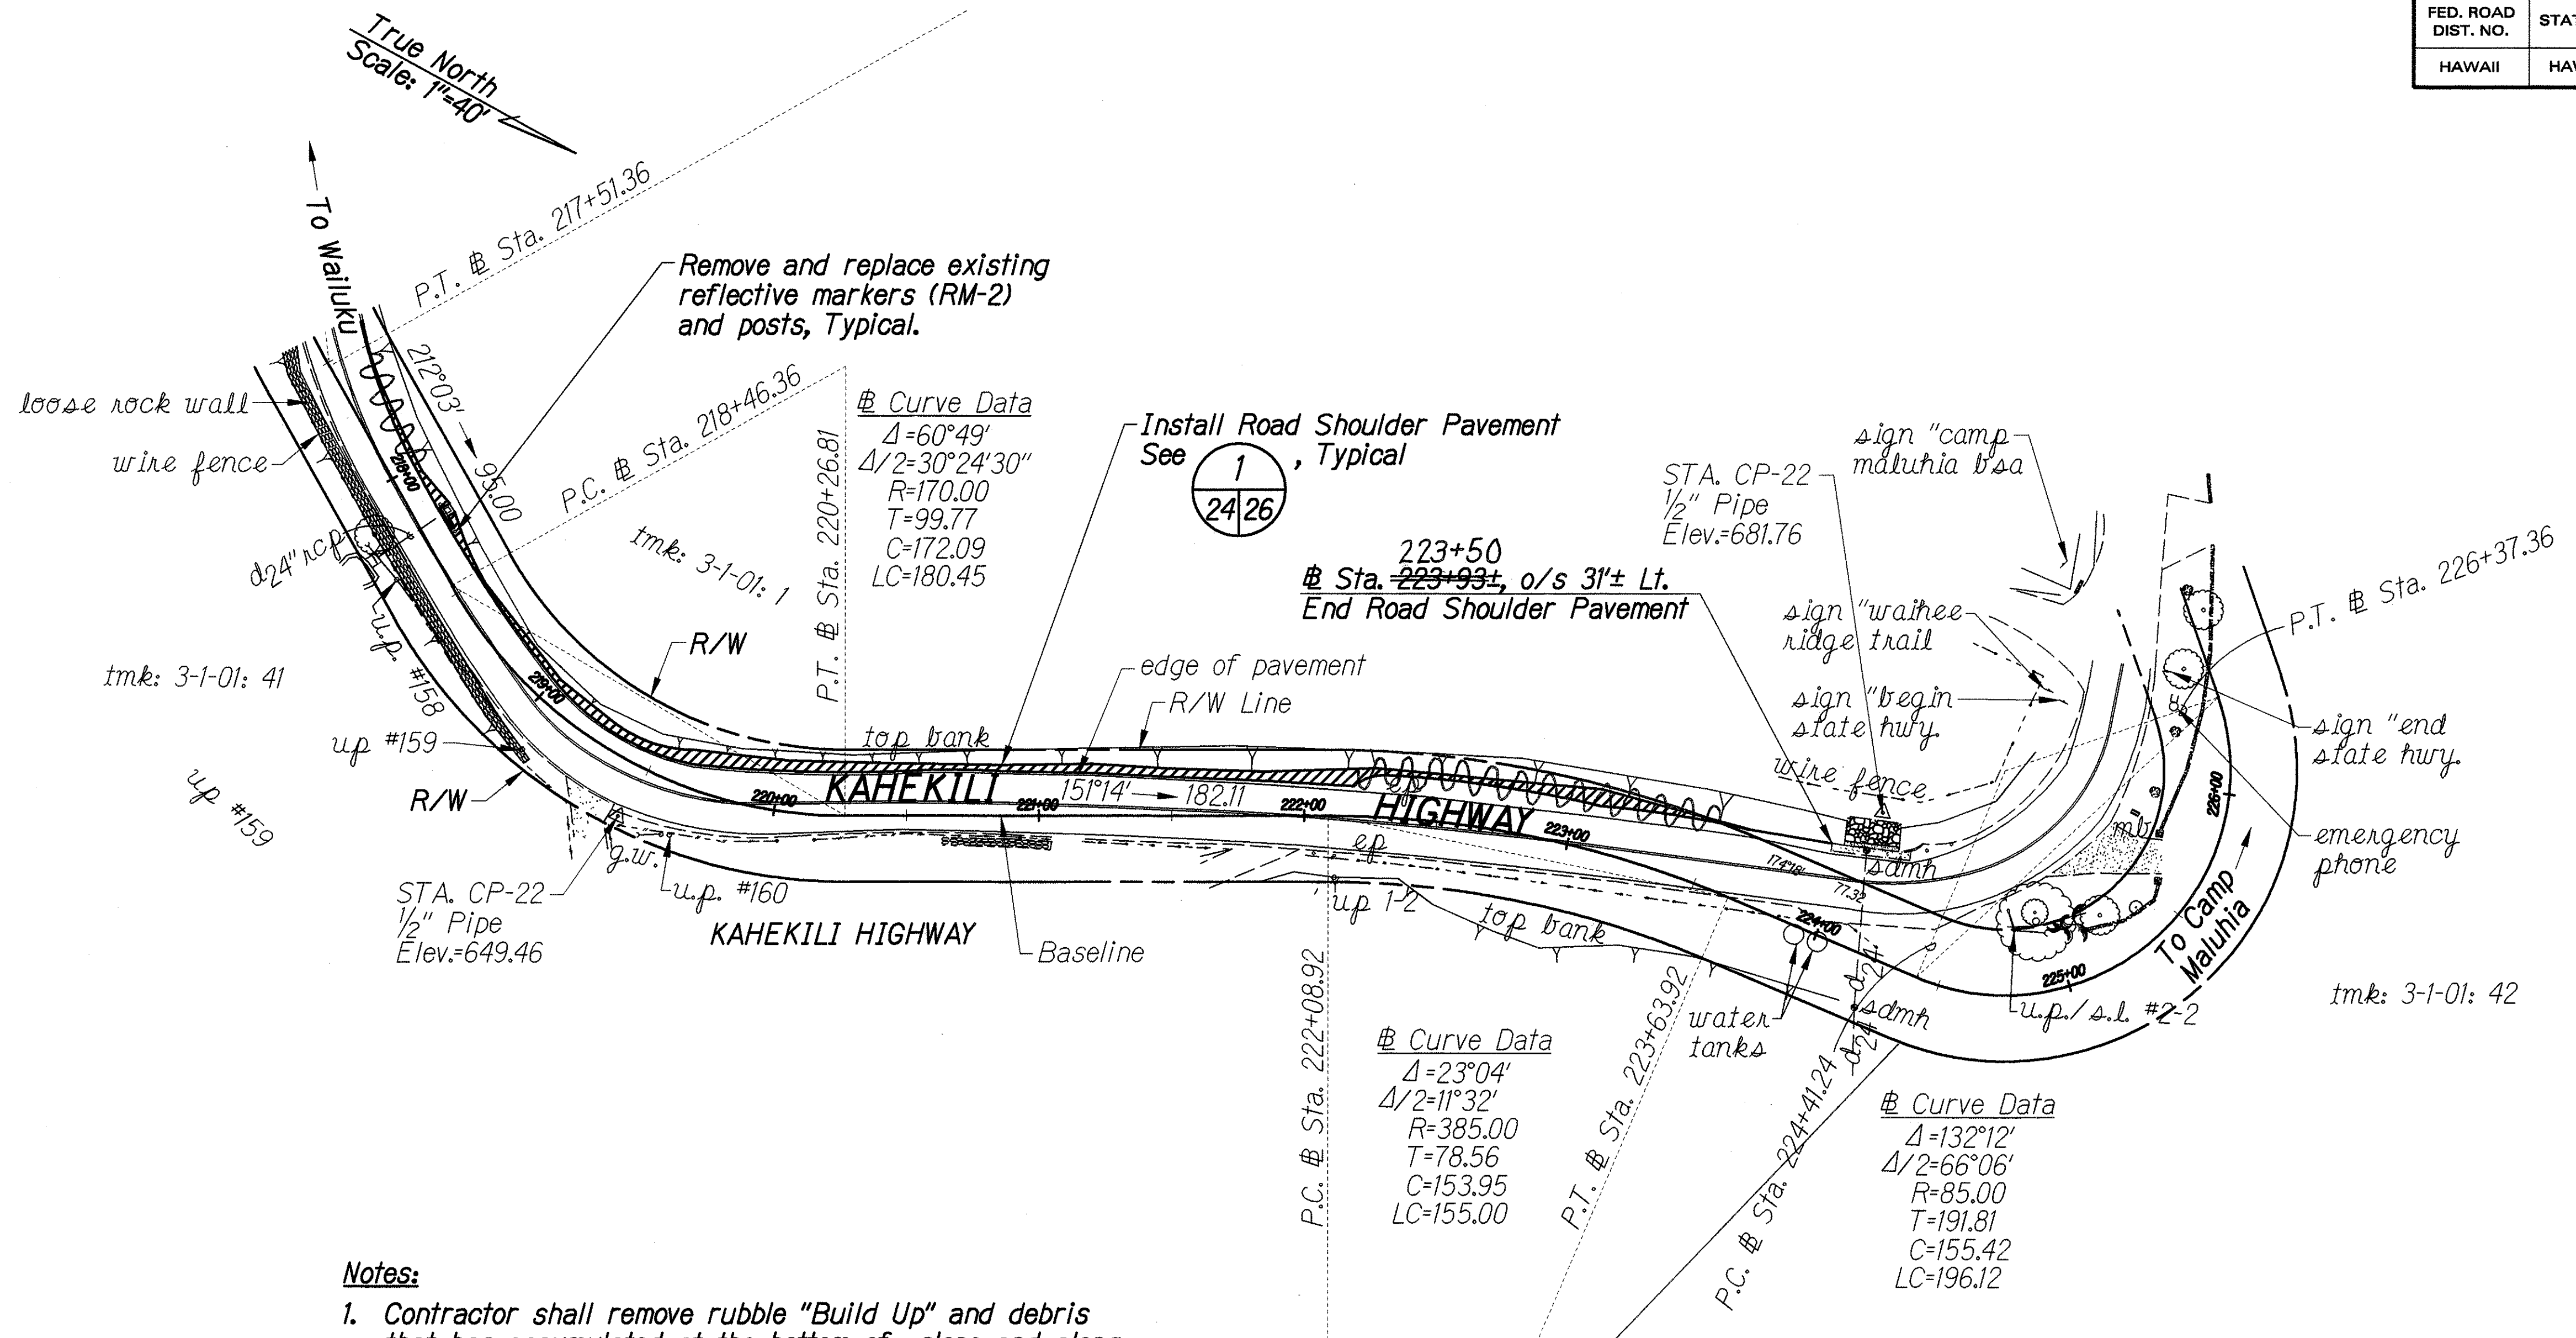


Notes:

1. Contractor shall remove rubble "Build Up" and debris that has accumulated at the bottom of slope and along the road shoulder area, prior to installation of Road Shoulder Pavement.
2. Contractor shall install Type "D" Pavement Markers wherever missing within the centerline stripe of the road between Sta. 140+00 to Sta. 224+00. Type "D" Pavement Markers are to be installed at 20' o.c.
3. Contractor shall install Type "C" Pavement Markers along the edge stripe of the road in both directions between Sta. 140+00 to Sta. 224+00. Type "C" Pavement Markers are to be installed at 40' o.c.

ROAD SHOULDER PAVING PLAN @ STA. 218+00 TO @ STA. 226+81

SCALE: 1"=40'

SURVEY PLANNED BY	DATE
DESIGNED BY	
NOTED BY	
CHECKED BY	

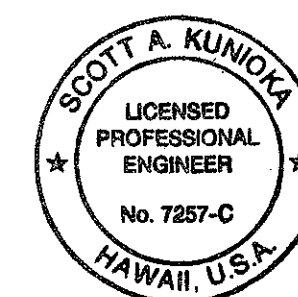

THIS WORK WAS PREPARED BY ME
OR UNDER MY SUPERVISION
Scott A. Kunoza
SHIMABUKURO, ENDO & TOSHIYAKI, INC.
1125 12TH AVENUE
Honolulu, Hawaii 96816

STATE OF HAWAII
DEPARTMENT OF TRANSPORTATION
HIGHWAYS DIVISION
ROAD SHOULDER PAVING PLAN
@ STA. 218+00 TO @ STA. 226+81
Kahekili Hwy. Repairs and Maintenance
Waiehu Beach Road to Camp Maluhia
Project No. 340CD-01-02M
Scale: 1"=40' Date: March 21, 2002

SHEET No. 6 OF 6 SHEETS