

INDEX TO DRAWINGS	
SHEET NO.	DESCRIPTION
1	TITLE SHEET
2	STANDARD PLANS SUMMARY
3	GENERAL NOTES AND LEGEND
4	WATER POLLUTION AND EROSION CONTROL NOTES
5	GENERAL PLAN/INDEX SHEET
6	INTERSECTION RESTRIPE @ STA. 30+00 to @ STA. 38+00
7	GUARDRAIL IMPROVEMENT @ STA. 46+50 to @ STA. 50+00
8	DRAINAGE SYSTEM IMPROV. @ STA. 73+70 to @ STA. 77+50
9	GUARDRAIL AND STRIPING IMPROVEMENT PLAN @ STA. 78+50 to @ STA. 81+50
10	REPLACE SIGN @ STA. 88+58
11	REPLACE INLET @ STA. 112+10
12	DRAINAGE IMPROVEMENTS @ STA. 130+24 to @ STA. 131+41
13	GUARDRAIL IMPROVEMENTS @ STA. 138+67 to @ STA. 140+04
14	REPLACE INLET @ STA. 144+19 & @ STA. 149+17
15	REPLACE INLET @ STA. 154+71 & @ STA. 160+78
16	GUARDRAIL IMPROVEMENTS & REPLACE INLET @ STA. 176+90 to @ STA. 180+31
17	GUARDRAIL IMPROVEMENT & REPLACE INLET @ STA. 193+77 TO @ STA. 195+15 PAVEMENT IMPROVEMENT @ STA. 210+50
18	GUARDRAIL & DRAINAGE IMPROVEMENTS @ STA. 213+43 to @ STA. 218+21
19-24	ROAD SHOULDER PAVING PLAN @ STA. 139+00 to @ STA. 226+81
25	MISCELLANEOUS DETAILS
26	MISCELLANEOUS DETAILS
27	GUARDRAIL DETAILS & NOTES
28	STRONG POST W-BEAM GUARDRAIL
29	STRONG POST W-BEAM GUARDRAIL
30	FLEAT 350
31	ET-2000 PLUS
32	PAVEMENT MARKING NOTES & LEGEND
33	DRAINAGE SUMMARY




SEY ENGINEERS, INC. DESIGNED BY P. CHUNG
P. S. & E. BY
May, 2002
DATE
873-3535
PHONE

STATE OF HAWAII
DEPARTMENT OF TRANSPORTATION
HIGHWAYS DIVISION
HONOLULU, HAWAII
"AS-BUILT"
PLANS FOR

KAHEKILI HIGHWAY REPAIRS AND MAINTENANCE
WAIEHU BEACH ROAD TO CAMP MALUHIA
PROJECT NO. 340CD-01-02M

DISTRICT OF WAILUKU
ISLAND OF MAUI

FED. ROAD DIST. NO.	STATE	PROJ. NO.	FISCAL YEAR	SHEET NO.	TOTAL SHEETS
HAWAII	HAW.	340CD-01-02M	2002	1	33

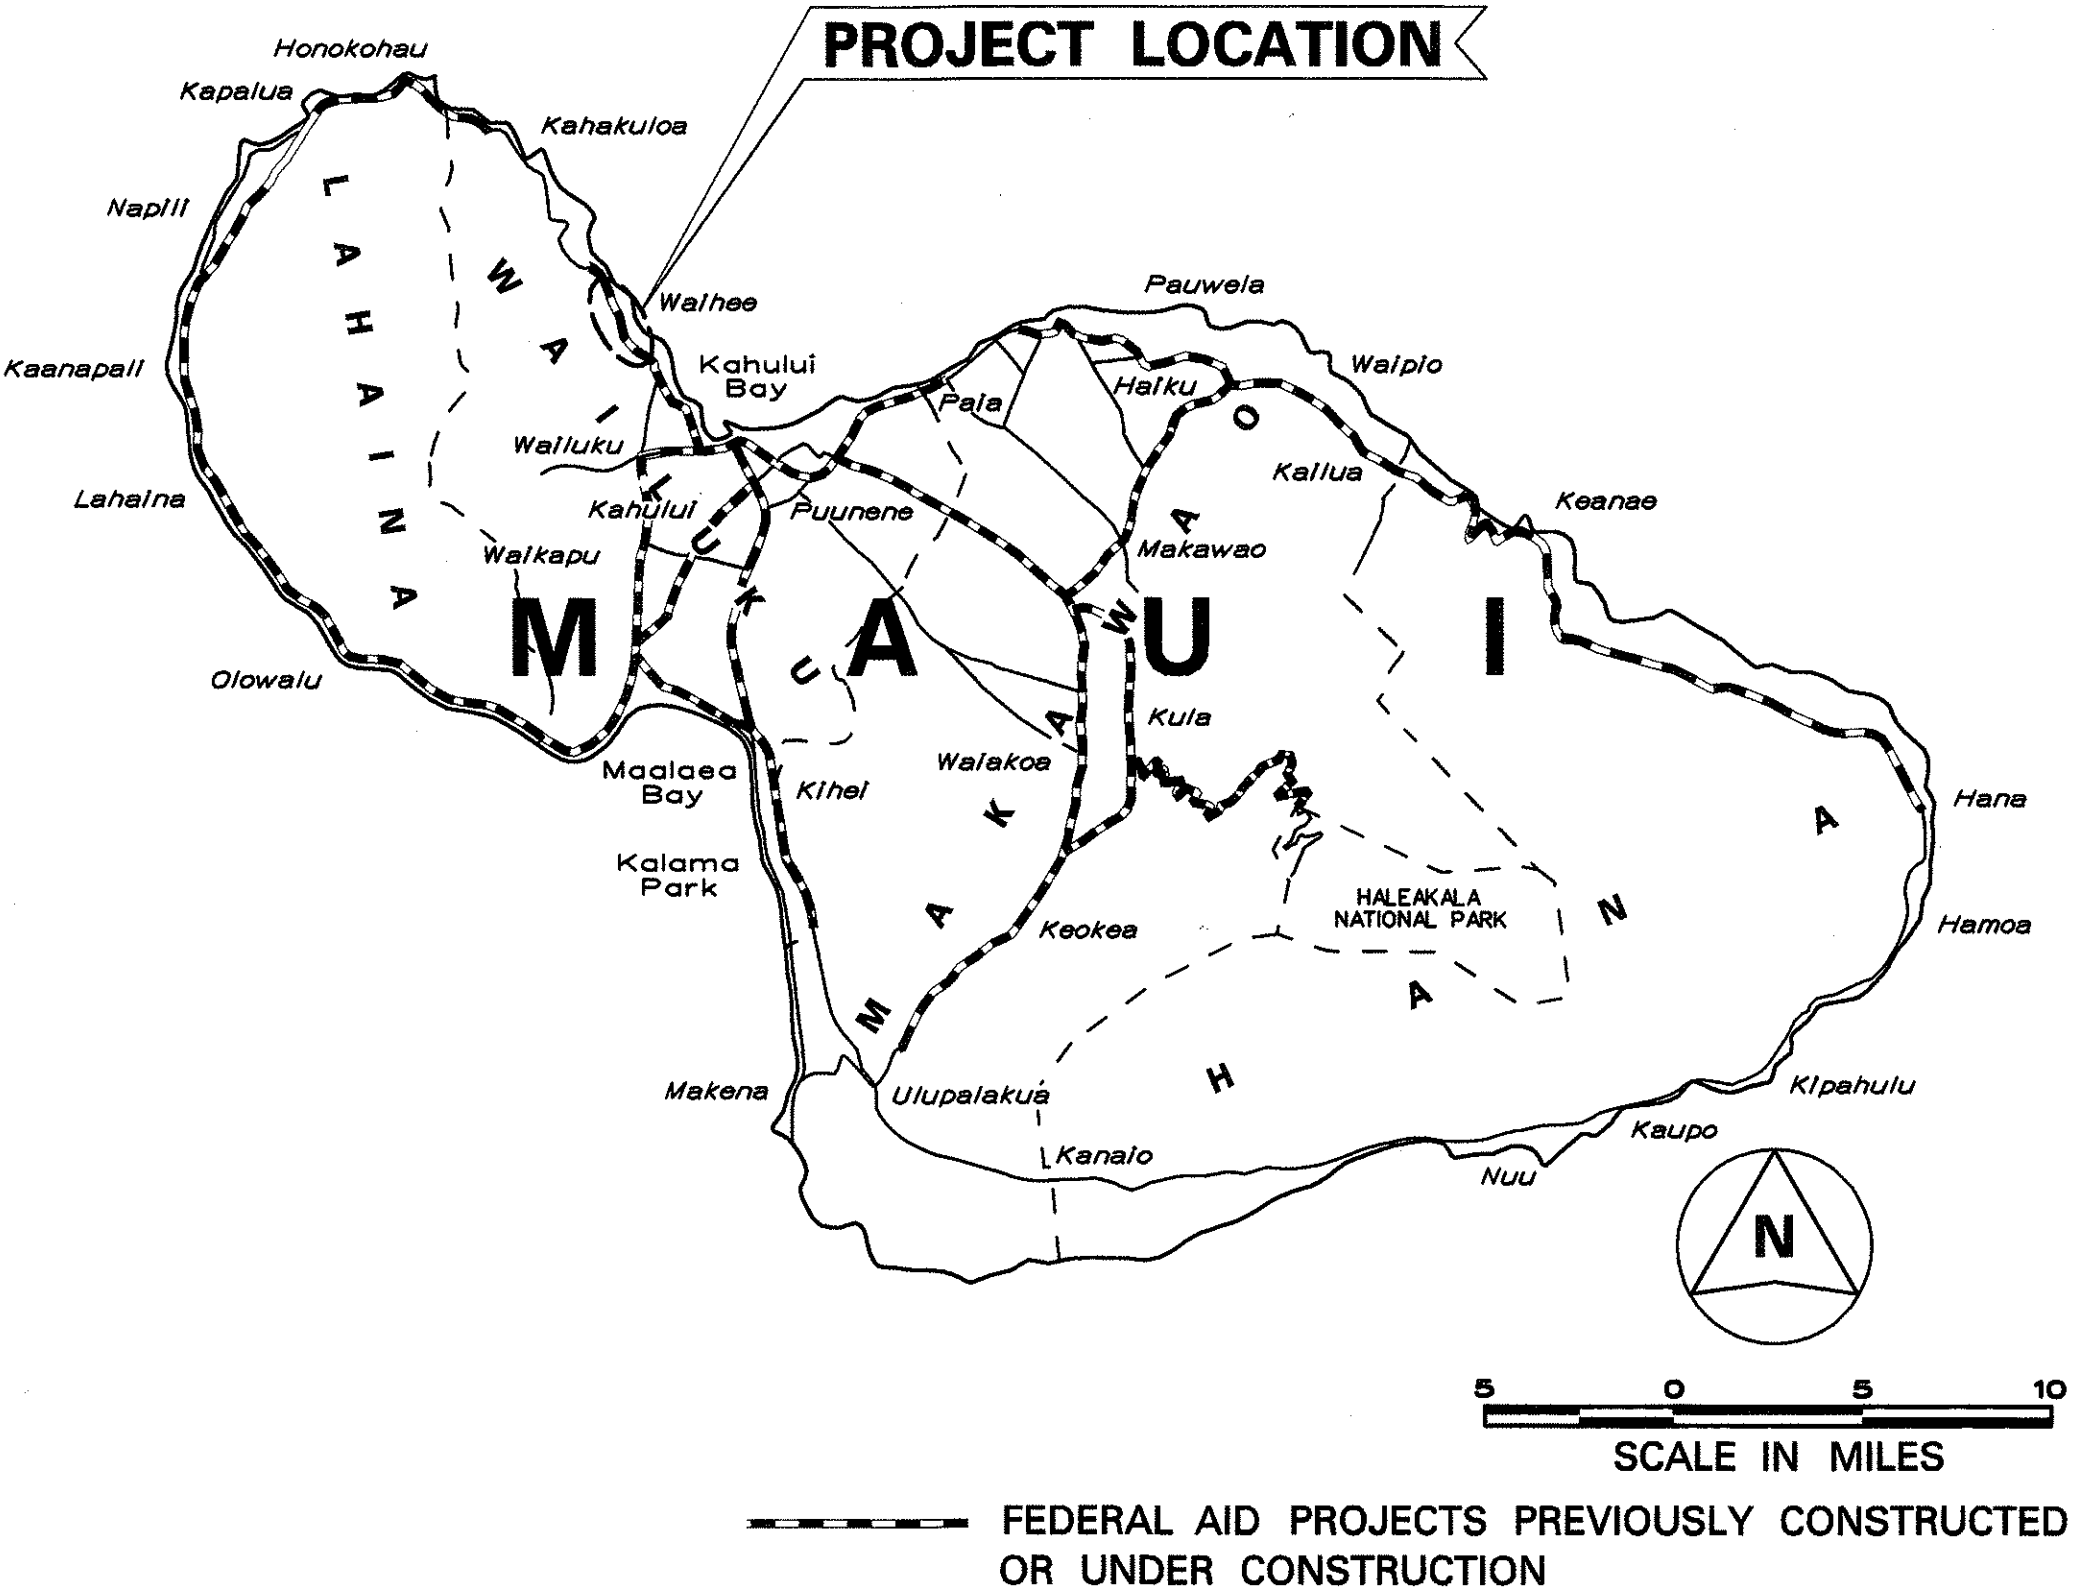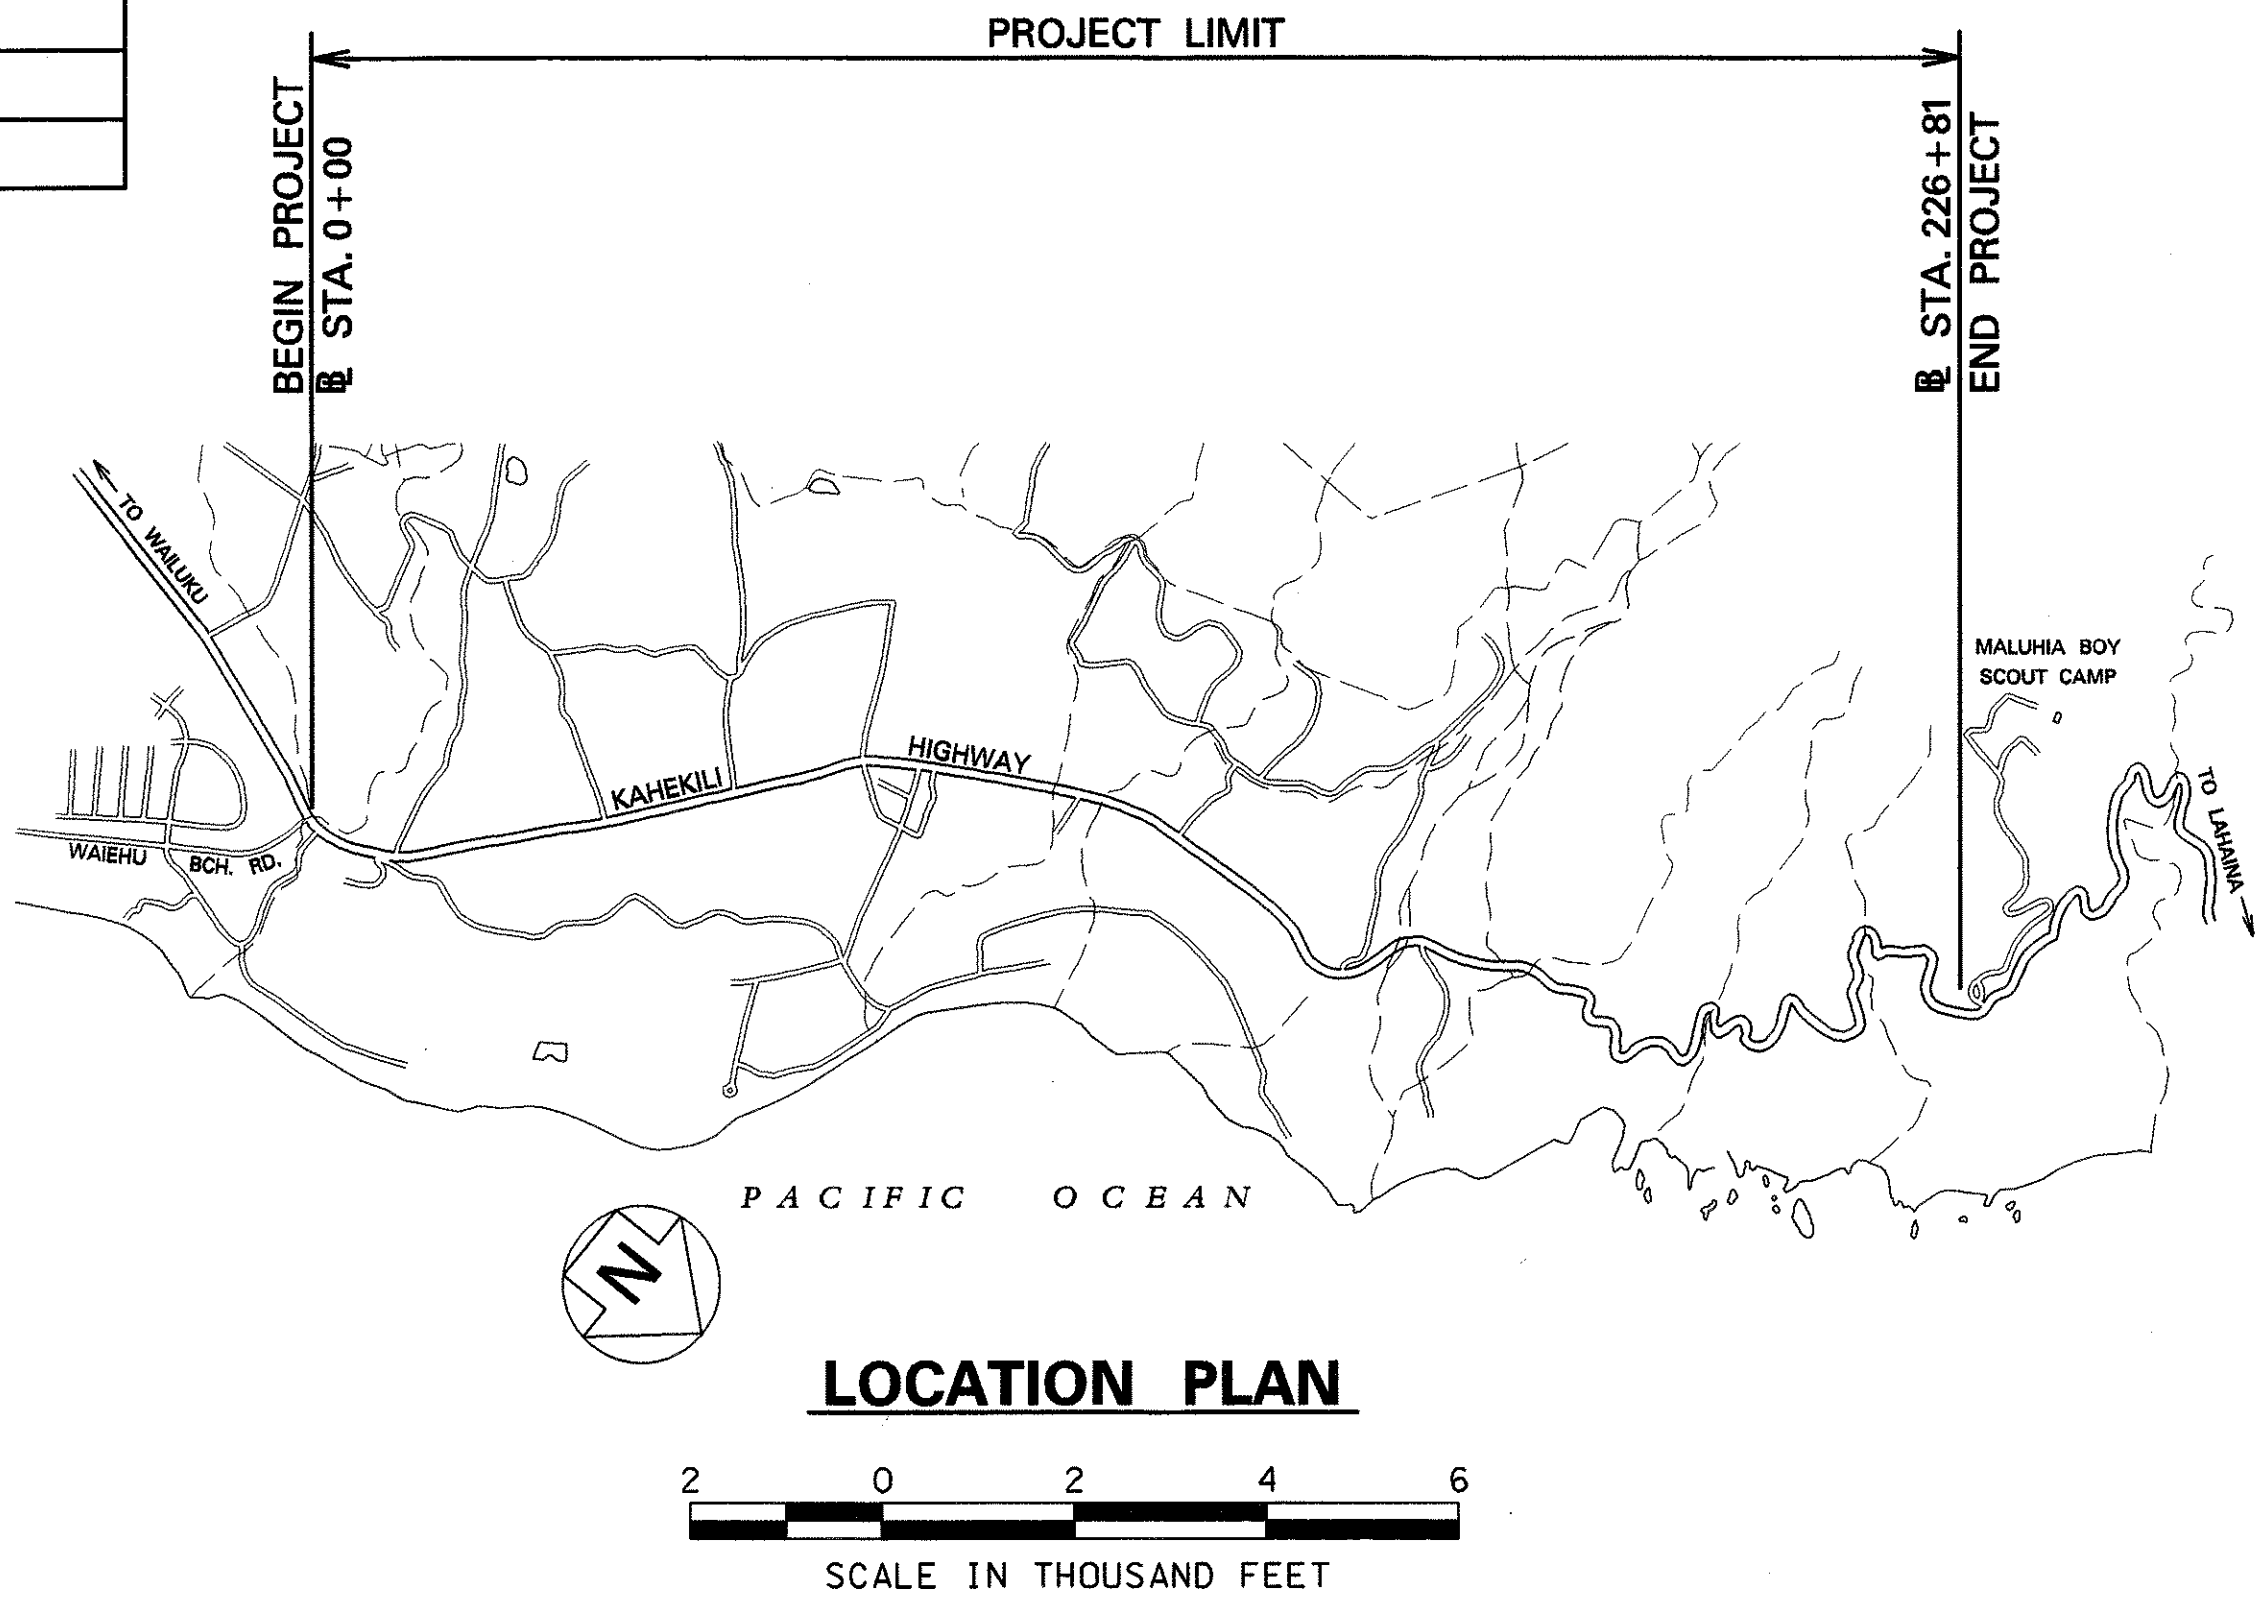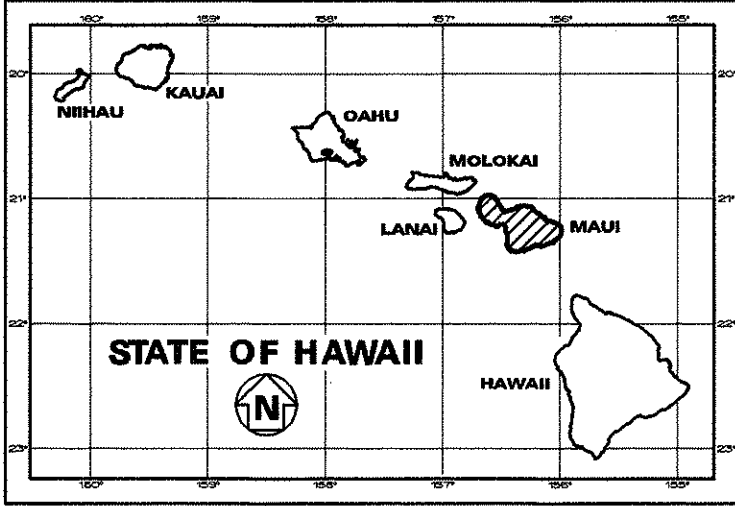

CHANGES MADE DURING CONSTRUCTION HAVE BEEN INCORPORATED ON THESE PLANS EXCEPT CHANGES IN THE ORIGINAL THEORETICAL QUANTITIES. FOR ACTUAL QUANTITIES, REFER TO PROJECT LEDGER AND/OR COMPUTATION BOOK.
2/19/06

DEPARTMENT OF TRANSPORTATION
STATE OF HAWAII
APPROVED: [Signature]
for DIR. OF TRANSPORTATION
5-13-02
DATE