

INDEX TO DRAWINGS	
SHEET NO.	DESCRIPTION
1	TITLE SHEET
2	STANDARD PLANS SUMMARY
3	GENERAL NOTES AND LEGEND
4 - 5	WATER POLLUTION AND EROSION CONTROL NOTES
6 - 7	TYPICAL SECTIONS AND DETAILS
8 - 17	ROADWAY PLANS
18	WORK ZONE SIGNING PLAN, NOTES AND DETAILS
19	PAVEMENT MARKING LEGEND, DETAILS, NOTES AND SIGN PANEL LAYOUTS
20 - 29	SIGNING AND PAVEMENT MARKING PLANS
30 - 31	MISCELLANEOUS SUMMARIES

STATE OF HAWAII

DEPARTMENT OF TRANSPORTATION

HIGHWAYS DIVISION

HONOLULU, HAWAII

"AS-BUILT"

PLANS FOR



KAHEKILI HIGHWAY RESURFACING

WAIIEHU BEACH ROAD TO CAMP MALUHIA

PROJECT NO. 340D-01-05M

DISTRICT OF WAILUKU

ISLAND OF MAUI

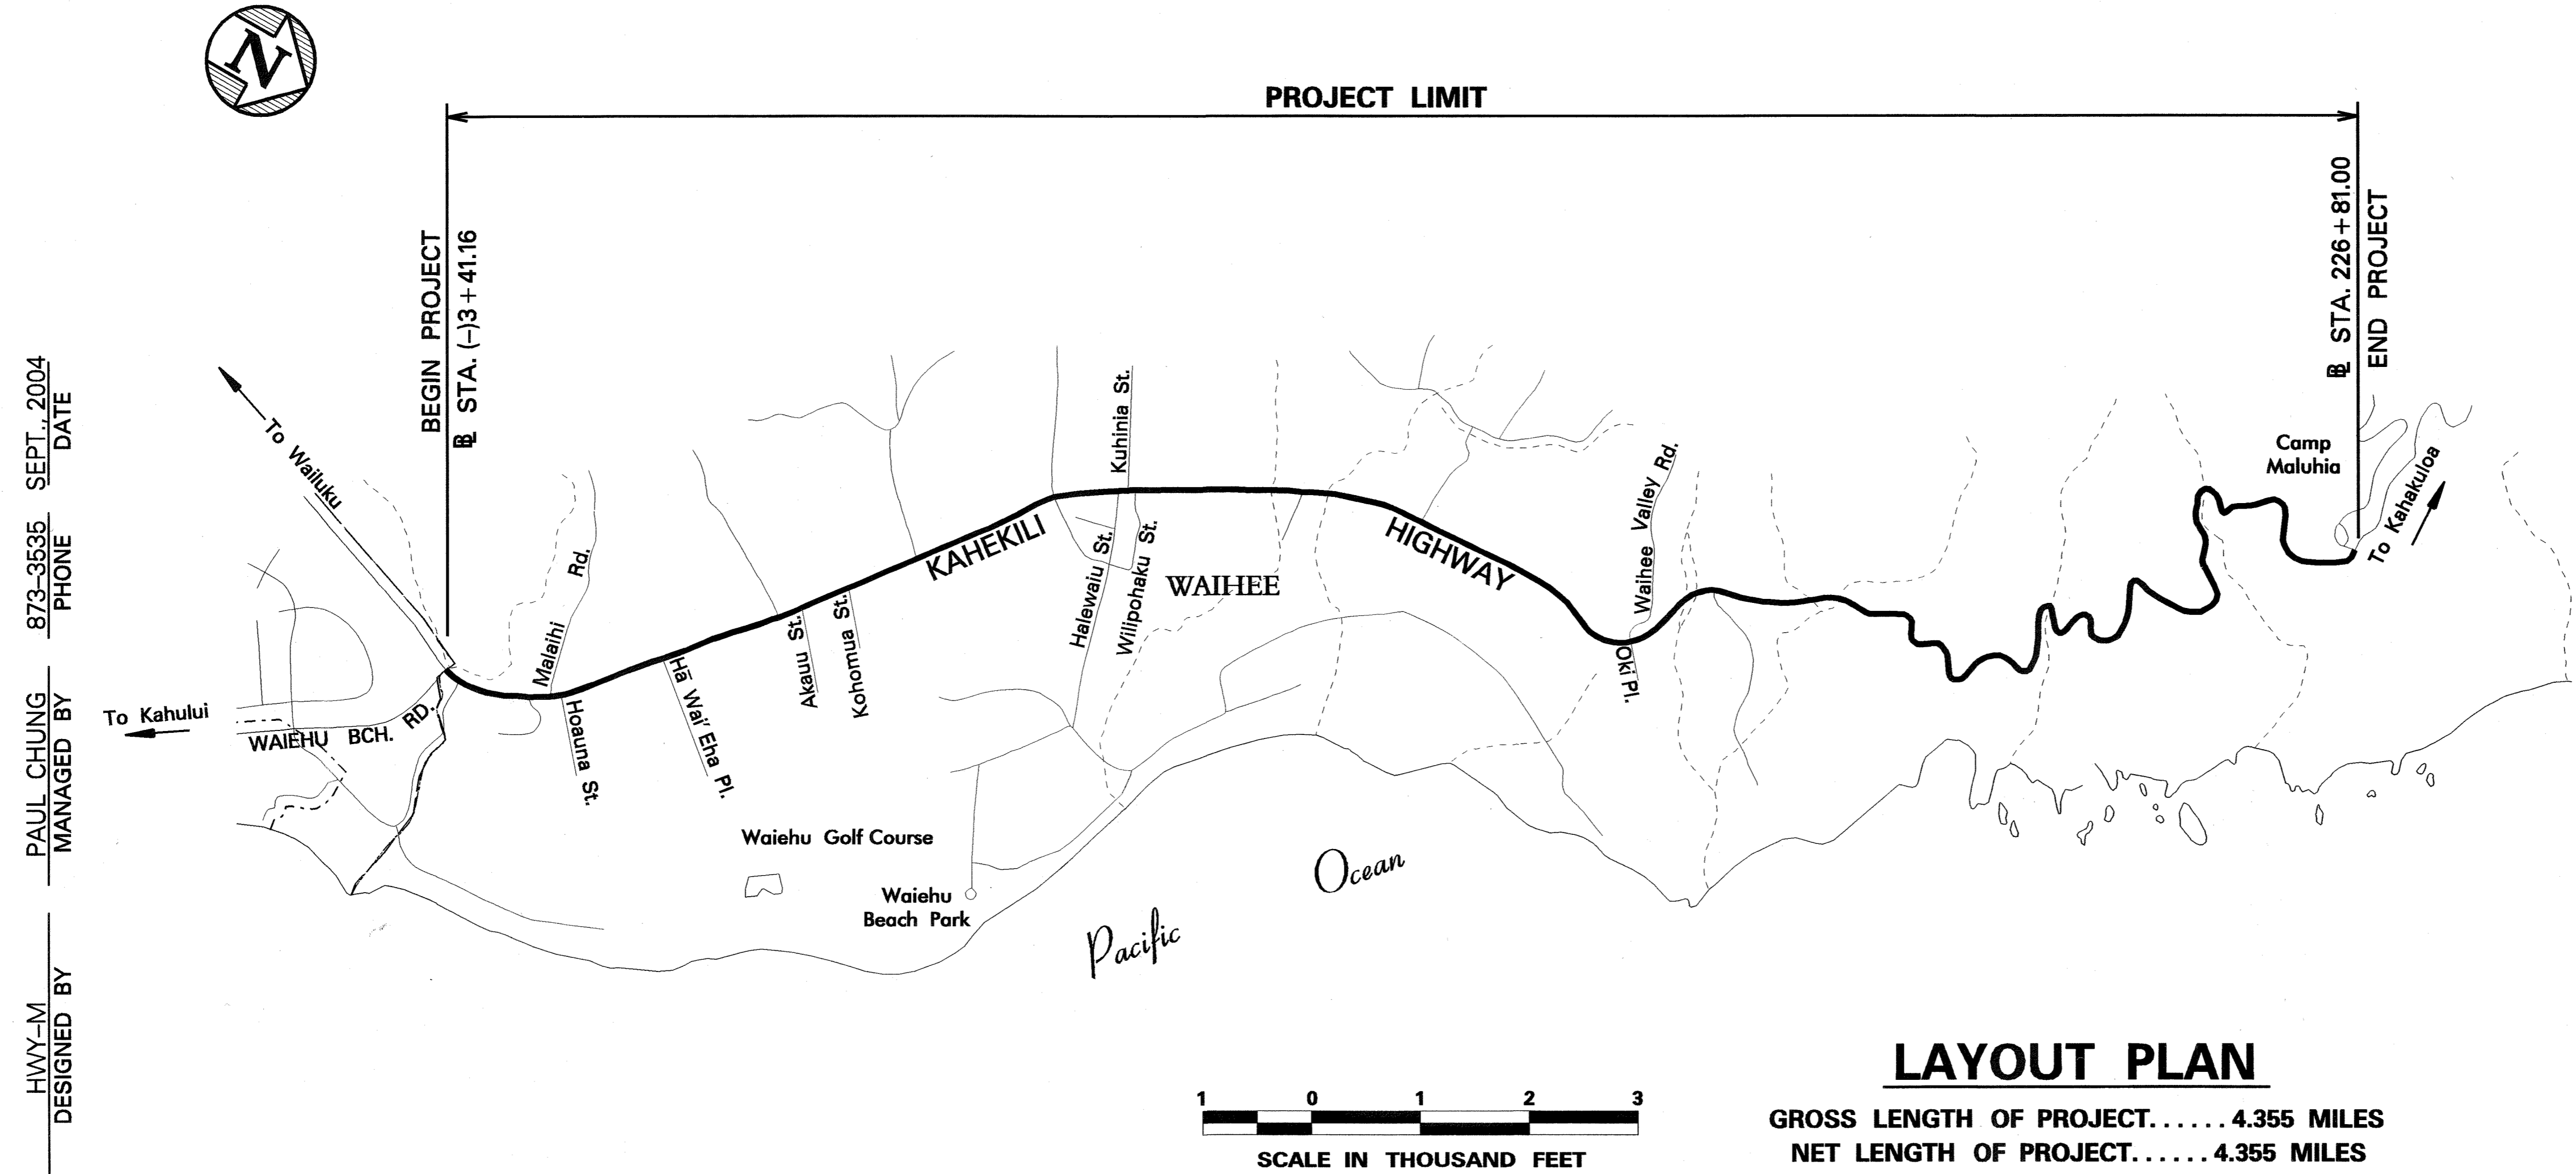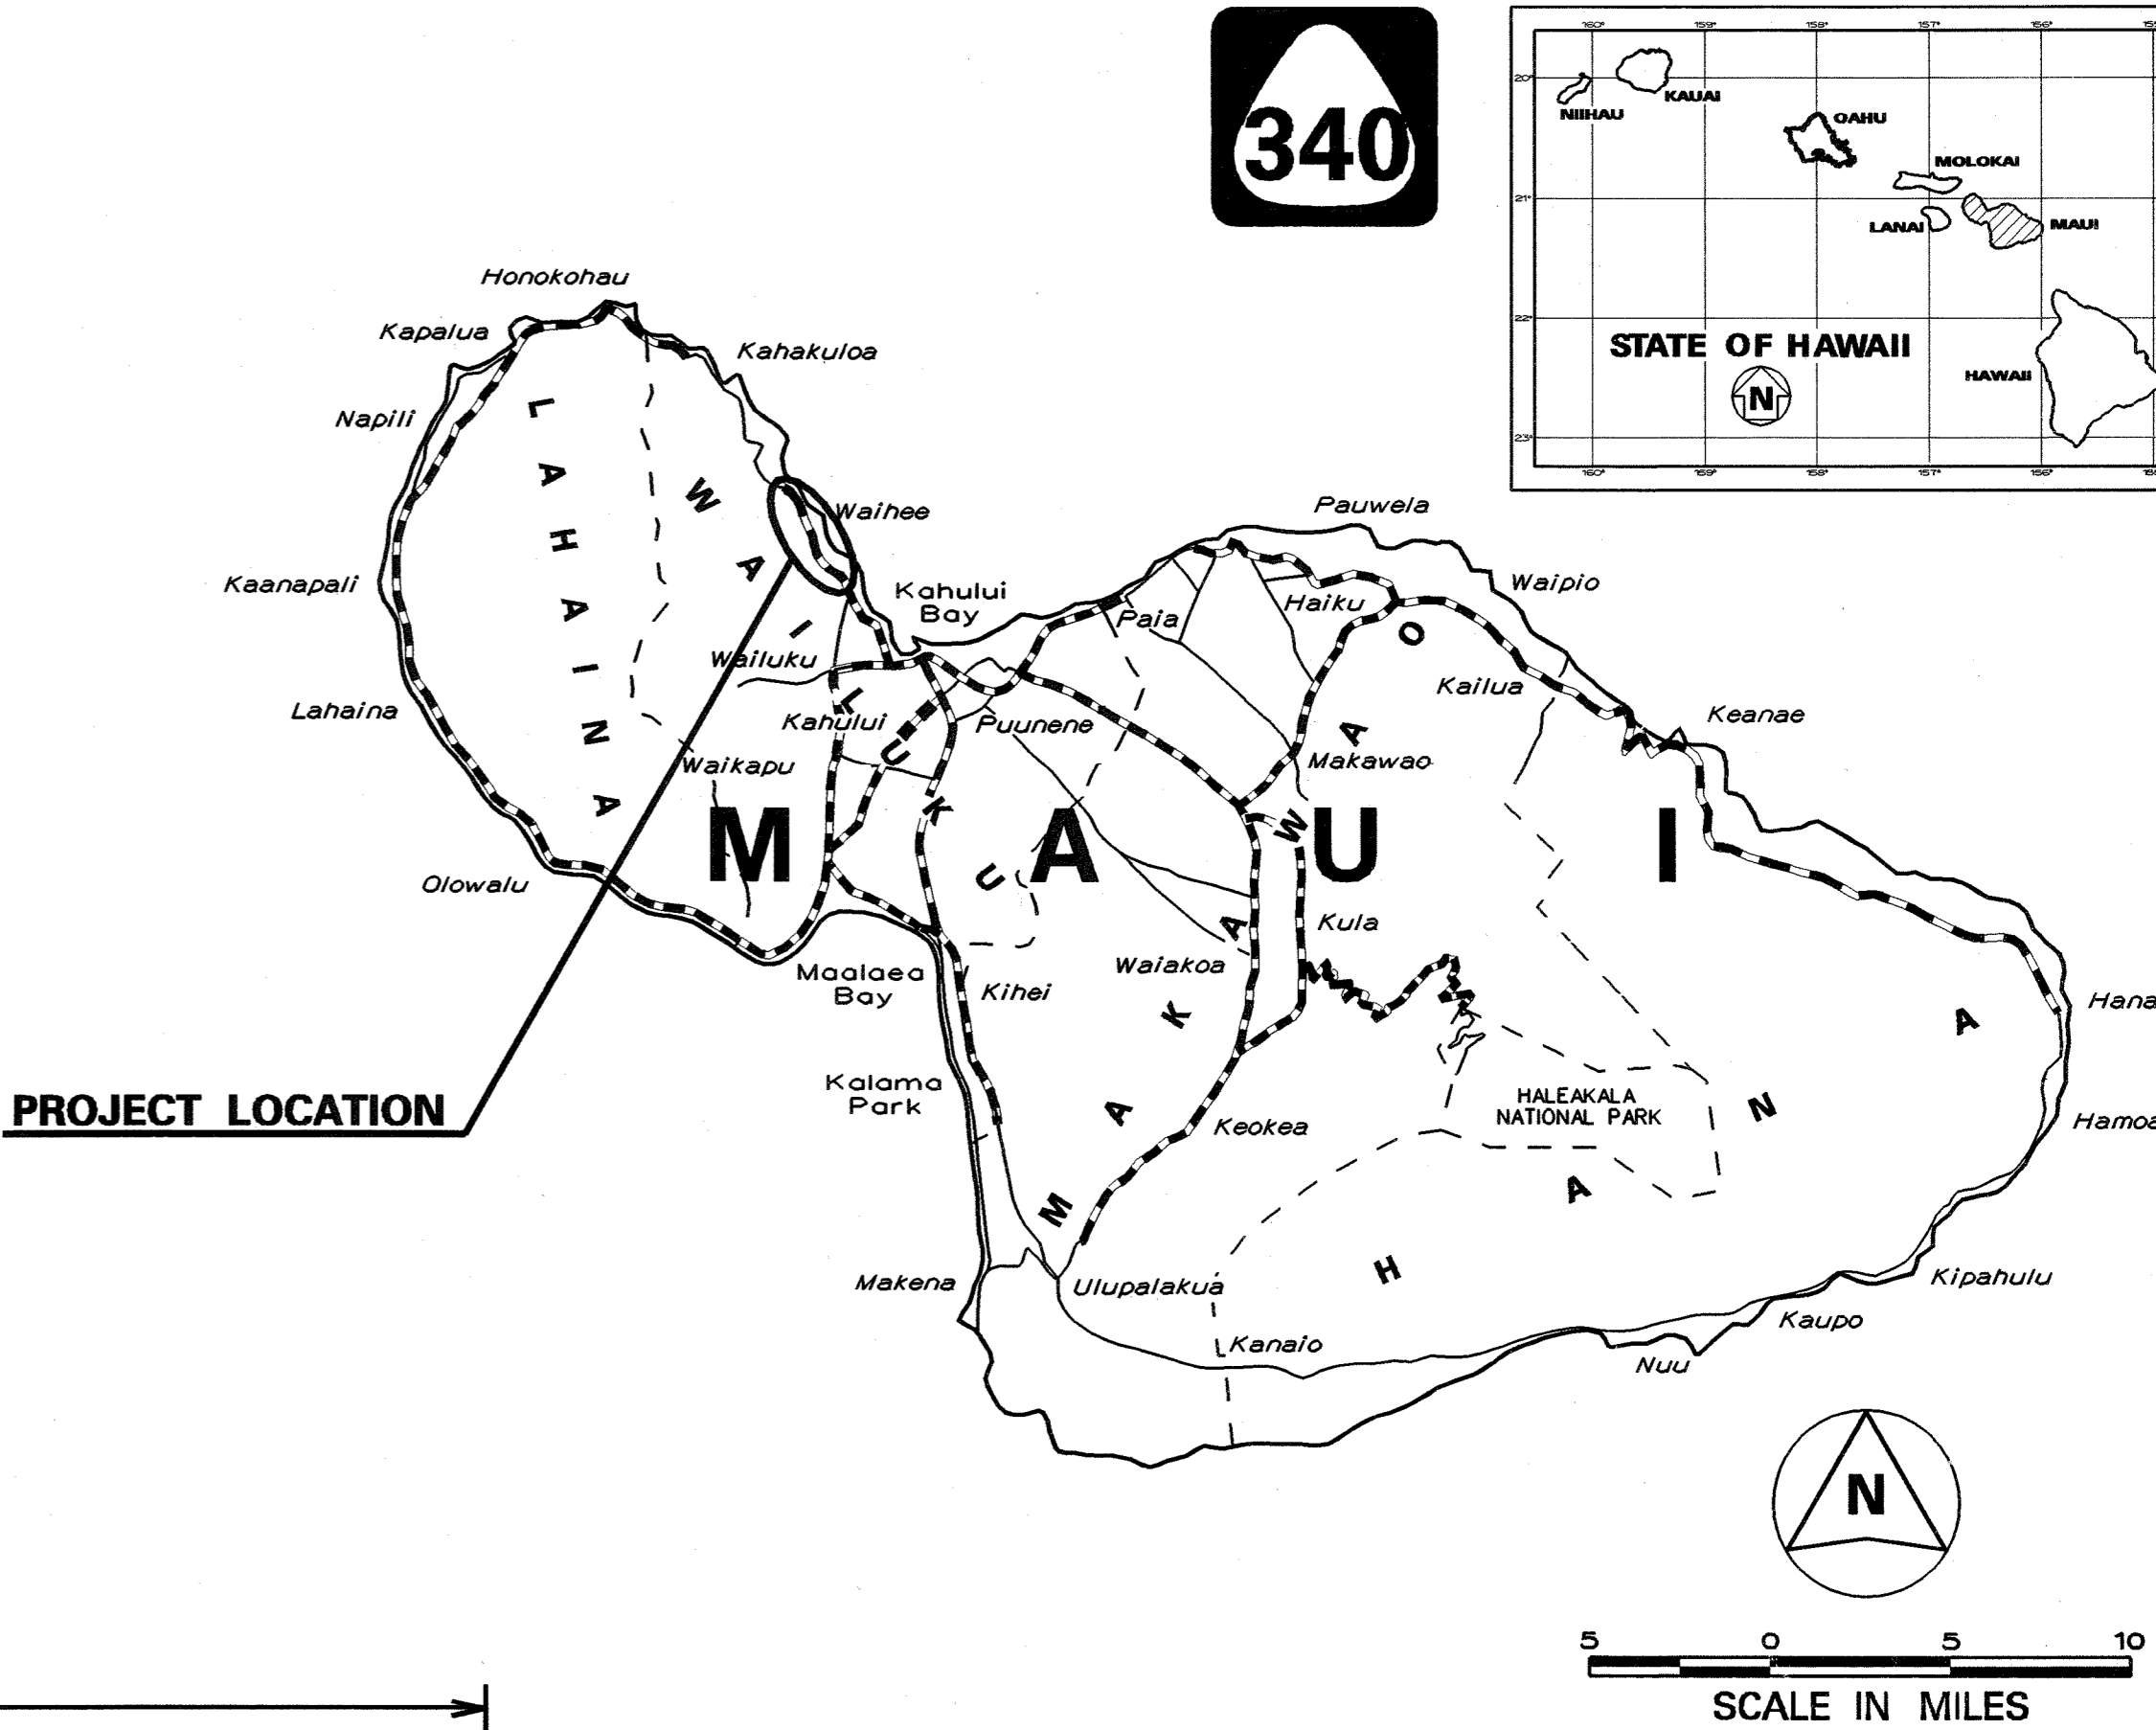

NO SIGNIFICANT CHANGES WERE MADE DURING
CONSTRUCTION ON THESE PLANS EXCEPT CHANGES
IN THE ORIGINAL THEORETICAL QUANTITIES. FOR
ACTUAL QUANTITIES, REFER TO PROJECT LEDGER
AND/OR COMPUTATION BOOK.

DEPARTMENT OF TRANSPORTATION
STATE OF HAWAII

APPROVED: *[Signature]* 3/3/05
DIR. OF TRANSPORTATION DATE