




FED. ROAD DIST. NO.	STATE	FED. AID PROJ. NO.	FISCAL YEAR	SHEET NO.	TOTAL SHEETS
HAWAII	HAW.	STP-0340(005)	2020	ADD.7	44

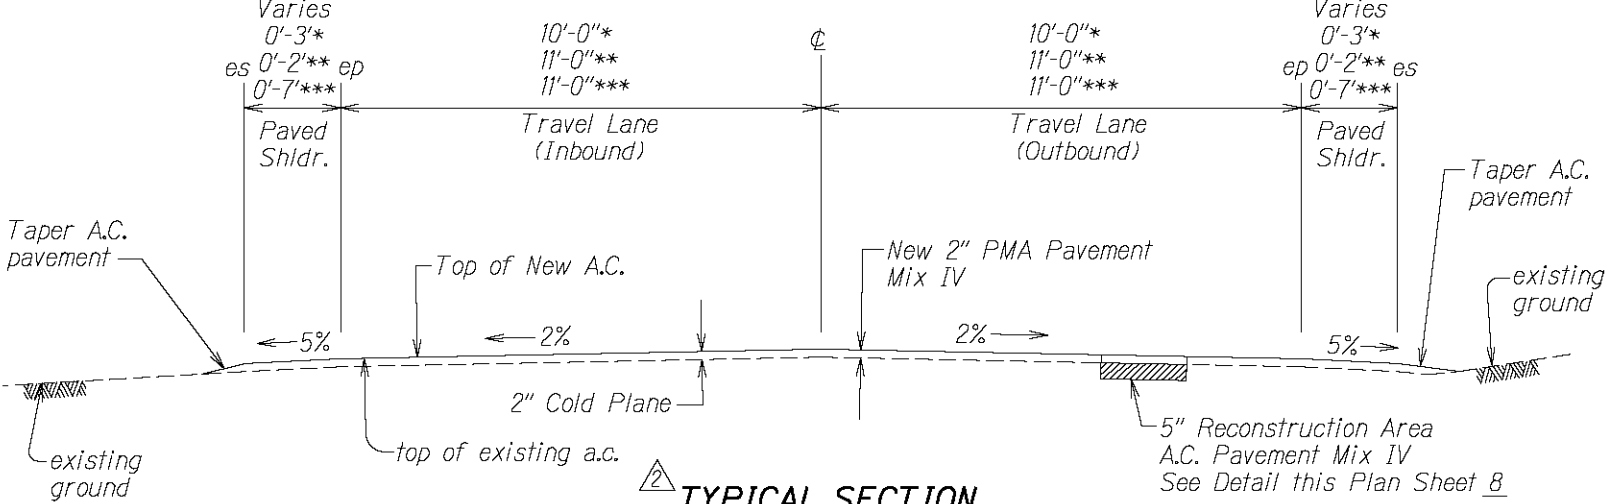

TYPICAL SECTION
***STA. 85+00± - STA. 115+00±**
****STA. 23+00± - STA. 85+00±**
*****STA. 0+00 - STA. 23+00, STA. 0+00 - STA. -3+41.16**
Scale: 1/2" = 1'-0"

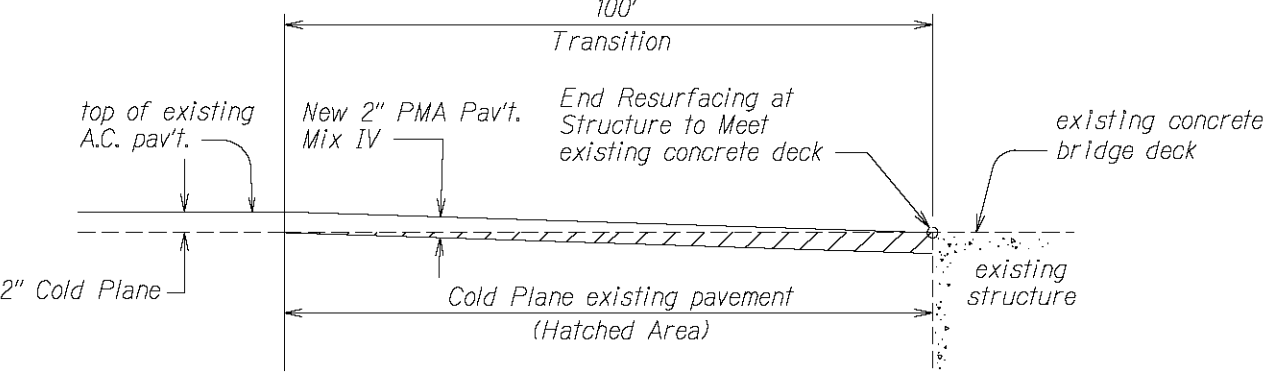


WAIHEE BRIDGE
COLD PLANED TRANSITION AT STRUCTURE
Not to Scale

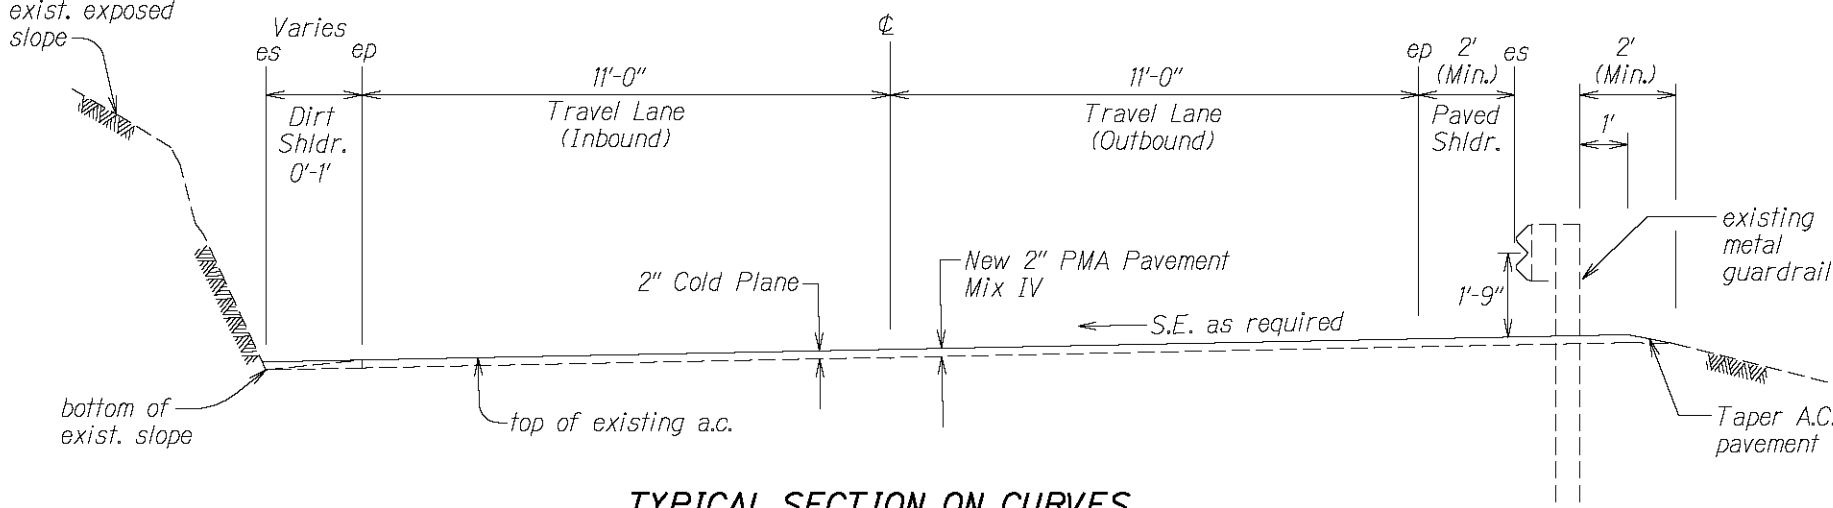


TYPICAL SECTION ON CURVES
STA. 115+00± - STA. 140+00±
Scale: 1/2" = 1'-0"

*If field conditions restrict, cold planing and paving should be at least to face of guardrail

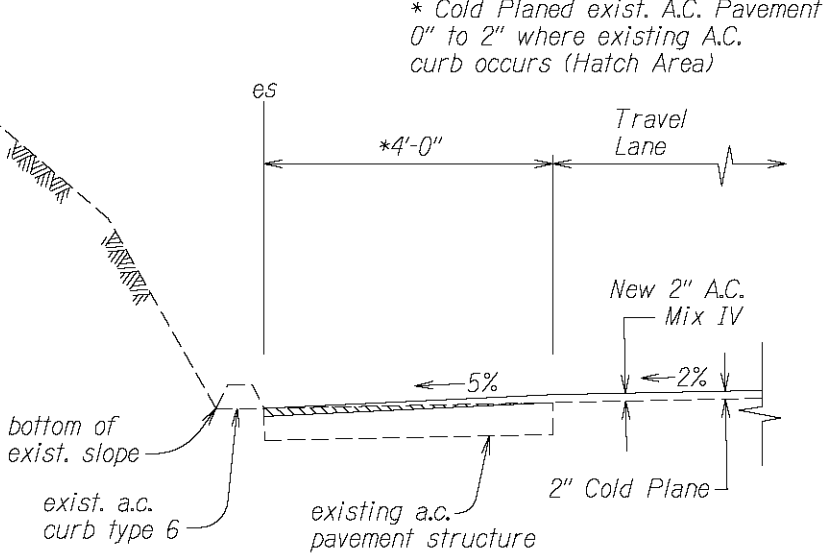

DETAIL FOR COLD PLANE
STA. 140+00± LT. - STA. 223+93± LT.
Not to Scale

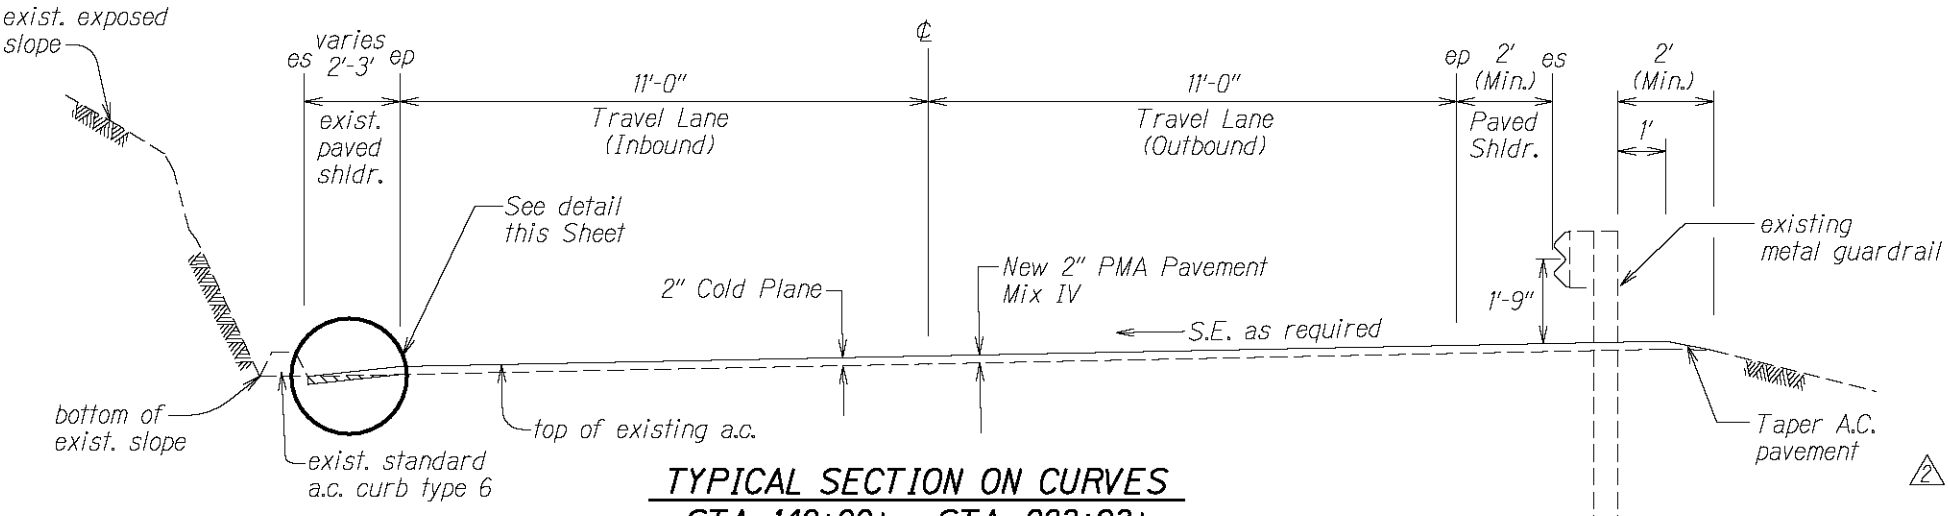

TYPICAL SECTION ON CURVES
STA. 140+00± - STA. 223+93±
Scale: 1/2" = 1'-0"

3-19-21	Revised Width of Travel Lane.
DATE	REVISION

STATE OF HAWAII
DEPARTMENT OF TRANSPORTATION
HIGHWAYS DIVISION

TYPICAL SECTIONS & DETAILS

KAHEKILI HIGHWAY RESURFACING
Waiehu Beach Road to Camp Maluhia
Federal-Aid Project No. STP-0340(005)

Scale: As Shown Date: May, 2020

SHEET No. 1 OF 3 SHEETS

SURVEY PLOTTED BY	DATE
DRAWN BY	2/28
CHECKED BY	
NOTED BY	
DESIGNED BY	
QUANTITIES BY	
CHECKED BY	