
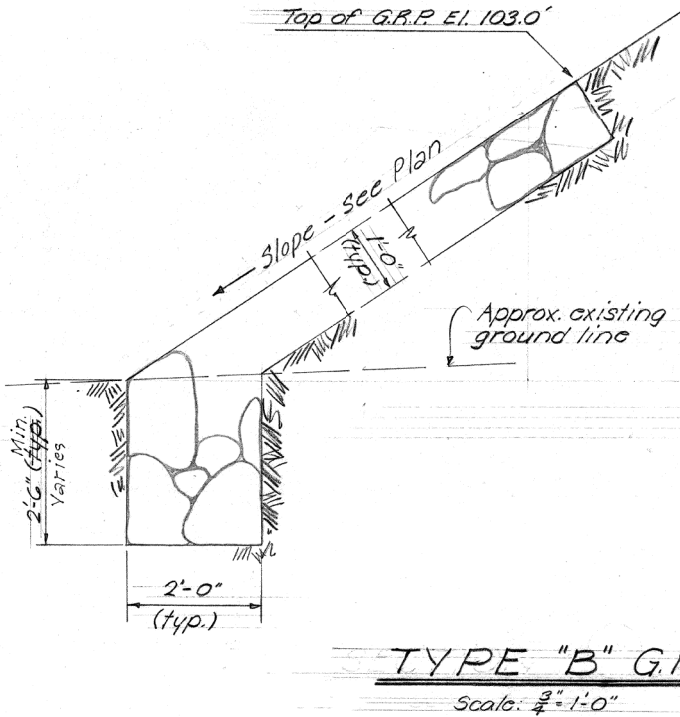
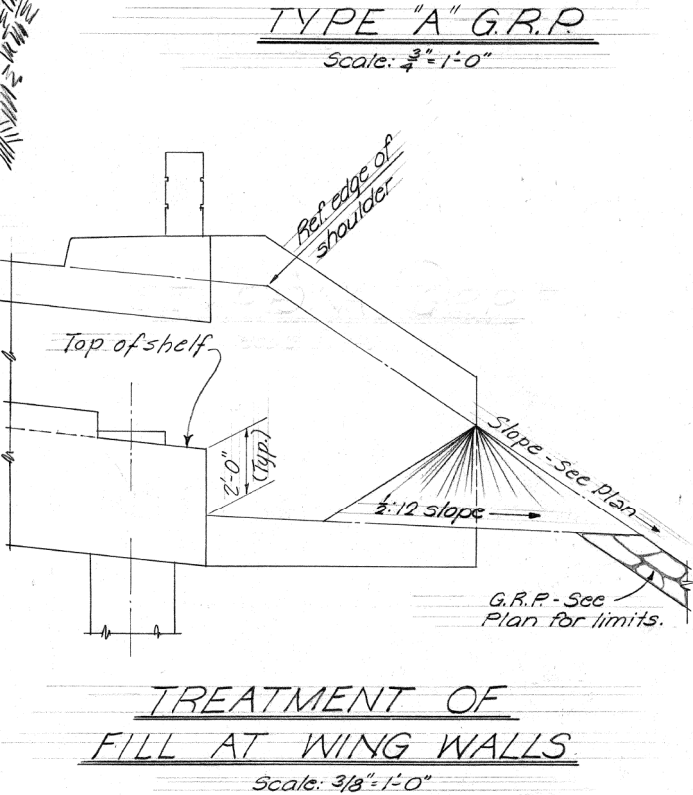
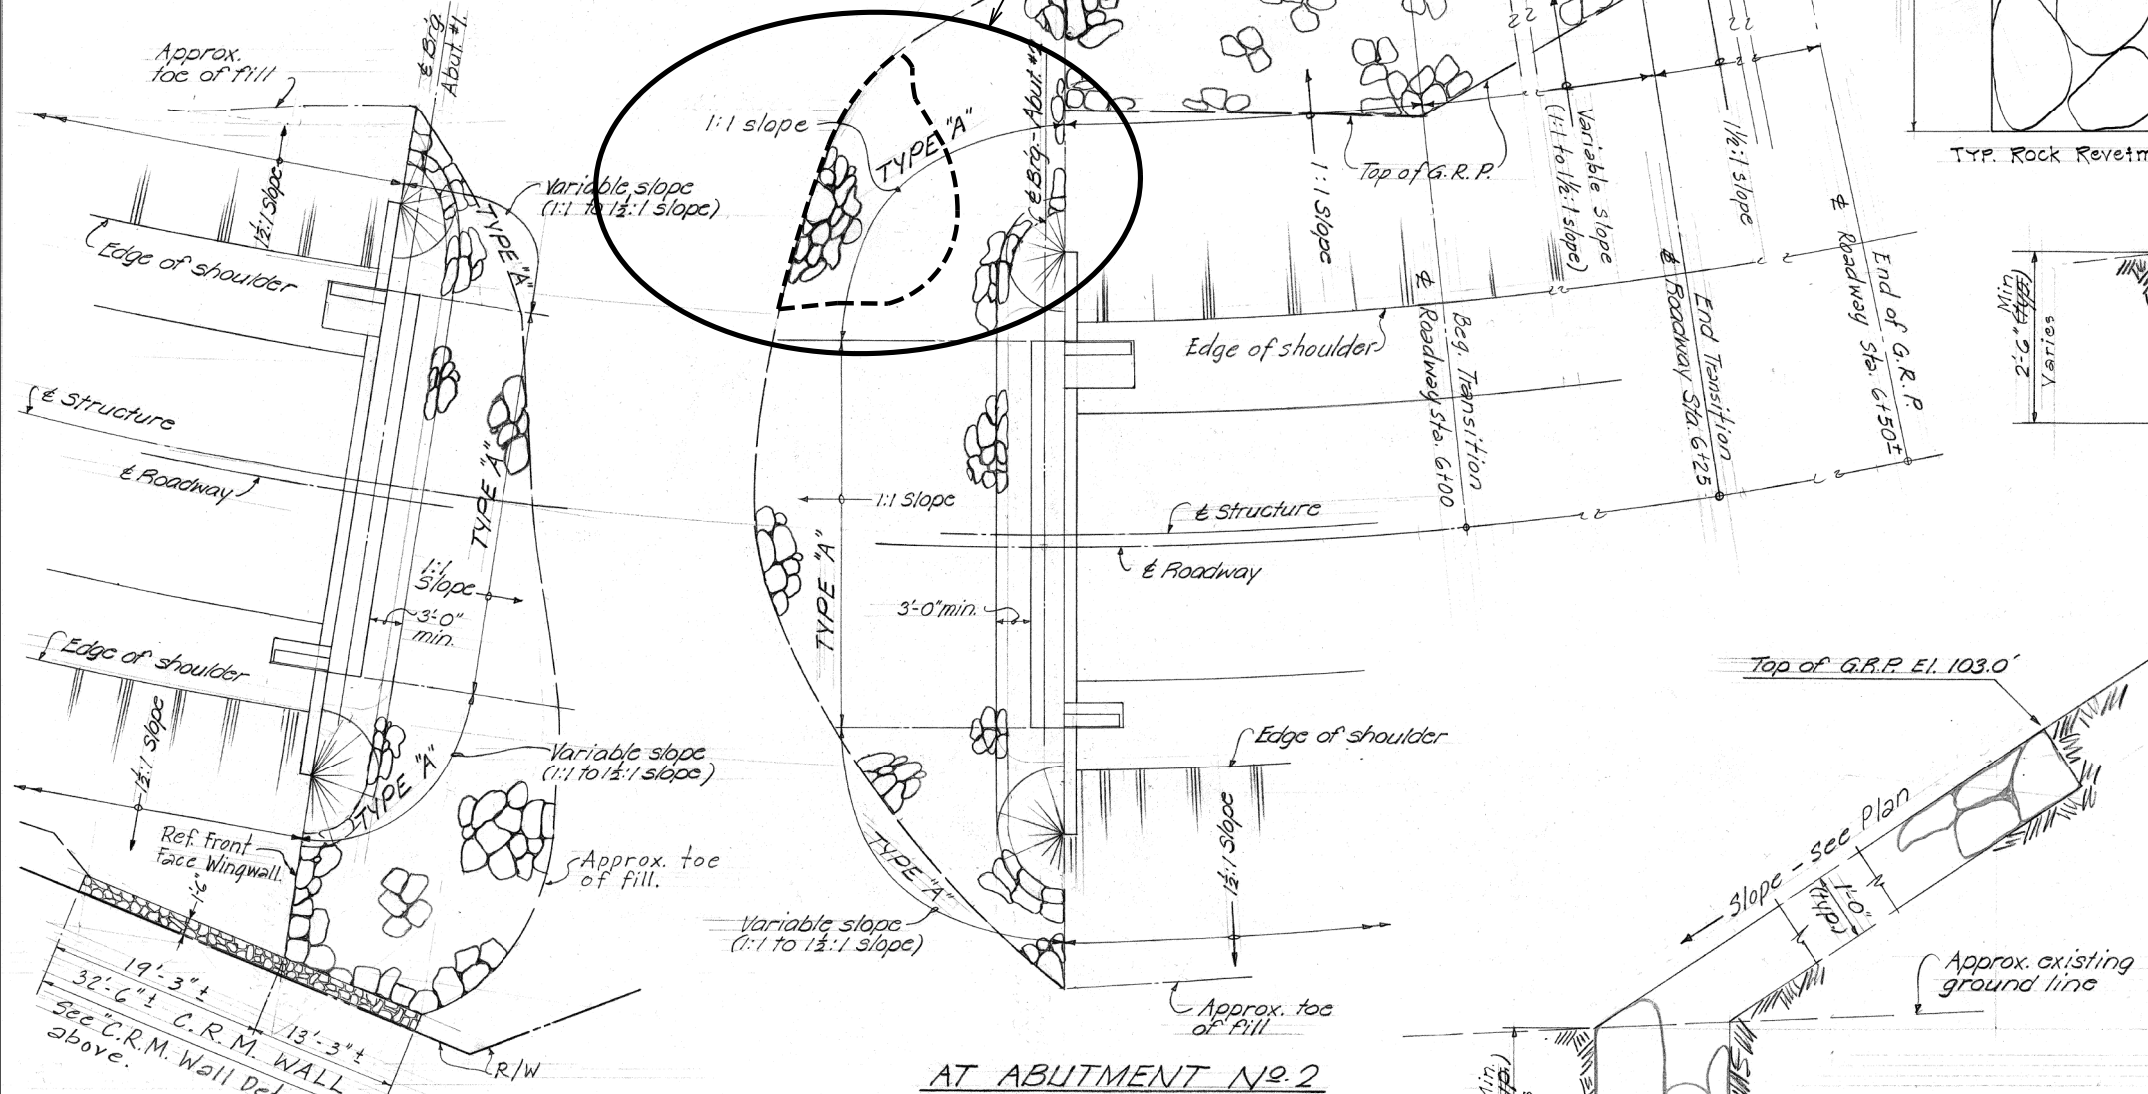
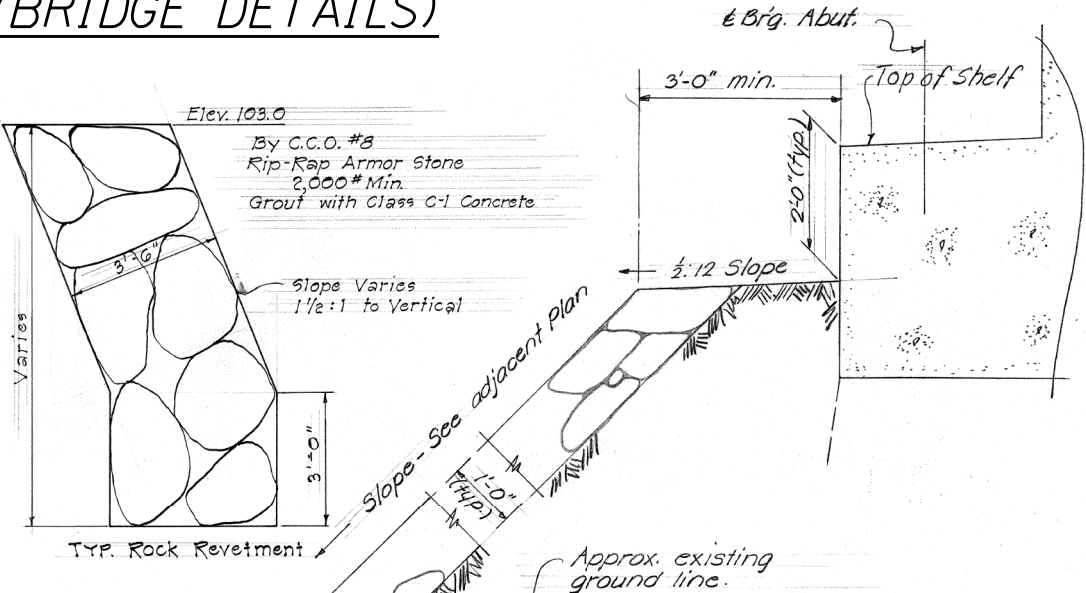


| FED. ROAD DIST. NO. | STATE | PROJ. NO.   | FISCAL YEAR | SHEET NO. | TOTAL SHEETS |
|---------------------|-------|-------------|-------------|-----------|--------------|
| HAWAII              | HAW.  | 340C-01-18M | 2021        | 11        | 11           |

"FOR INFORMATION ONLY"  
 "AS-BUILT PLAN"  
 (BRIDGE DETAILS)

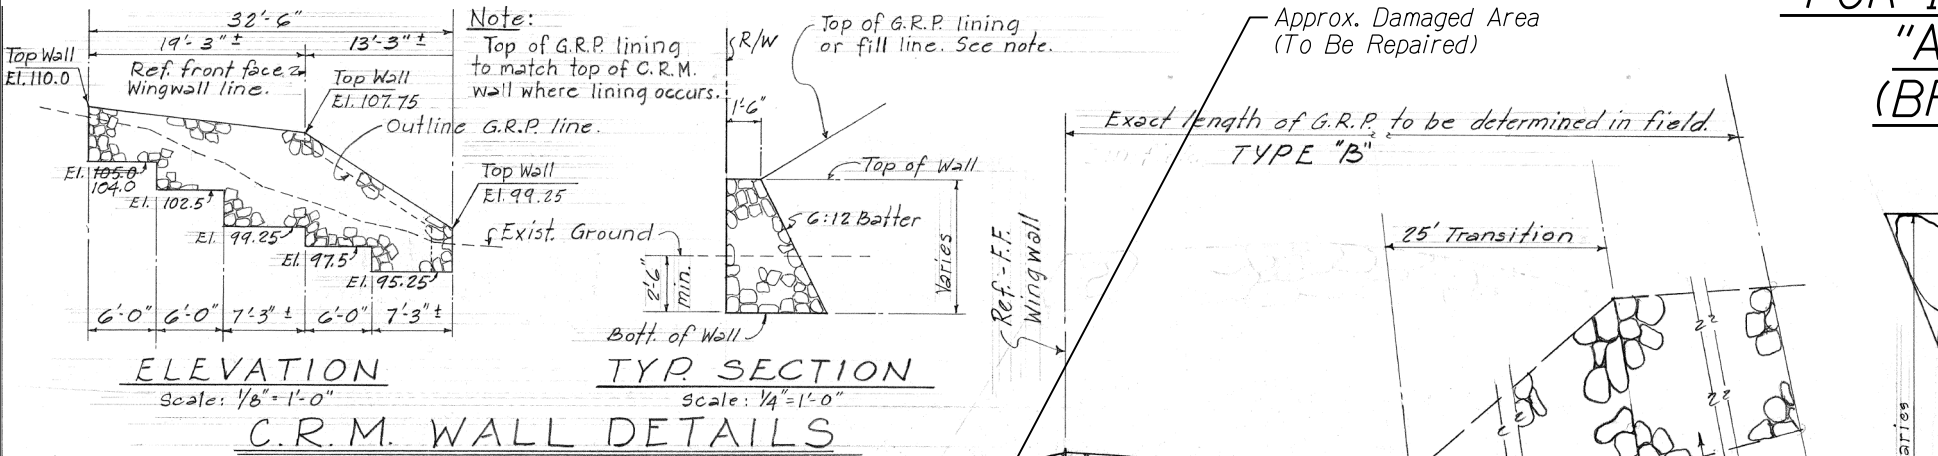

STATE OF HAWAII

DEPARTMENT OF TRANSPORTATION

HIGHWAYS DIVISION

WAIHEE RIVER BRIDGE

KAHEKILI HIGHWAY

WAIHEE RIVER FLOOD REPAIRS

AT WAIHEE BRIDGE

Project No. 340C-01-18M

Date: March, 2020

SHEET No. 3 OF 3 SHEETS

|                   |      |
|-------------------|------|
| SURVEY PLOTTED BY | DATE |
| 2/18              |      |
| DESIGNED BY       |      |
| NOTED BY          |      |
| CHECKED BY        |      |
| APPROVED BY       |      |