
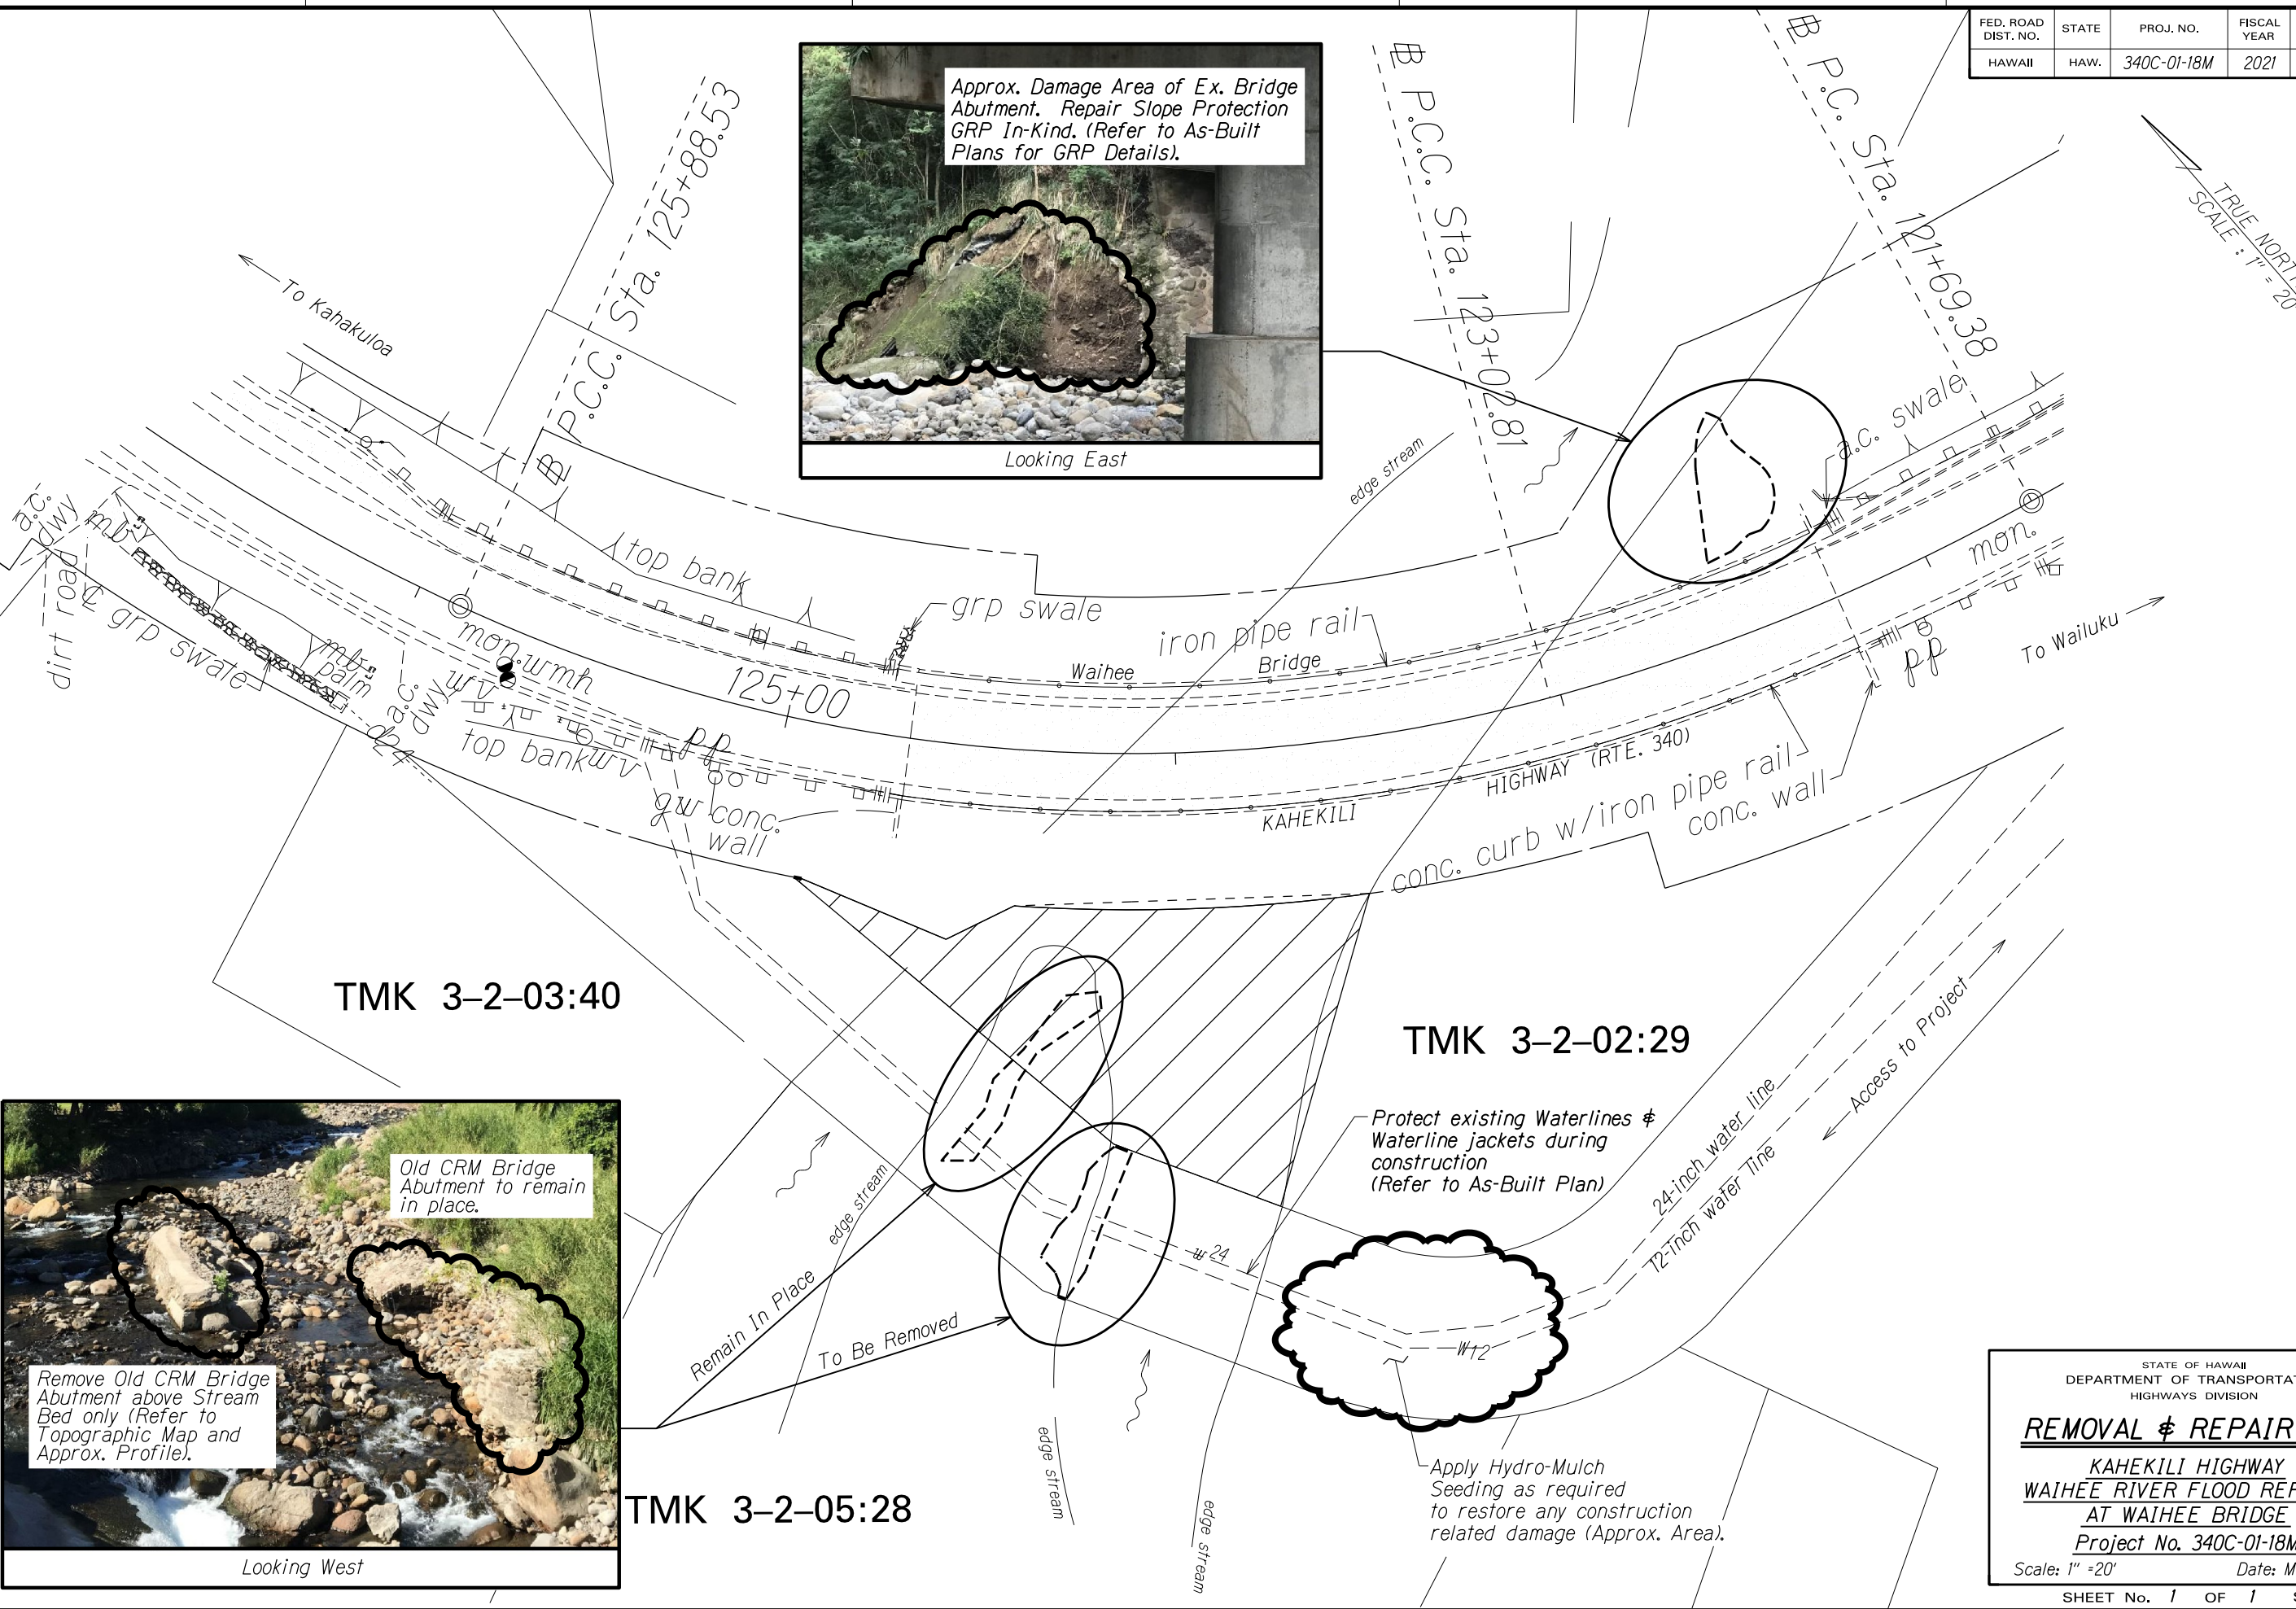


| FED. ROAD DIST. NO. | STATE | PROJ. NO. | FISCAL YEAR | SHEET NO. | TOTAL SHEETS |
|---------------------|-------|-------------|-------------|-----------|--------------|
| HAWAII | HAW. | 340C-01-18M | 2021 | 6 | 11 |

TRUE NORTH
SCALE: 1" = 20'

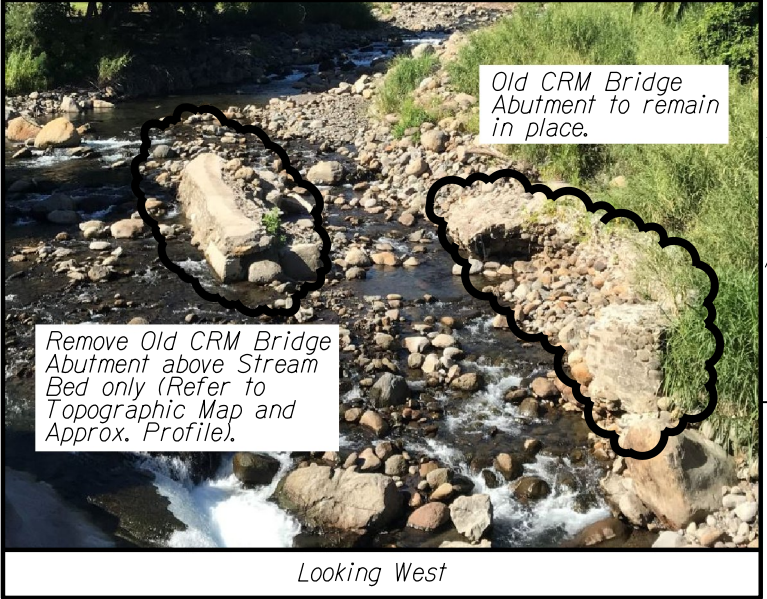

STATE OF HAWAII
DEPARTMENT OF TRANSPORTATION
HIGHWAYS DIVISION

REMOVAL & REPAIR PLAN

**KAHEKILI HIGHWAY
WAIHEE RIVER FLOOD REPAIRS
AT WAIHEE BRIDGE**

Project No. 340C-01-18M

Scale: 1" = 20' Date: March, 2021


SHEET No. 1 OF 1 SHEETS

| FED. ROAD DIST. NO. | STATE | PROJ. NO. | FISCAL YEAR | SHEET NO. | TOTAL SHEETS |
|---------------------|-------|-------------|-------------|-----------|--------------|
| HAWAII | HAW. | 340C-01-18M | 2021 | 6 | 11 |

TRUE NORTH
SCALE: 1" = 20'



Looking East

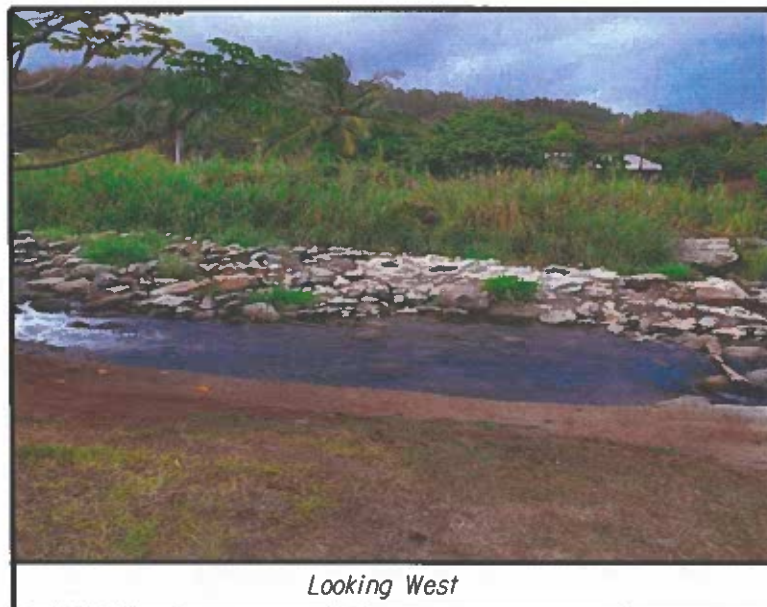

Looking West

| | |
|---------------|------|
| ORIGINAL PLAN | DATE |
| 5/21 | |
| DESIGNED BY | |
| QUANTITIES BY | |
| CHECKED BY | |

STATE OF HAWAII
DEPARTMENT OF TRANSPORTATION
HIGHWAYS DIVISION

REMOVAL & REPAIR PLAN
KAHEKILI HIGHWAY
WAIHEE RIVER FLOOD REPAIRS
AT WAIHEE BRIDGE
Project No. 340C-01-18M
Scale: 1" = 20' Date: March, 2021

SHEET No. 1 OF 1 SHEETS

"AS-BUILT"