	INDEX TO DRAWINGS
SHEET NO.	DESCRIPTION
1	TITLE SHEET
2	GENERAL NOTES
3 - 5	WATER POLLUTION AND EROSION CONTROL NOTES
6	REMOVAL AND REPAIR PLAN
7	TRAFFIC ACCESS PLANS
8	TOPOGRAPHIC MAP
9	AS-BUILT PLAN (WATERLINE JACKET)
10	AS-BUILT PLAN (BRIDGE LAYOUT)
11	AS-BUILT PLAN (BRIDGE DETAILS)
	8

STATE OF HAWAII

DEPARTMENT OF TRANSPORTATION

HIGHWAYS DIVISION HONOLULU, HAWAII


"AS-BUILT"

PLANS FOR

KAHEKILI HIGHWAY WAIHEE RIVER FLOOD REPAIRS AT WAIHEE BRIDGE PROJECT NO. 340C-01-18M

DISTRICT OF WAILUKU ISLAND OF MAUI

SCALE IN THOUSAND FEET

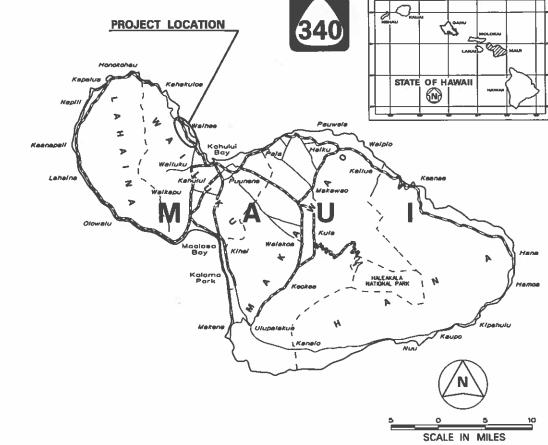

FED. ROAD DIST. NO.

STATE

APPROVED:

DIR. OF TRANSPORTATION

DATE

PROJ. NO.

340C-01-18M

SHEET NO.

FISCAL YEAR

2021

