






PROFILES
Scale: 1"=5'

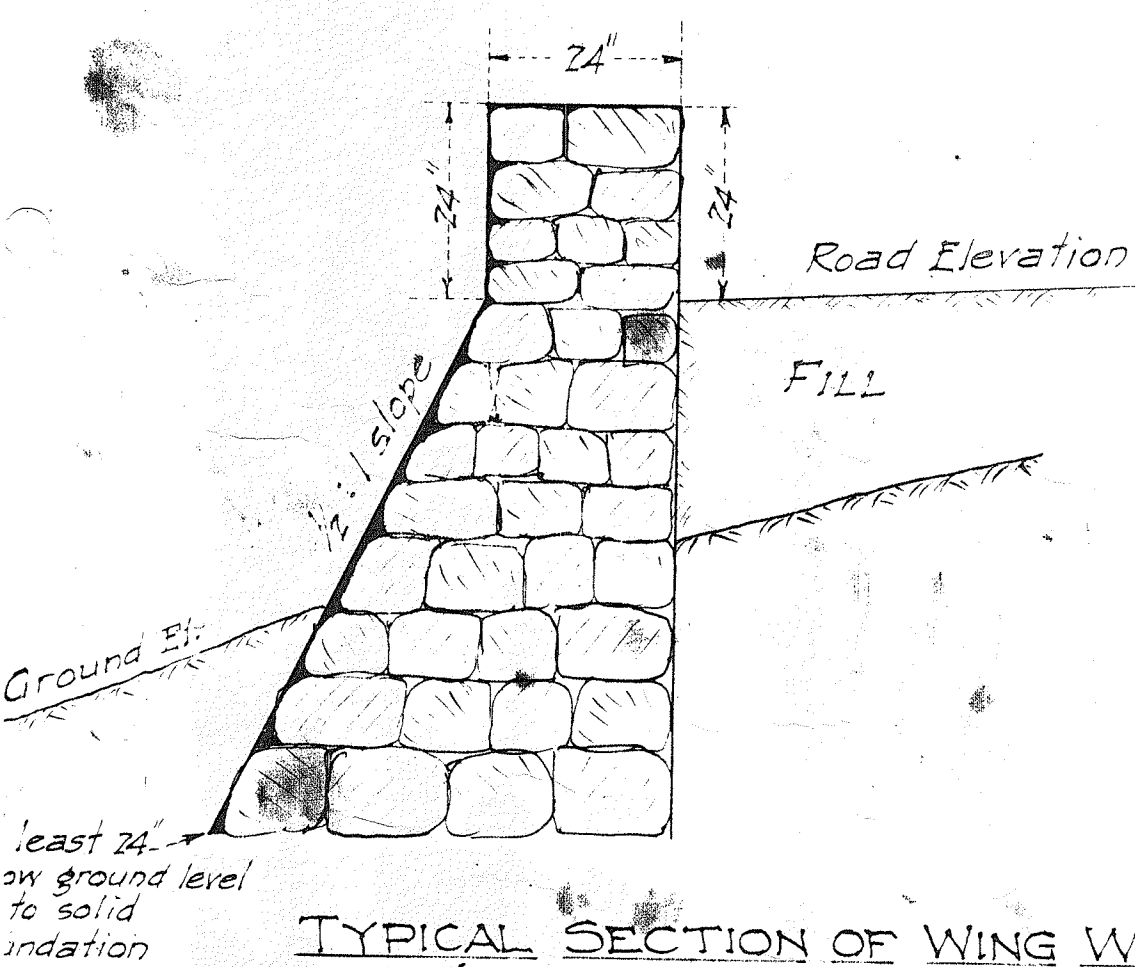


TYPICAL SECTION OF WING WALLS
(LOOSE ROCK, POINTED FACE)
Scale: 1"=2'

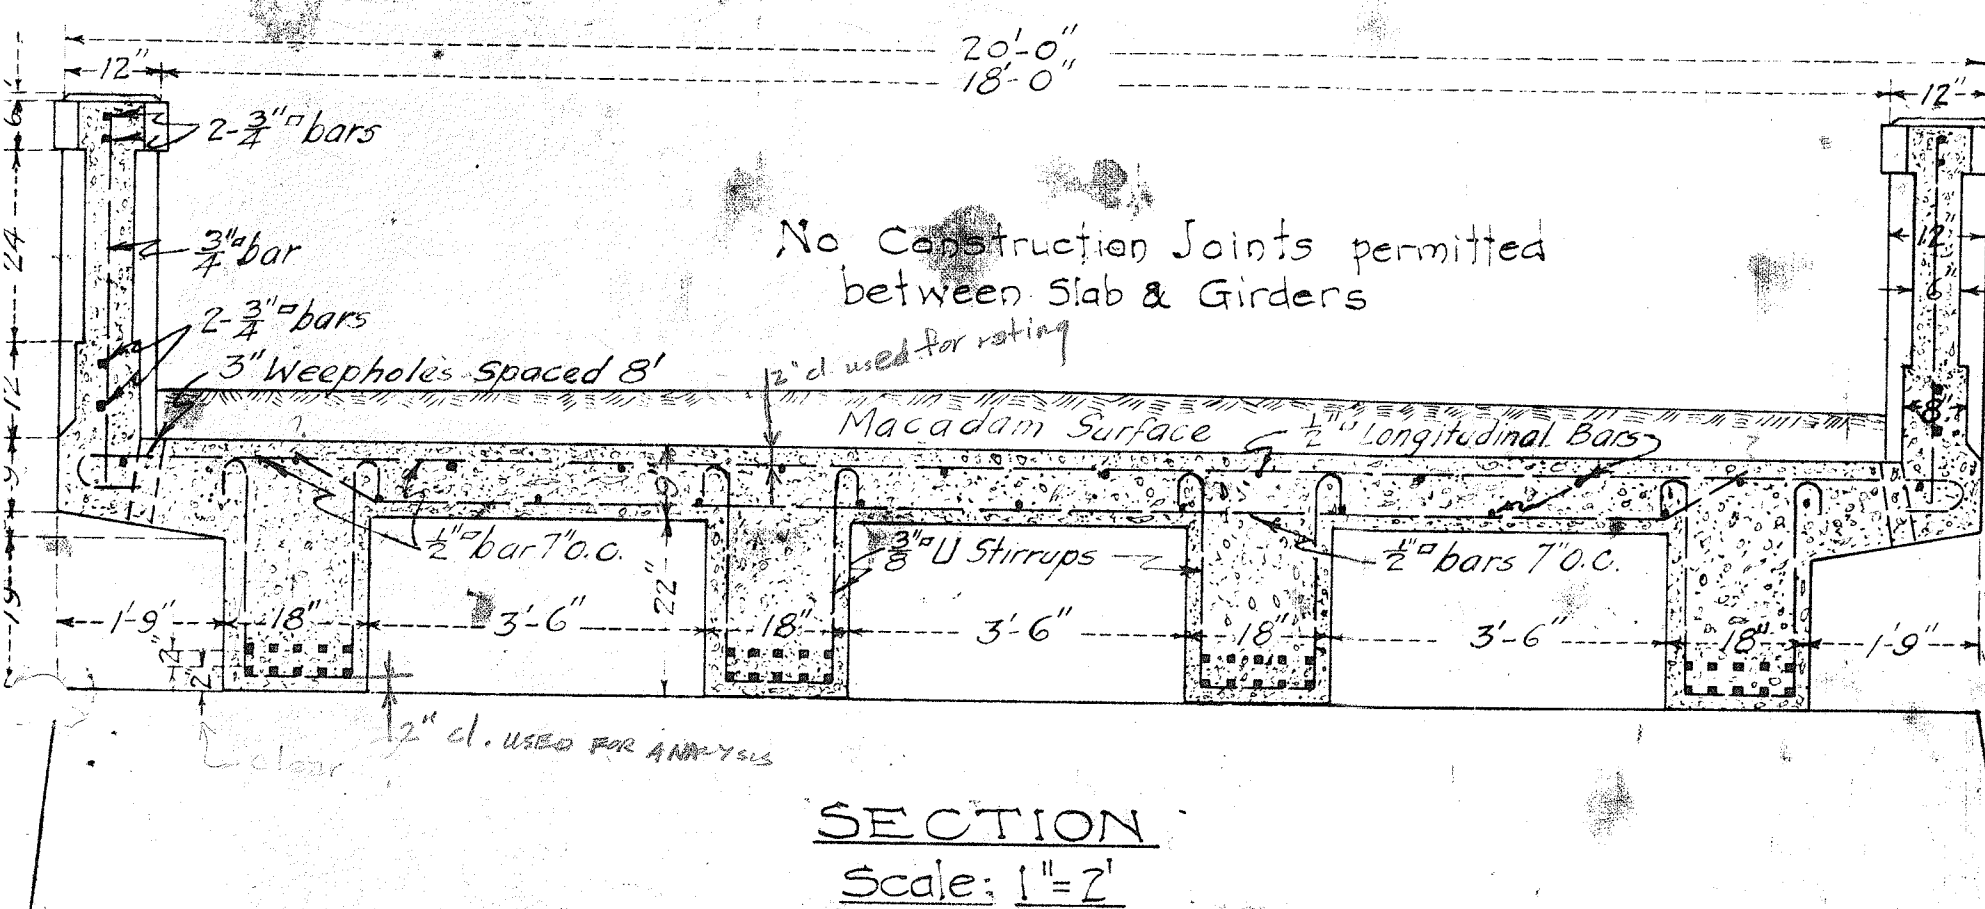

SECTION
Scale: 1"=2'

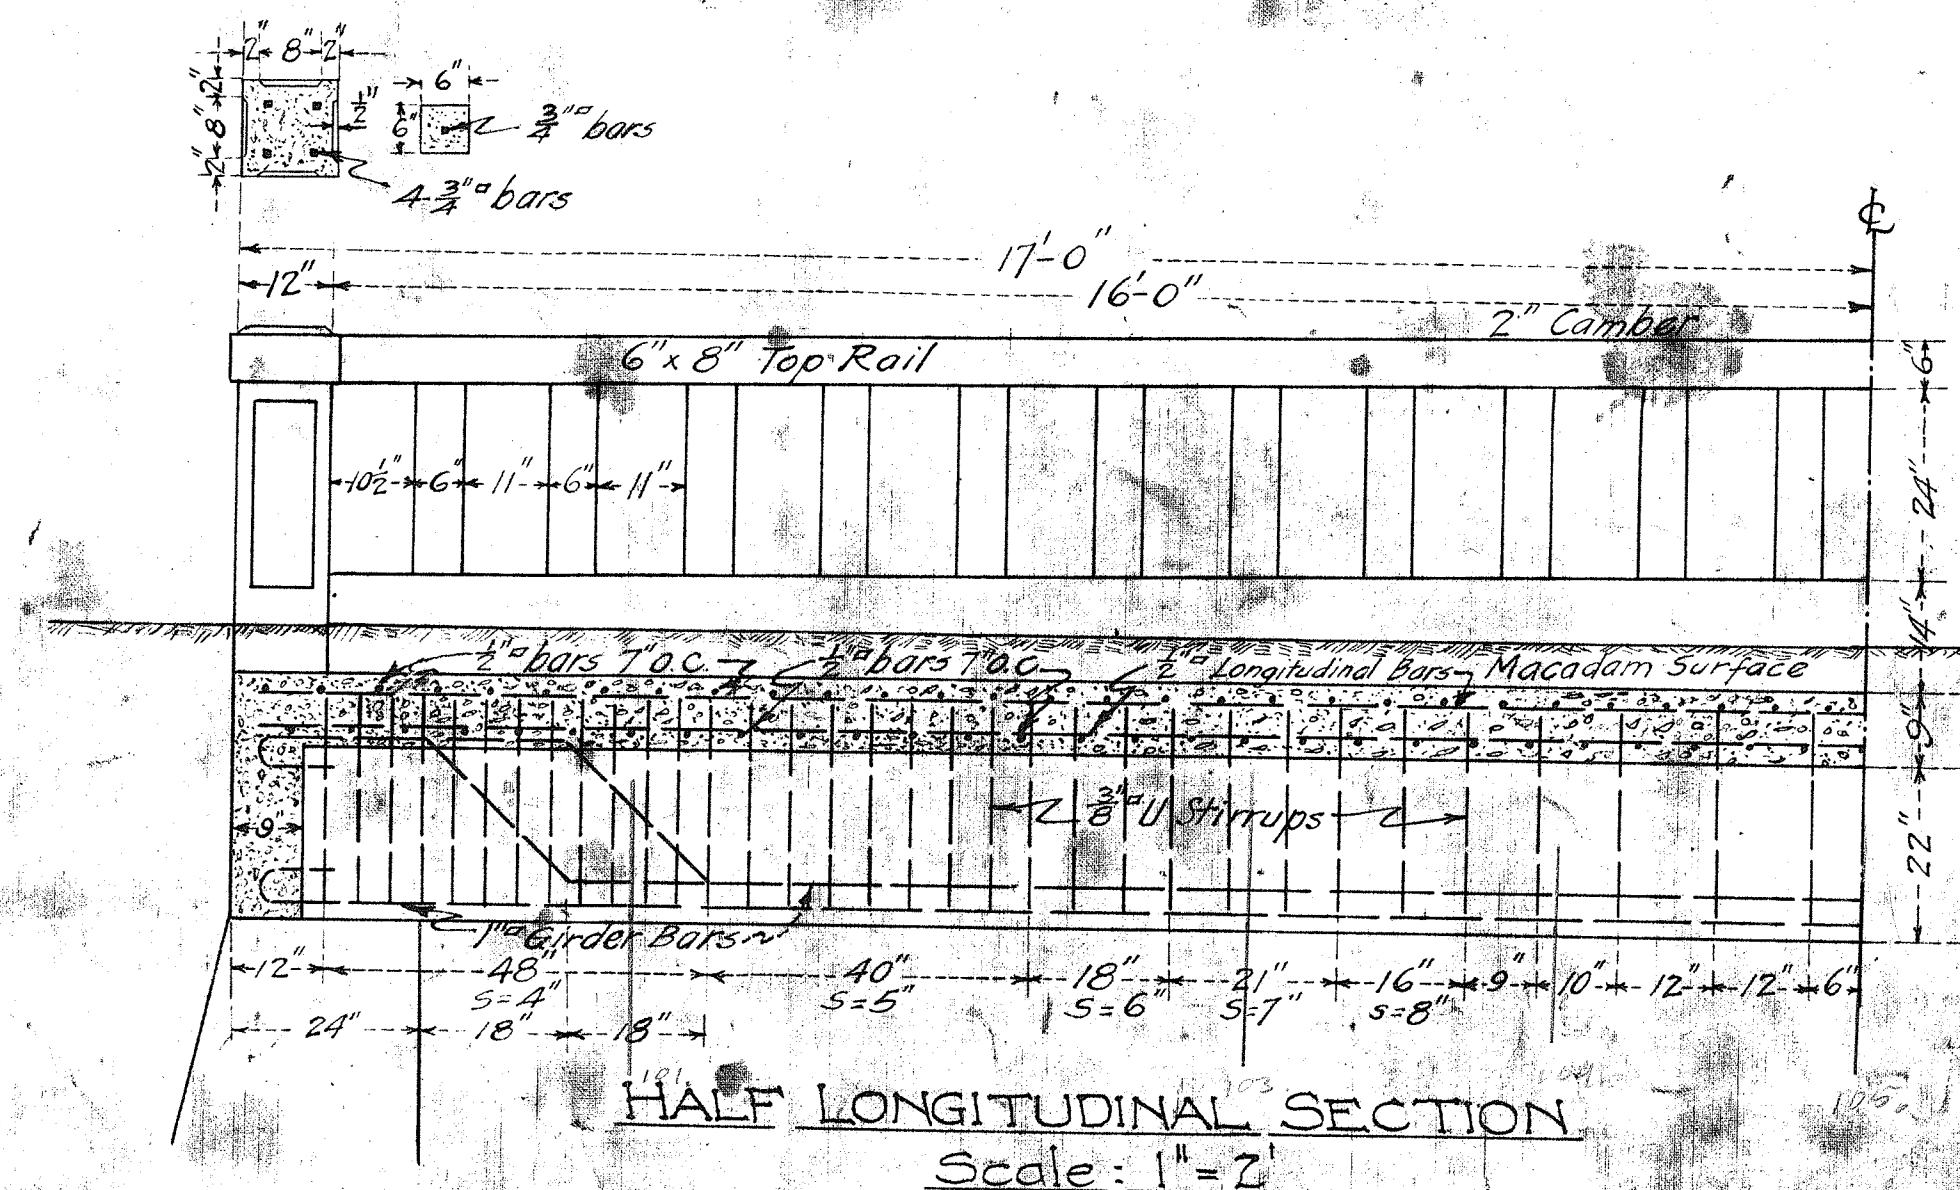

HALF LONGITUDINAL SECTION
Scale: 1"=2'

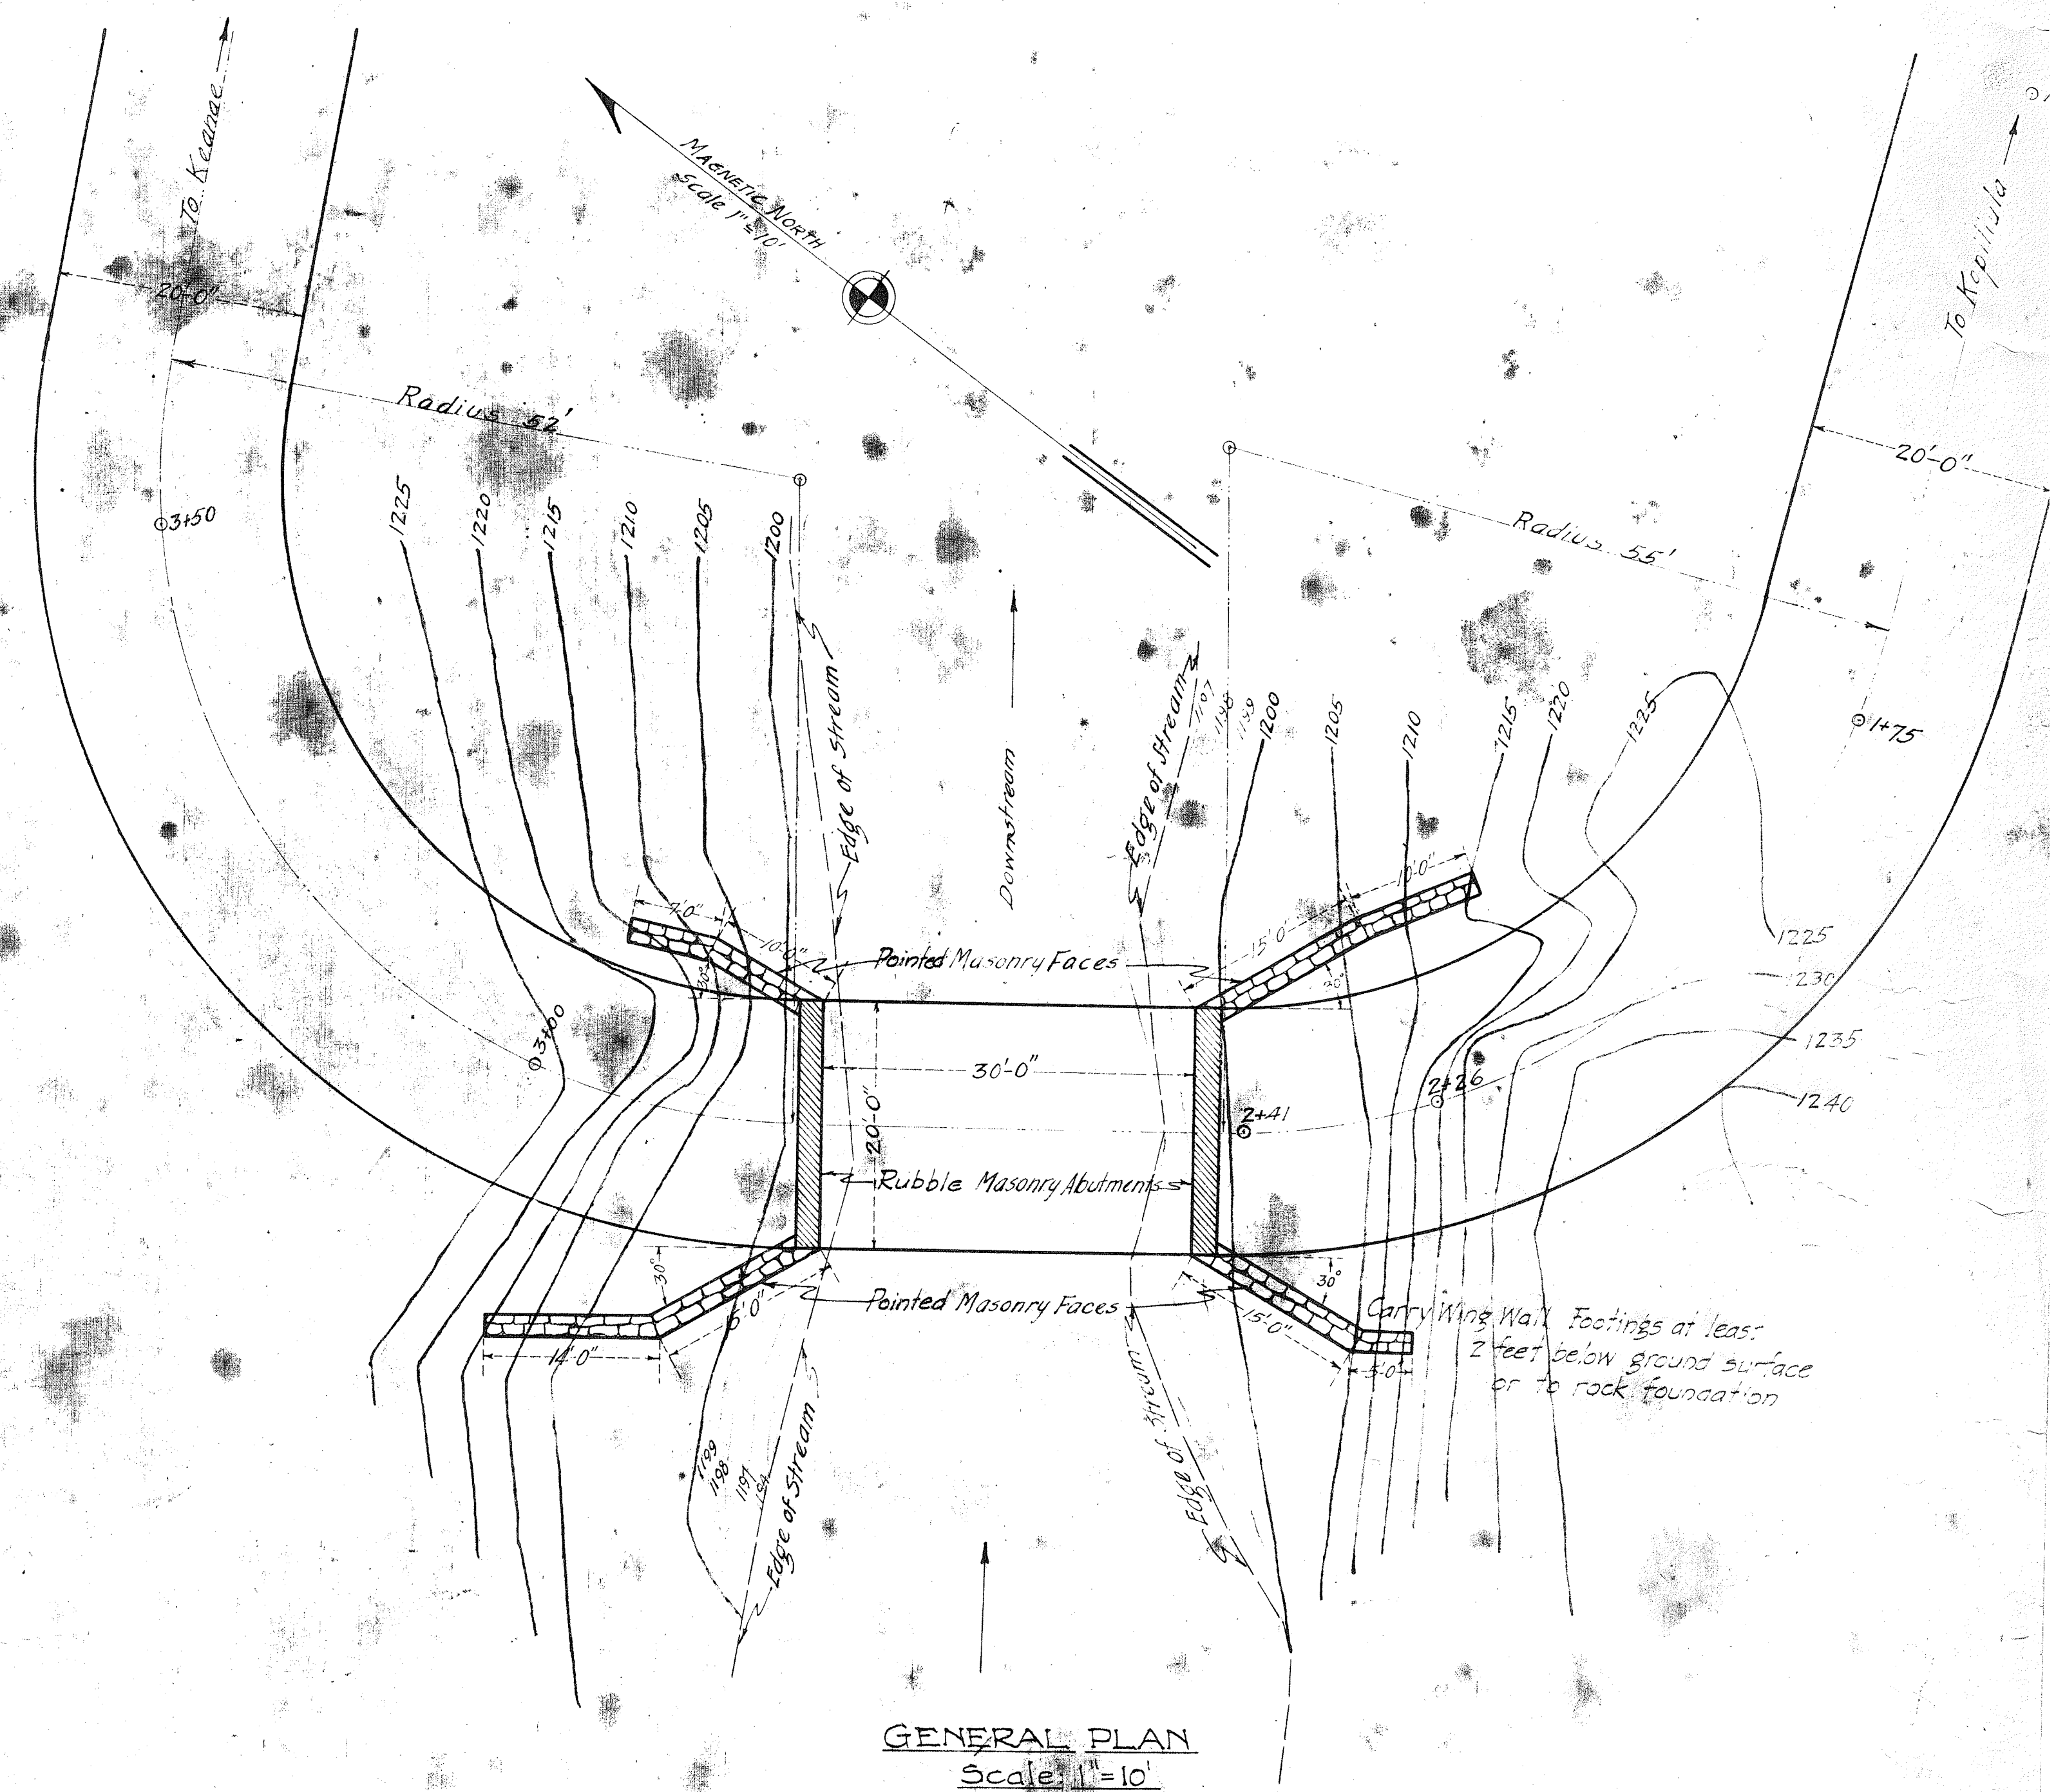

GENERAL PLAN
Scale: 1"=10'

East Wailuaiki Stream Bridge
009 00360 05 02131
Hana Highway (Route 360)
Milepost 21.30

M-8: Sht. 20 of 21

KAILUA-KOPILIULA BELT &
COUNTY OF MAUI, HAWAII
JOB No. 7
COUNTY ENGINEER'S OFFICE JULY
A.P. LOW, COUNTY ENGINEER
Approved by: *L. H. B. B.*
Superintendent of Public Works
Sheet 7 of 7

EAST WAILUAIKI BRIDGE
#360017