




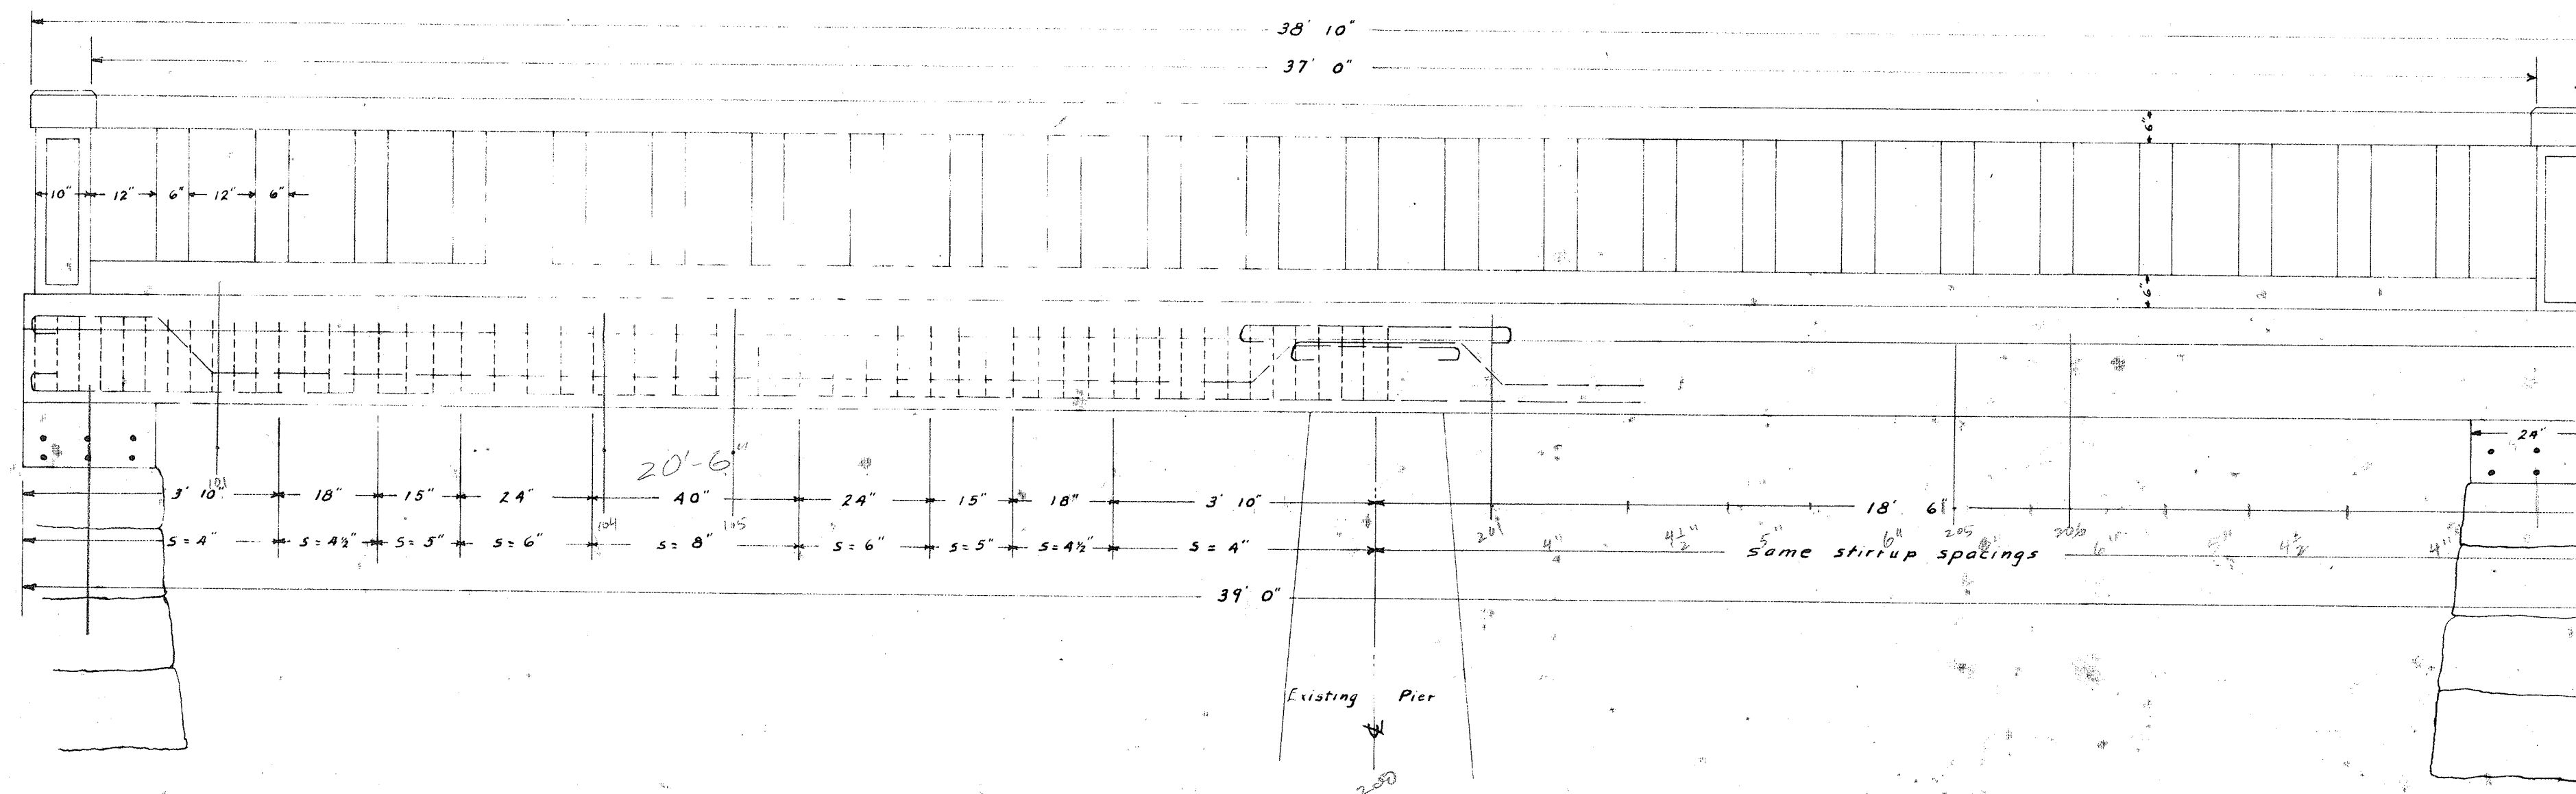

ELEVATION
Scale 1" = 2'

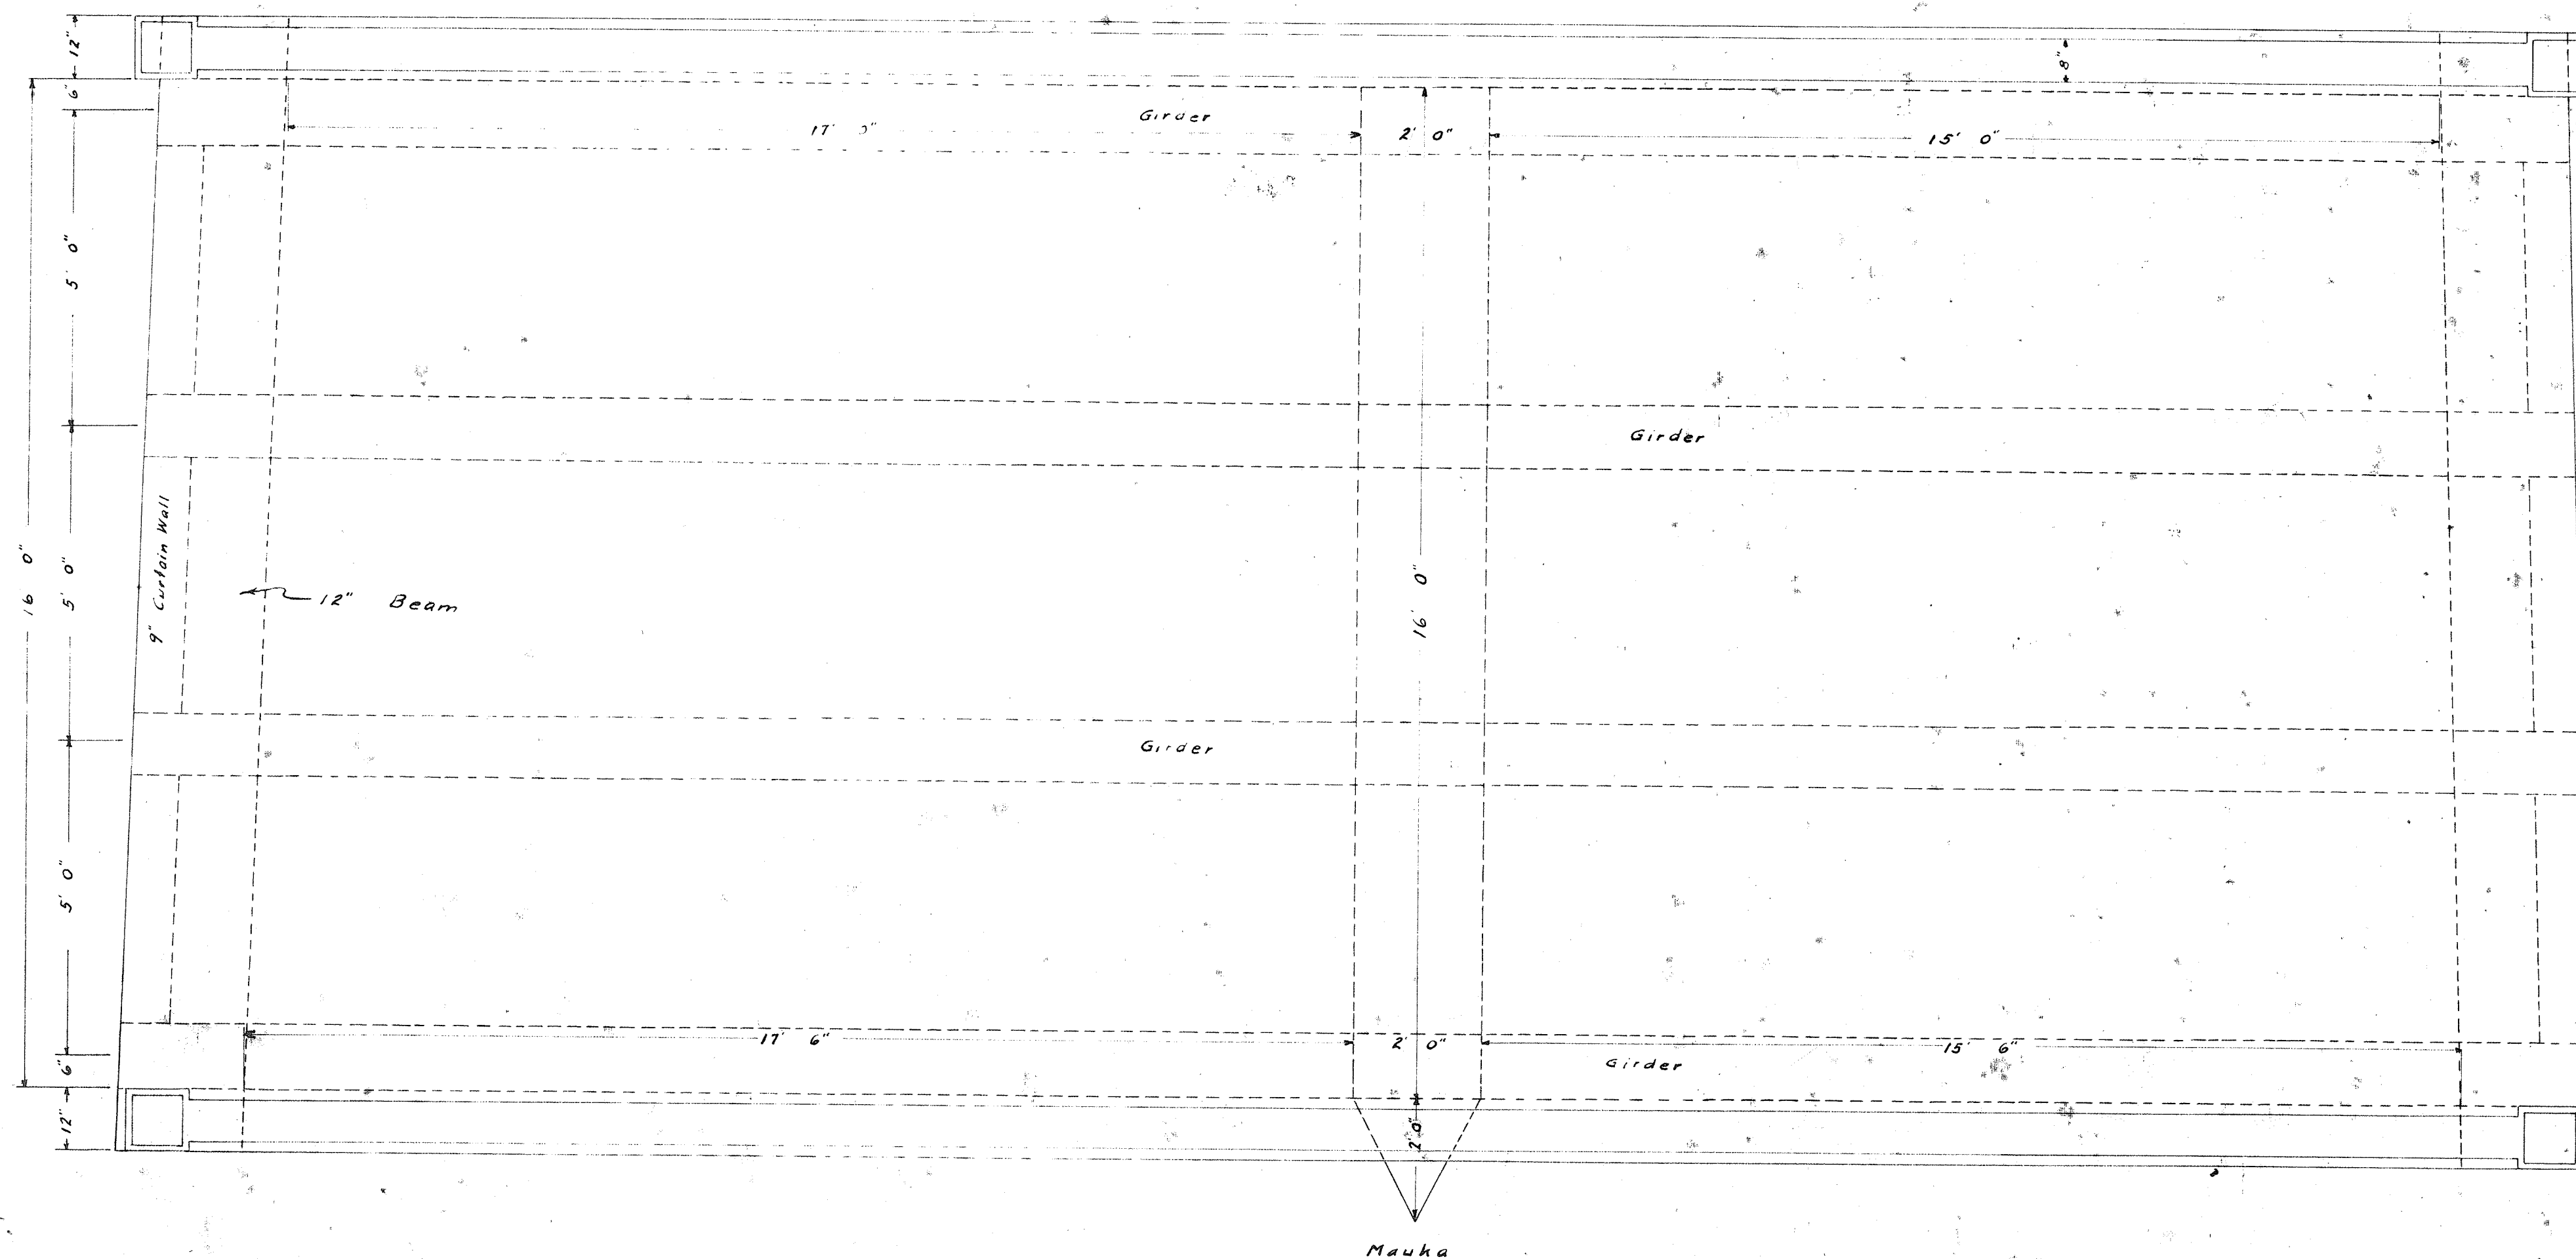

EAST HONOMAELE BRIDGE #360039
HANA, MAUI, T. H.
County Engineer's Office Sept, 1924
Scale 1" = 2'

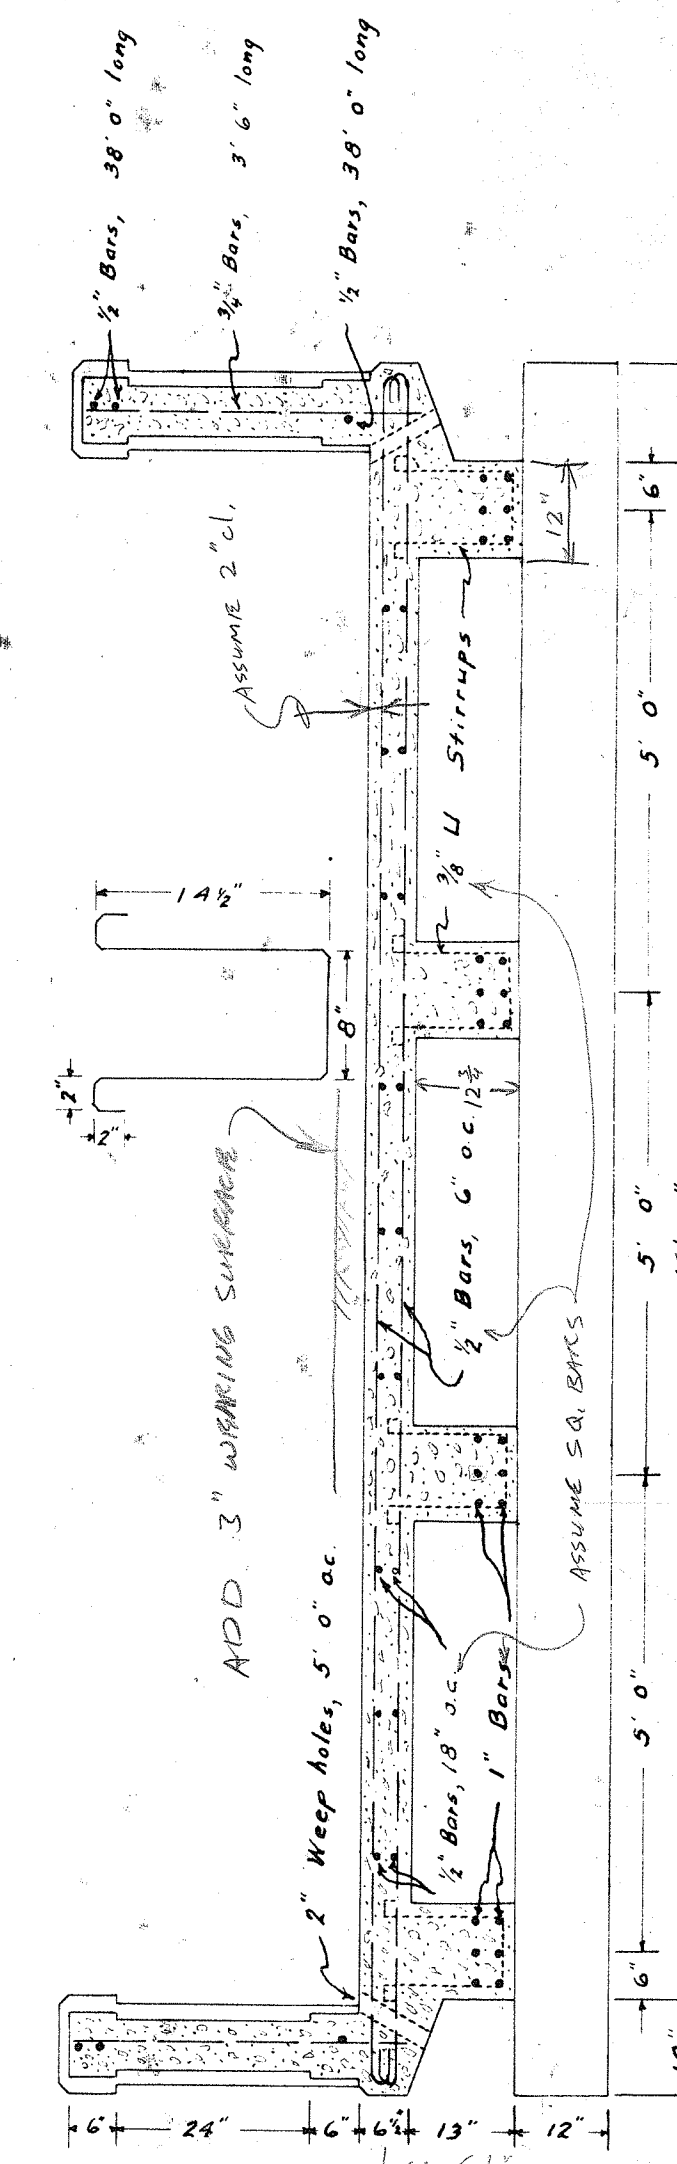

Honomaele Stream Bridge
009 00360 05 02958
Hana Highway (Route 360)
Milepost 29.54