




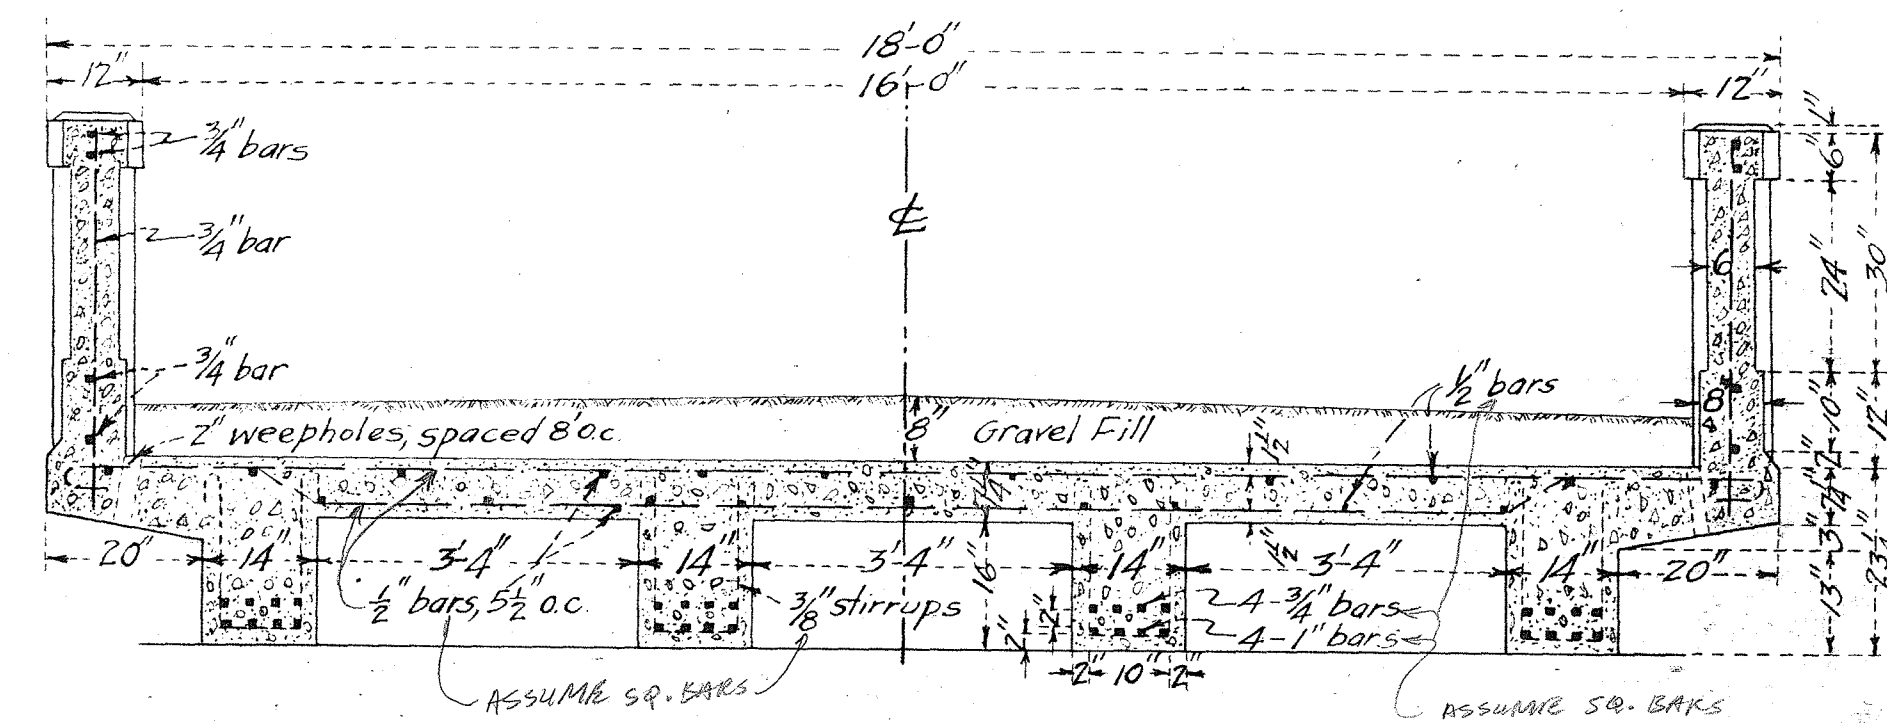


SECTION
Scale: 1"=2'

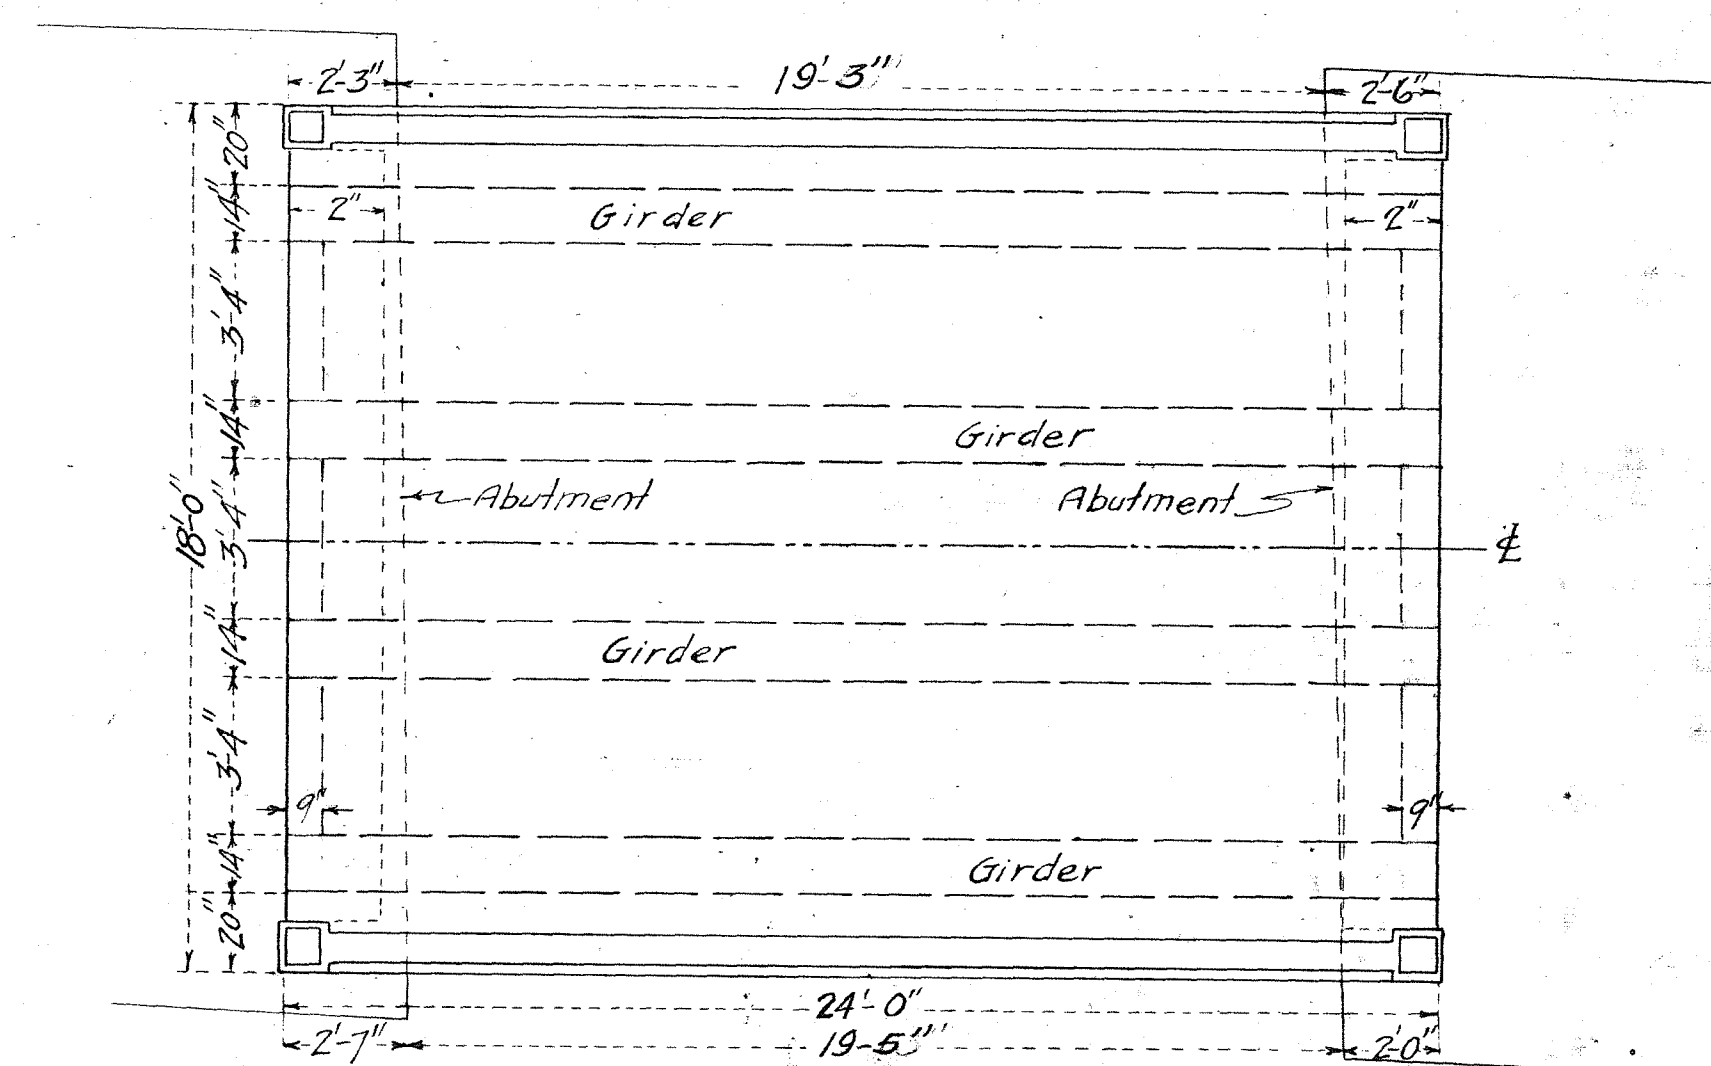

PLAN
Scale: 1"=4'

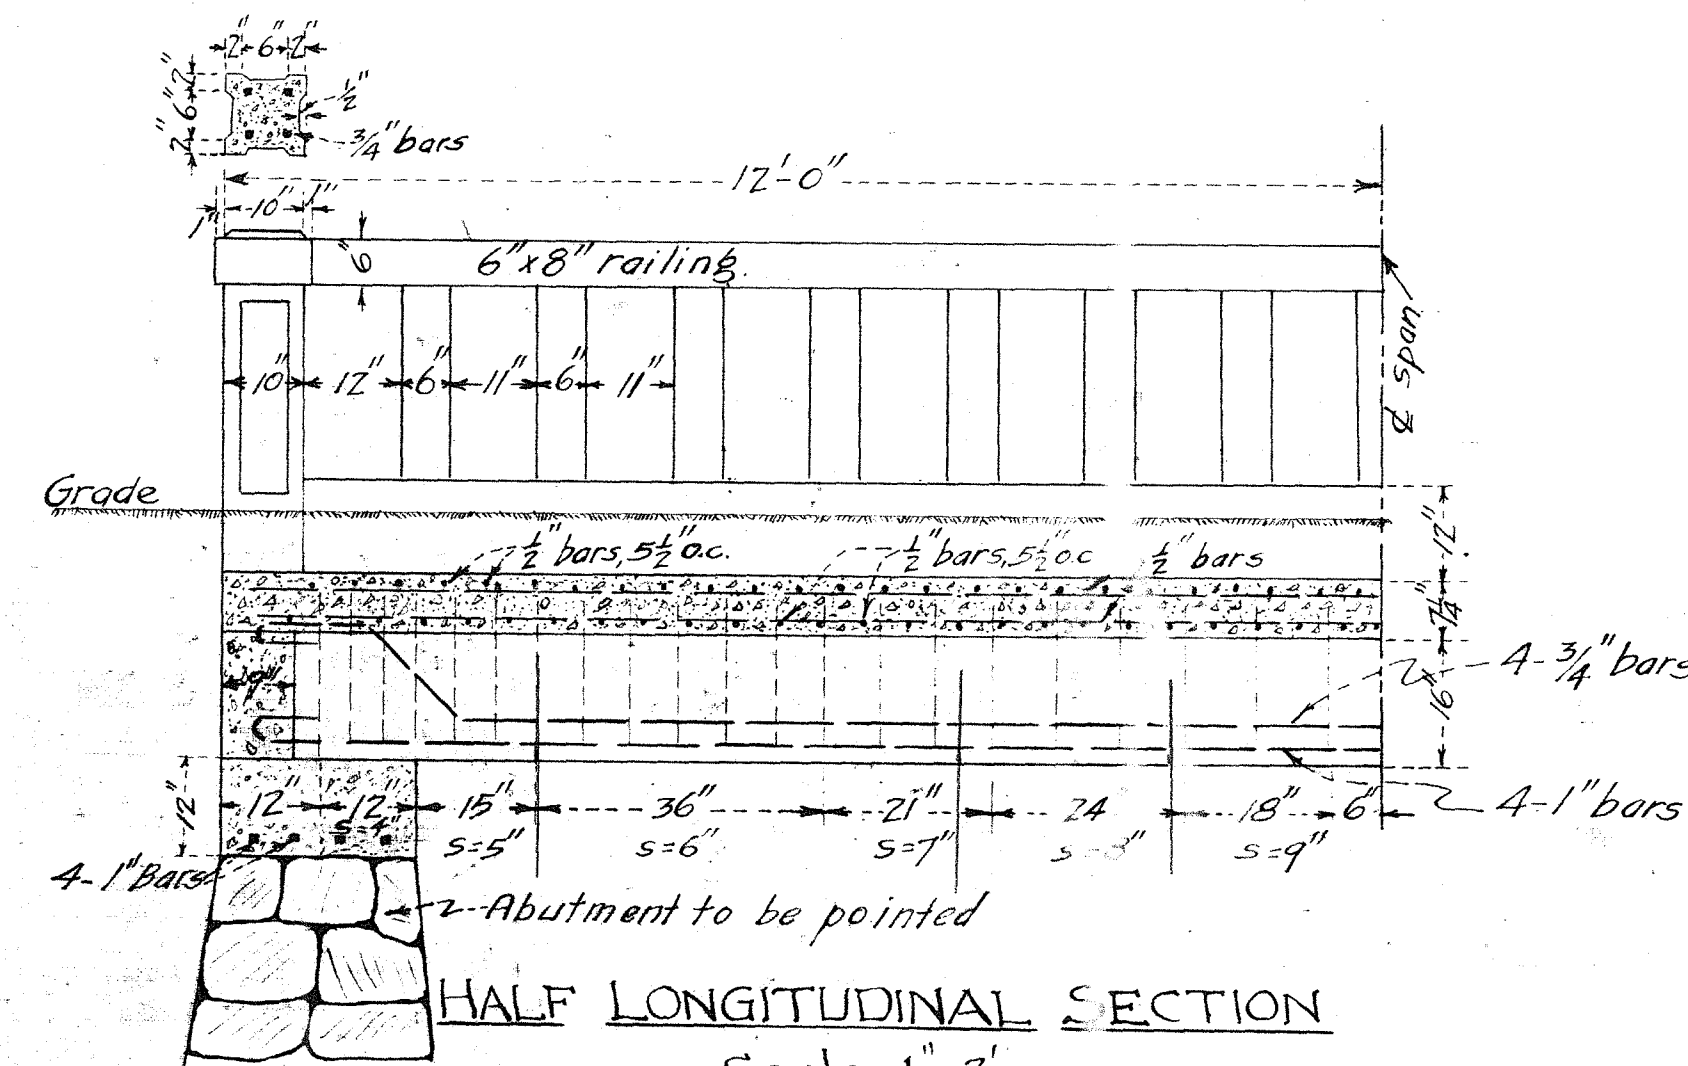

HALF LONGITUDINAL SECTION
Scale: 1"=2'

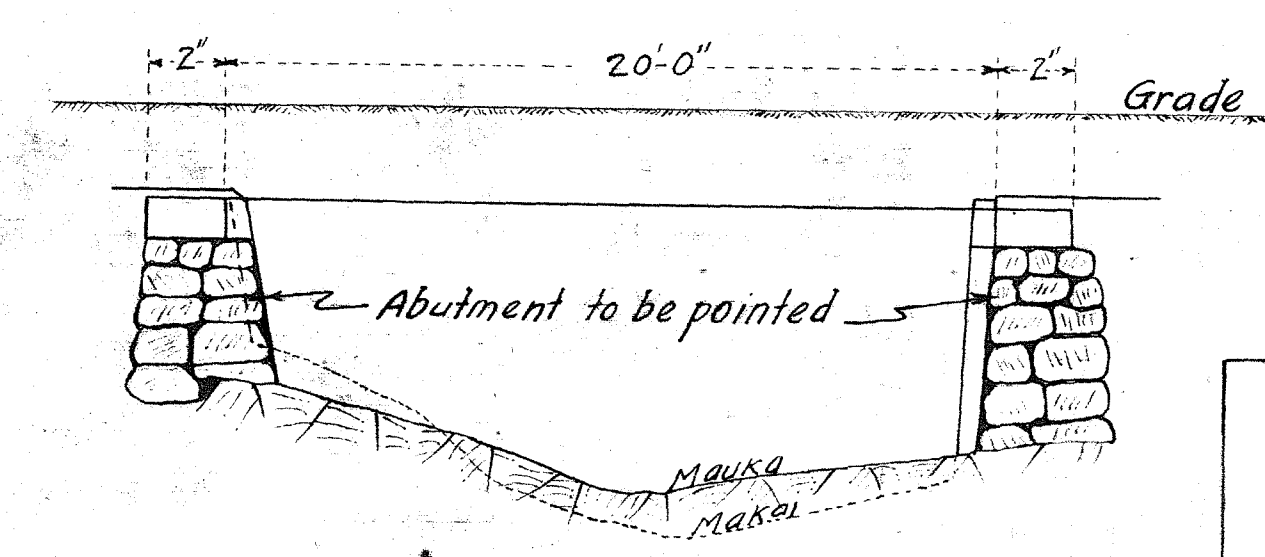

PROFILES
Scale: 1"=5'

STEEL SCHEDULE				
Beam	Qty	Size	Length	
Girder	10	1	15'-6"	Bottom Chord
	10	1	25'-0"	do
	16	3/4	25'-0"	do
Slab	101	3/8	1'-8"	Stirrups
	21	1/2	18'-6"	Transverse
	46	3/4	25'-0"	Longitudinal
	8	3/4	4'-0"	Vertical
	8	3/4	23'-6"	Horizontal

CONCRETE YARDAGE
1.5 cu concrete - 21.5 cu yds.

#360028
KAHALAOWAKA BRIDGE
50.8 MILES
HANA DISTRICT MAUI, HI
COUNTY ENGINEER'S OFFICE
AUGUST 1925