
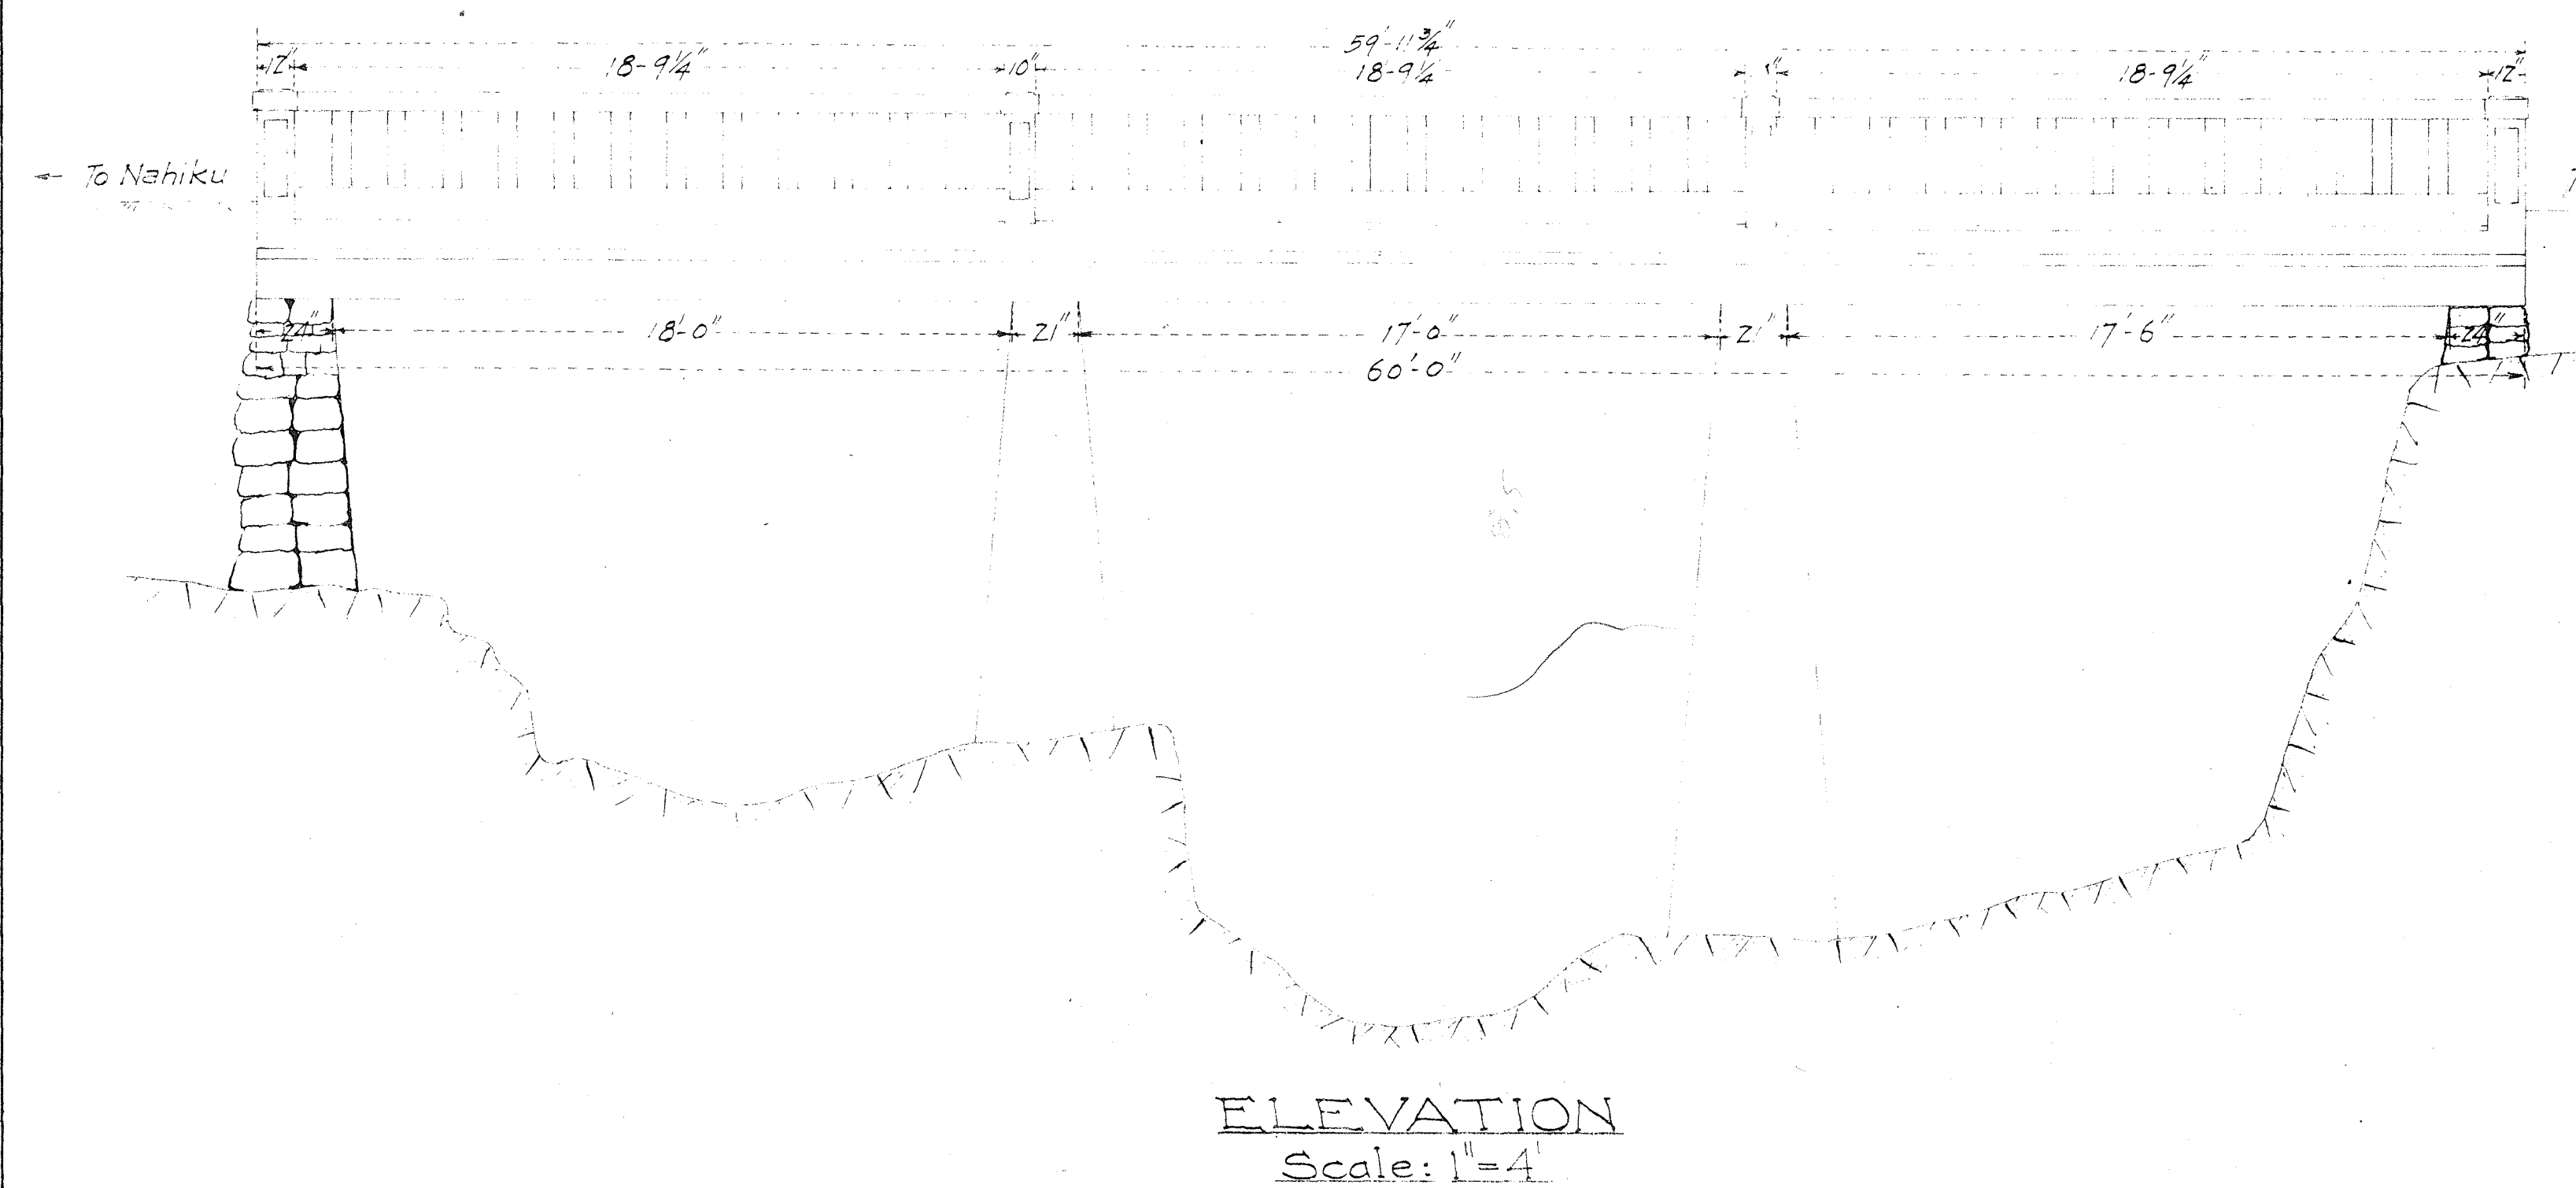


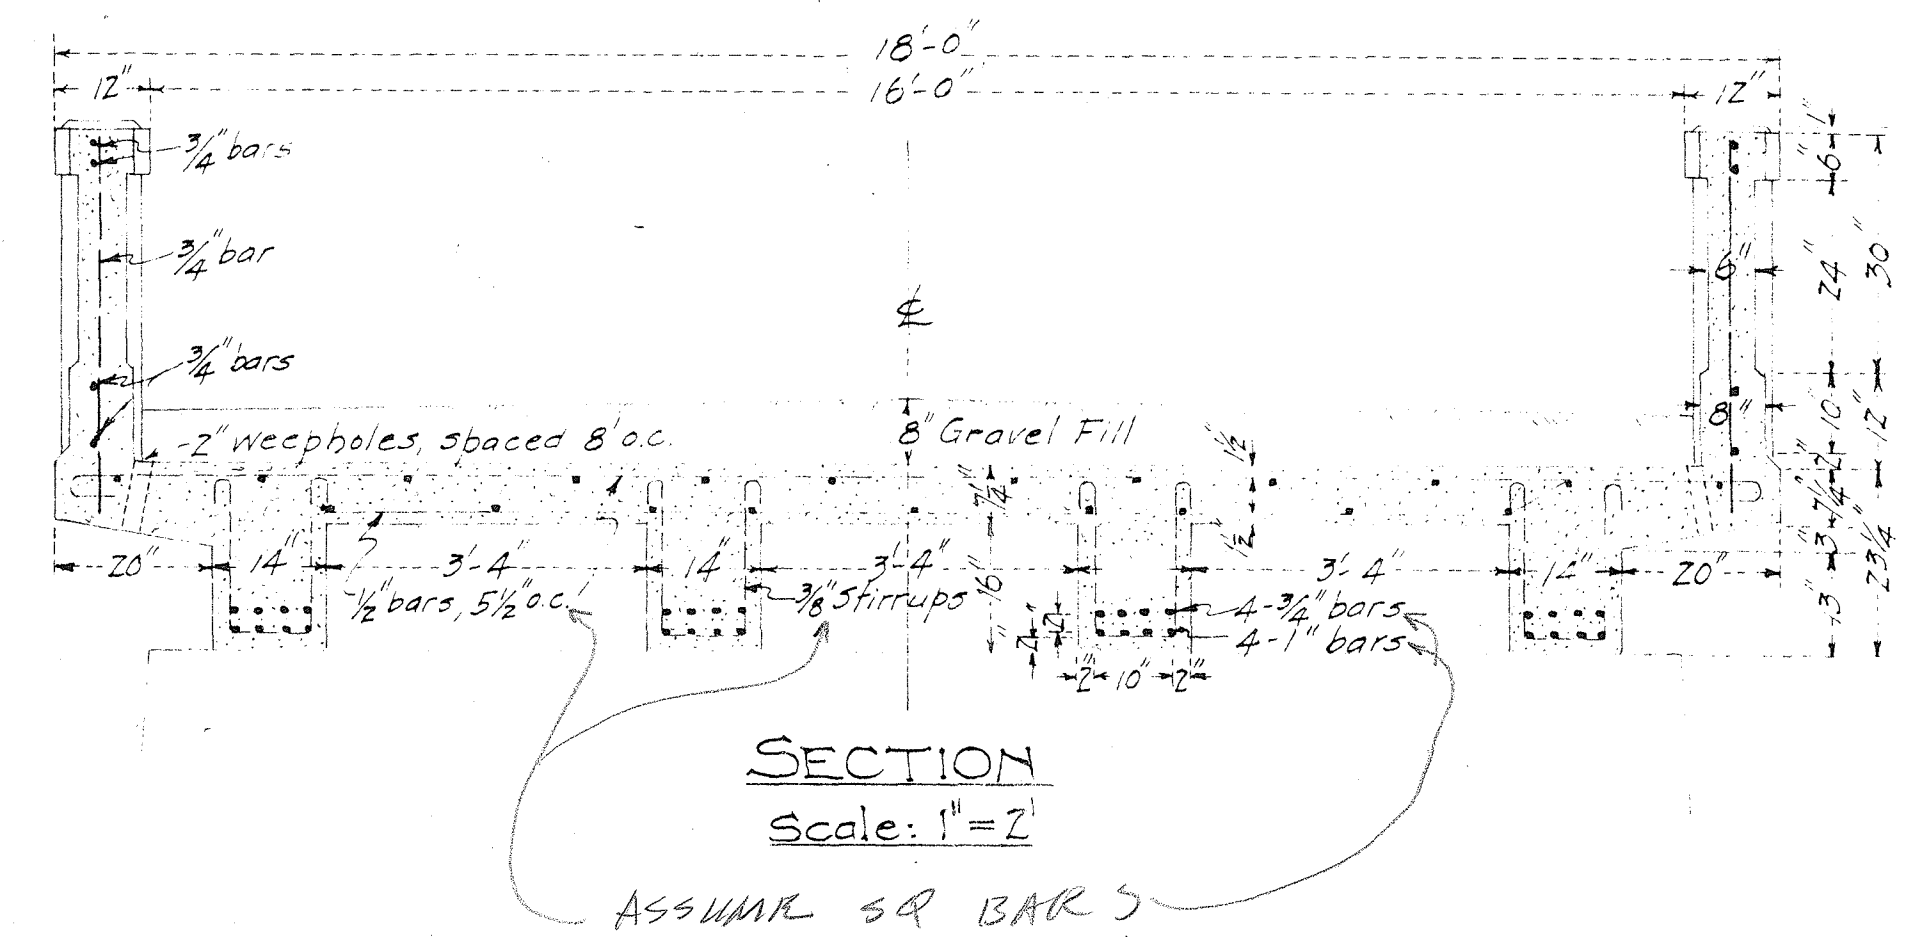

Kahawaihapapa Stream Bridge
009 00360 05 02664
Hana Highway (Route 360)
Milepost 26.60

M-9: Sht. 7 of 10

#360030
KAWAIHAPAPA BRIDGE
51.5 MILES
HANA DISTRICT MAULI T. H.
COUNTY ENGINEER'S OFFICE
JULY, 1925