
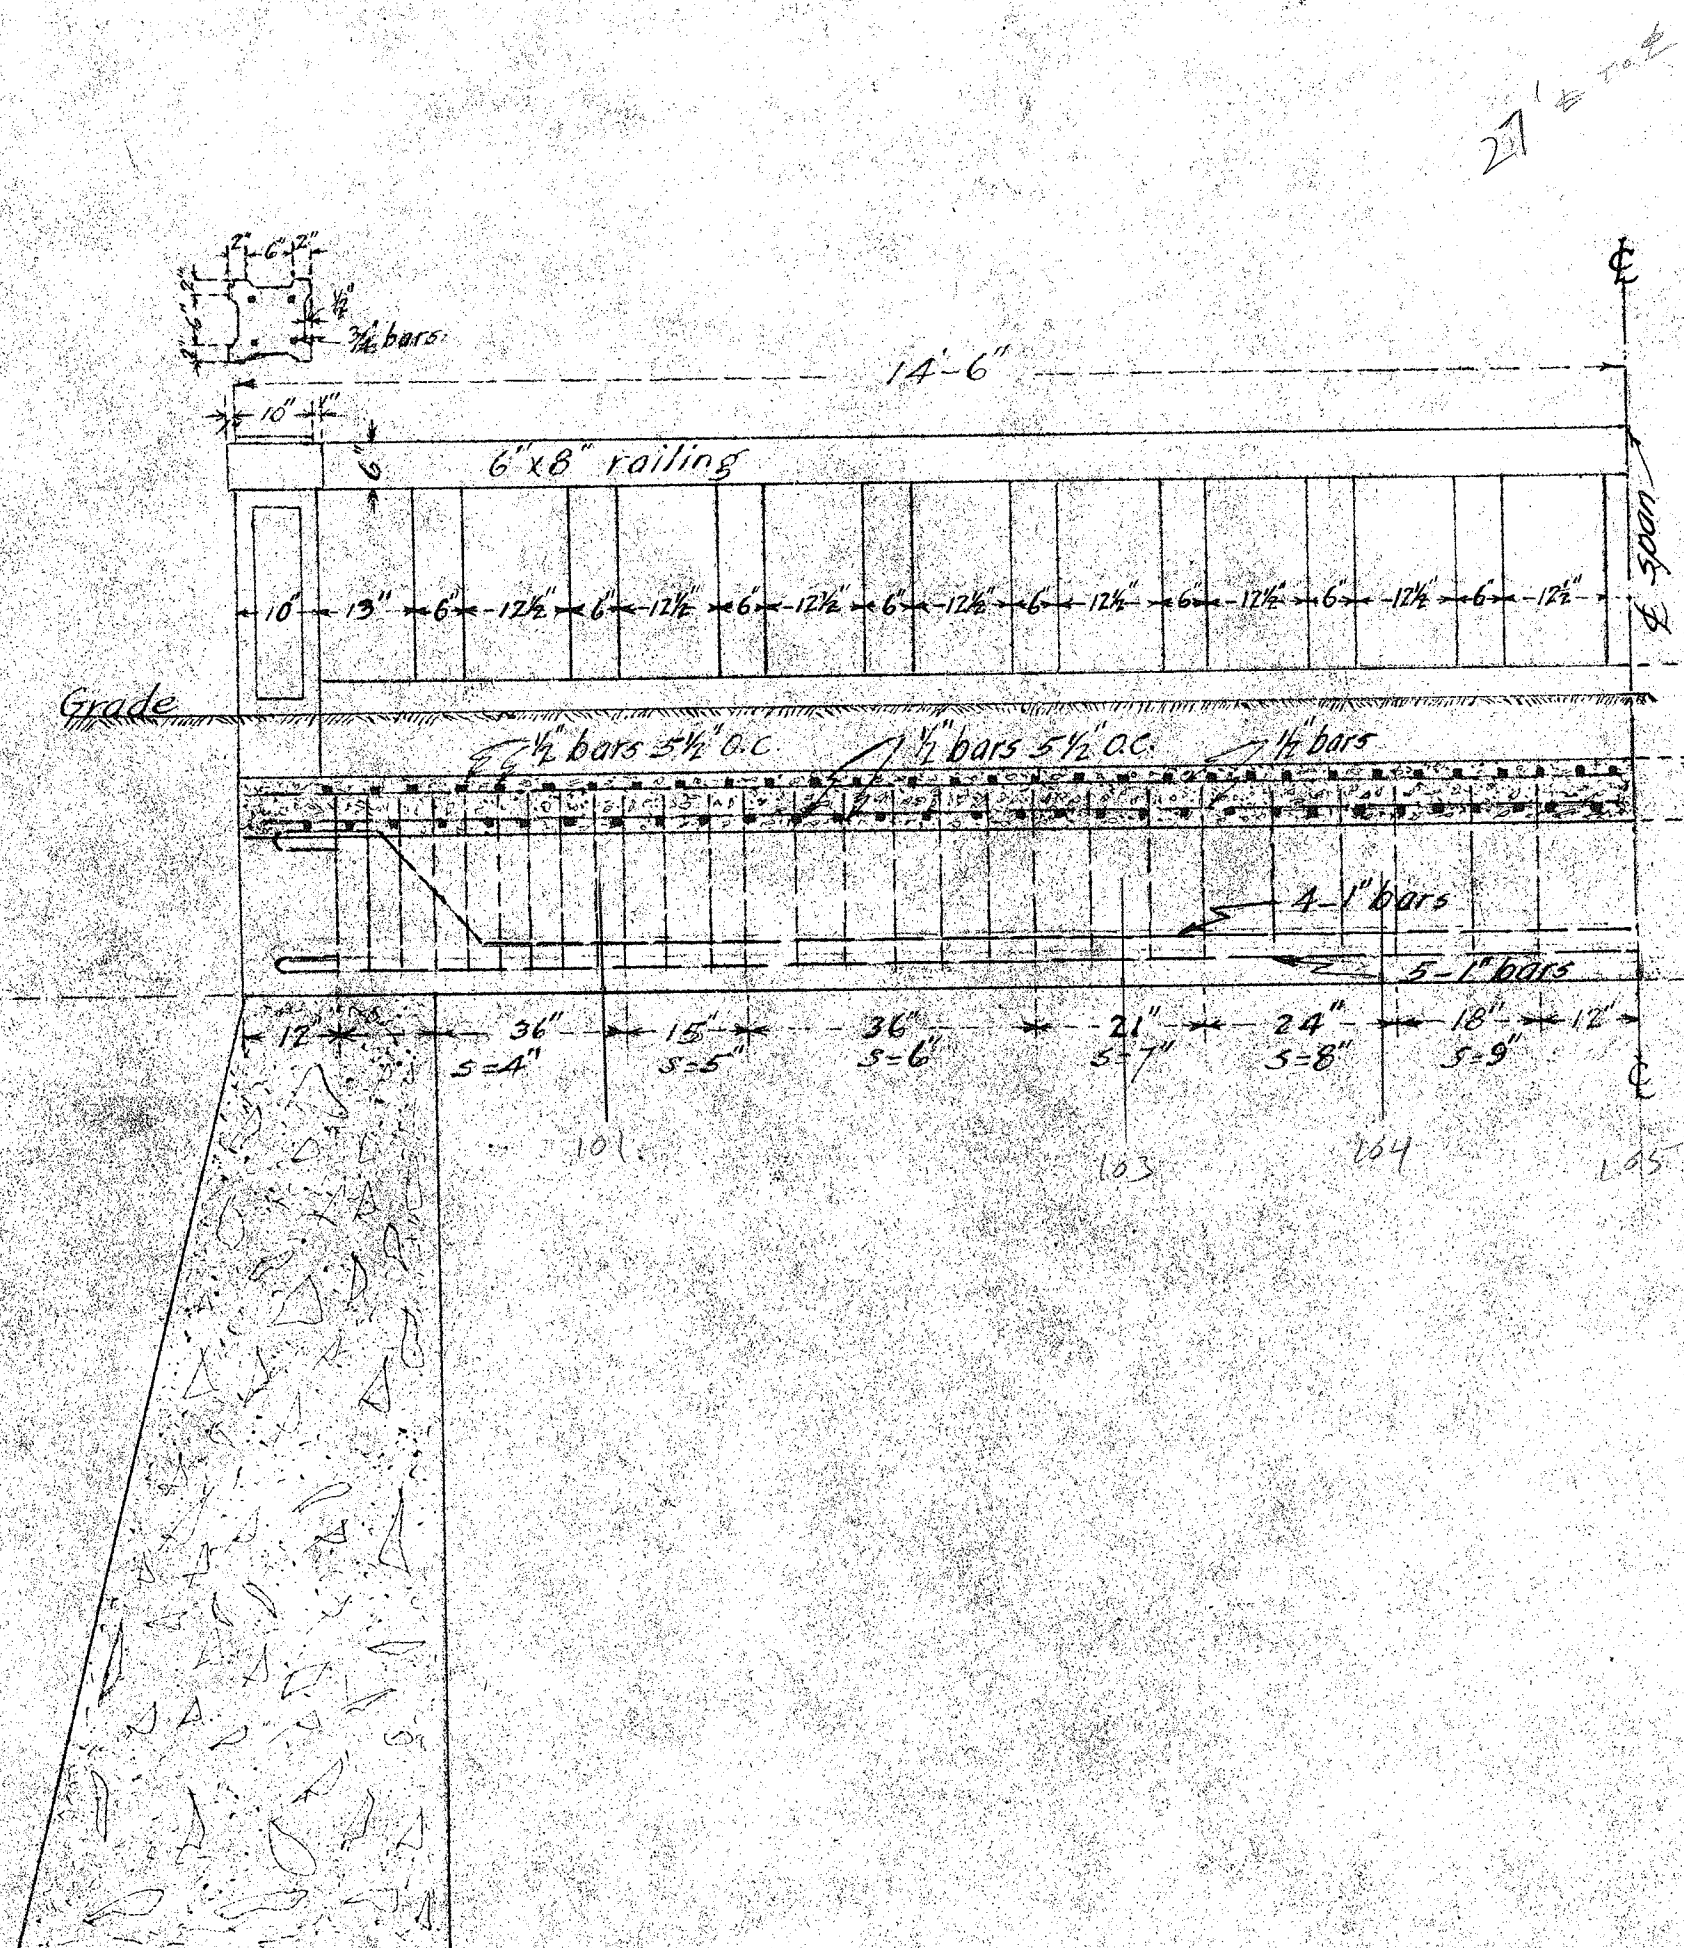


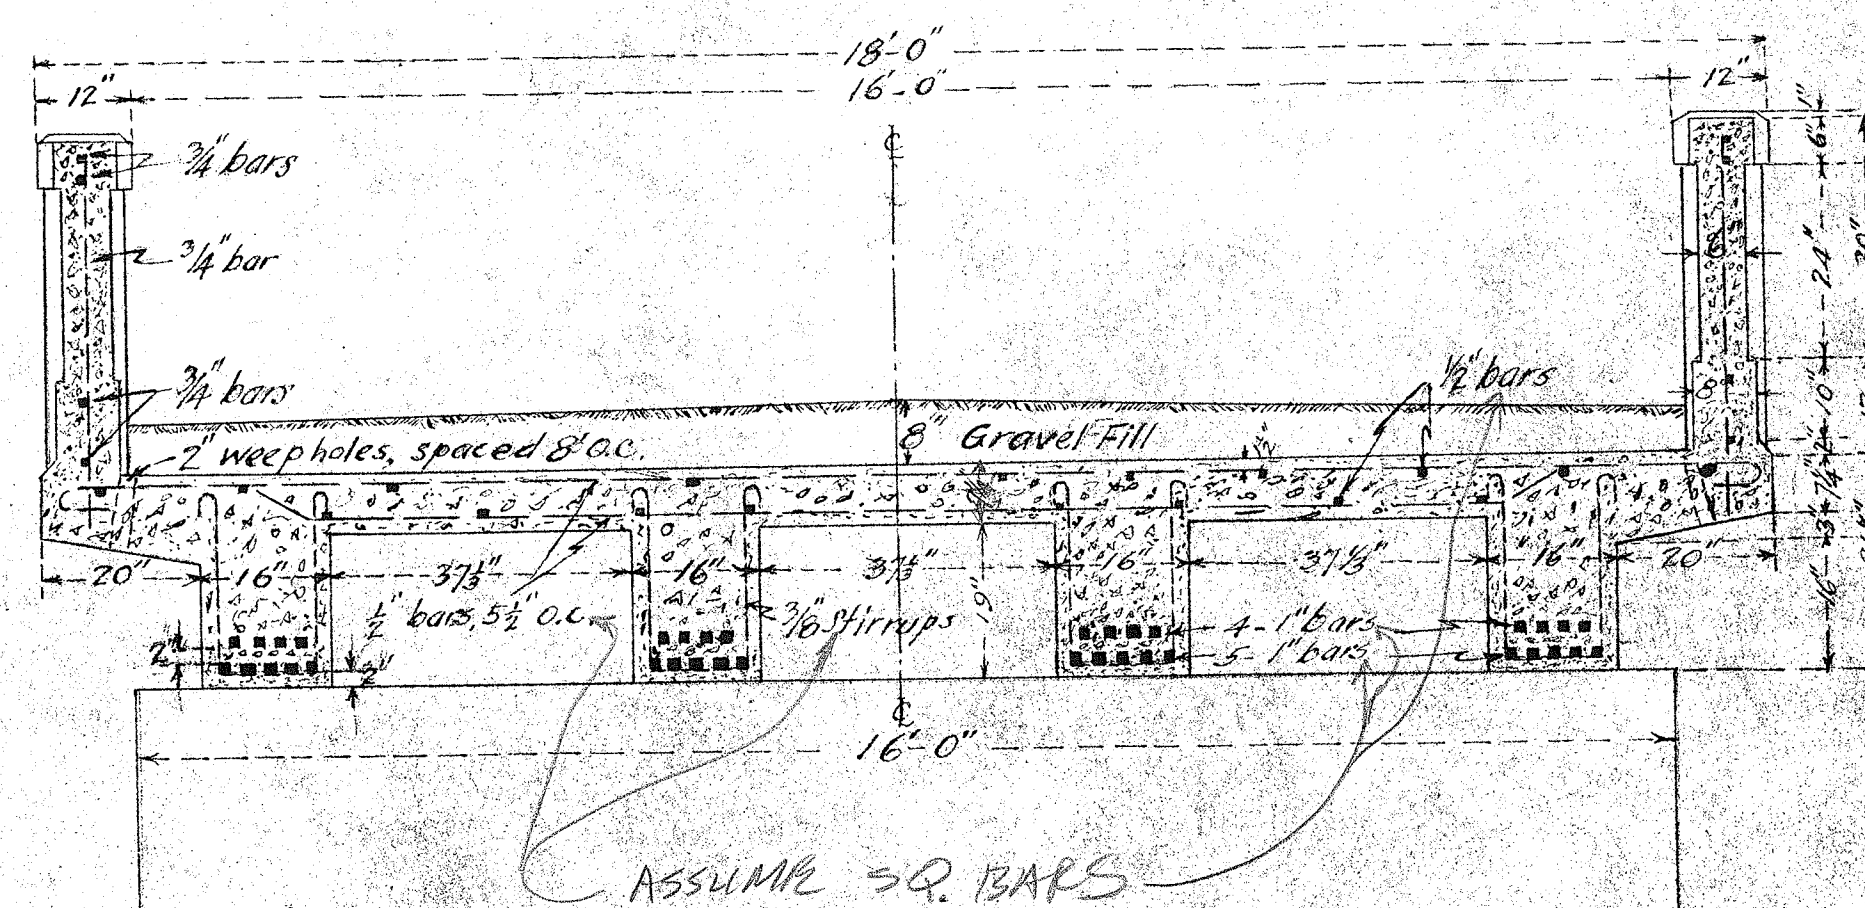

360031
KEAIKI BRIDGE
51.8 MILE
HANA, MAUI, T.H.
COUNTY ENGINEER'S OFFICE MAY 1925

3