




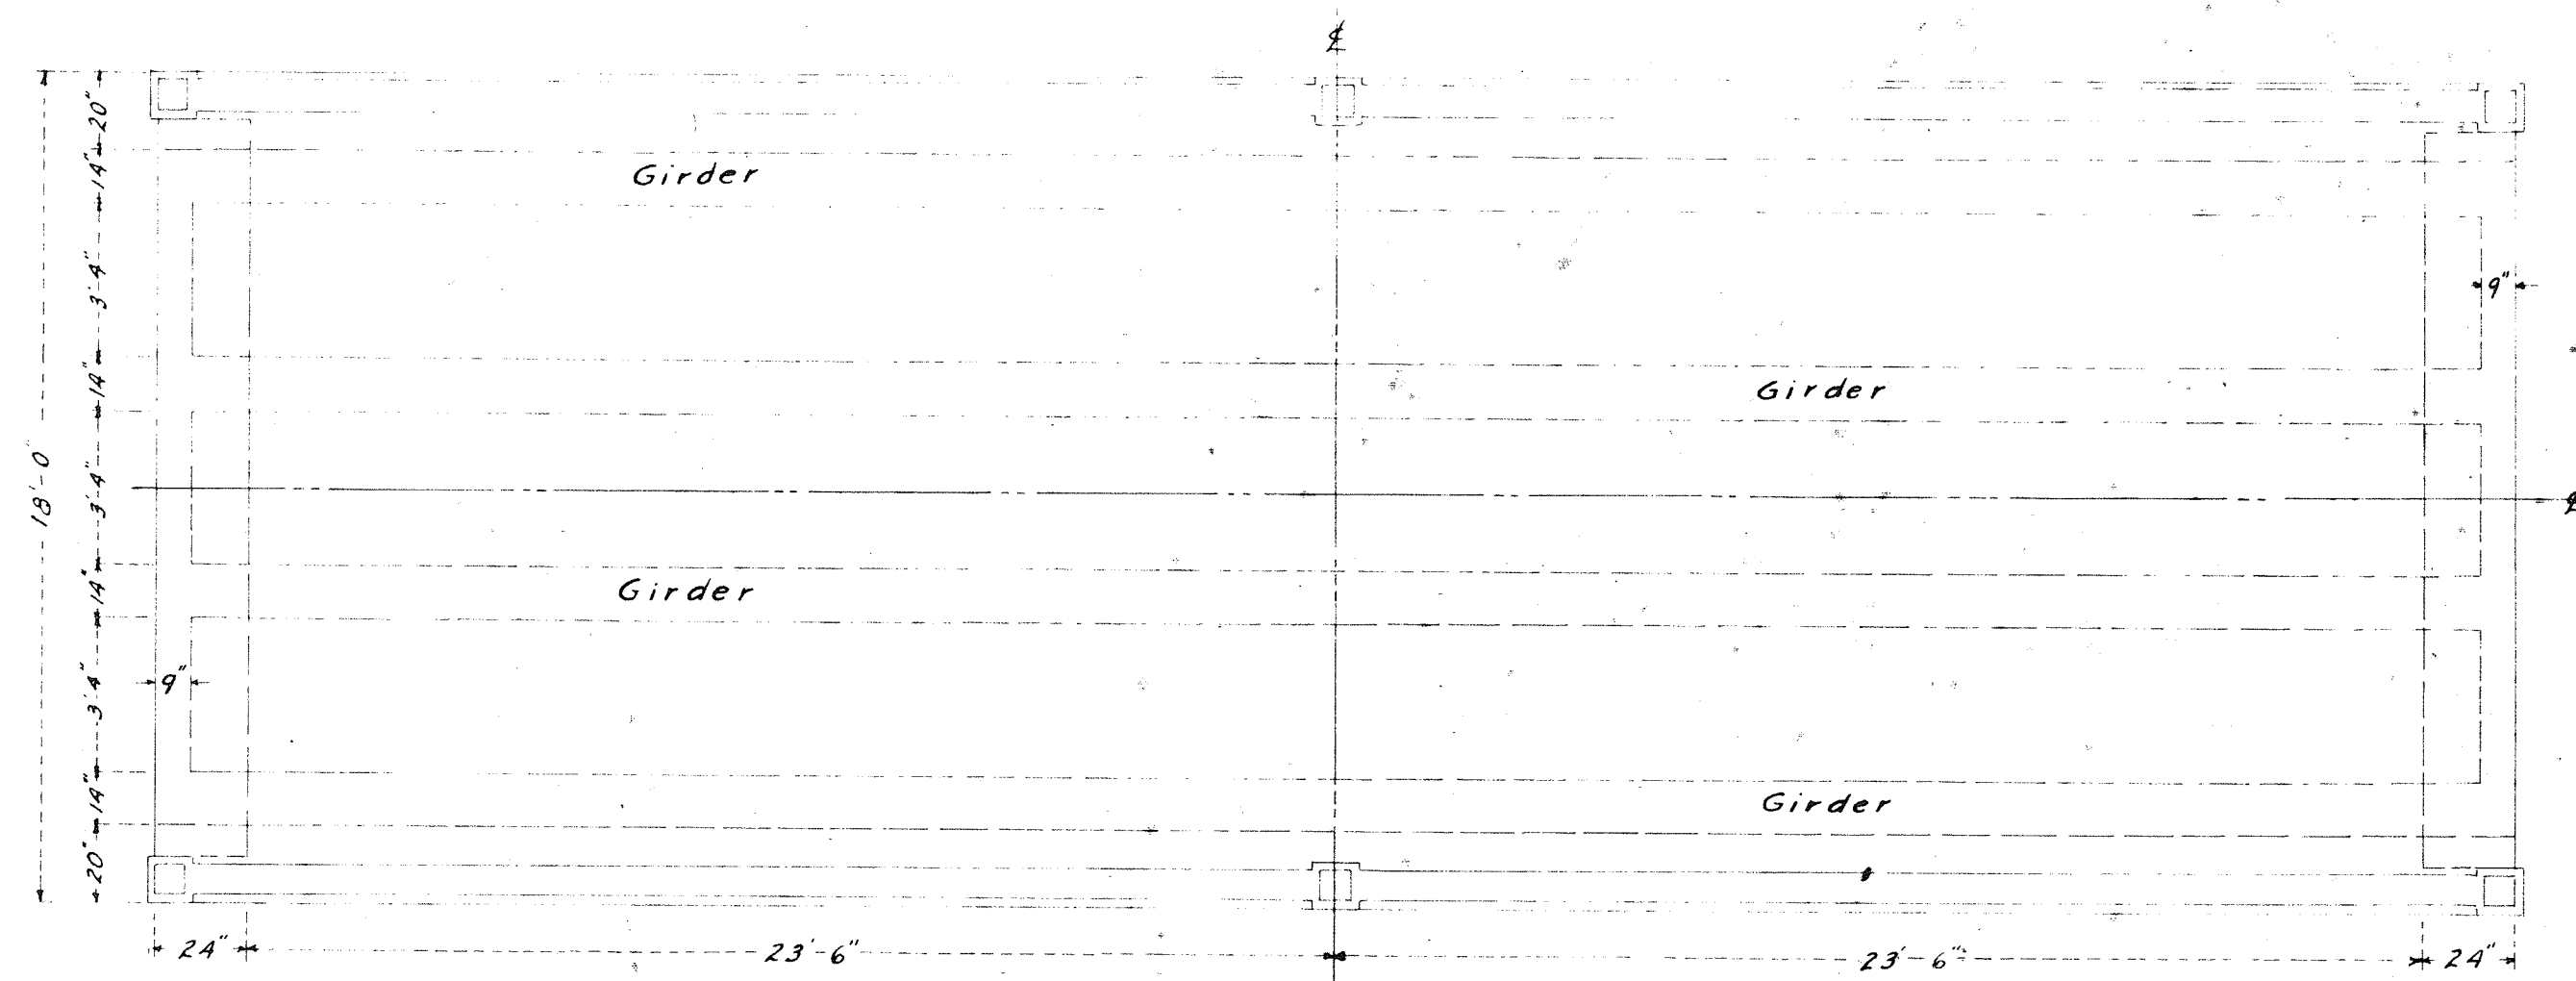


PLAN
Scale 1"=4'

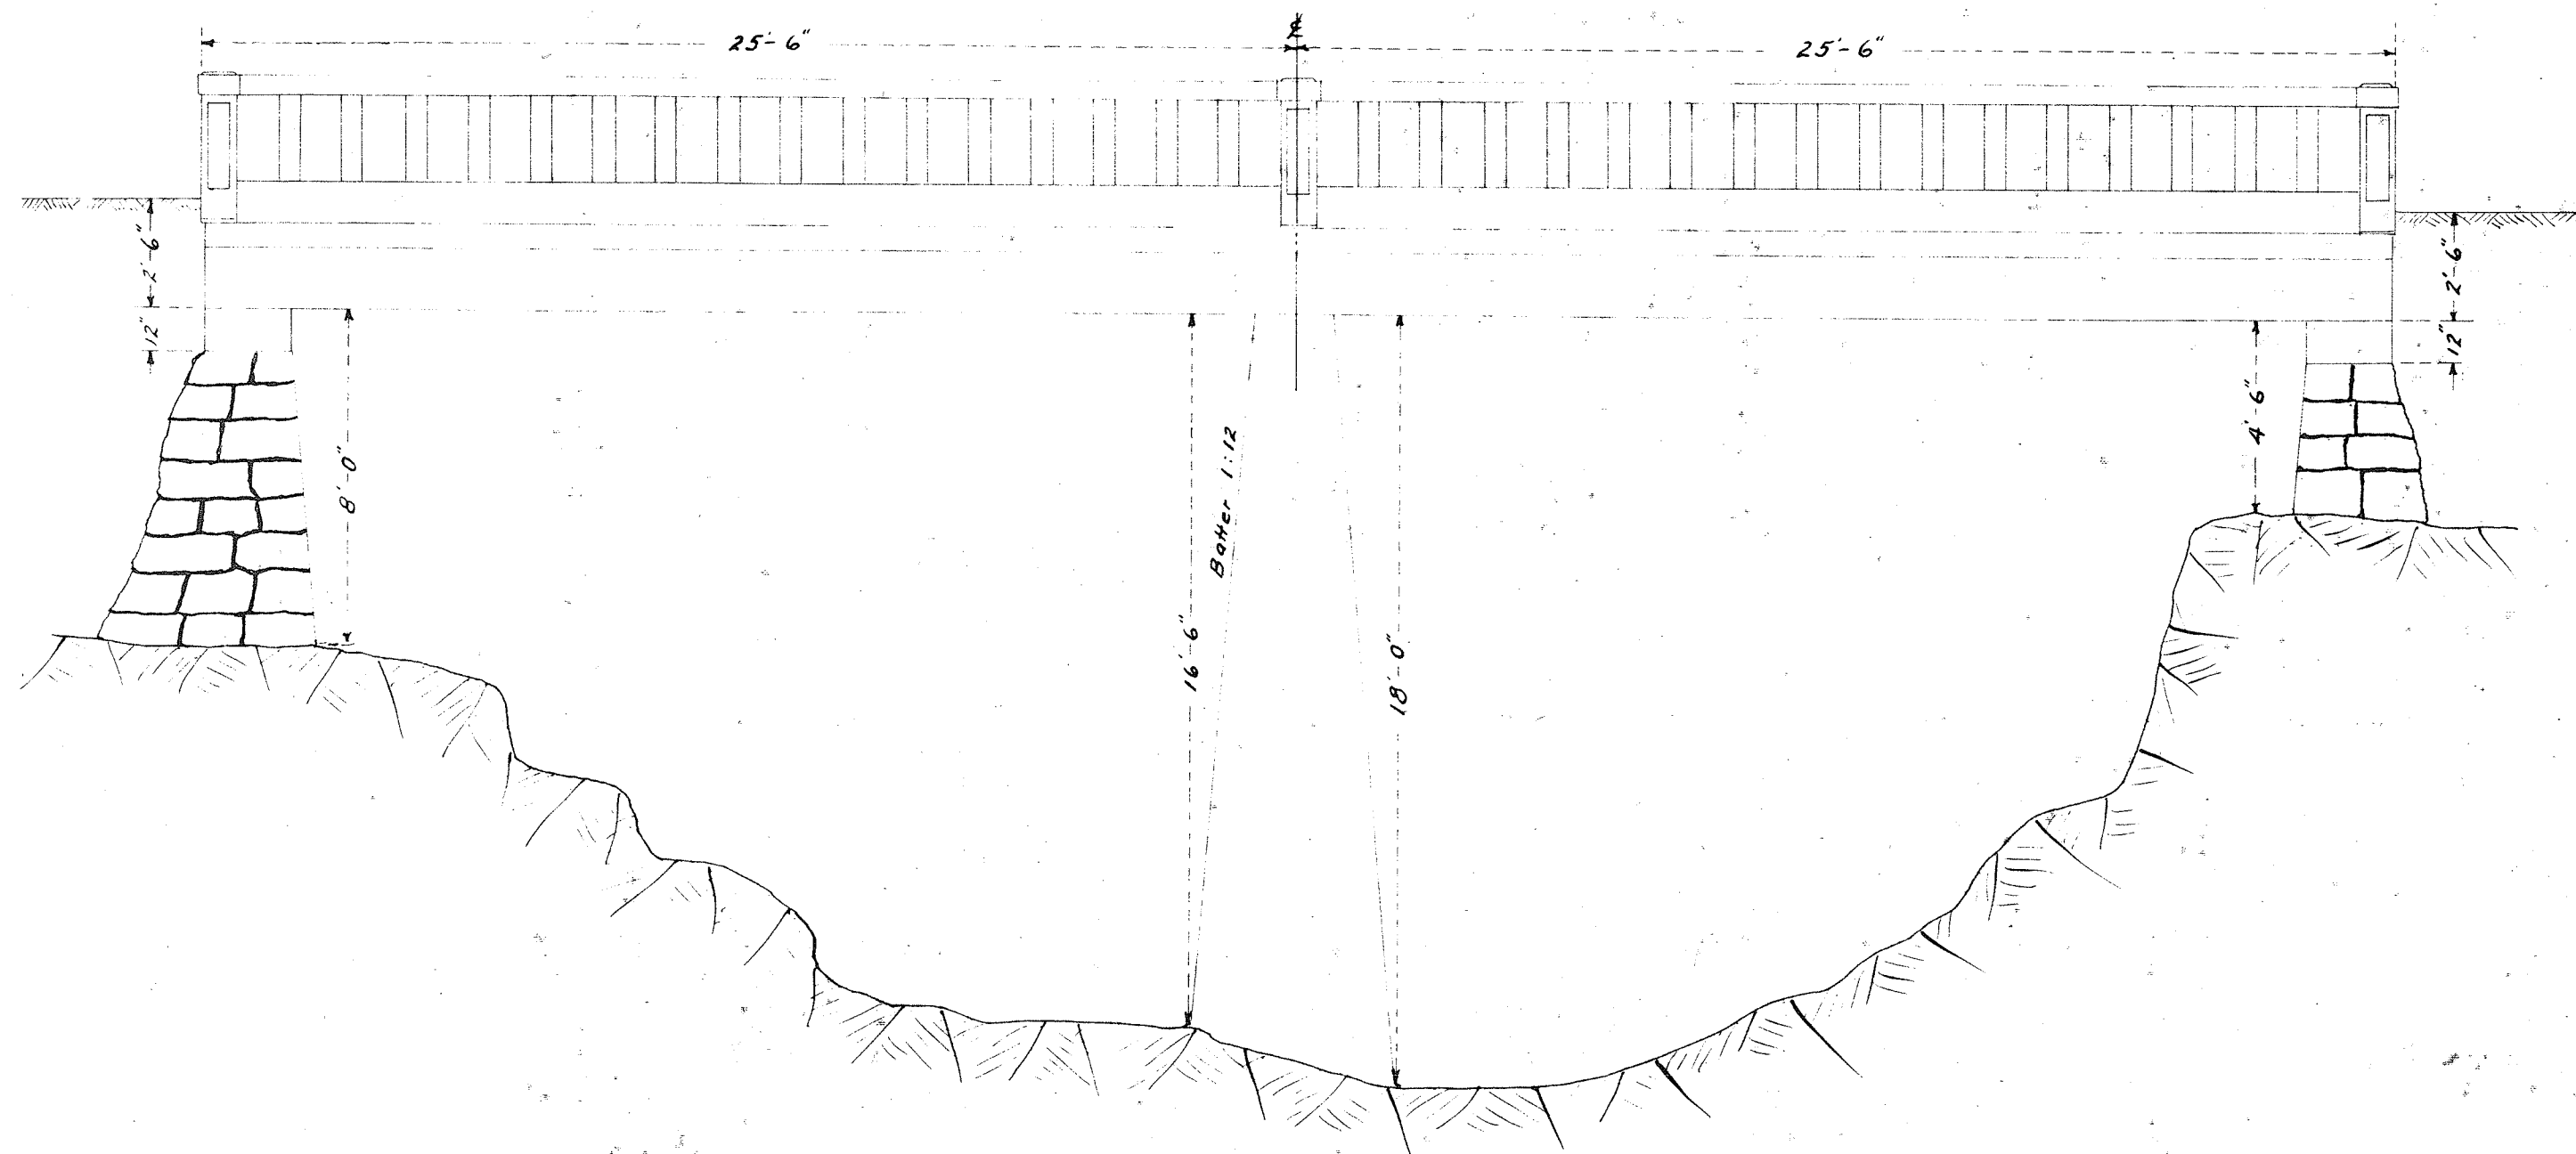


ELEVATION
Scale 1"=4'

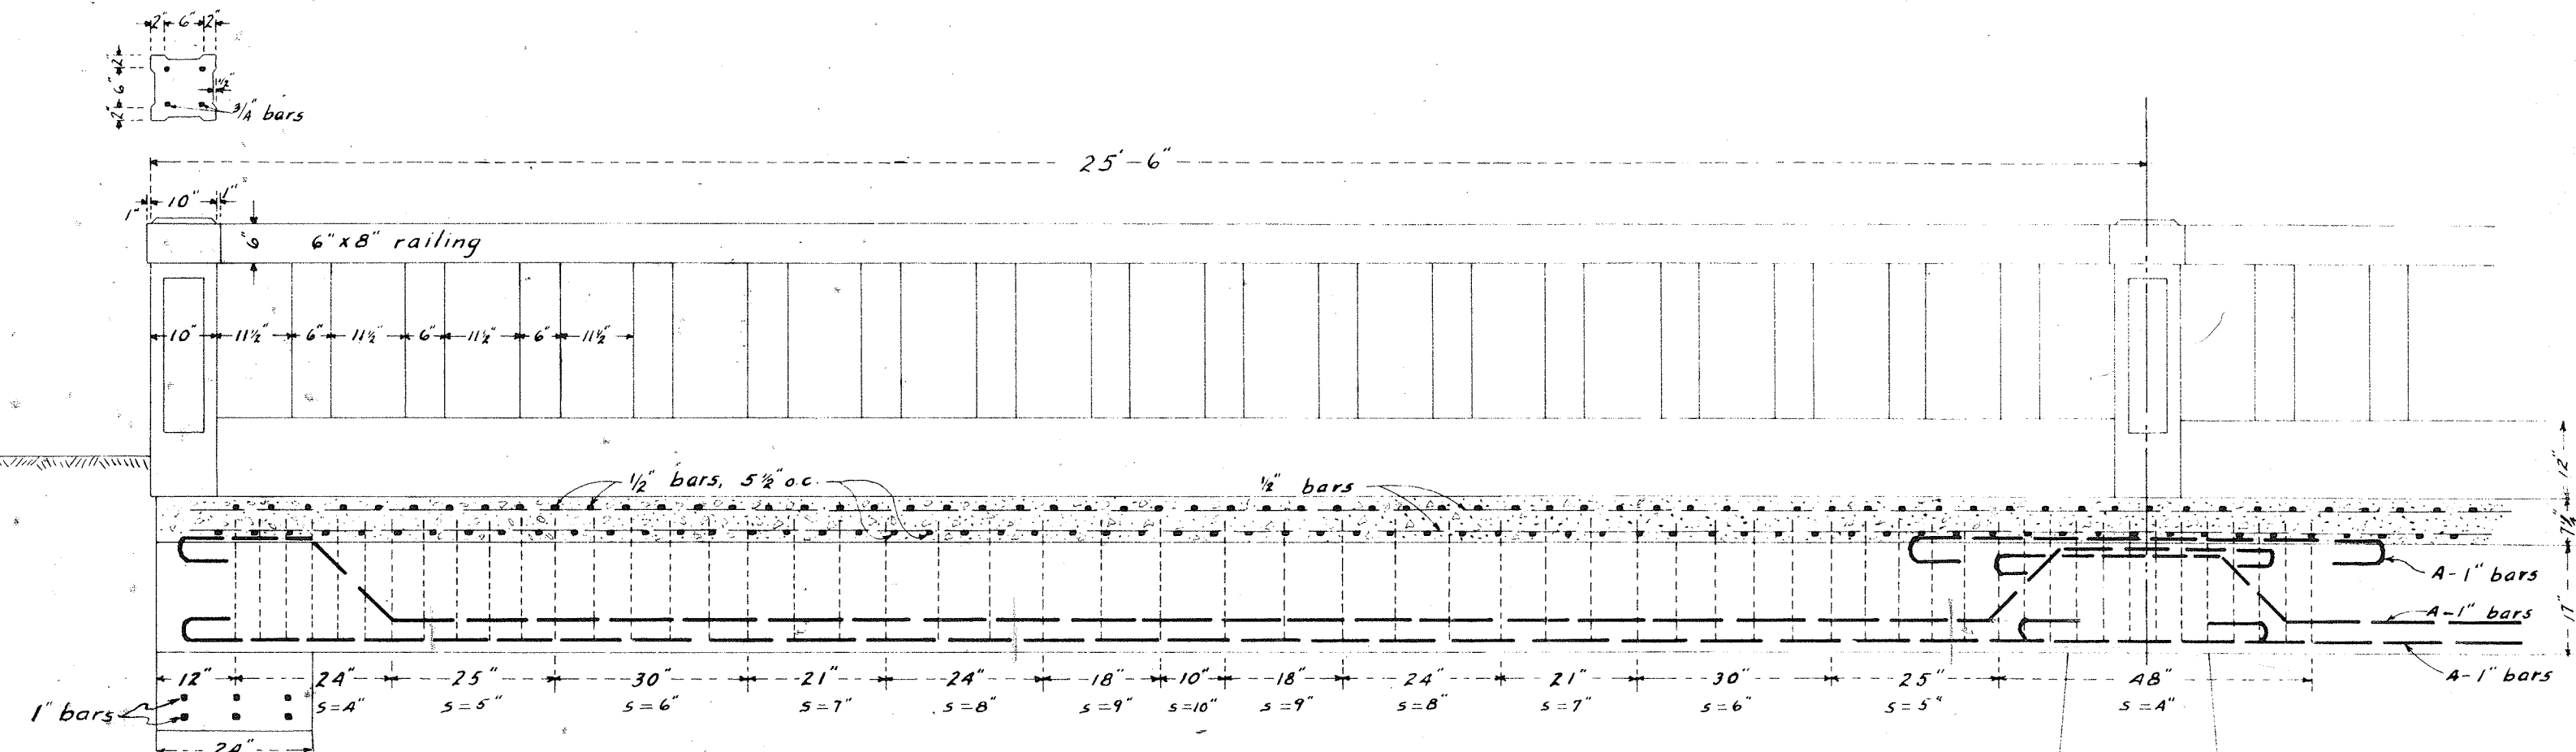

HALF LONGITUDINAL SECTION
Scale 1"=2'

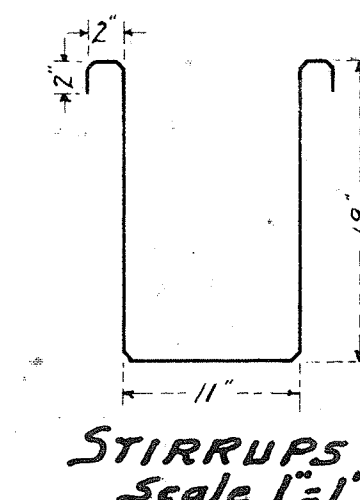

STIRRUPS
Scale 1"=1'

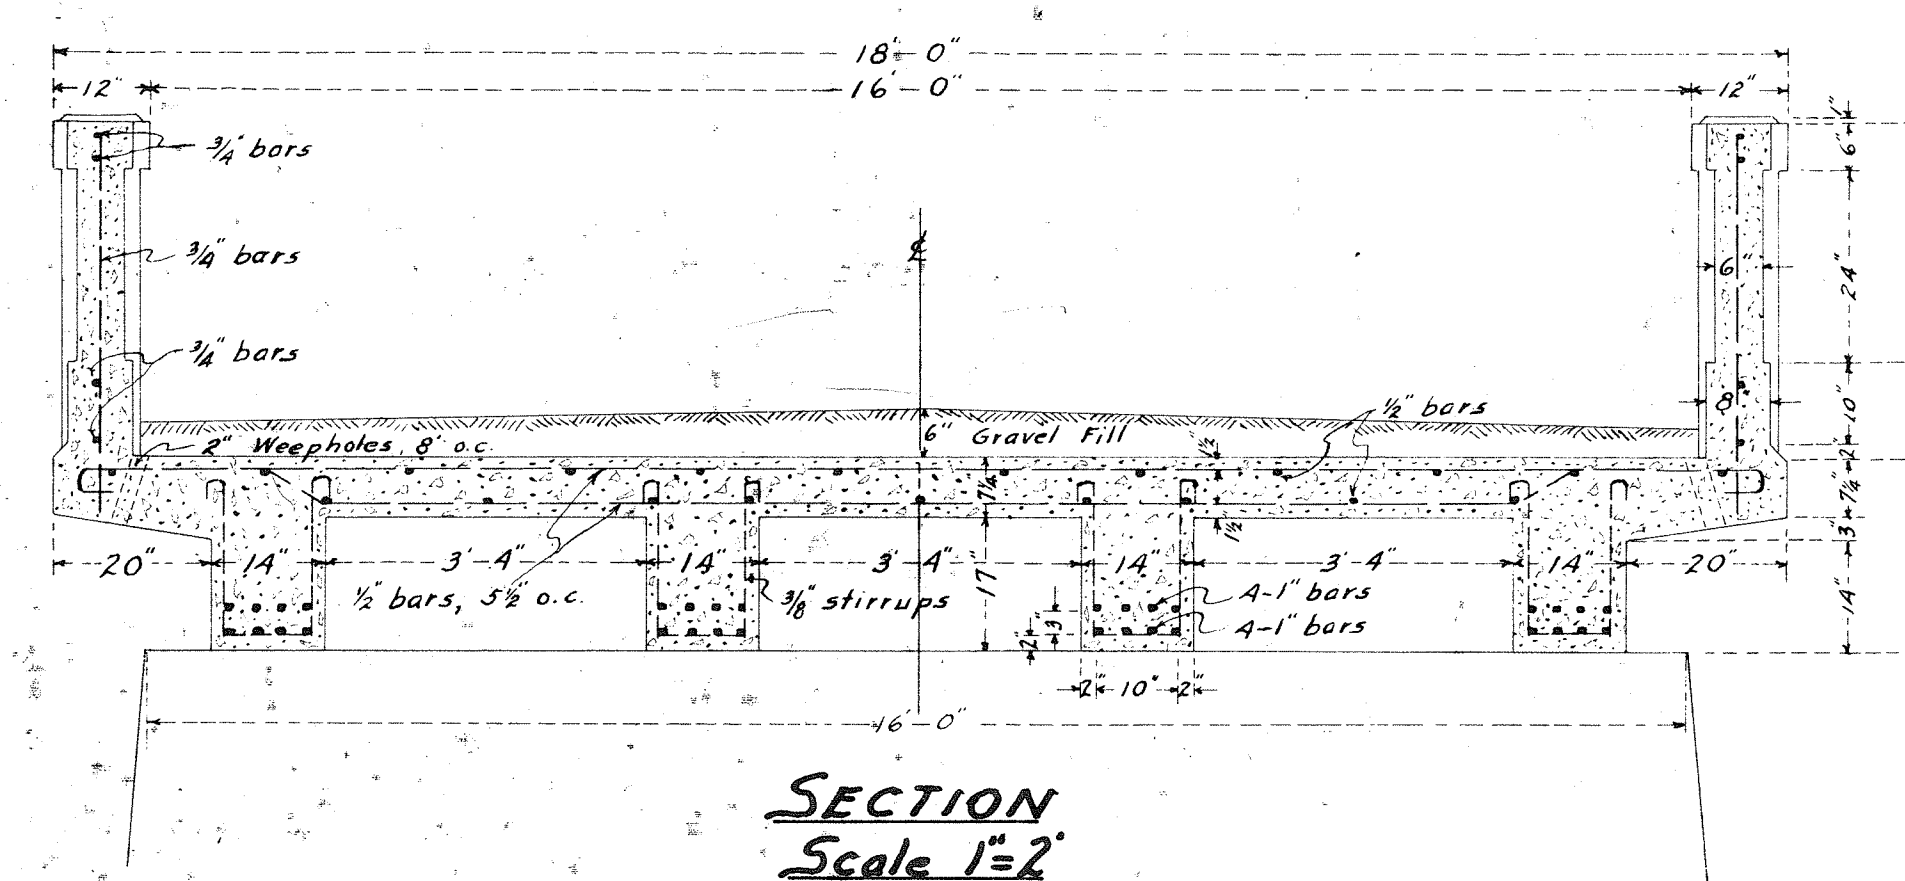

SECTION
Scale 1"=2'

STEEL SCHEDULE				
Quantity	Size	Length		
Girder Bars	64	1"	28'-0"	Bottom Chord
	16	1"	7'-0"	Top "
Slab Bars	204	3/8"	4'-10"	Stirrups
	220	1/2"	18'-6"	Transverse Bars
Railing Bars	42	1/2"	28'-0"	Longitudinal Bars
	16	3/4"	28'-0"	Horizontal Bars
Abutment Beam	96	3/4"	4'-0"	Vertical Bars
	12	1"	16'-0"	Bottom Chord

CONCRETE YARDAGE
1:2:4 Concrete — 42.1 cu. yds.

THIS BRIDGE NOT BUILT?

HELELEI KEOKA

#360035

HELELEI KEOKA BRIDGE

52.65 MILE

HANA, MAUI, T.H.

County Engineer's Office

By A.F.L. Drawn by F.K. February, 1925

Lanikele Stream Bridge
009 00360 05 02779
Hana Highway (Route 360)
Milepost 27.76