
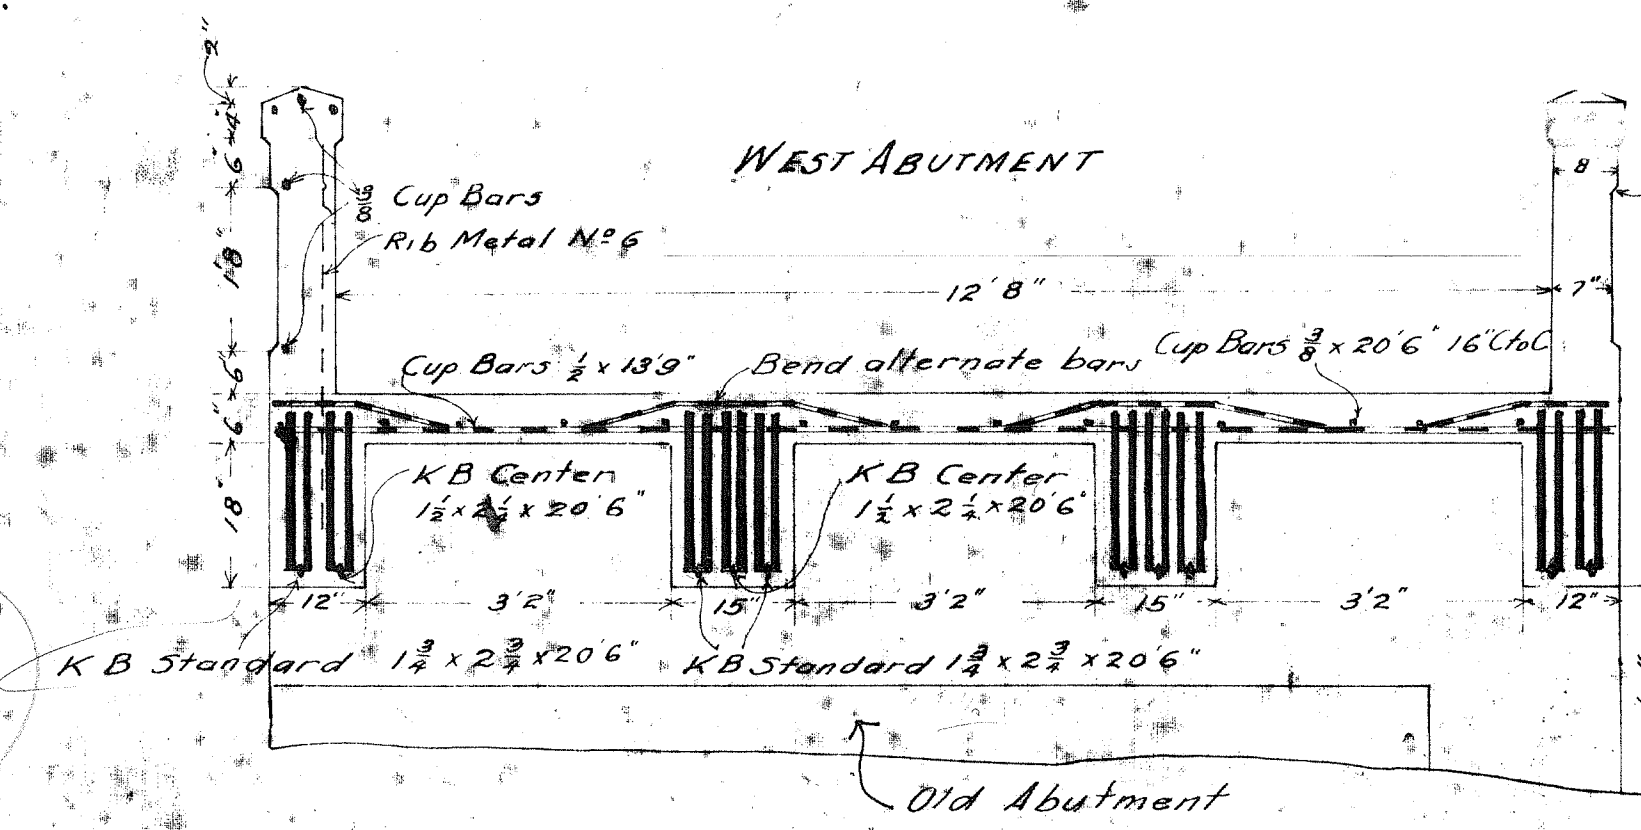


PUAKEA BRIDGE
STATION 389+78
1/Inch=2 Ft.

Unknown 2
Paakea Stream

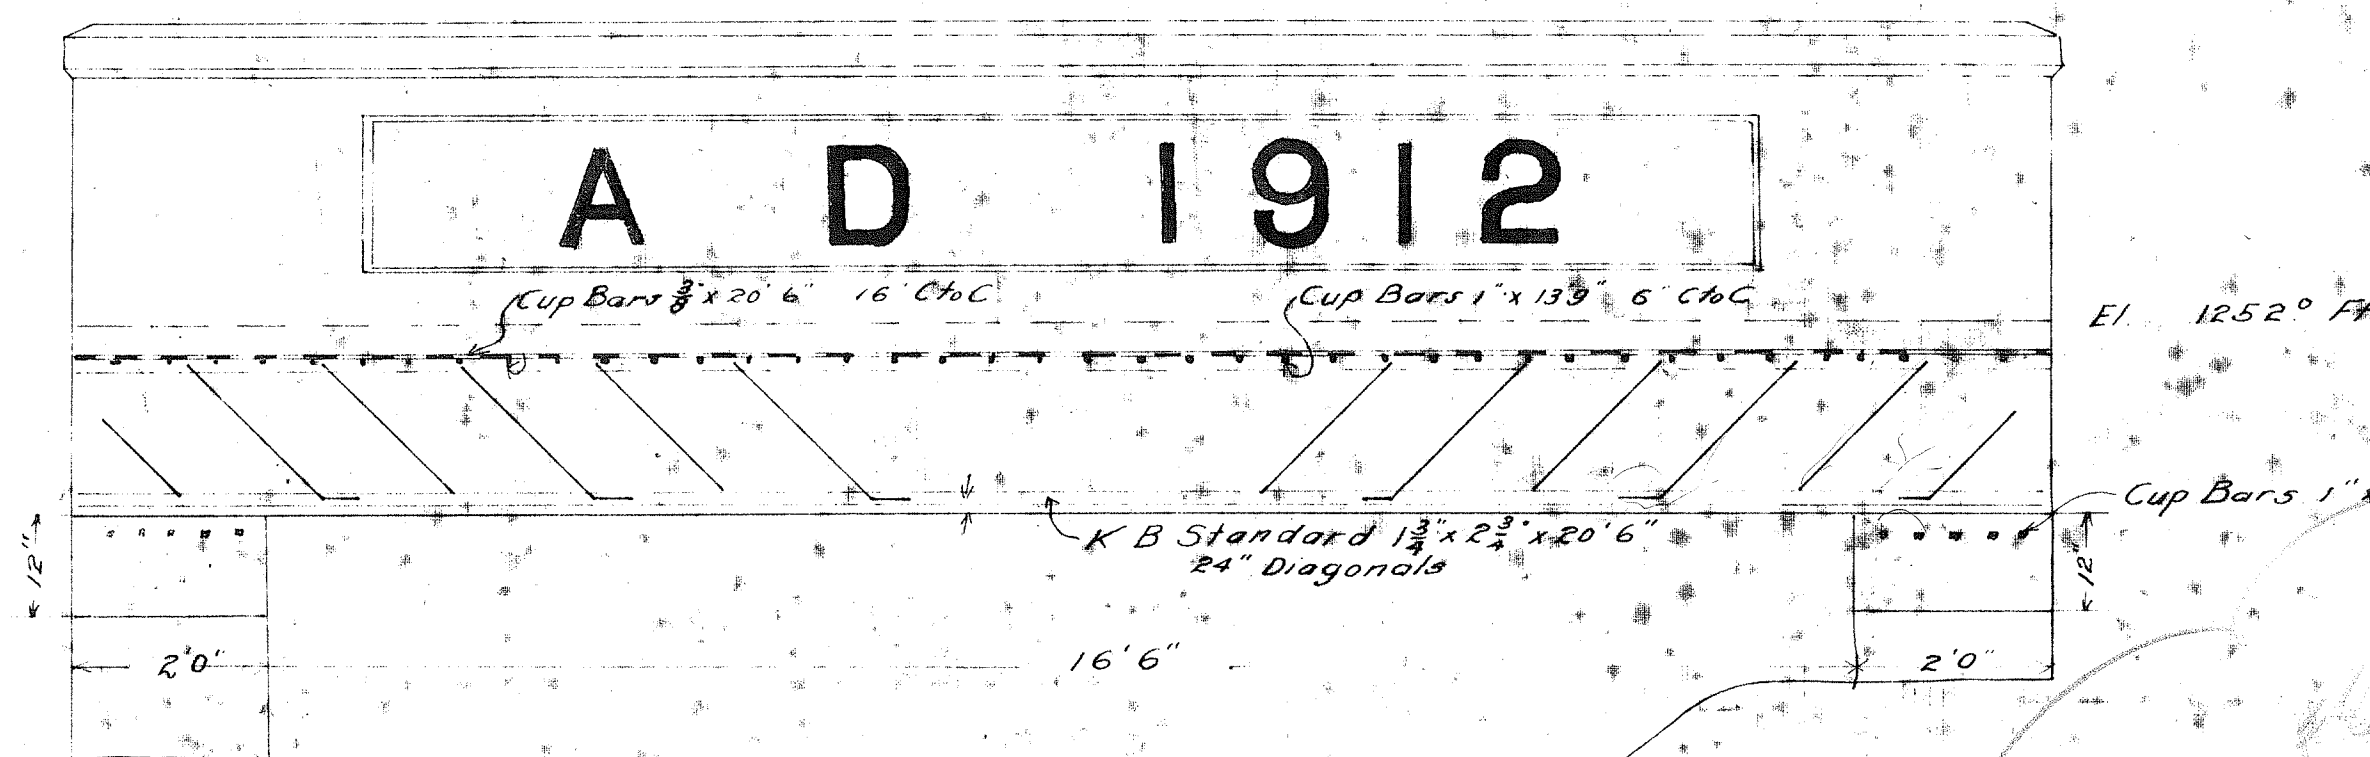

MAUI LOAN FUND COMMISSION
TERRITORY OF HAWAII.

Approved *W. J. J. J. J.*
Vice Chairman.

PUAKEA (EAST) BRIDGE
STA. 390+23
1/Inch=2 Ft.

Unknown 3
Paakea Stream
#360019 ✓
Completed

