




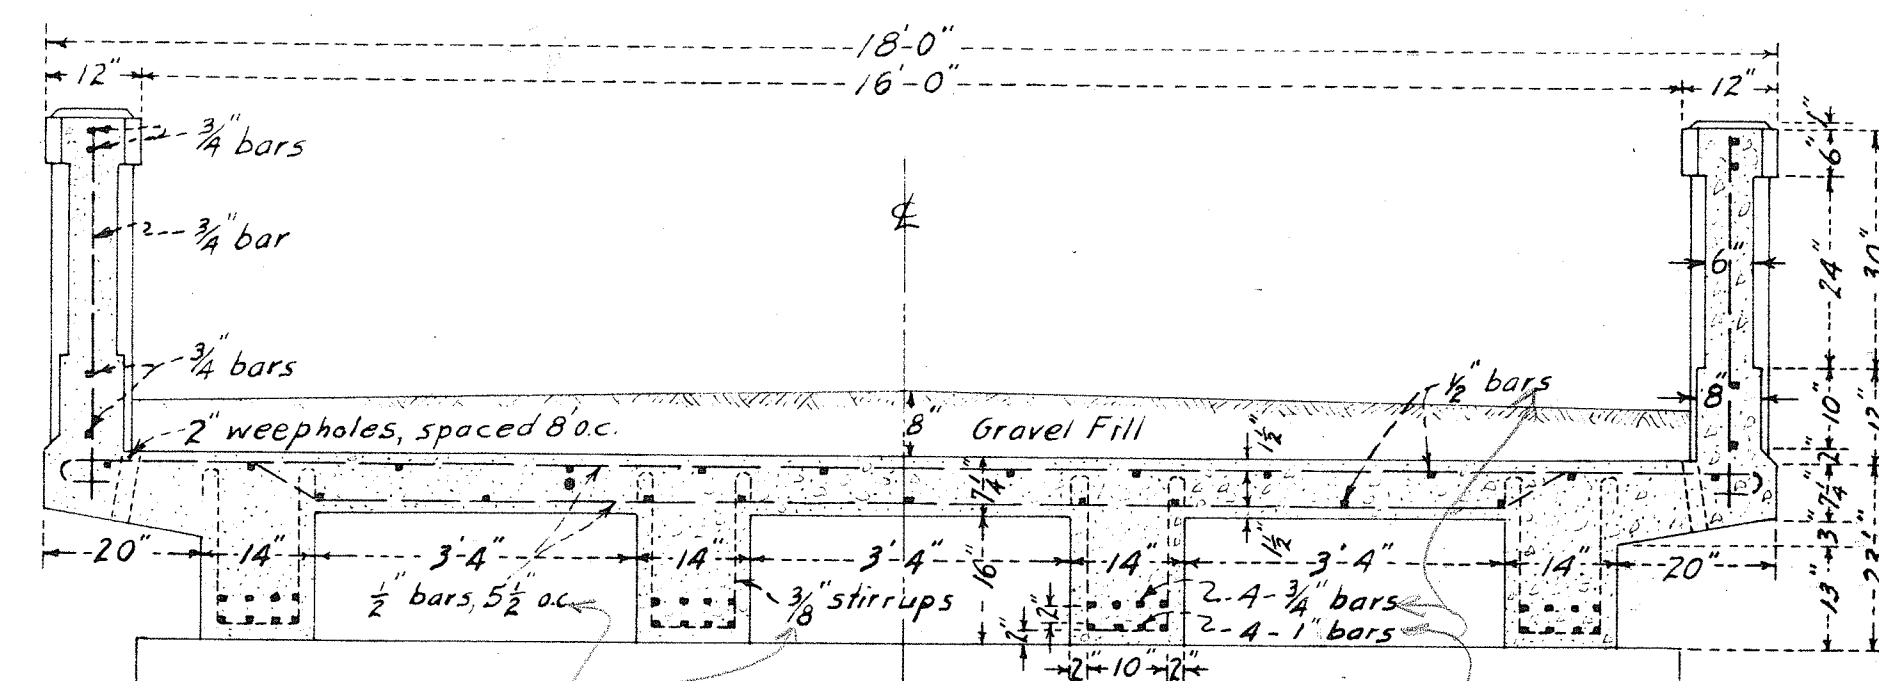


SECTION
Scale: 1"=2'

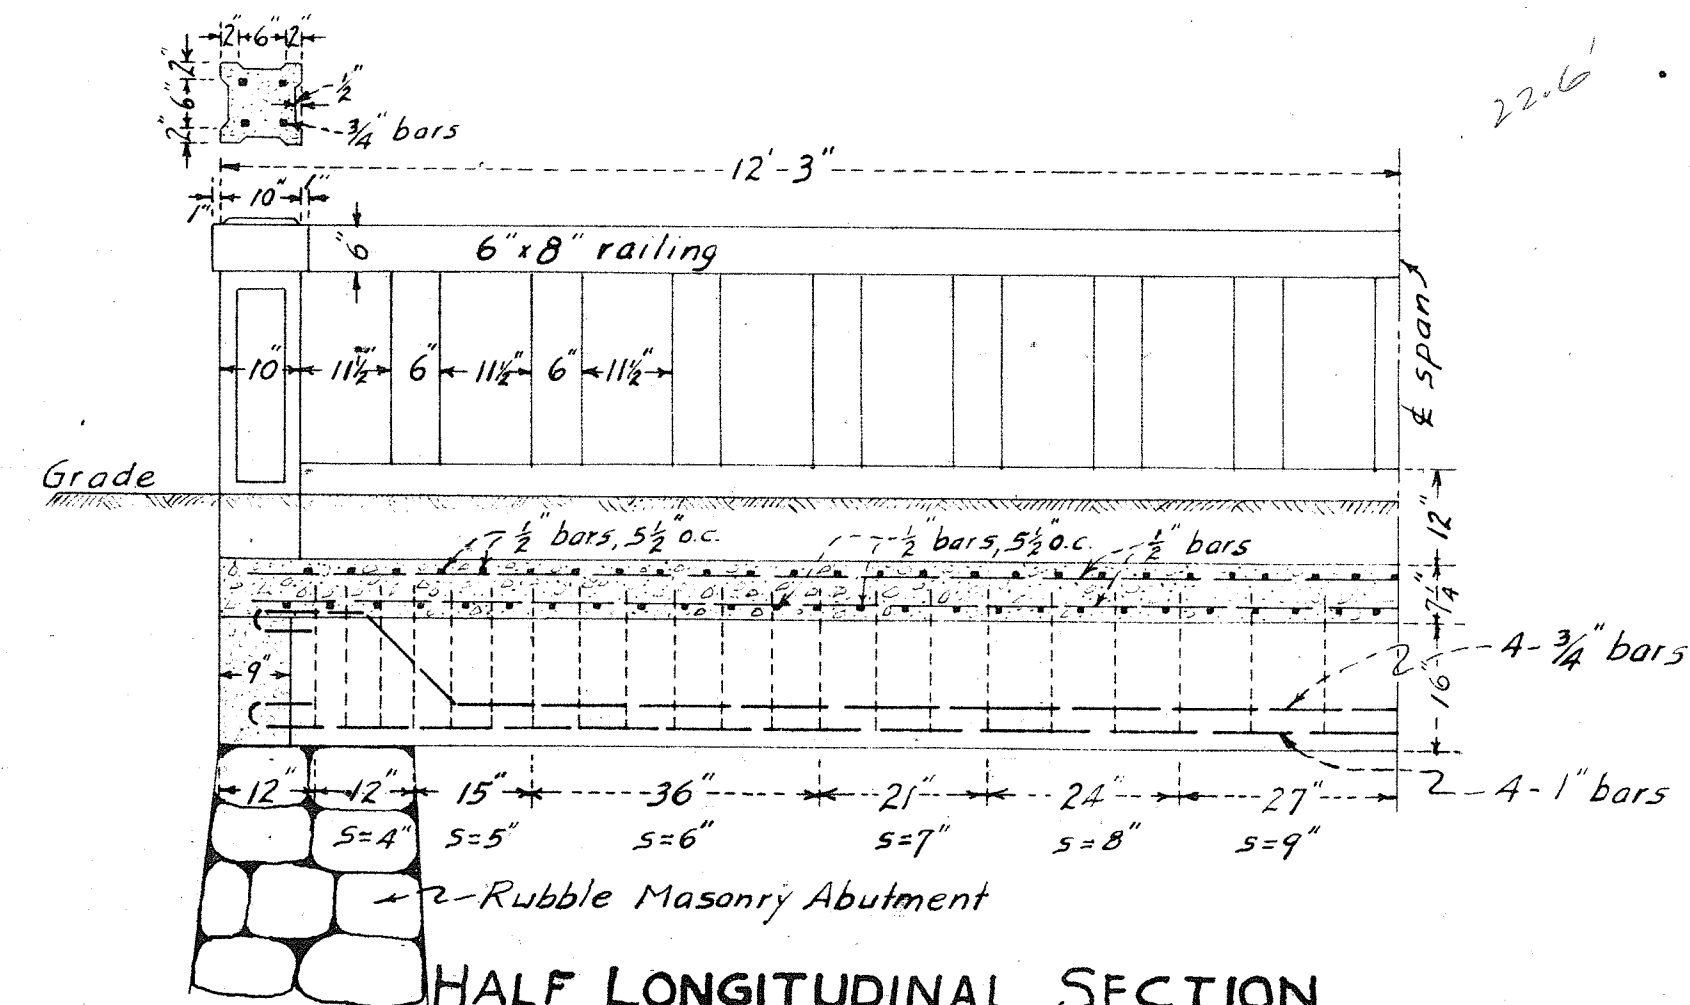

HALF LONGITUDINAL SECTION
Scale: 1"=2'

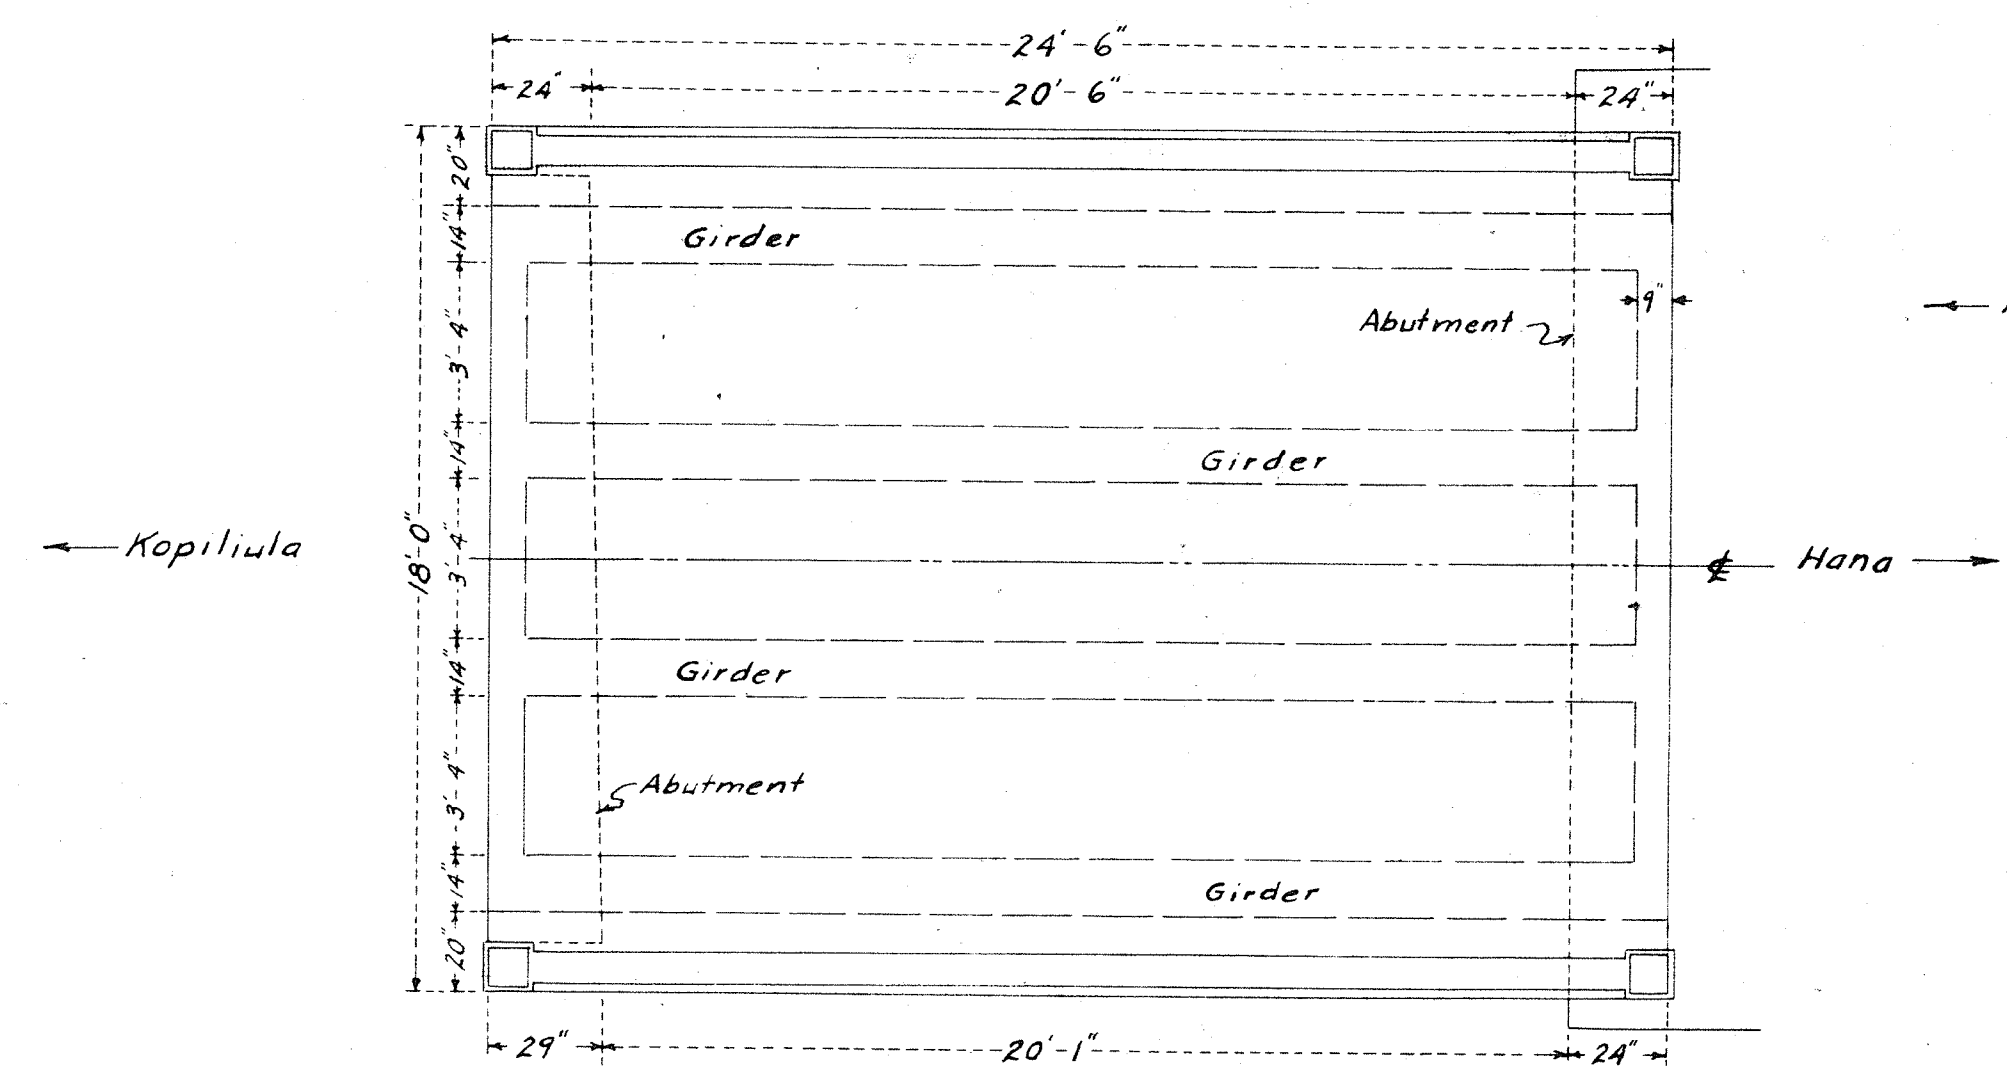

PLAN
Scale 1"=4'

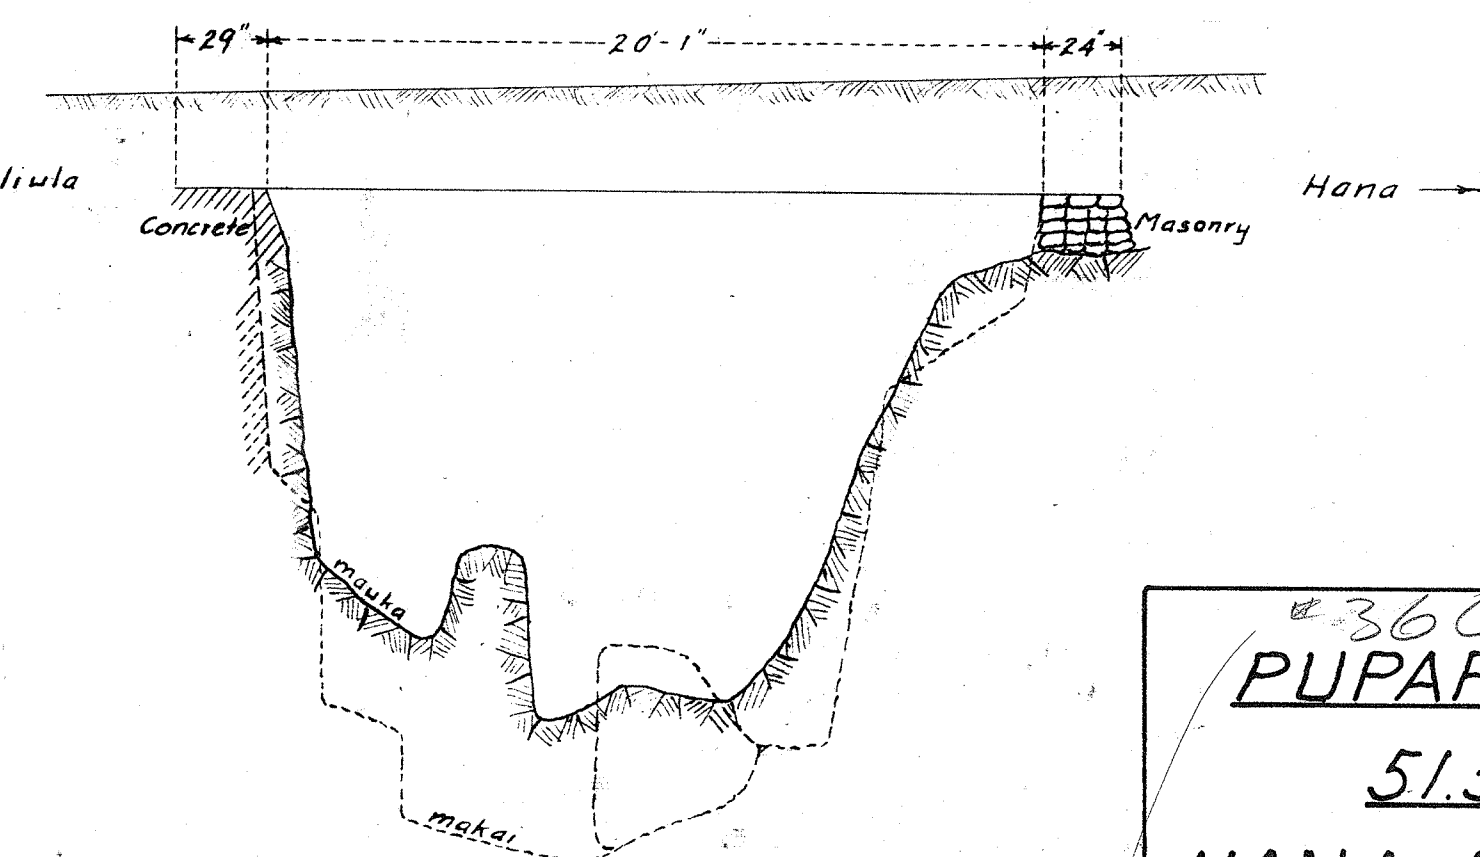

PROFILES
Scale 1"=8'

STEEL SCHEDULE			
Quantity	Size	Length	
Girder bars	16	1/2	25'-0" Bottom Chord
	16	3/4	26'-0" do
	172	3/8	4'-8" Stirrups
Slab bars	104	1/2	18'-6" Transverse
	21	1/2	24'-0" Longitudinal
Reinforcing bars	8	3/4	24'-0" Horizontal
	46	3/8	4'-0" Vertical
CONCRETE YARDAGE			
1:2:4 concrete	19.5	cu yds.	

#360029 ✓
PUPAPE BRIDGE
51.3 MILES
HANA DISTRICT MAUI, I.H.
COUNTY ENGINEER'S OFFICE
AUGUST, 1925

NOTE SAME AS #360027 FOR RATING PURPOSES
 RATING ON SAME COMPUTER RUN