




DECK PLAN
SCALE 1/4" = 12'

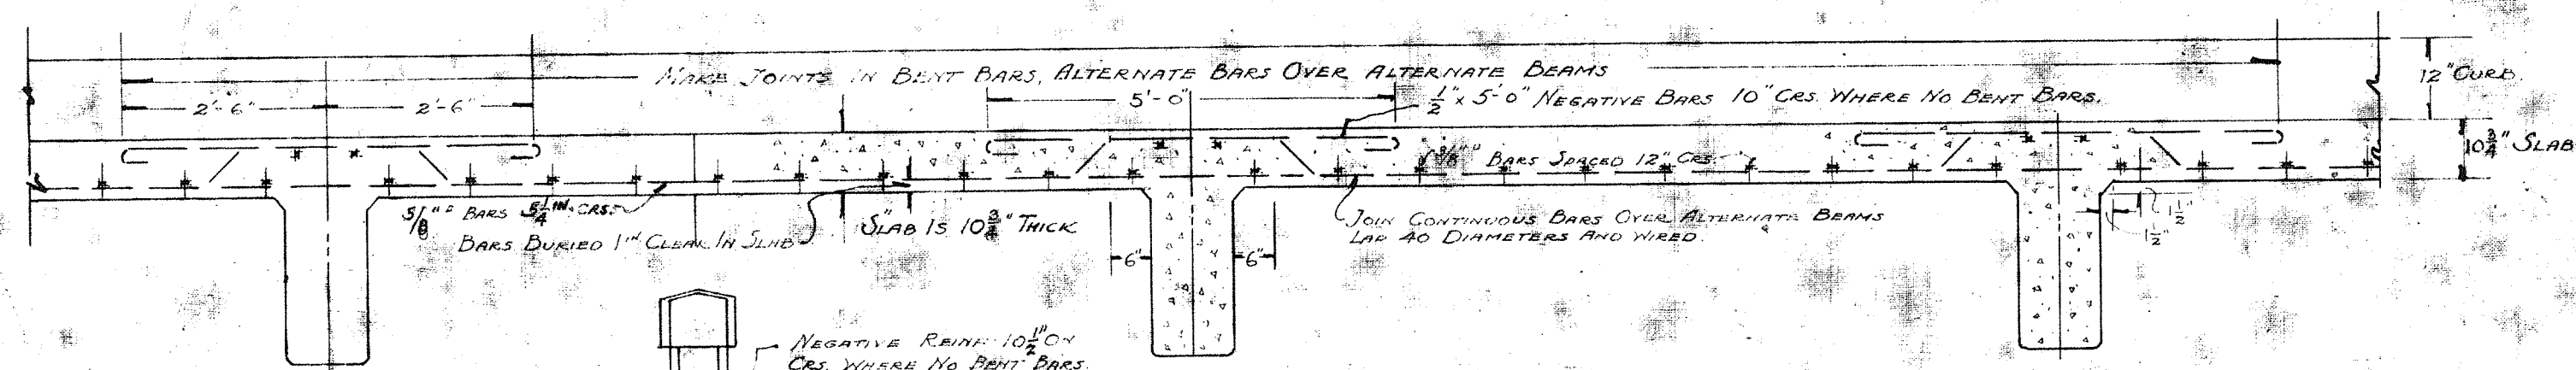

LONGITUDINAL SECTION SHOWING
DECK STEEL
SCALE 1/2" = 12'

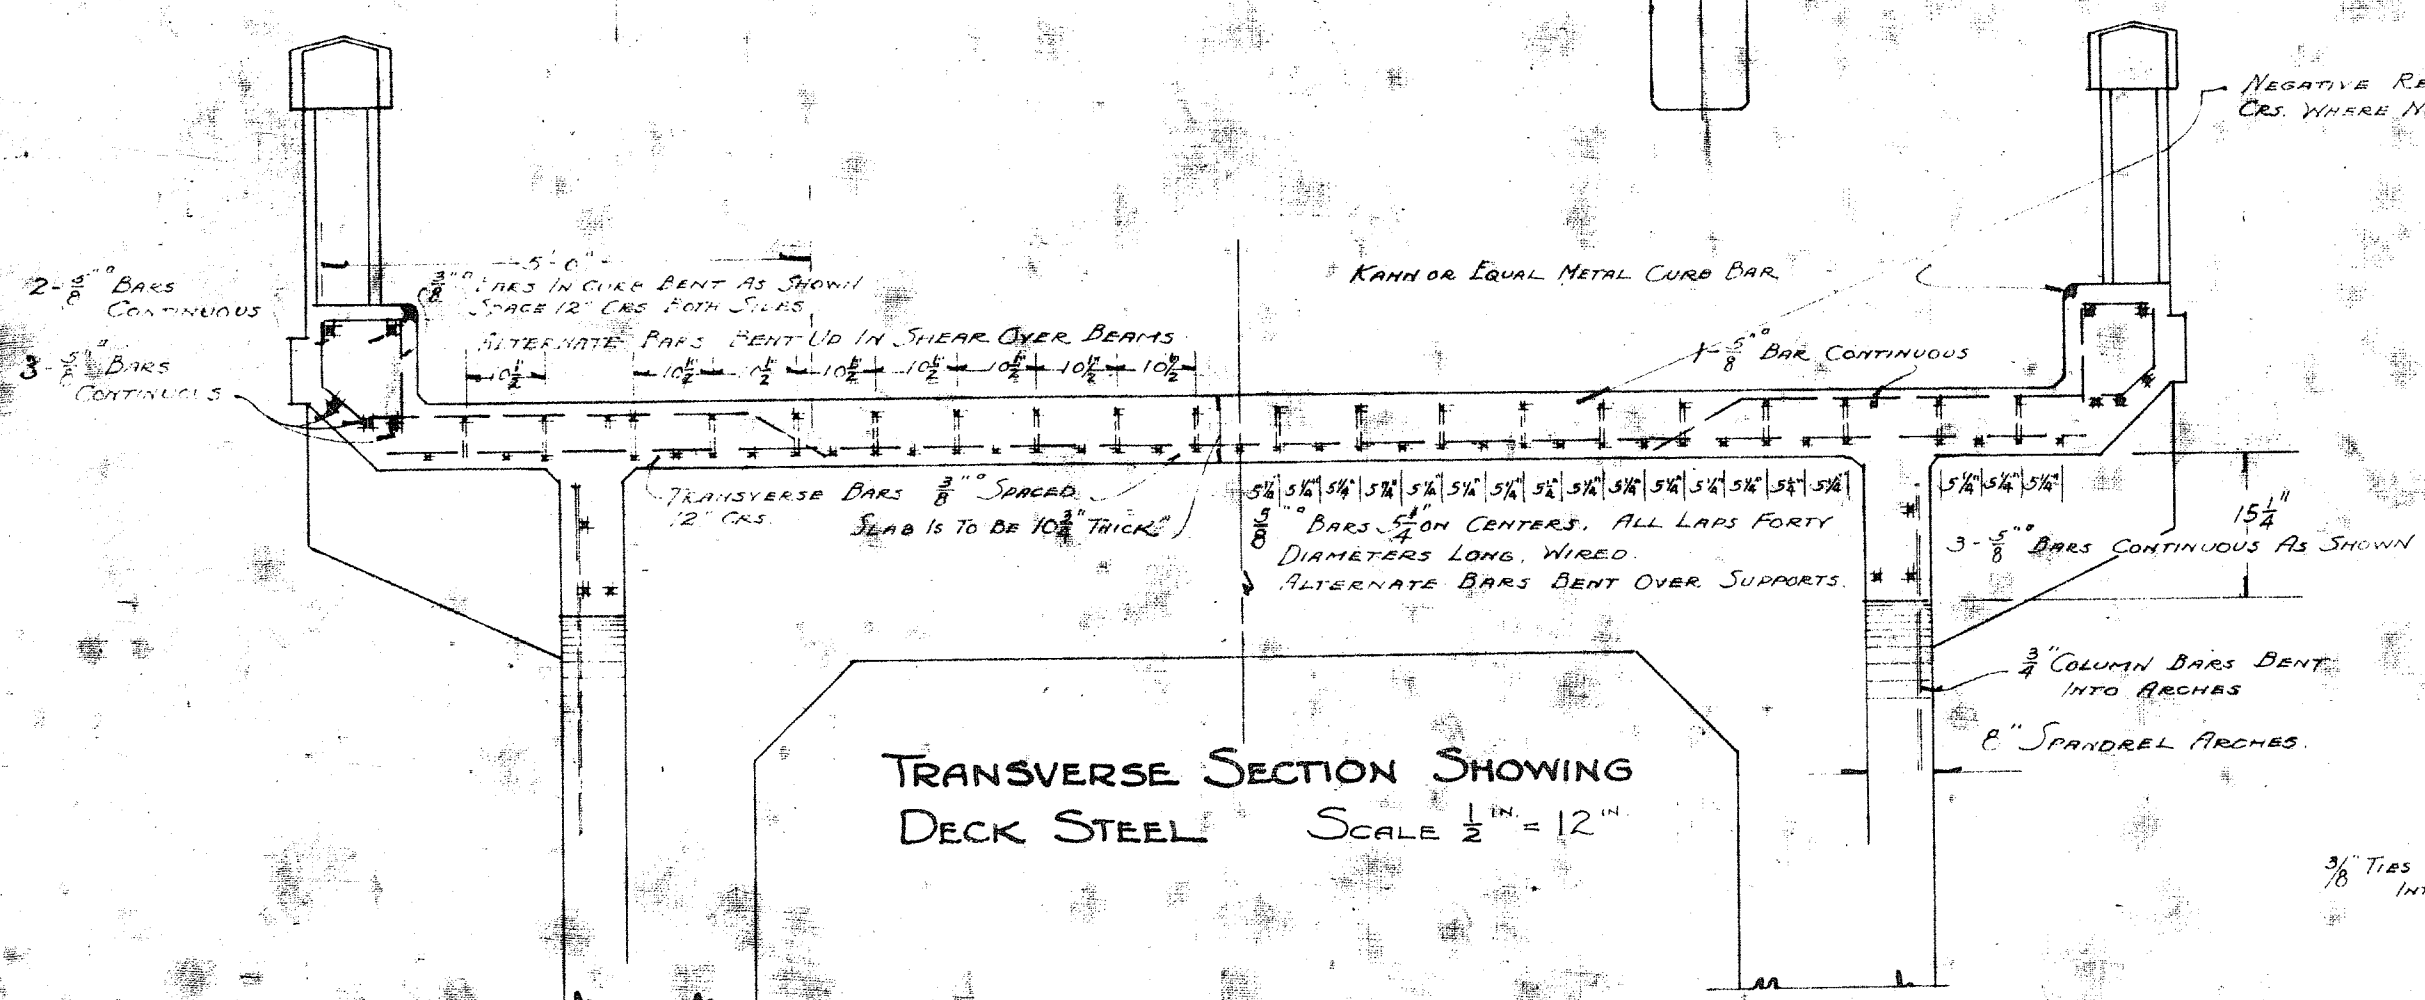

TRANSVERSE SECTION SHOWING
DECK STEEL
SCALE 1/2" = 12'

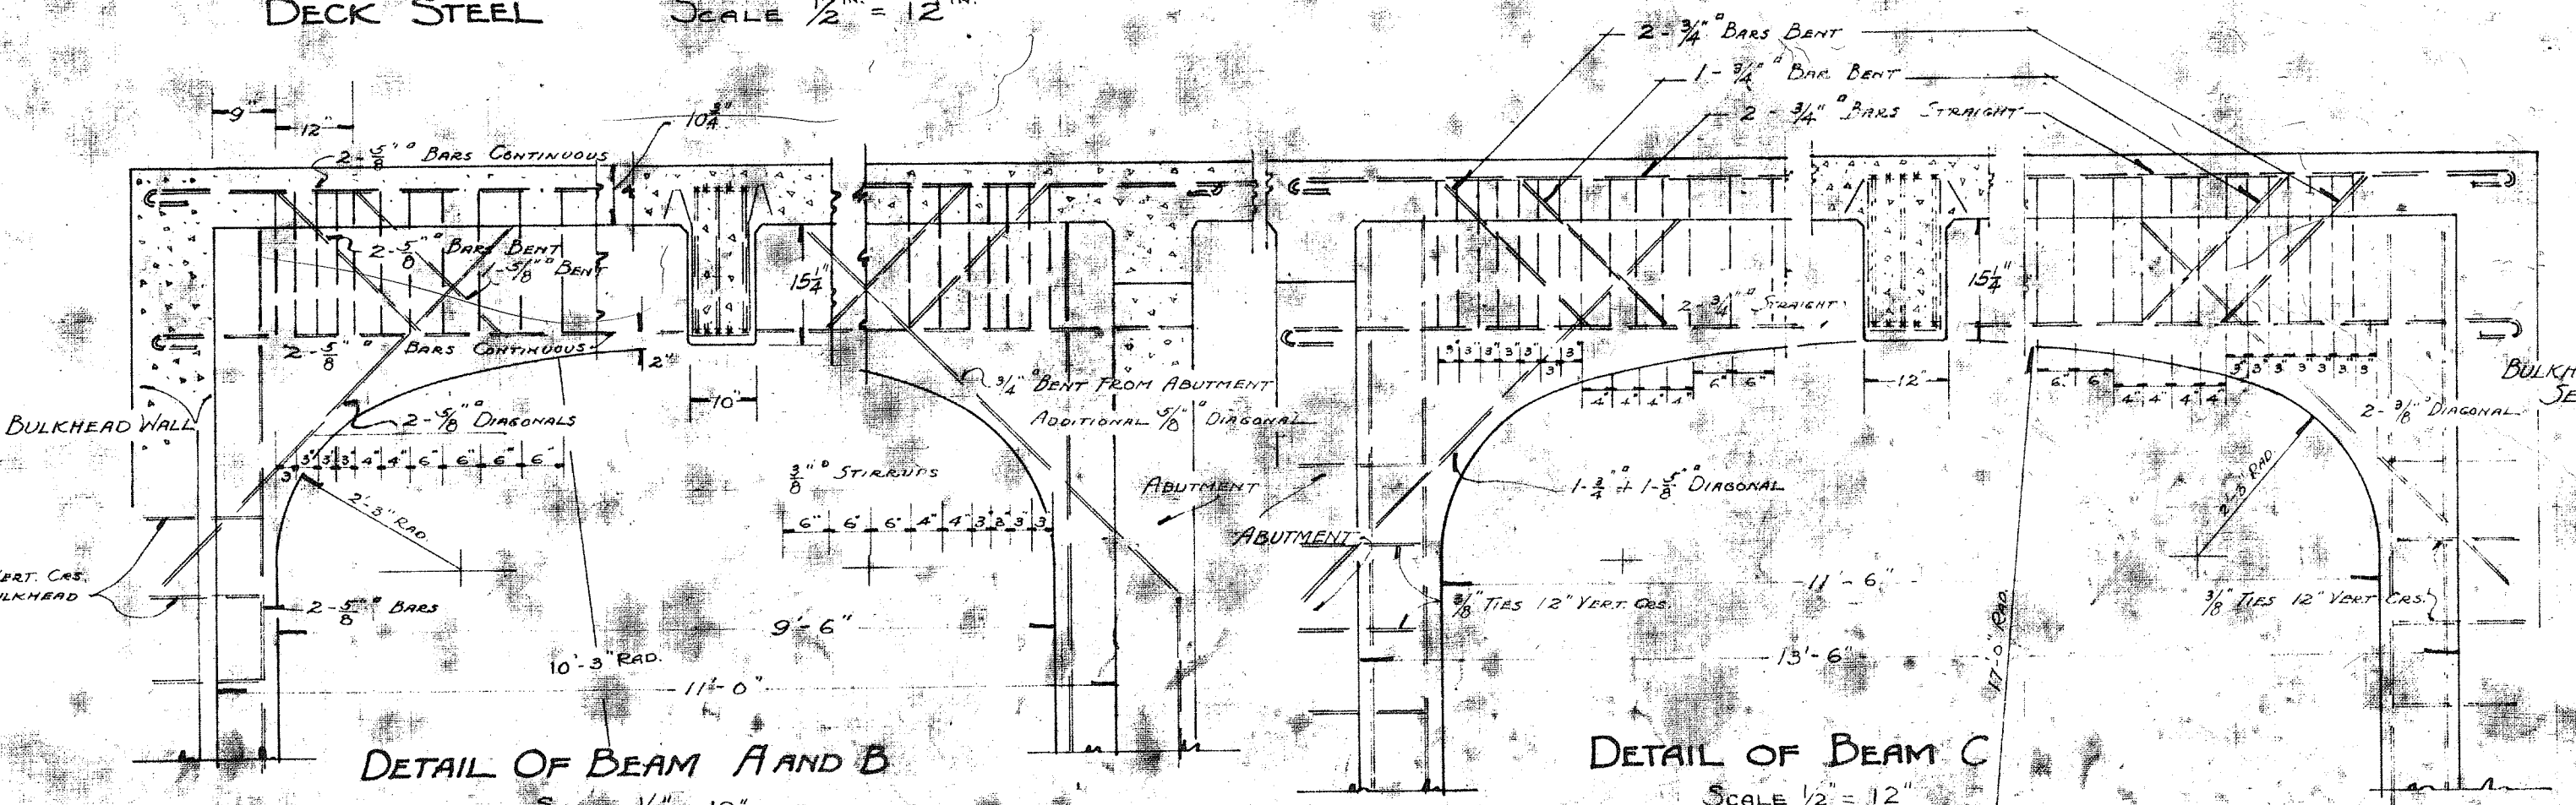

DETAIL OF BEAM A AND B
SCALE 1/4" = 12'

DETAIL OF BEAM C
SCALE 1/2" = 12'

WAILUANUI BRIDGE
KAILUA-KOPILIULA BELT ROAD
COUNTY OF MAUI, T.H.
JOB NO. 9
JANUARY, 1926

DESIGN BY WILLIAM DESMOND
AND W. H. WONG

CHECKED BY A. P. LOW - A. H. WONG
DRAWN BY WILLIAM DESMOND
TRACED BY KEN E. YAMADA

APPROVED: *C. P. Jones*
COUNTY ENGINEER
Wm. H. Bingham
SUPV. OF PUBLIC WORKS

SHEET NO. 4 OF 4 SHEETS

Waikani Stream Bridge
009 00360 05 01942
Hana Highway (Route 360)
Milepost 19.39