
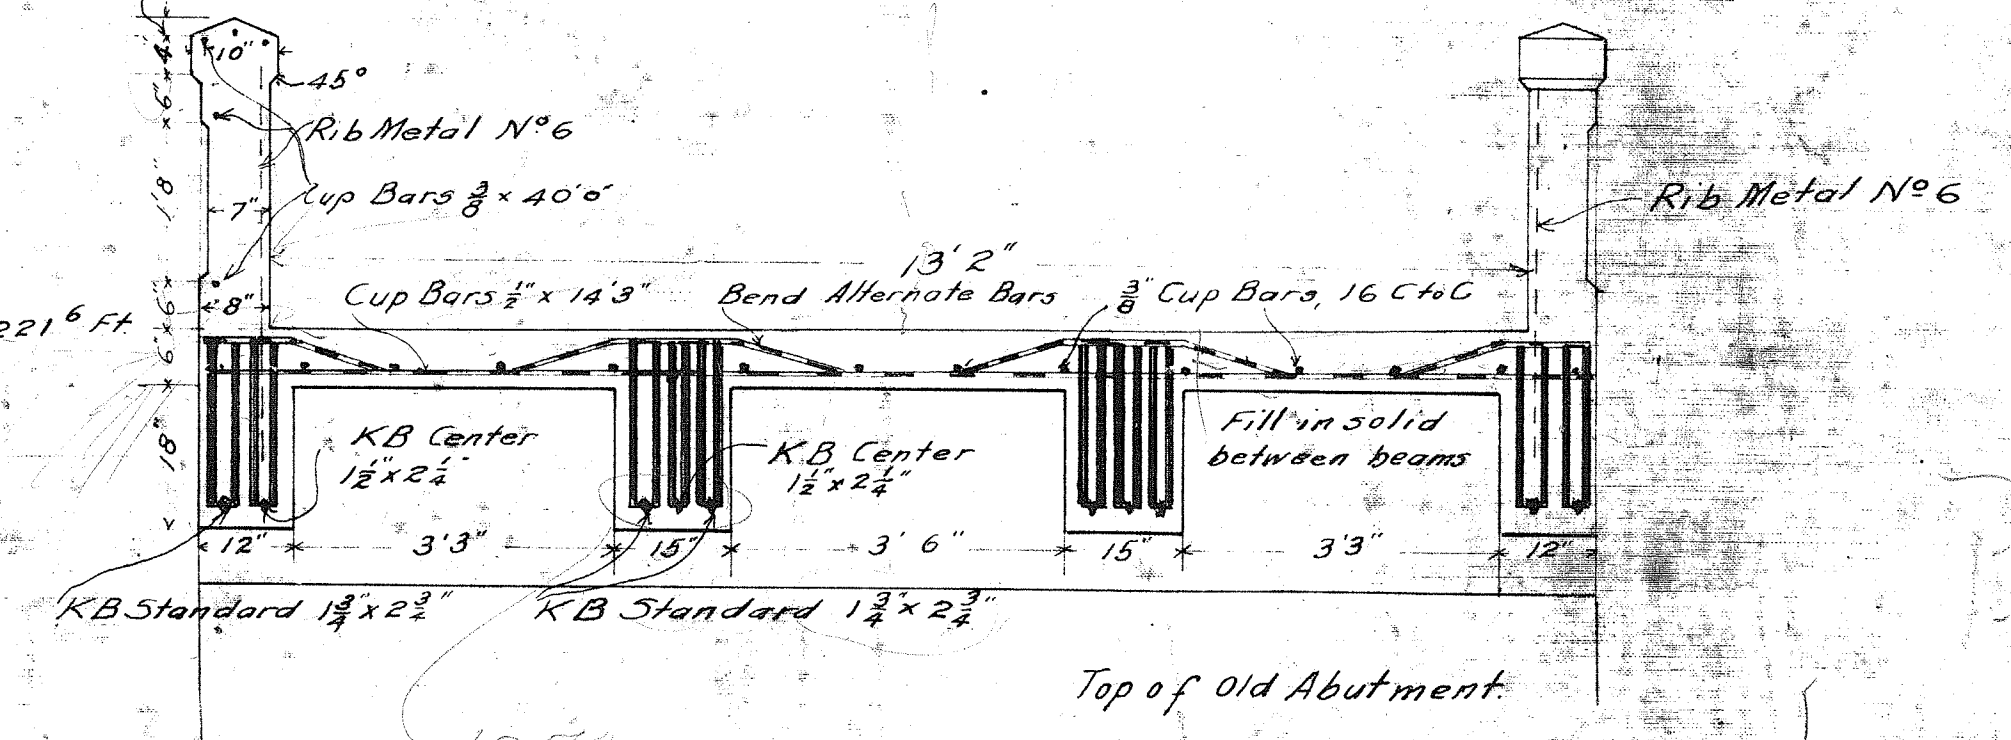


PAAKEA BRIDGE (ECCLES)
 (WAIHUE STREAM) (100) 360020 ✓
 WAIHUE BRIDGE DEC 11/2009



STATION 362+35
 1 Inch = 2 Ft.

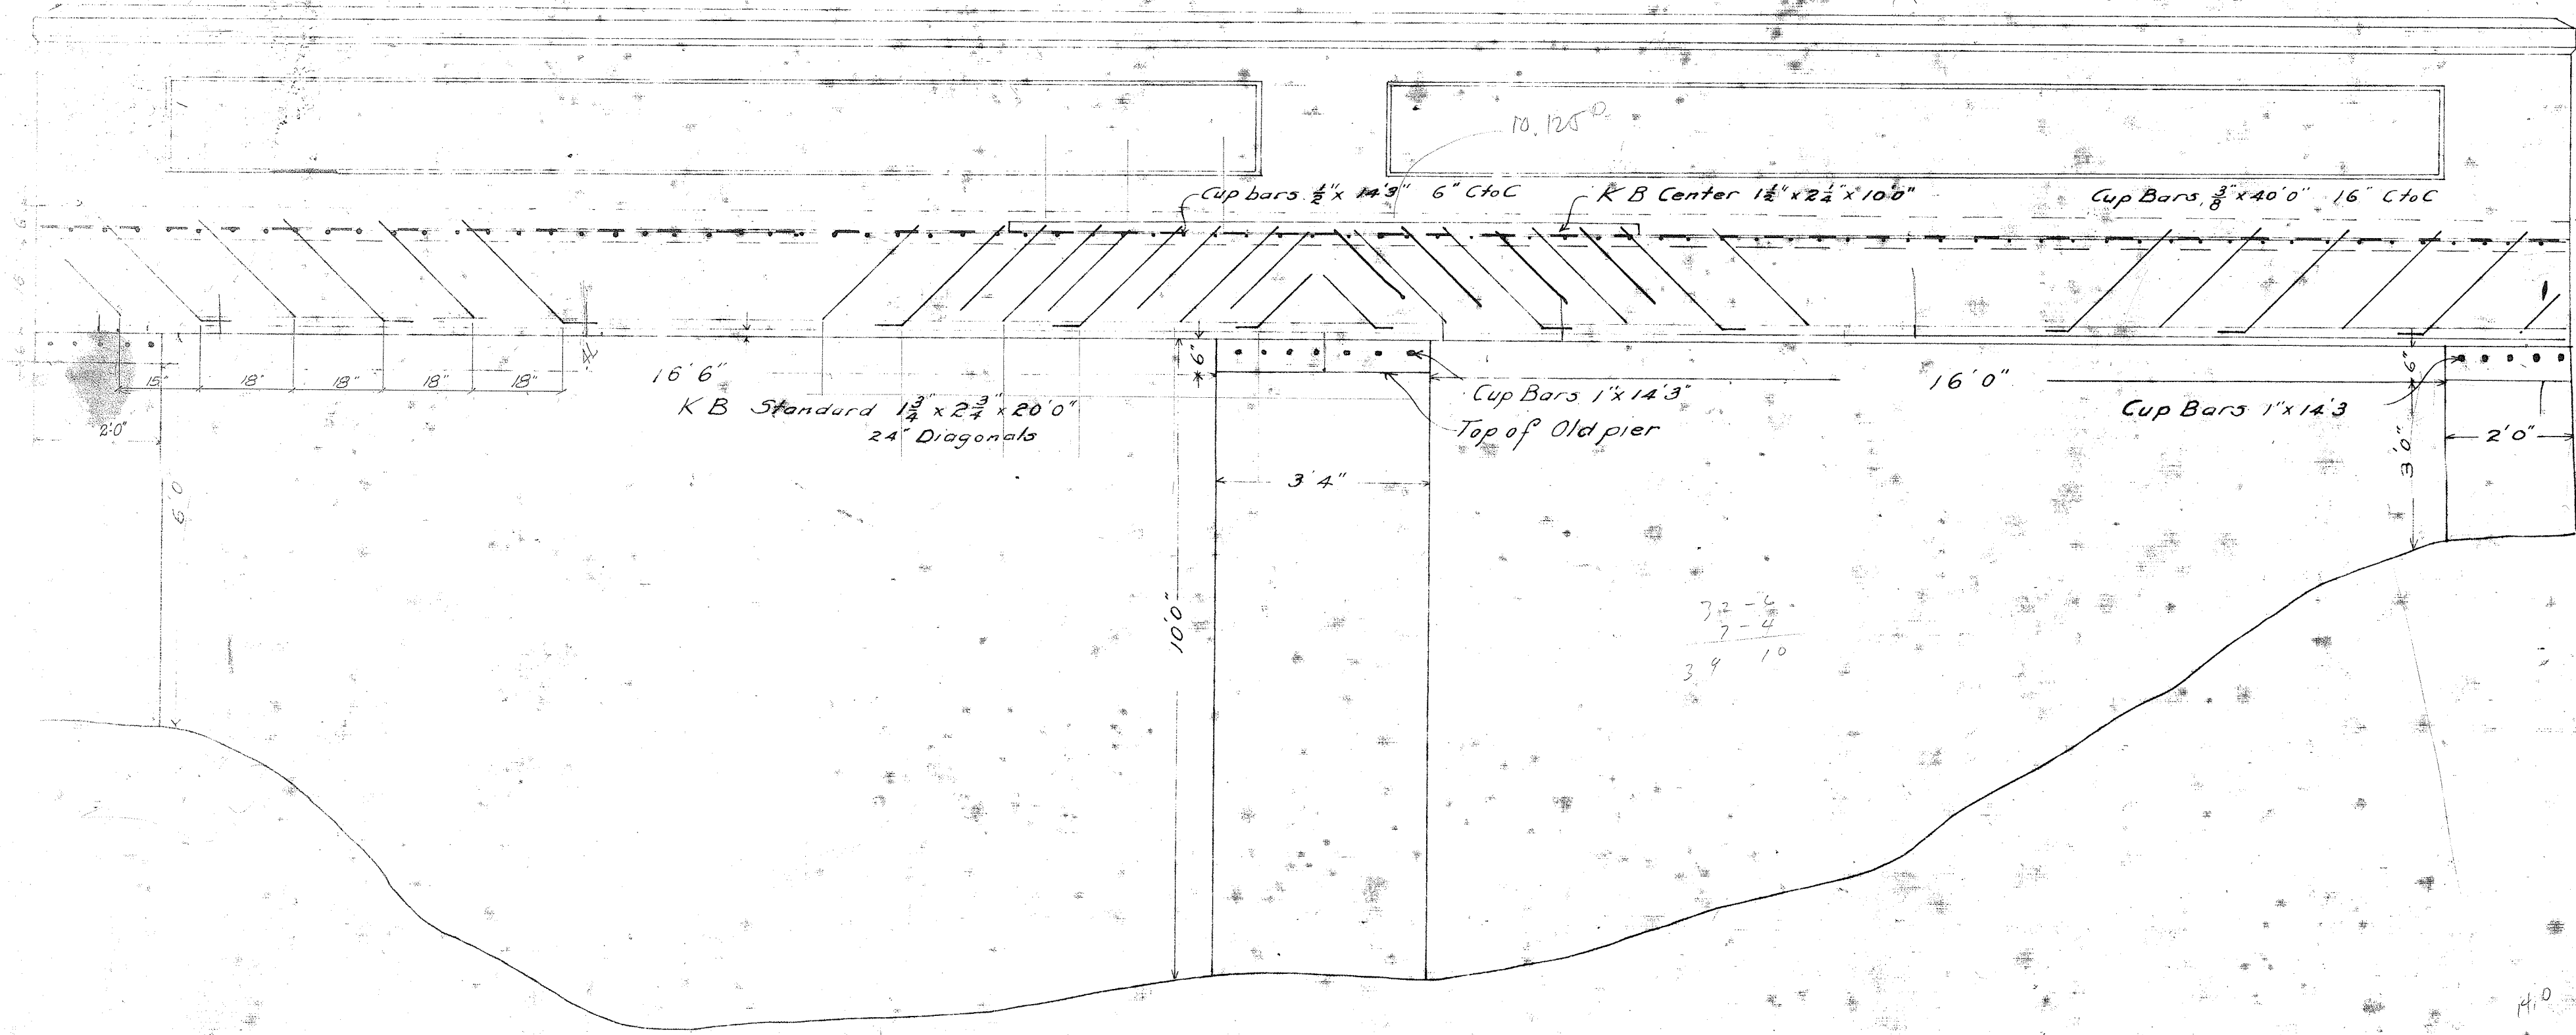

MAUI LOAN FUND COMMISSION
 TERRITORY OF HAWAII.

Approved *[Signature]*
 Vice Chairman

PAAKEA (West) BRIDGE
 STATION 388+50
 1 Inch = 2 Ft.
 Unknown 1
 (Paakea Stream)

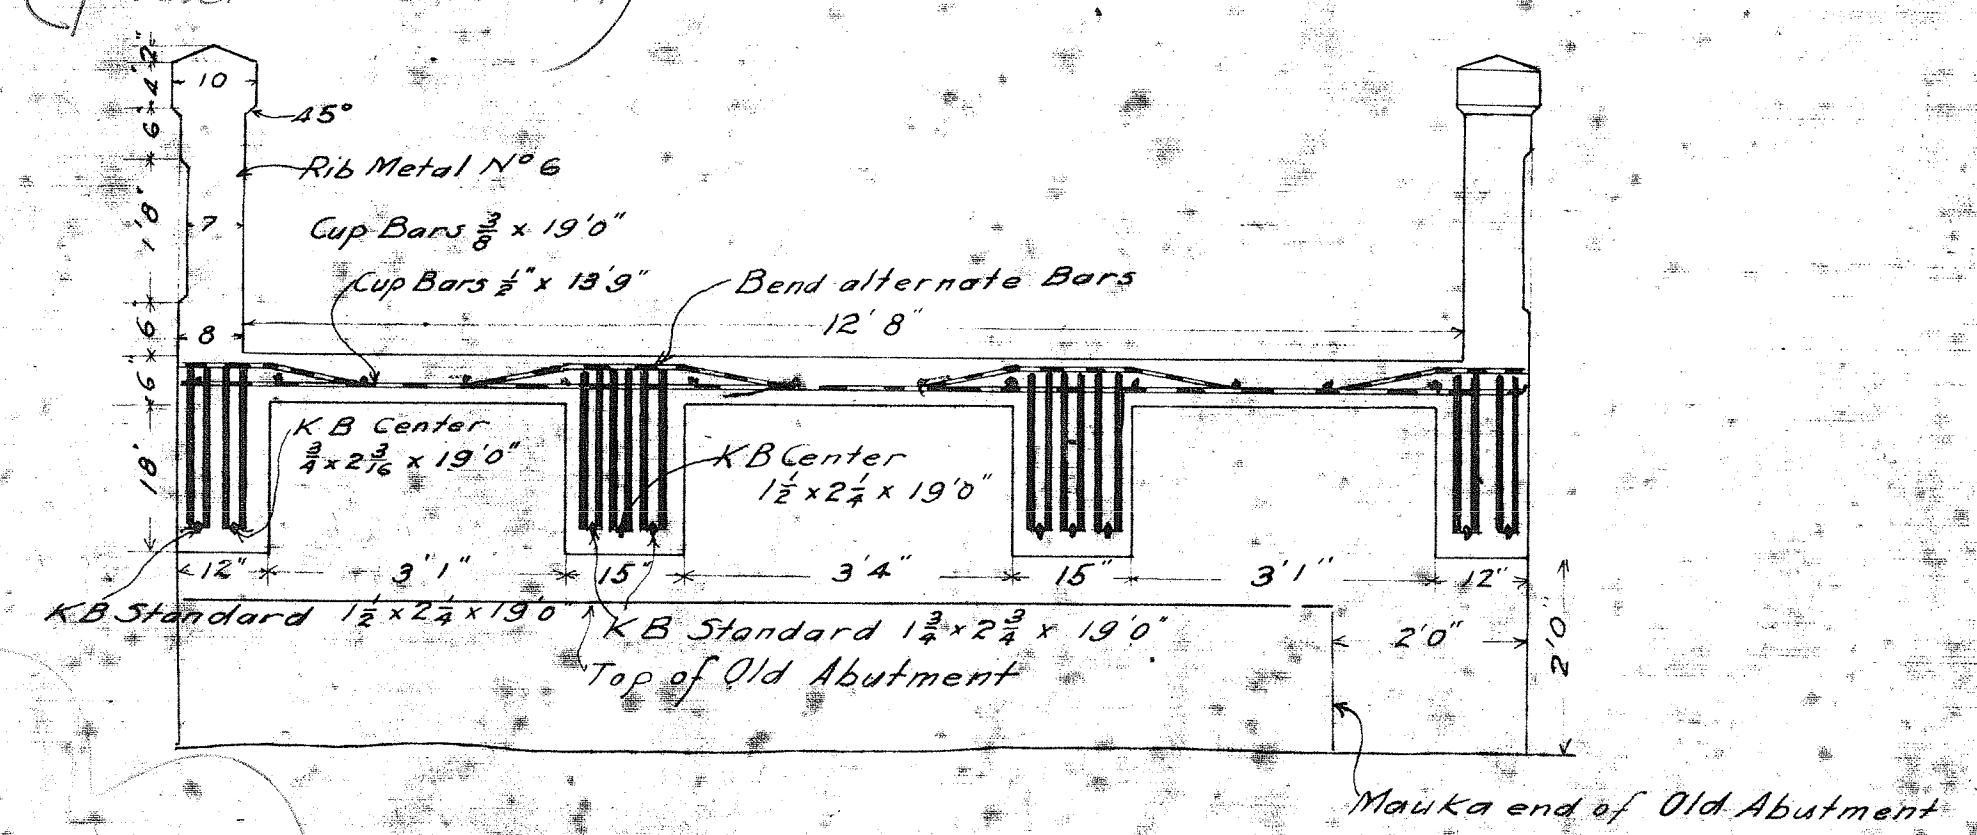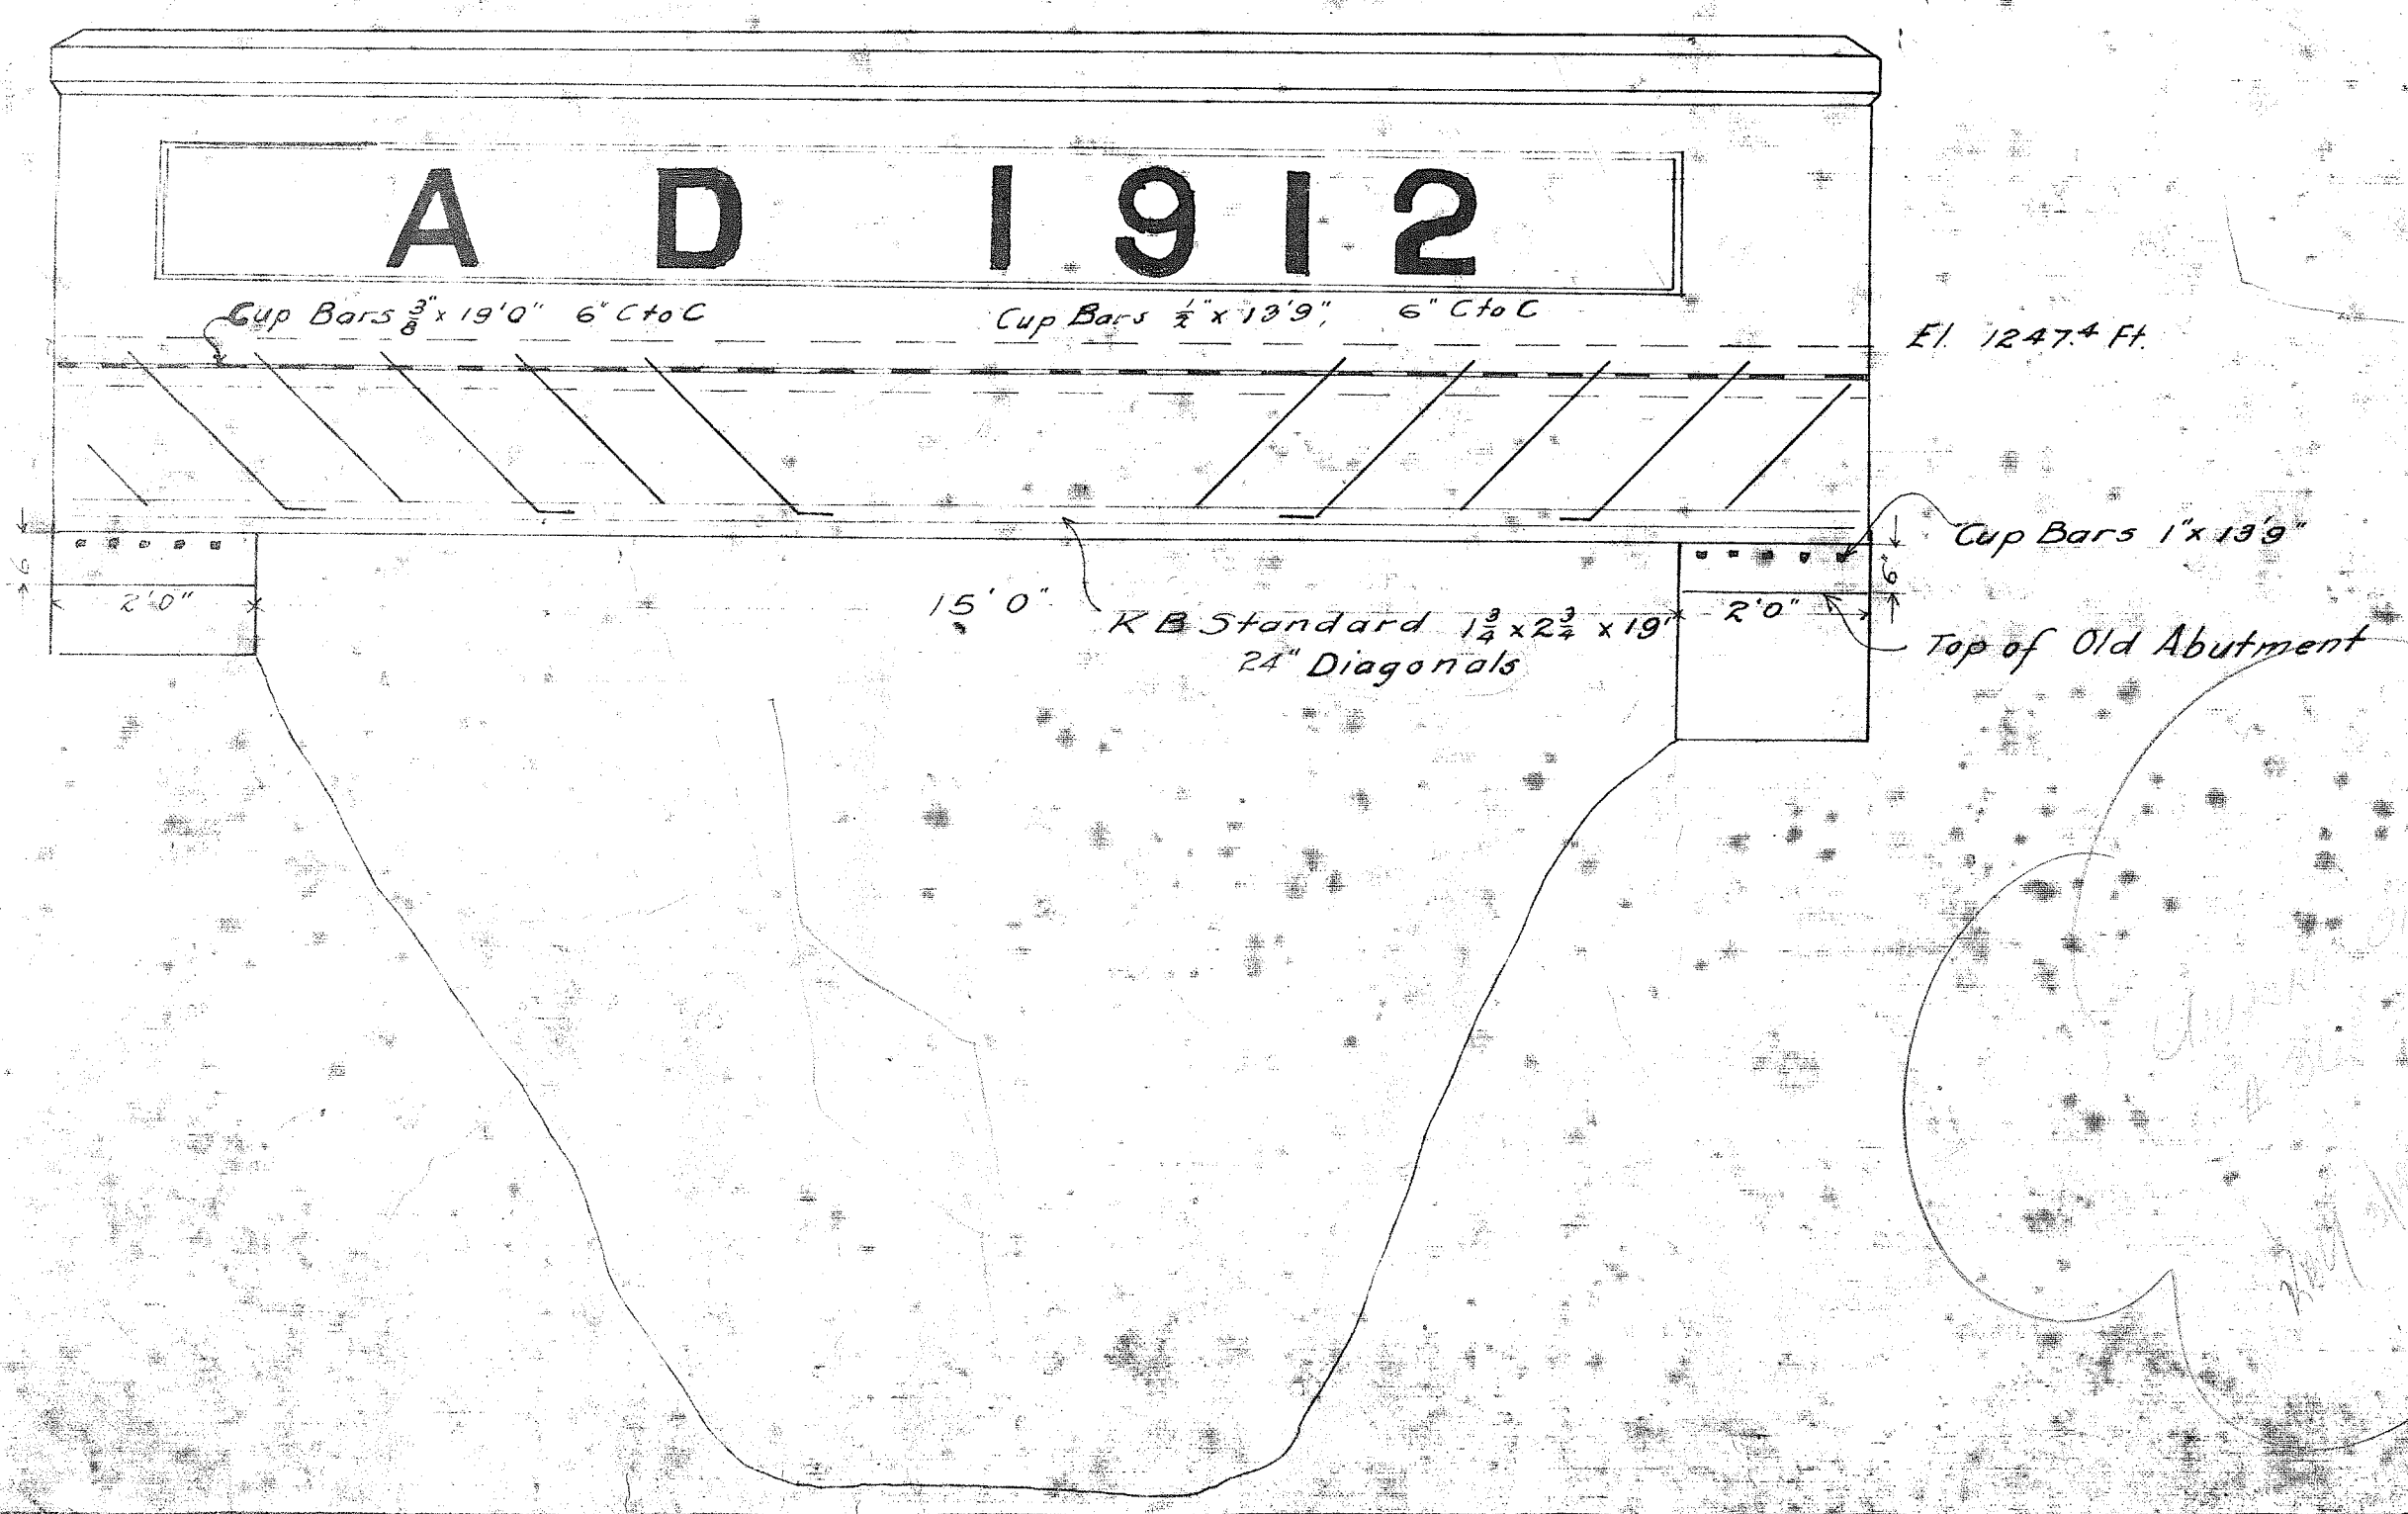

Waiohue Stream Bridge
 009 00360 05 02250
 Hana Highway (Route 360)
 Milepost 22.31
 Unnamed Bridge No. 1
 009 00360 05 02298
 Hana Highway (Route 360)
 Milepost 22.95