
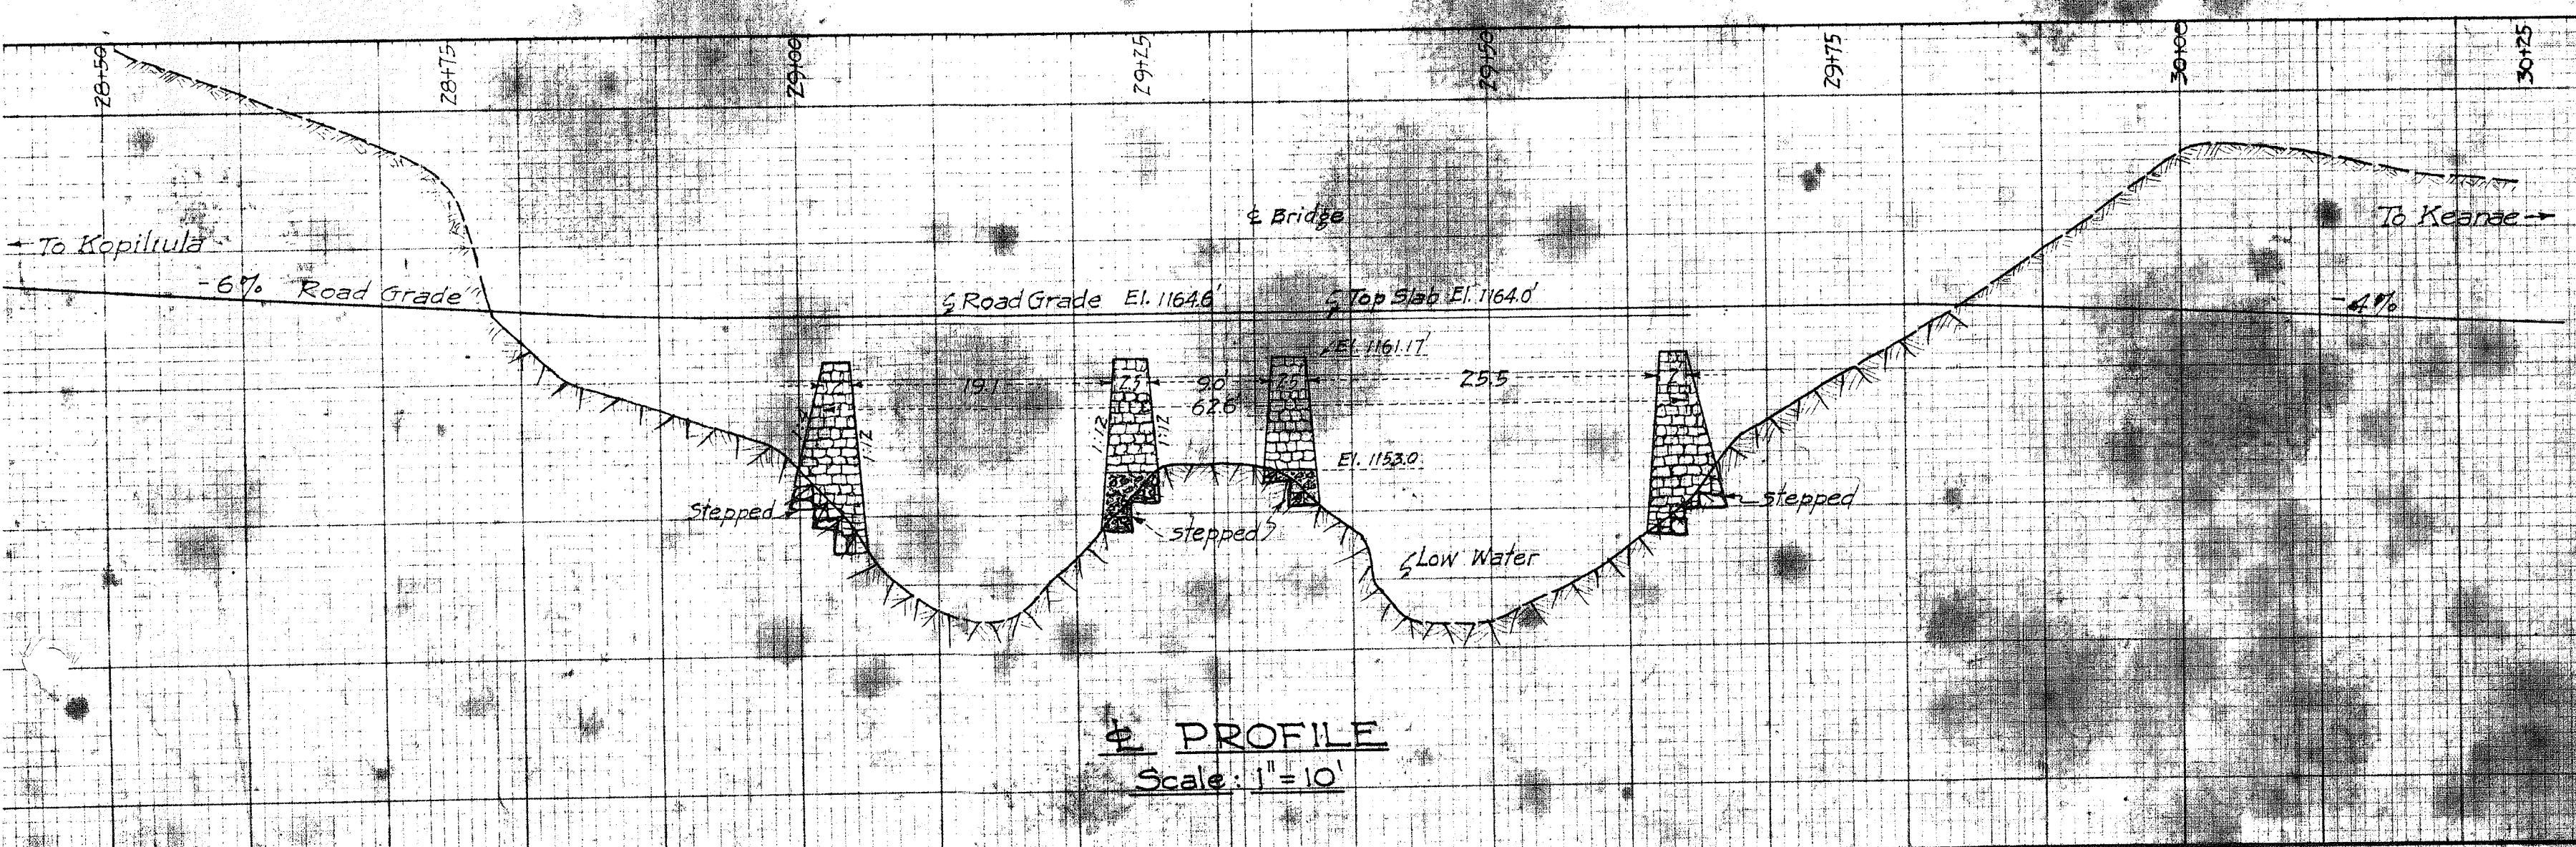
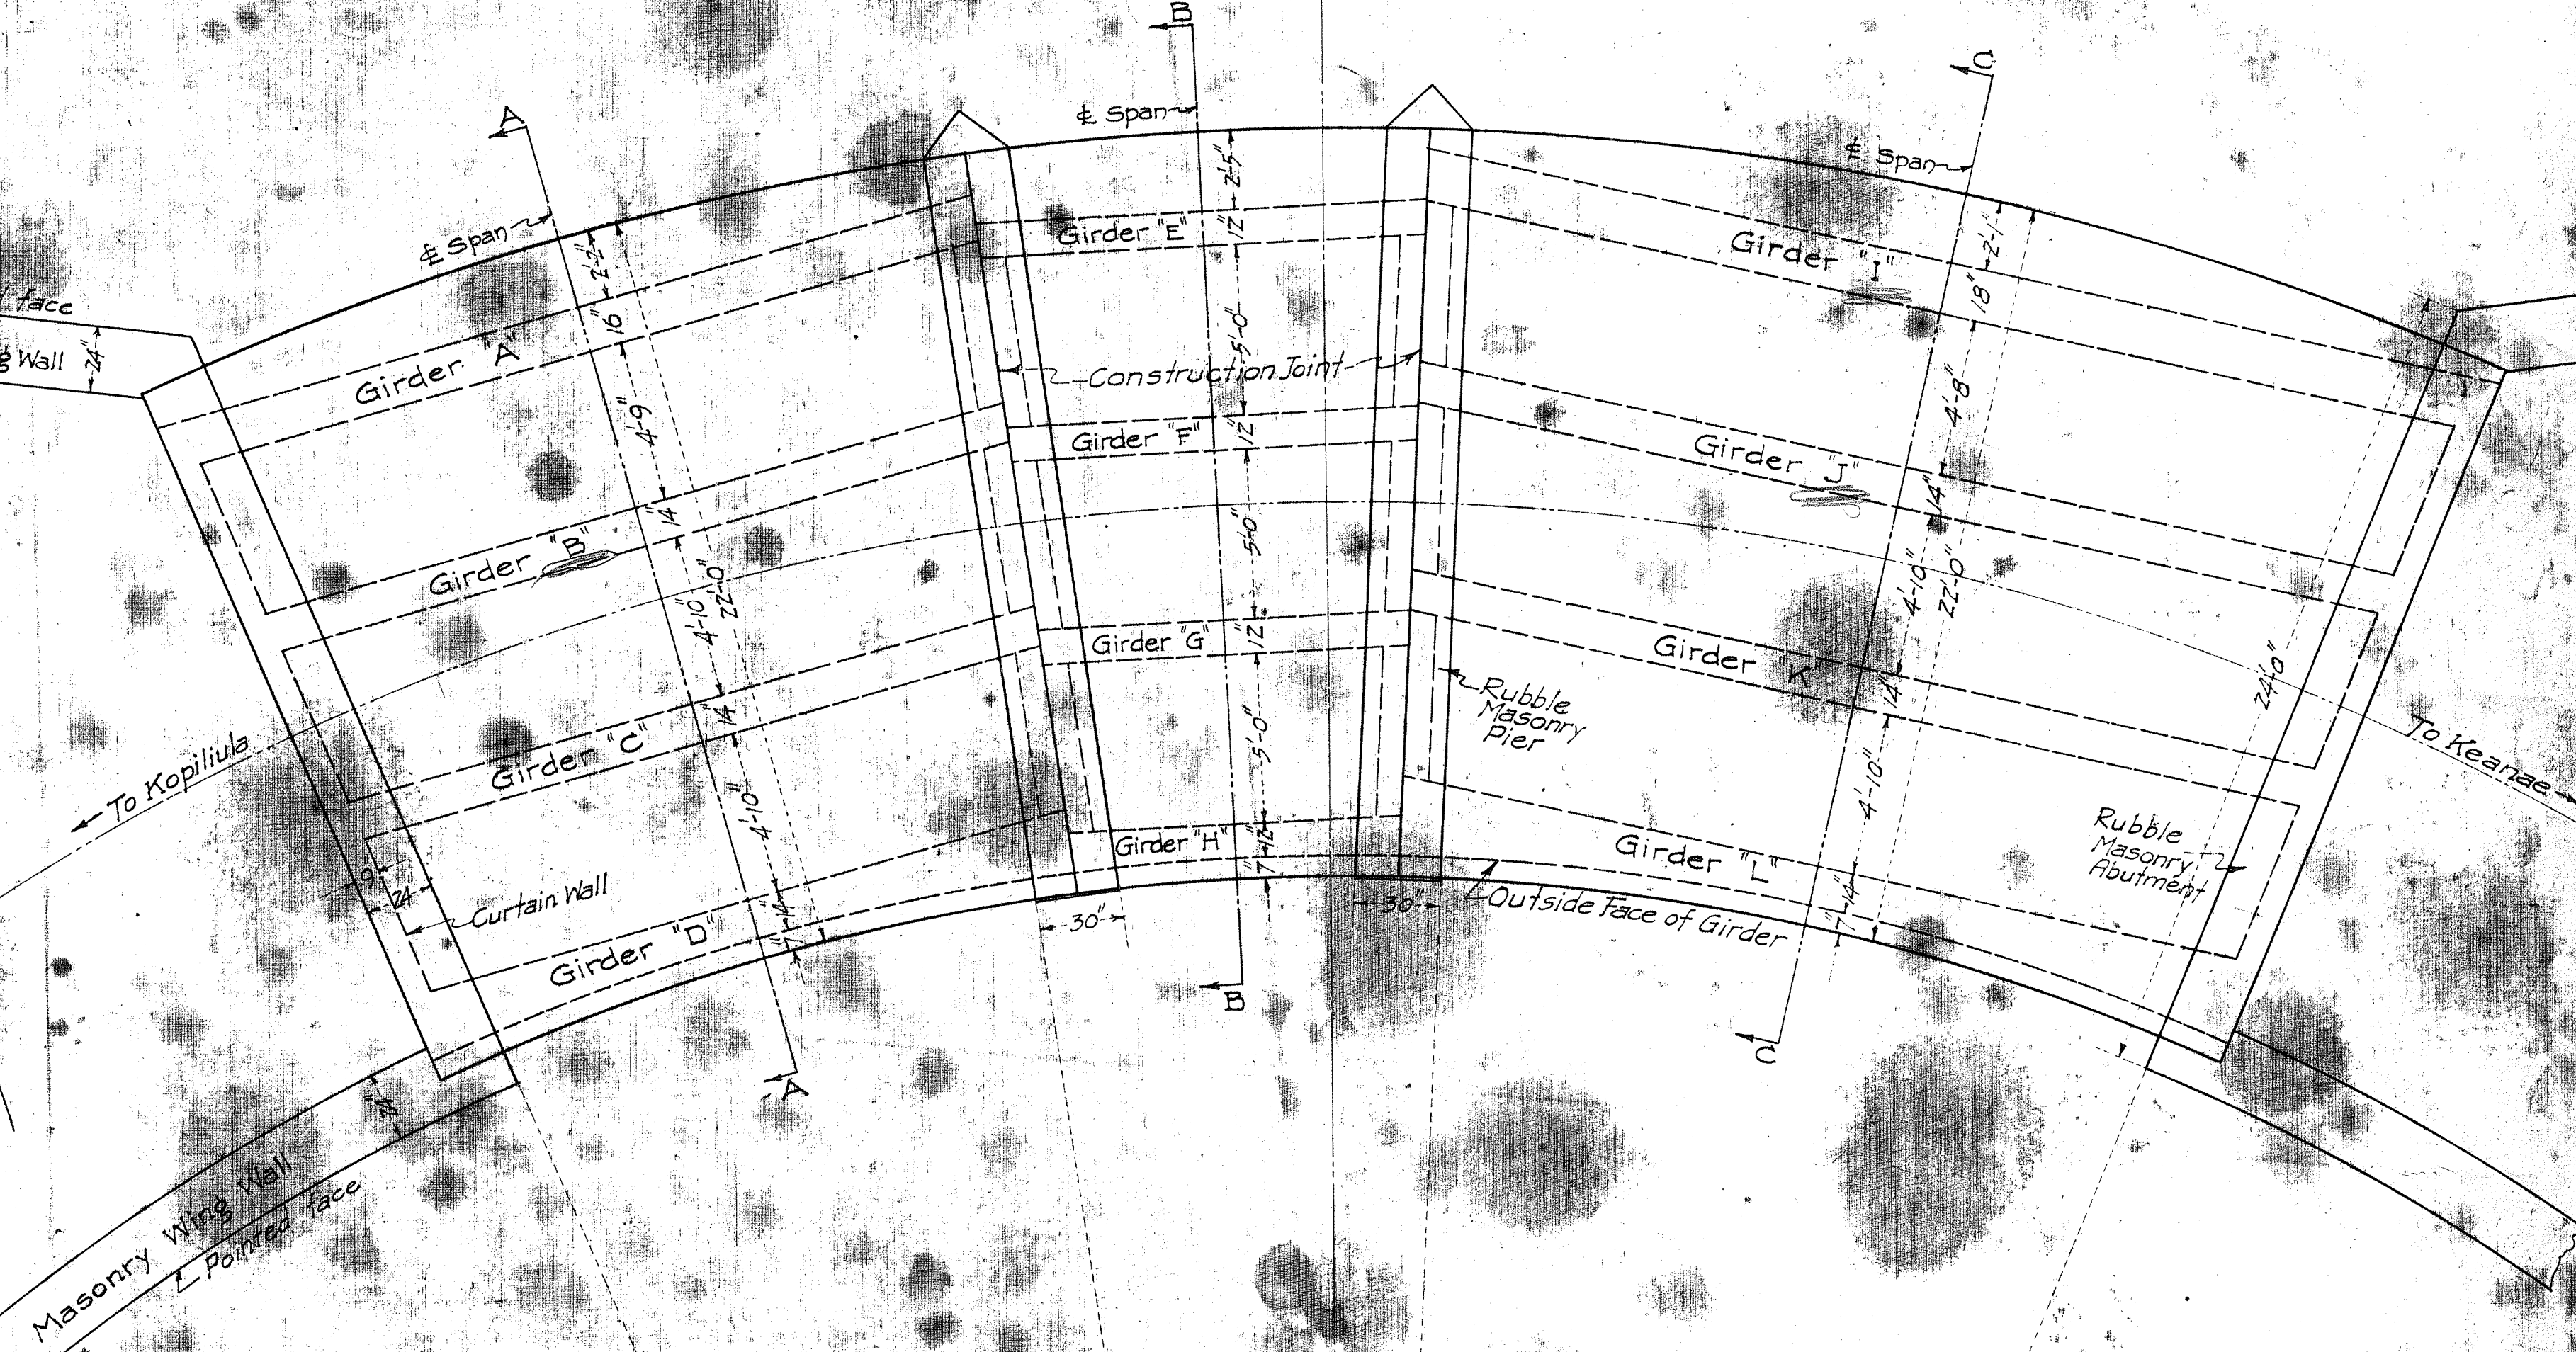


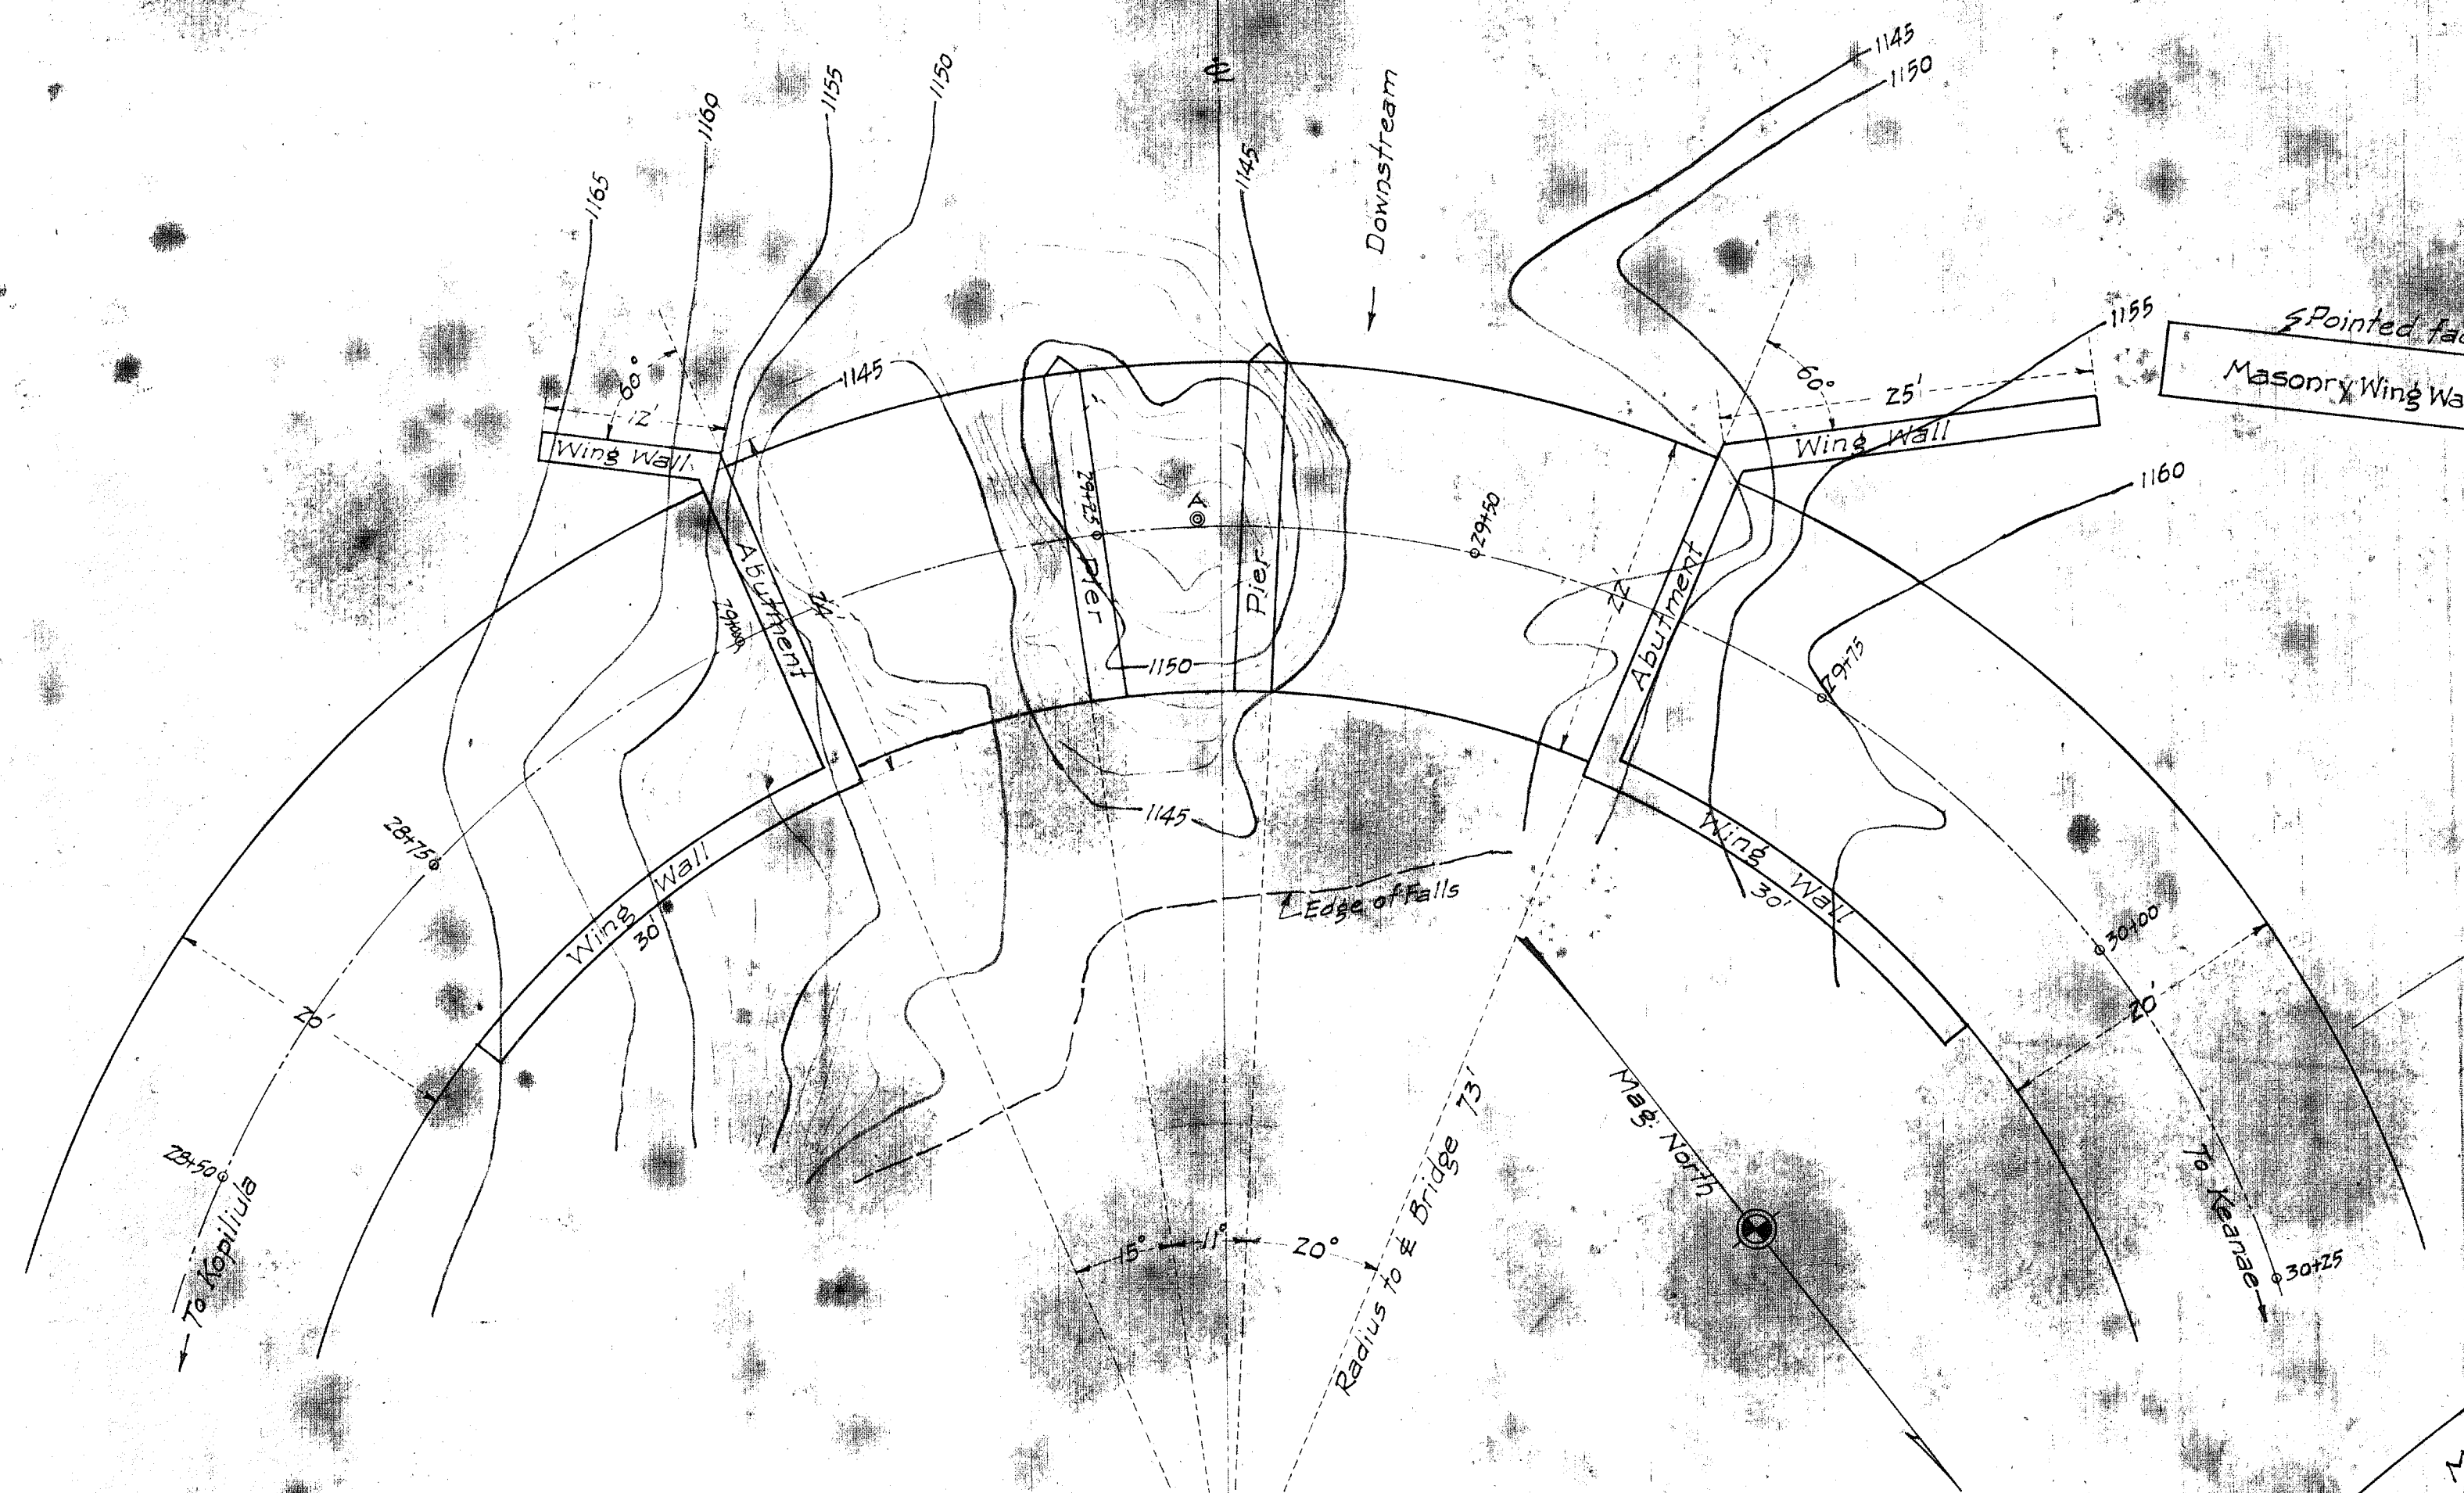

West Wailuiki Stream Bridge
009 00360 05 02086
Hana Highway (Route 360)
Milepost 20.83

M-8: Sht. 17 of 21

#360 016 ✓


WEST WAILUAIKI BRIDGE
KAILUA-KOPIILULA BELT ROAD
COUNTY OF MAUI, T.H.
JOB NO. 8

COUNTY ENGINEER'S OFFICE DEC. 22, 1926
A.P. LOW, COUNTY ENGINEER


Approved by: *[Signature]* 2/1/26
Superintendent of Public Works

Designed by: A.H. Wong
Checked by: F. Kanabale
Drawn by: A.H. Wong


Sheet 1 of 3 Sheets

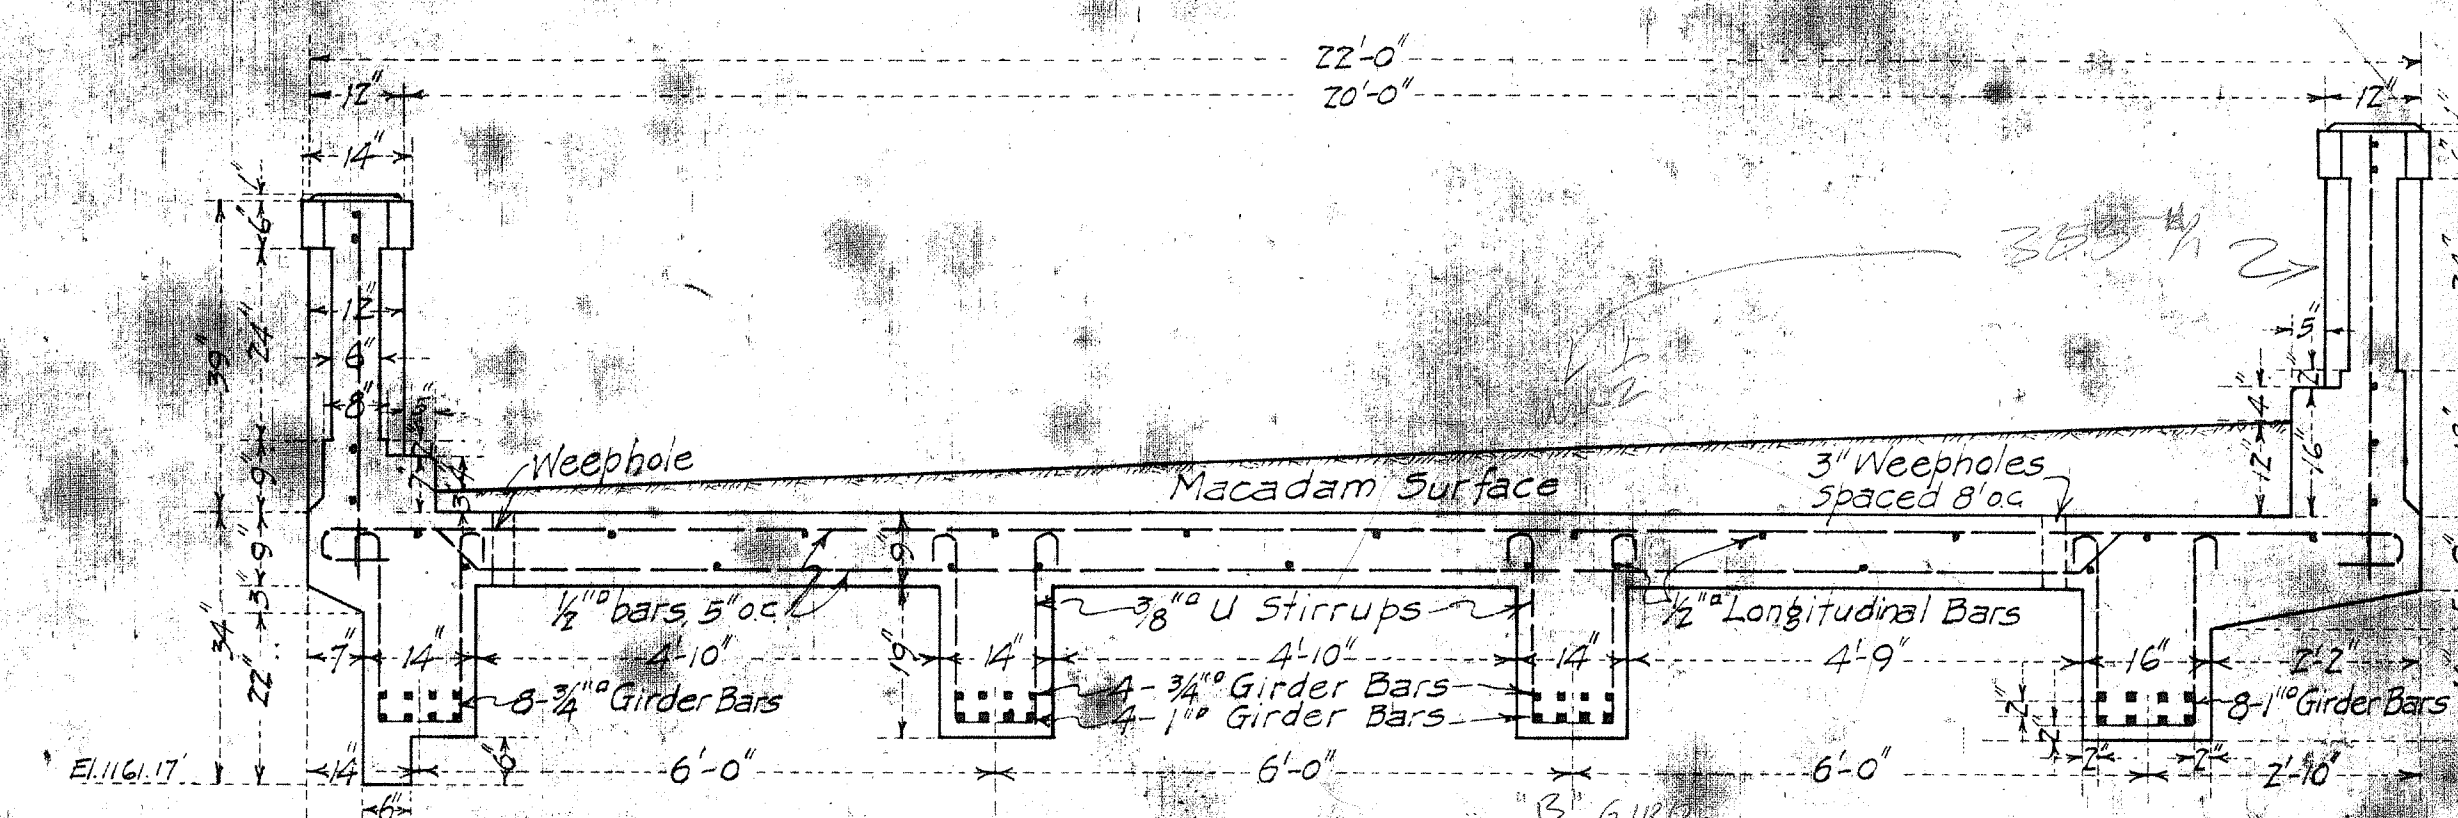

SECTION "A-A"
KOPILIULA SPAN
Scale: 1"=2'

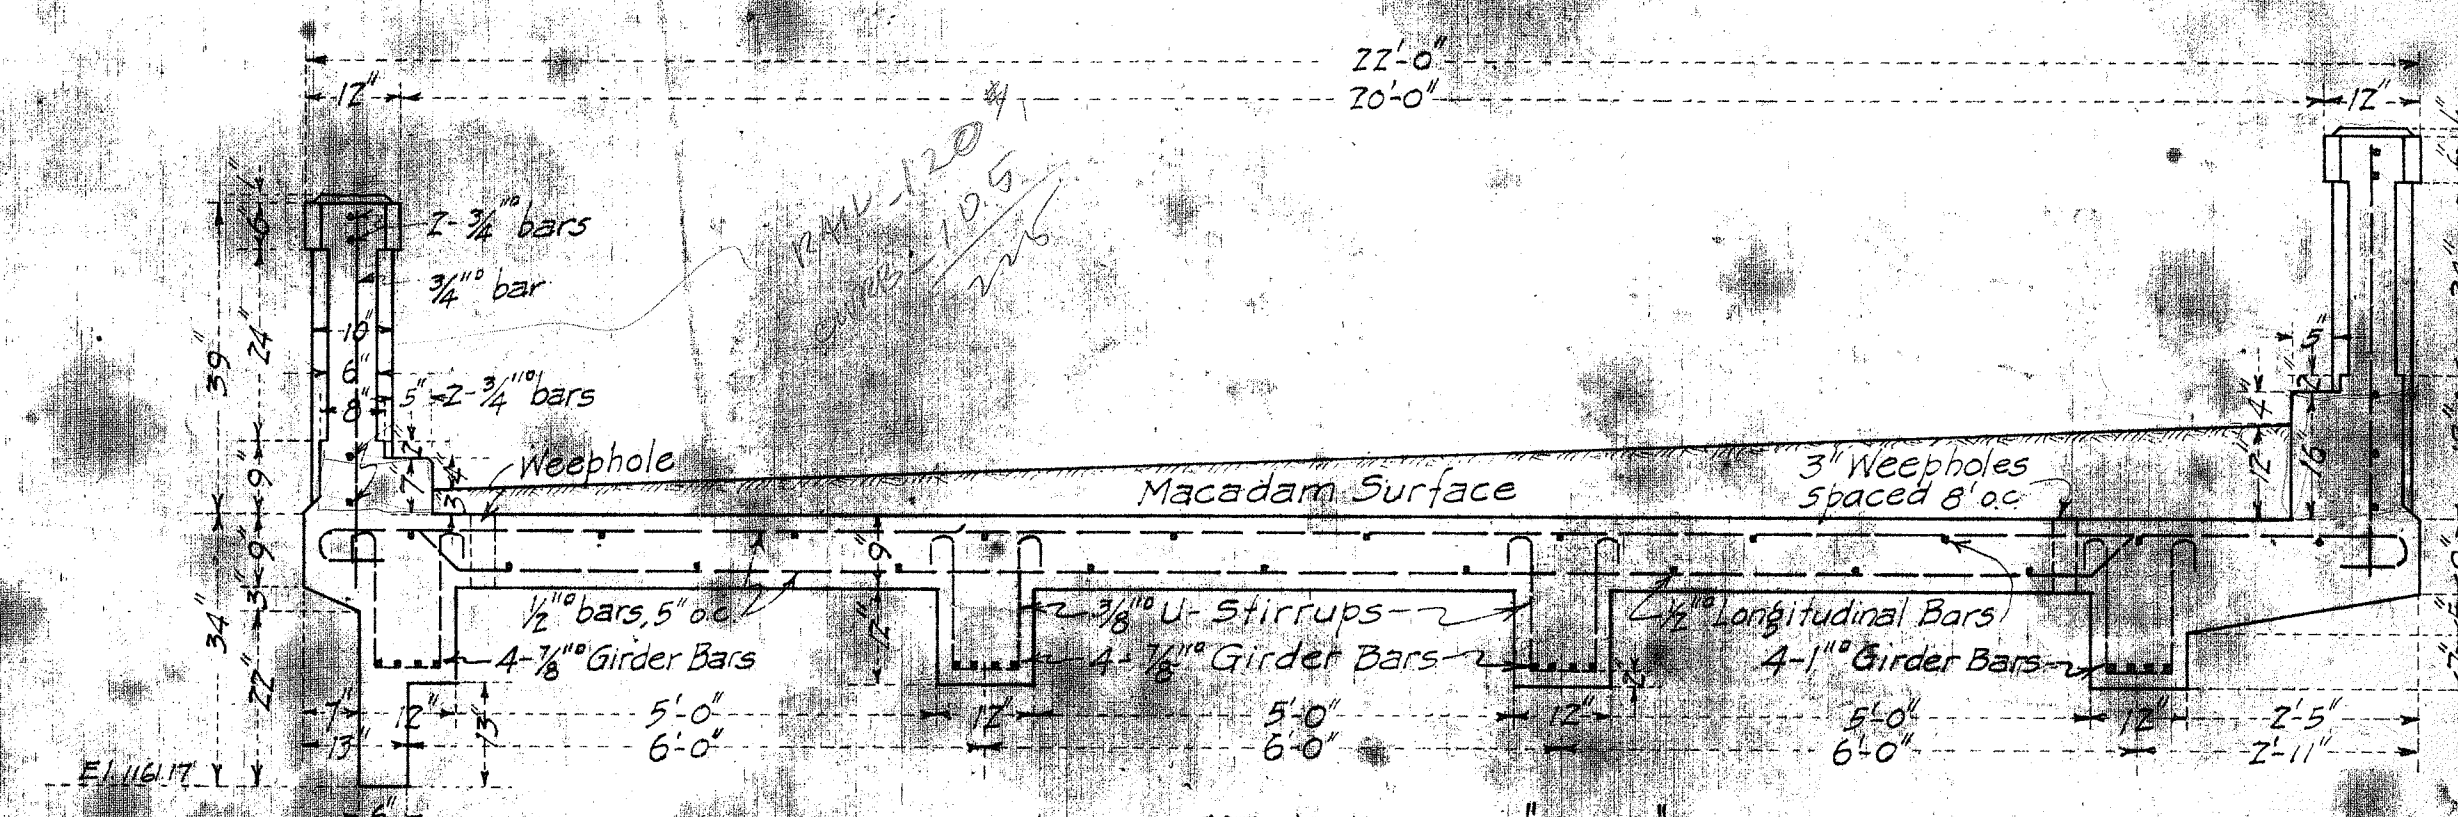

SECTION "B-B" USE FOR SLAB,
MIDDLE SPAN
Scale: 1" = 2'

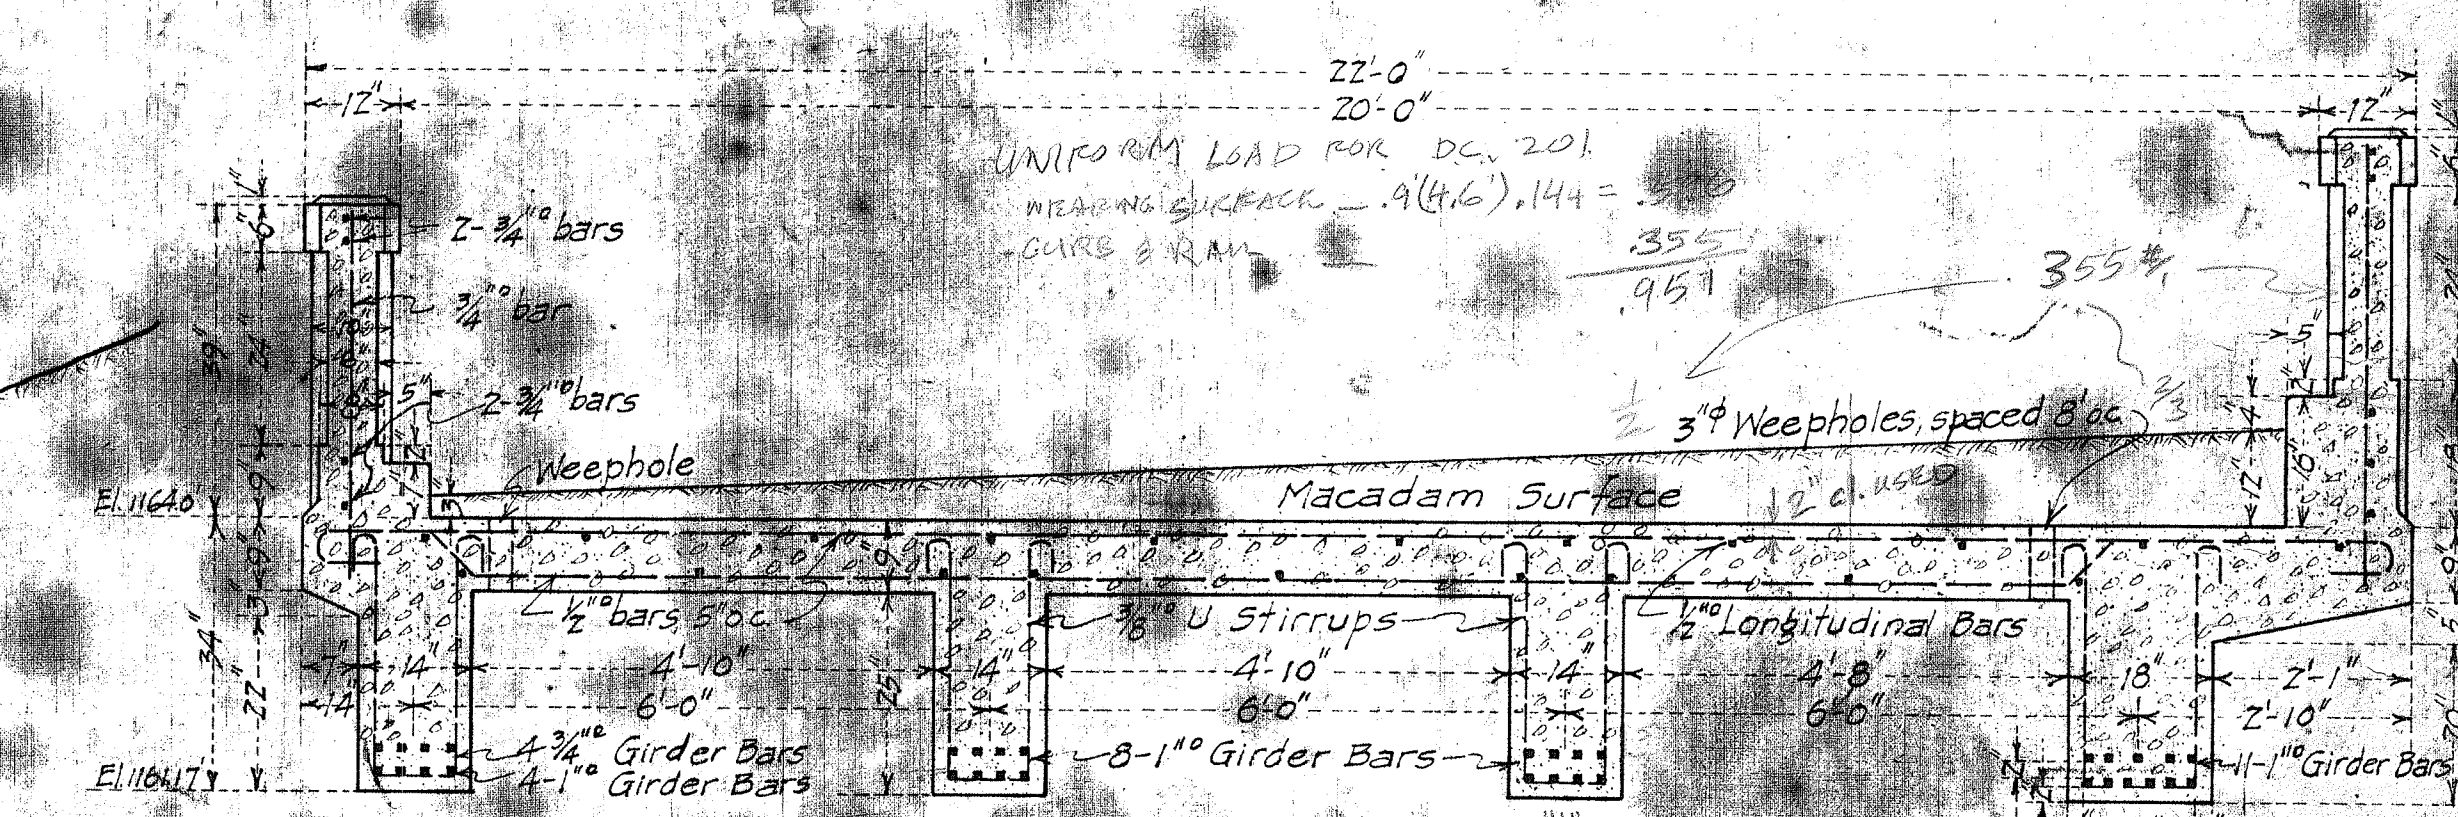

SECTION "C-C"
KEANAE SPAN
Scale: 1"=2'

West Wailuaiki Stream Bridge
009 00360 05 02086
Hana Highway (Route 360)
Milepost 20.83

WEST WAILUAIKI BRIDGE
KAILUA-KOPIILUULA BELT ROAD
COUNTY OF MAUI, T. H.
JOB No. 8
COUNTY ENGINEER'S OFFICE DEC. 22, 1926
A. P. LOW, COUNTY ENGINEER
Approved by: *B. H. Wong* Jan. 2, 1927
Superintendent of Public Works
Designed by: A. H. Wong
Checked by: F. Kanahale
Sheet 2 of 3 Sheets Drawn by: A. H. Wong

