


FED. ROAD DIST. NO.	STATE	PROJ. NO.	FISCAL YEAR	SHEET NO.	TOTAL SHEETS
HAWAII	HA	A360-01-62	1962	3	11


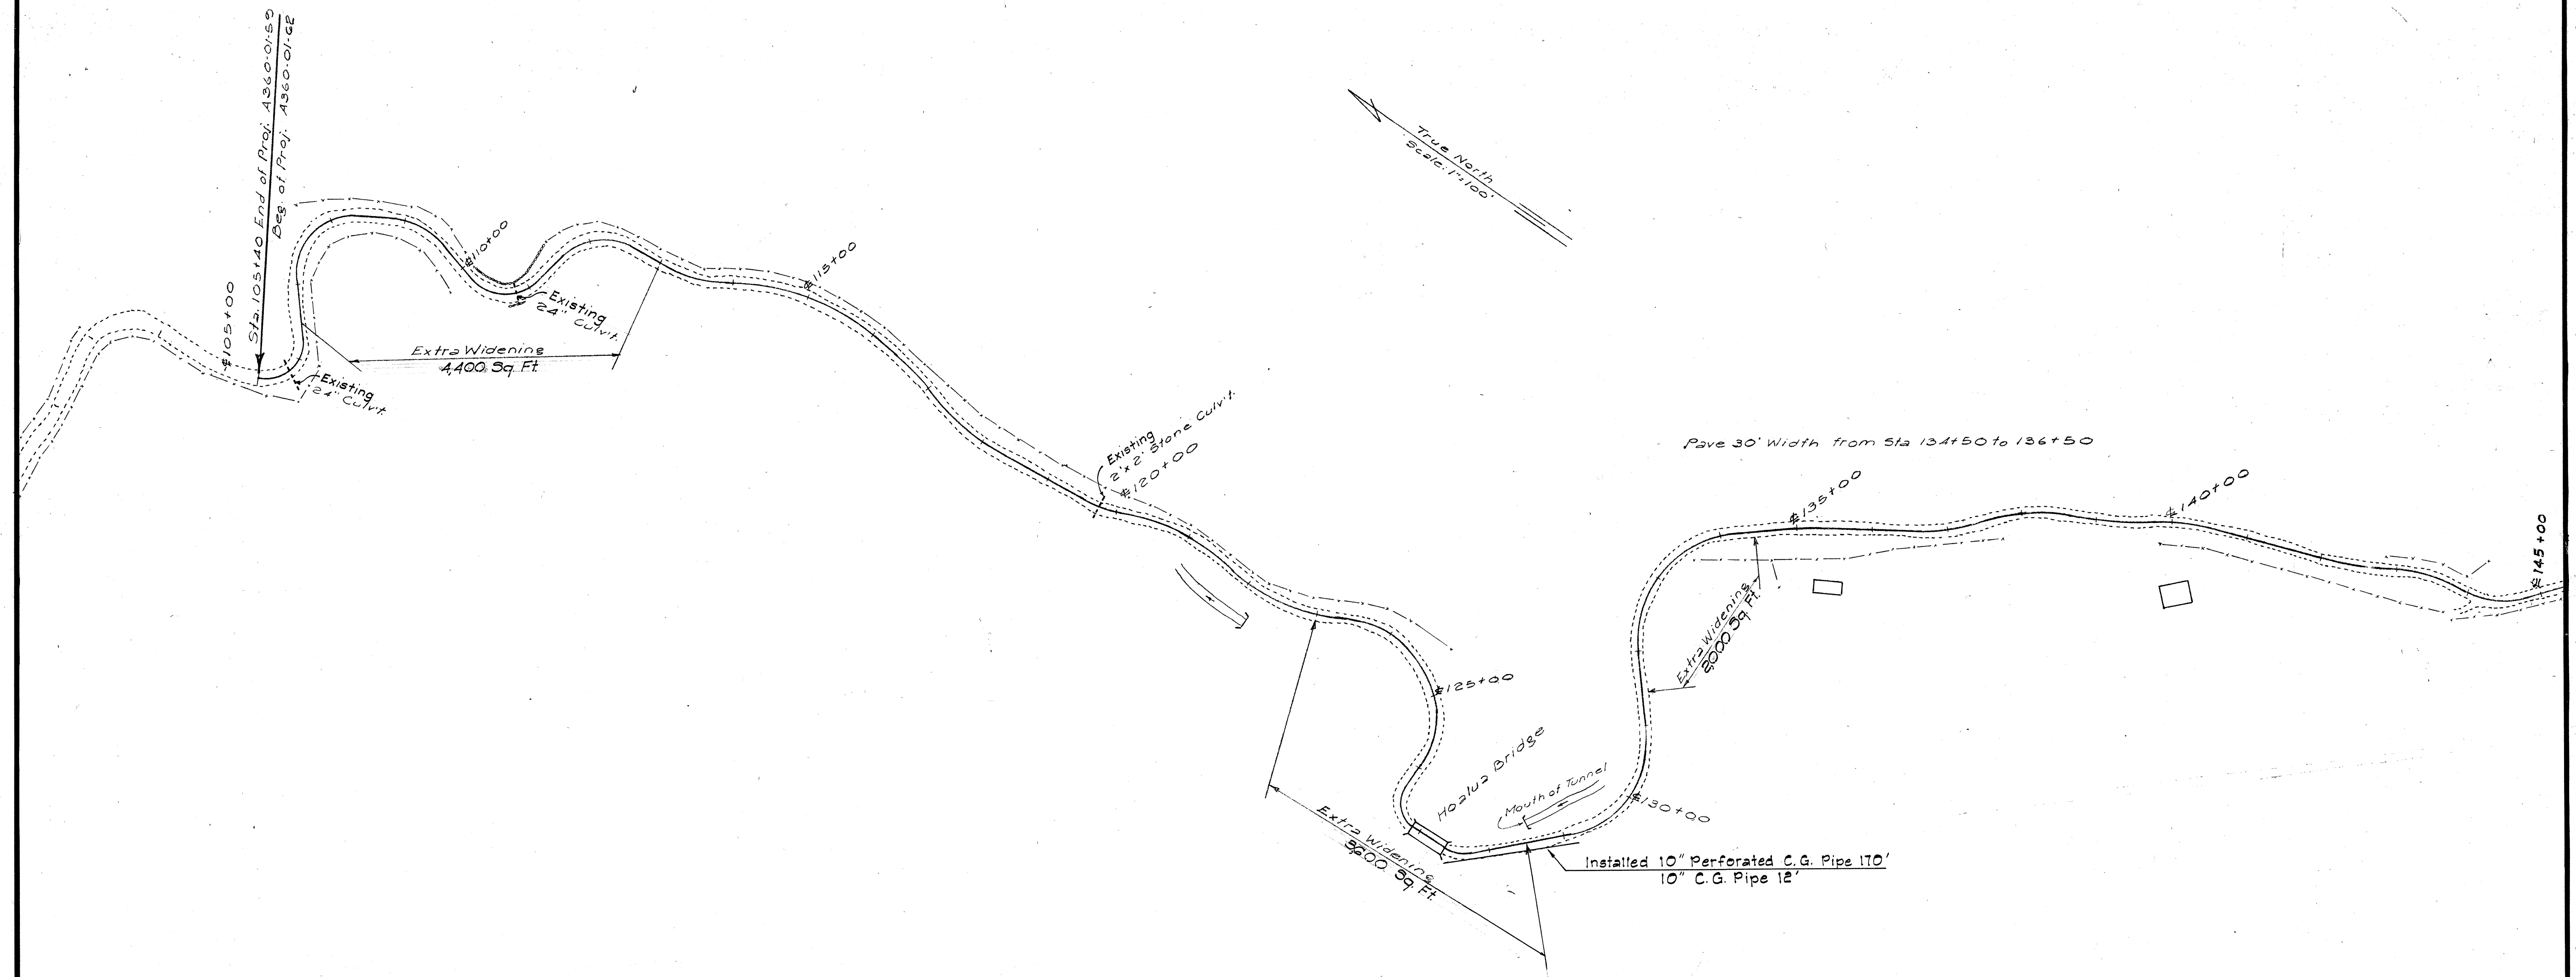


NOTE: Two sets of stationings are used on these plans

1. Stations shown adjacent to the circular symbols connected by solid lines are traverse transit points used for the topographic survey.
2. Stations preceded by the center line symbol (C) are roadway stations established by scaling the existing road. These stations are shown on the plans only to help establish locations and estimate quantities.


DEPARTMENT OF TRANSPORTATION
HIGHWAYS DIVISION
STATE OF HAWAII
RESURFACING A PORTION OF
HANA BELT ROAD
(KAILUA TO HONOMANU)
PROJ. NO A360-01-62

RD. ROAD DIST. NO.	STATE	PROJ. NO.	FISCAL YEAR	SHEET NO.	TOTAL SHEETS
HAWAII	HAW	A-360-01-62	1962	5	11

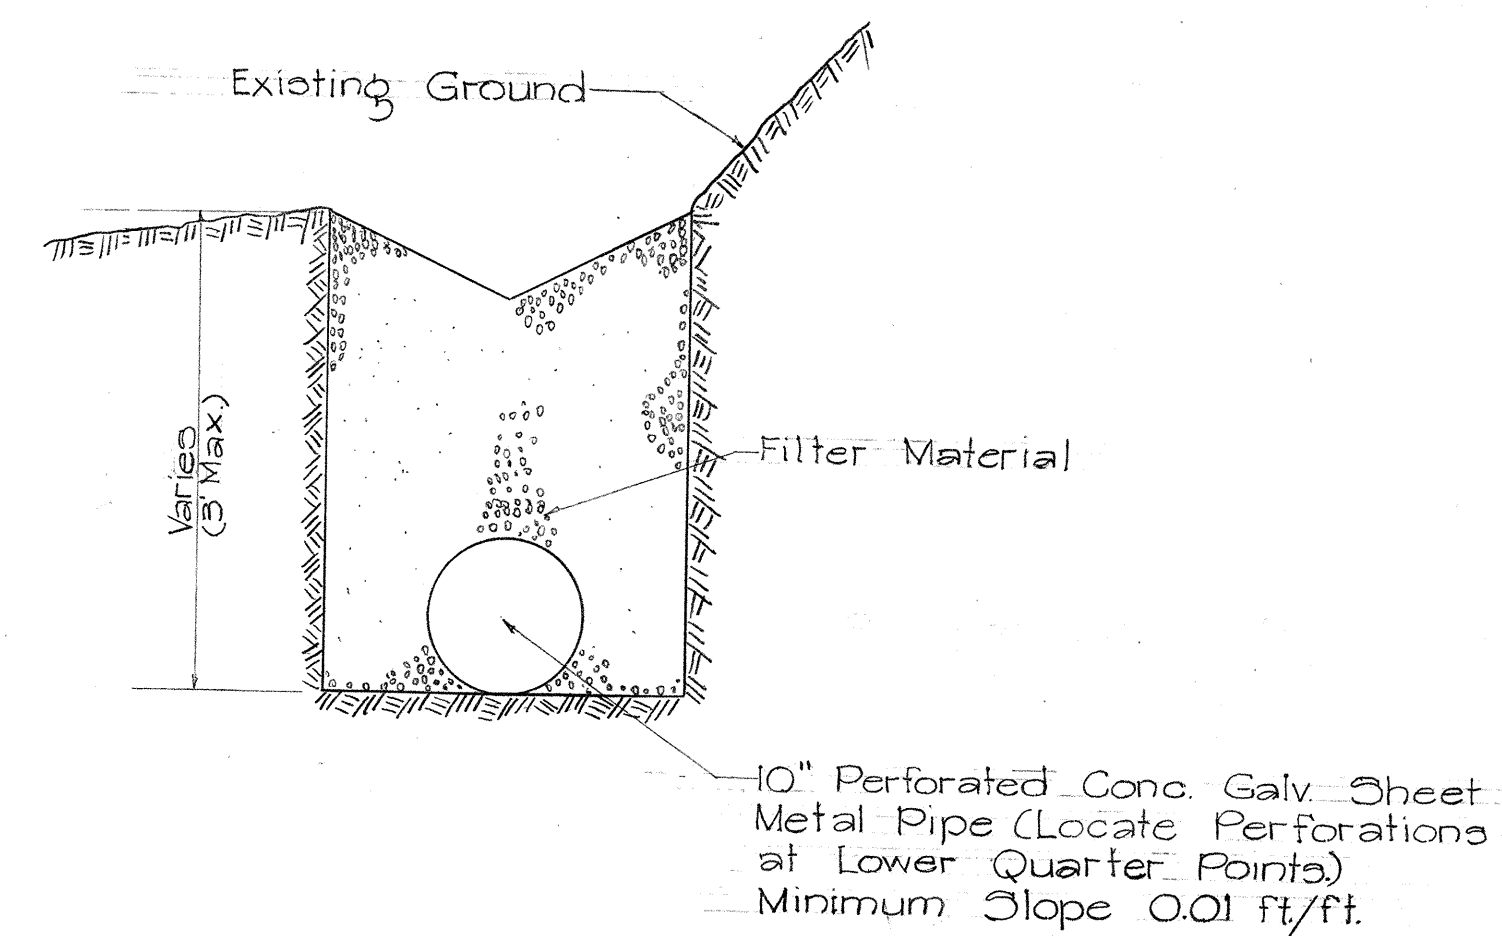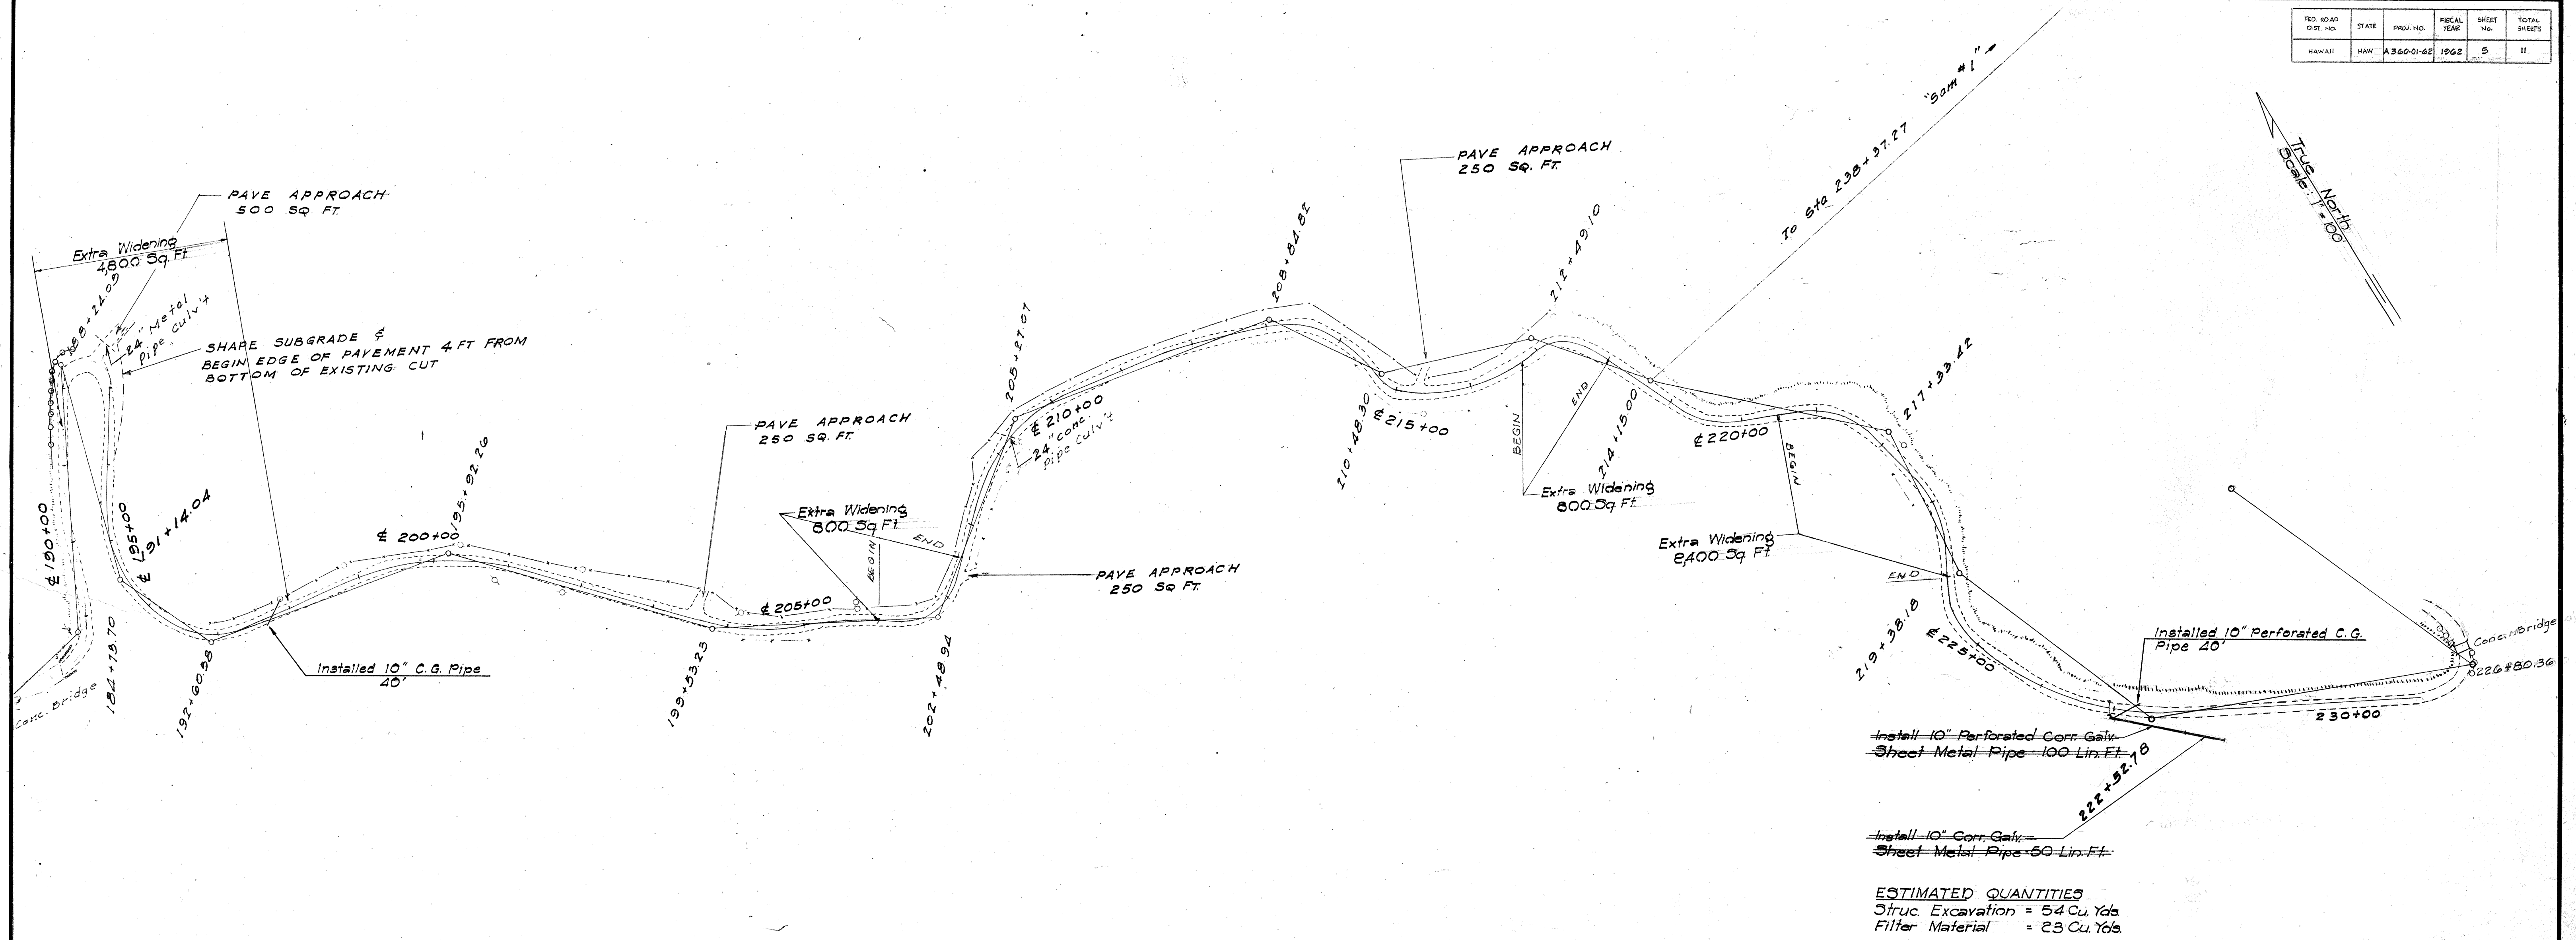

DEPARTMENT OF TRANSPORTATION
HIGHWAYS DIVISION
STATE OF HAWAII
RESURFACING A PORTION OF
HANA BELT ROAD
(KAILUA TO HONOMANU)
PROJ. NO. A-360-01-62


FED. ROAD DIST. NO.	STATE	FED. PROJ. NO.	FISCAL YEAR	SHEET NO.	TOTAL SHEETS
HAWAII	HAW.	A360-01-62	1962	6	11

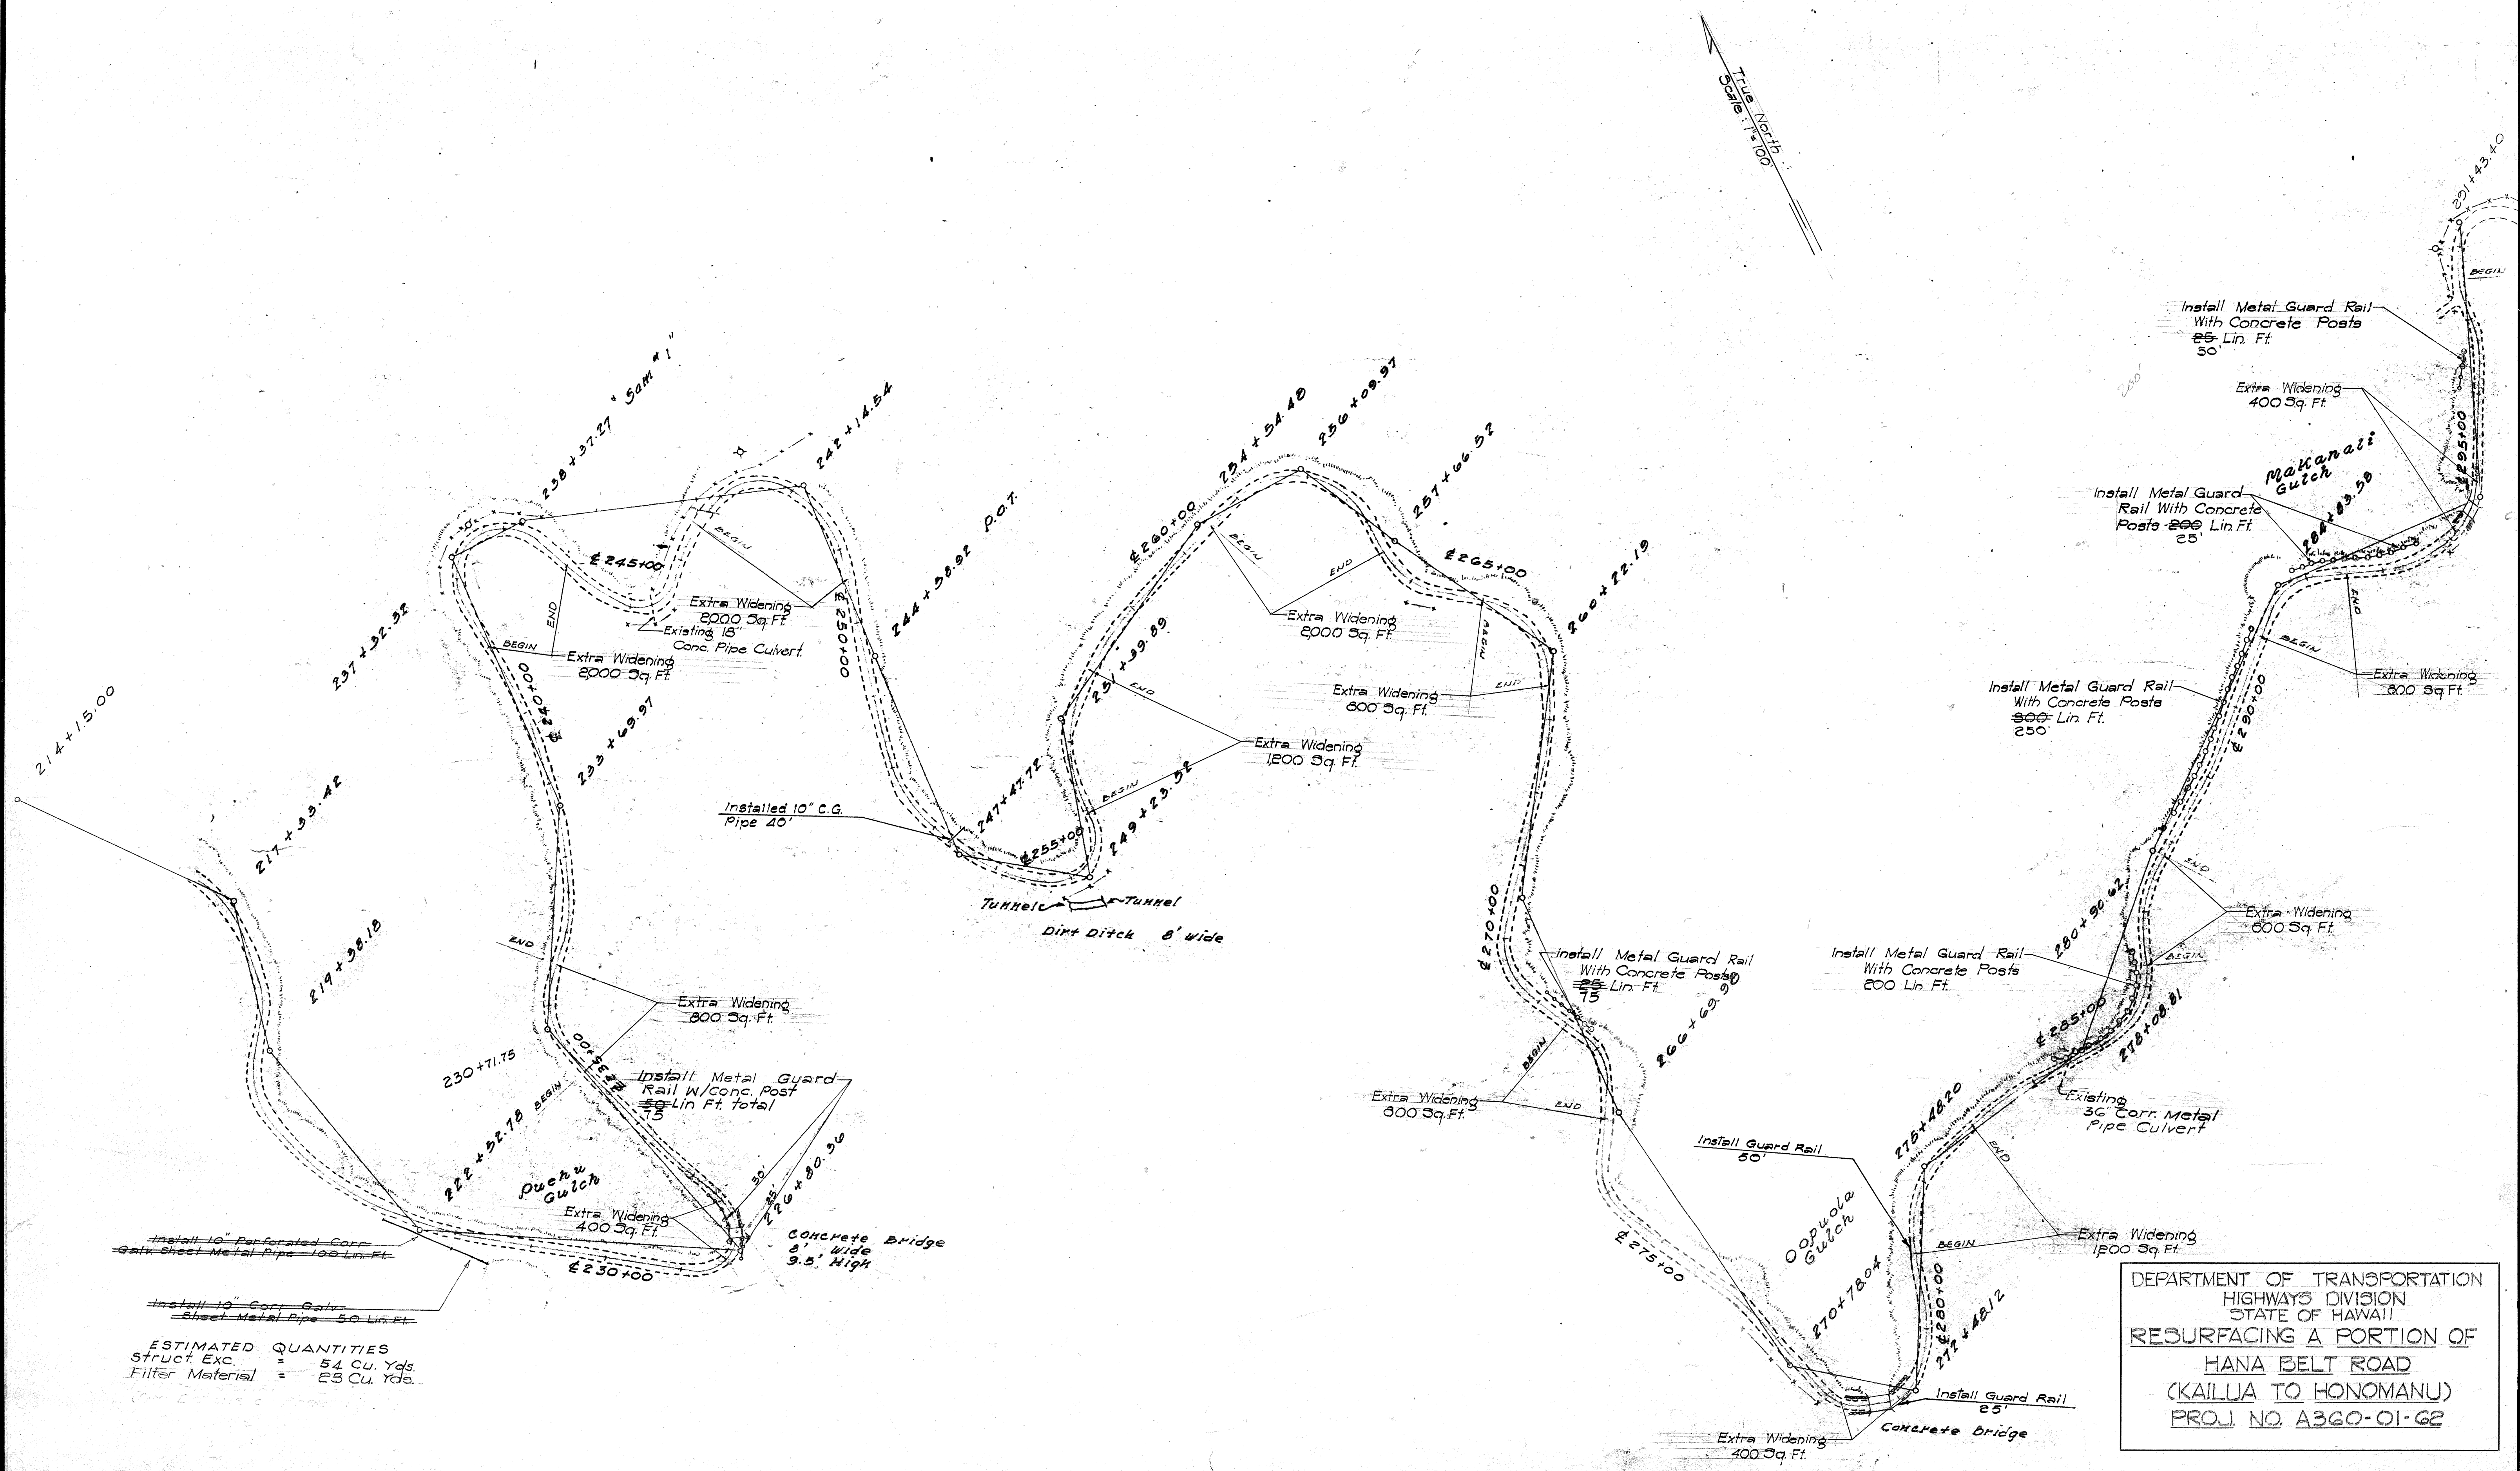

ESTIMATED QUANTITIES
 Struct. Exc. = 54 Cu. Yds.
 Filter Material = 23 Cu. Yds.

DEPARTMENT OF TRANSPORTATION
 HIGHWAYS DIVISION
 STATE OF HAWAII
 RESURFACING A PORTION OF
 HANA BELT ROAD
 (KAILUA TO HONOMANU)
 PROJ. NO. A360-01-62


FED. ROAD DIST. No.	STATE	PROJ. No.	FISCAL YEAR	SHEET No.	TOTAL SHEETS
HAWAII	HAW.	A360-01-62	1962	8	11

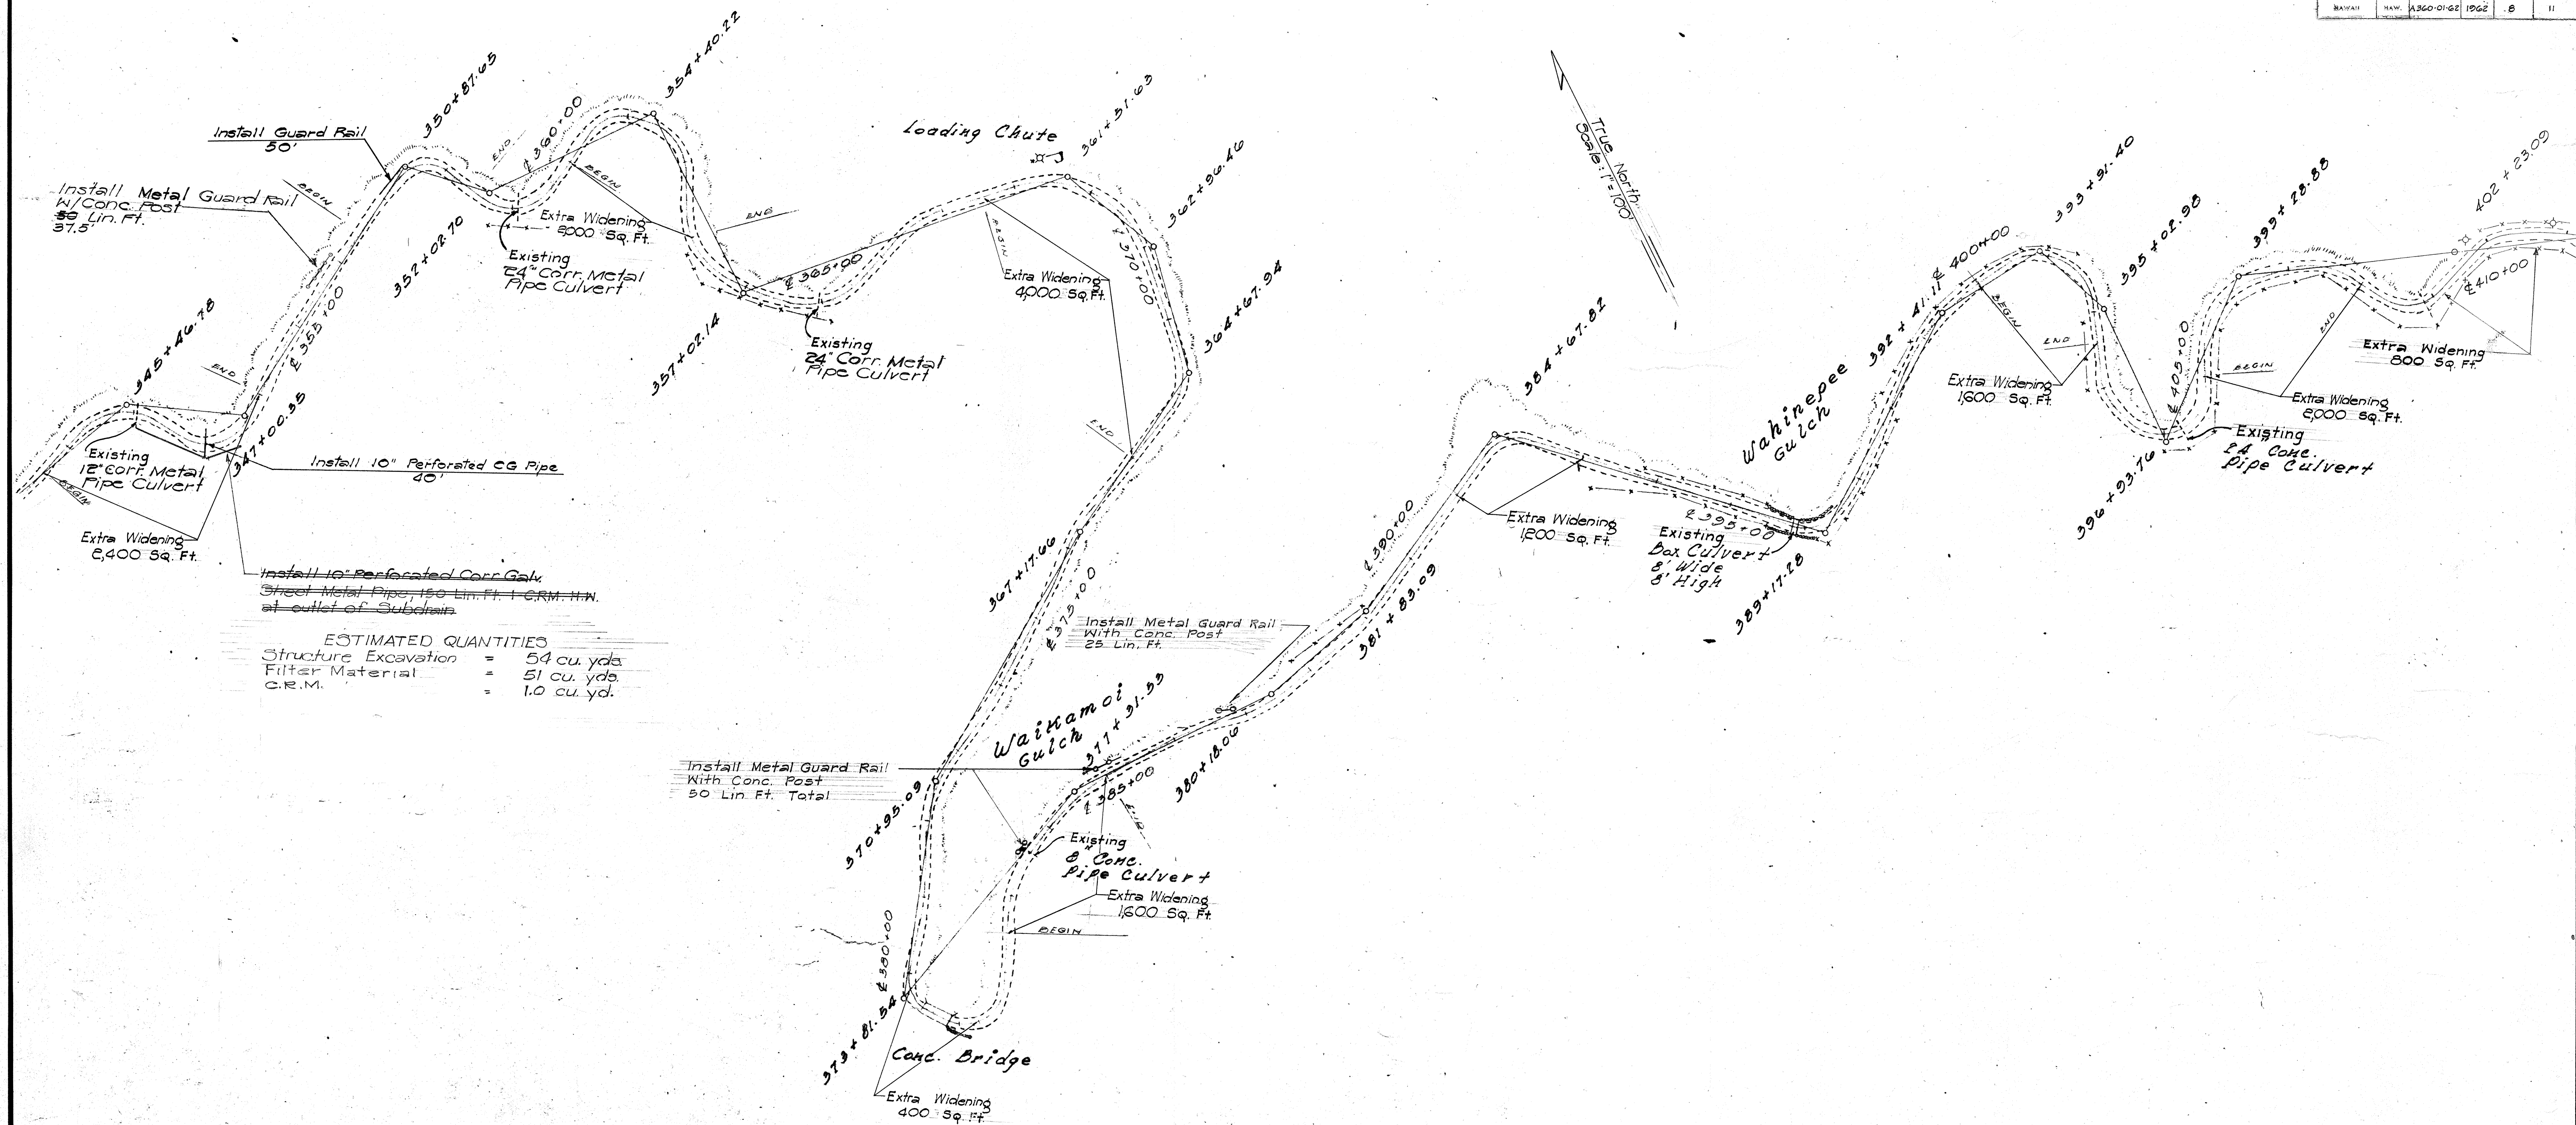

ESTIMATED QUANTITIES
 Structure Excavation = 54 cu. yds.
 Filter Material = 51 cu. yds.
 C.R.M. = 1.0 cu. yd.

DEPARTMENT OF TRANSPORTATION
 HIGHWAYS DIVISION
 STATE OF HAWAII
 RESURFACING A PORTION OF
 HANA BELT ROAD
 (KAILUA TO HONOMANU)
 PROJ. NO. A360-01-62


FED. ROAD DIST. NO.	STATE	FISCAL YEAR	SHEET NO.	TOTAL SHEETS
HAWAII	101	1962	10	11

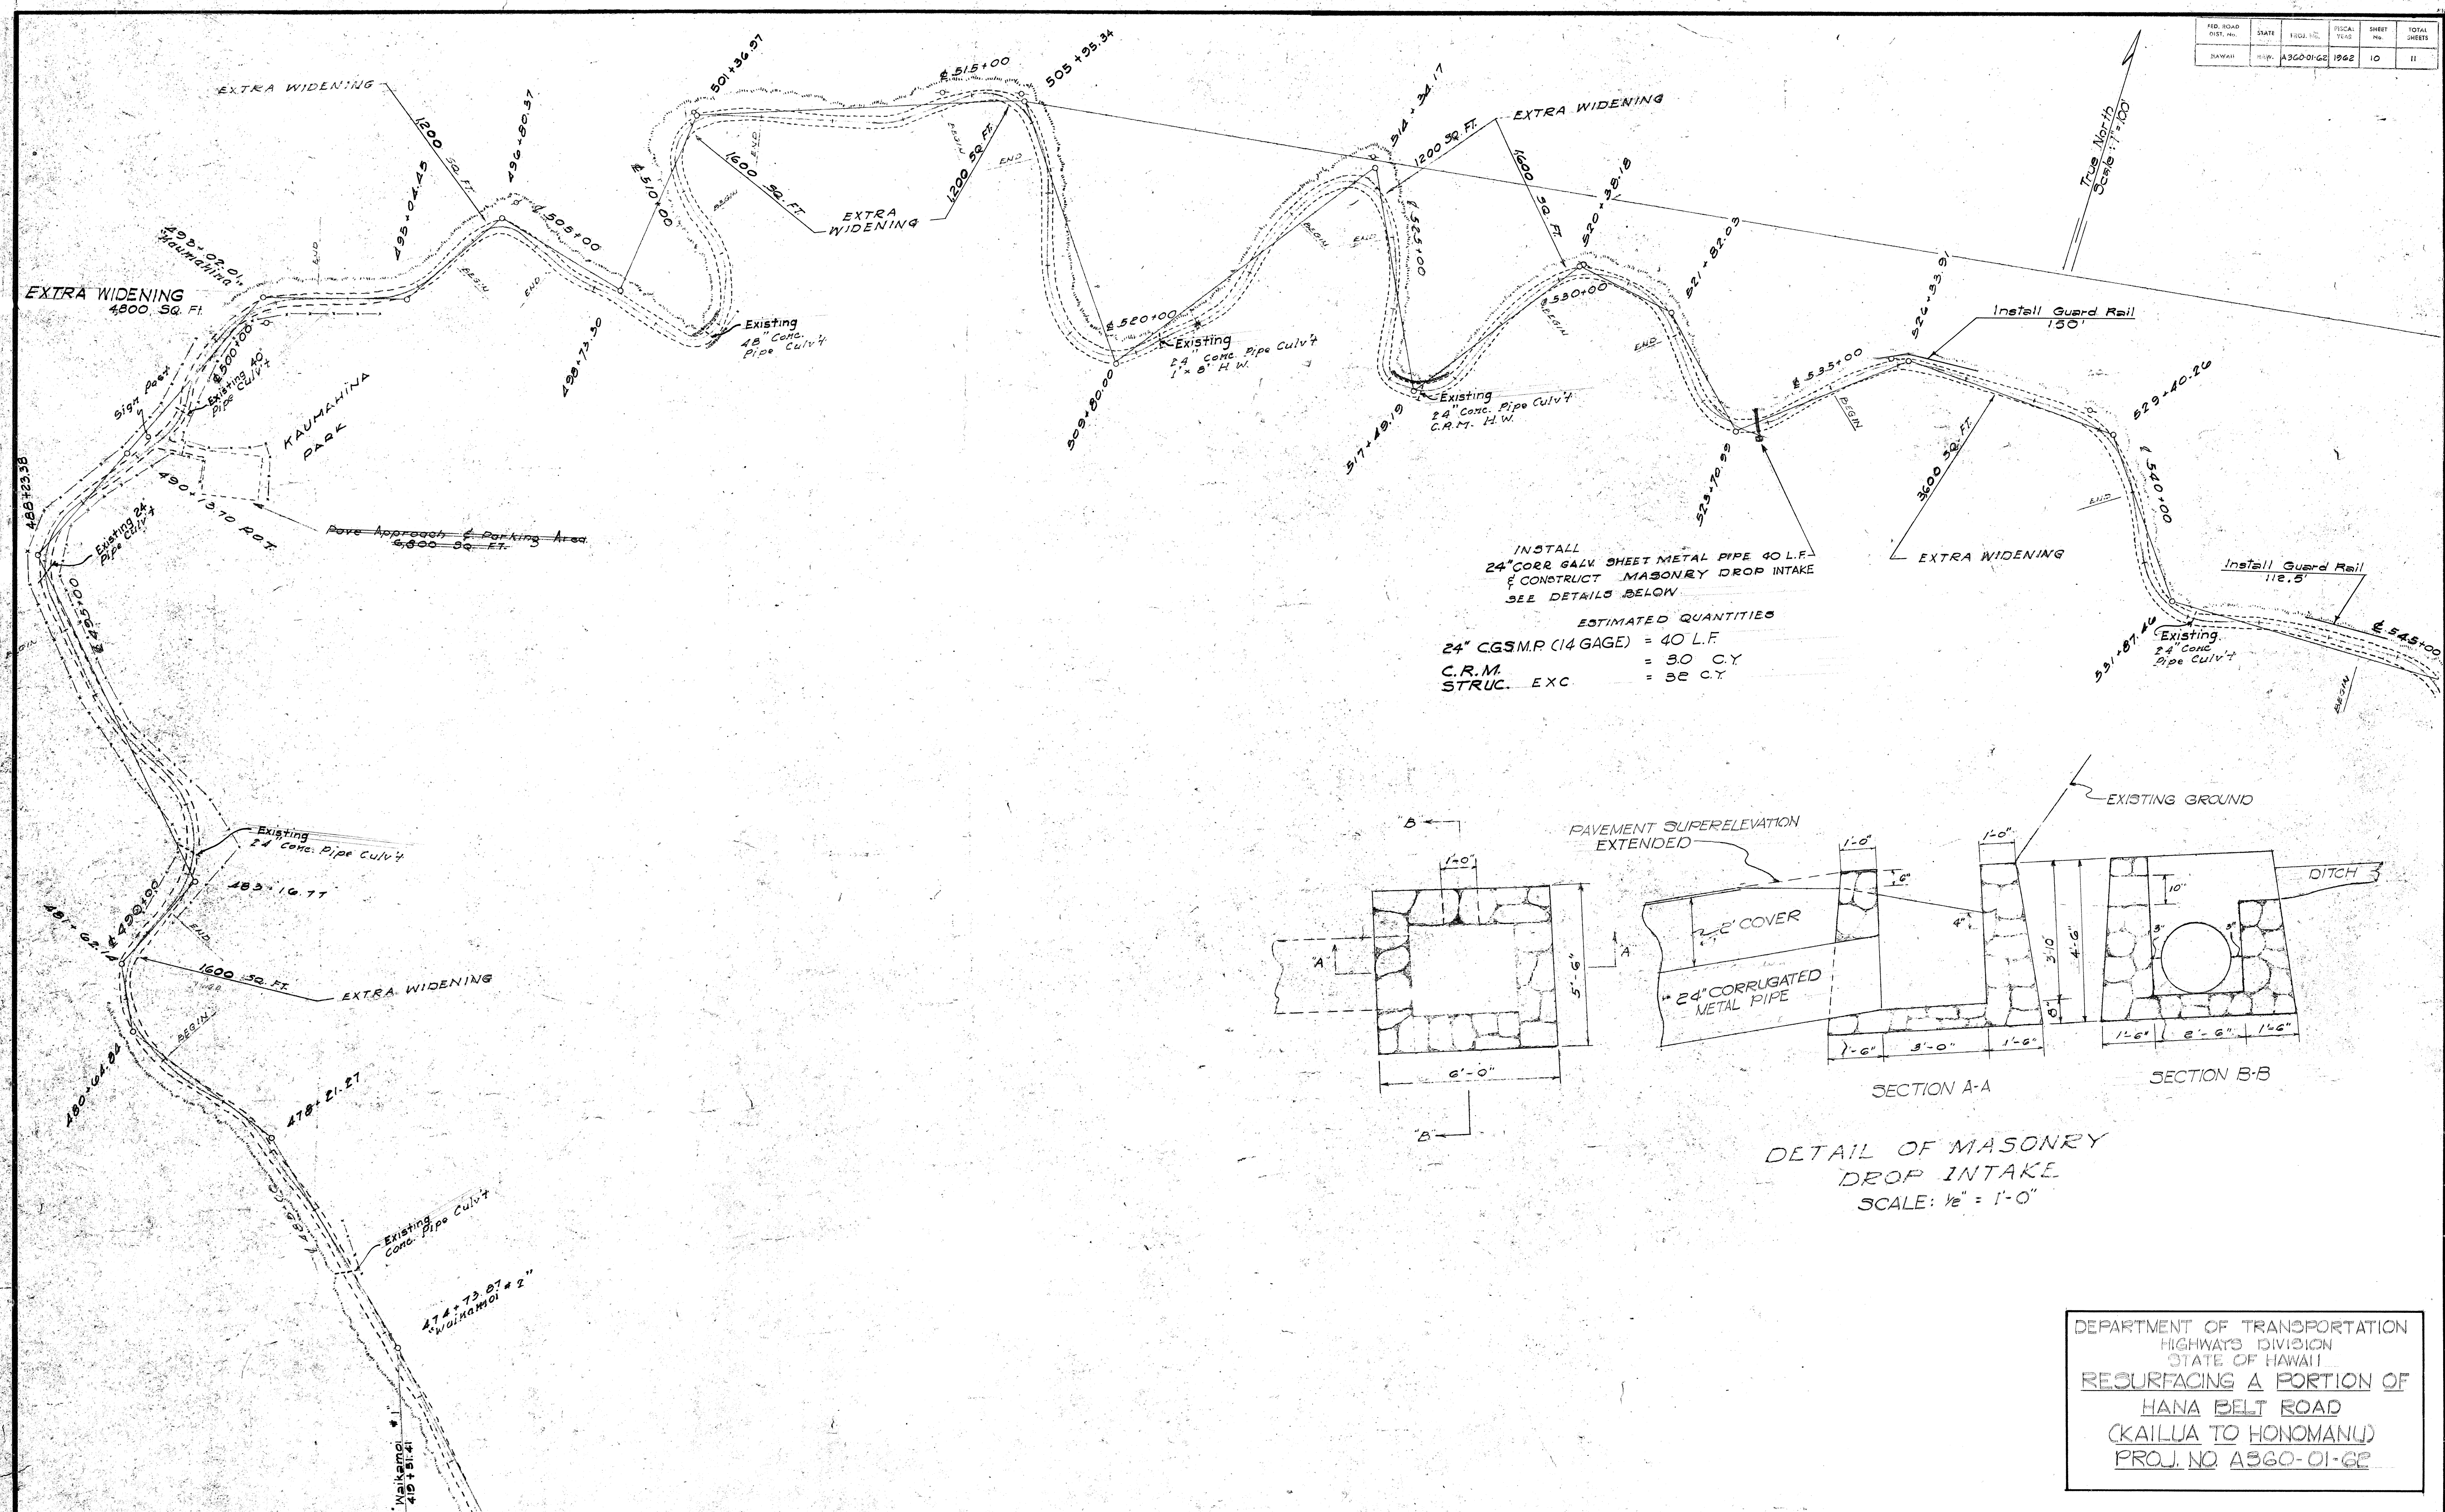

INSTALL
24" CORR. GALV. SHEET METAL PIPE 40 L.F.
& CONSTRUCT MASONRY DROP INTAKE
SEE DETAILS BELOW


ESTIMATED QUANTITIES

24" CGS.M.P. (14 GAGE)	= 40 L.F.
C.R.M.	= 30 C.Y.
STRUC. EXC.	= 32 C.Y.

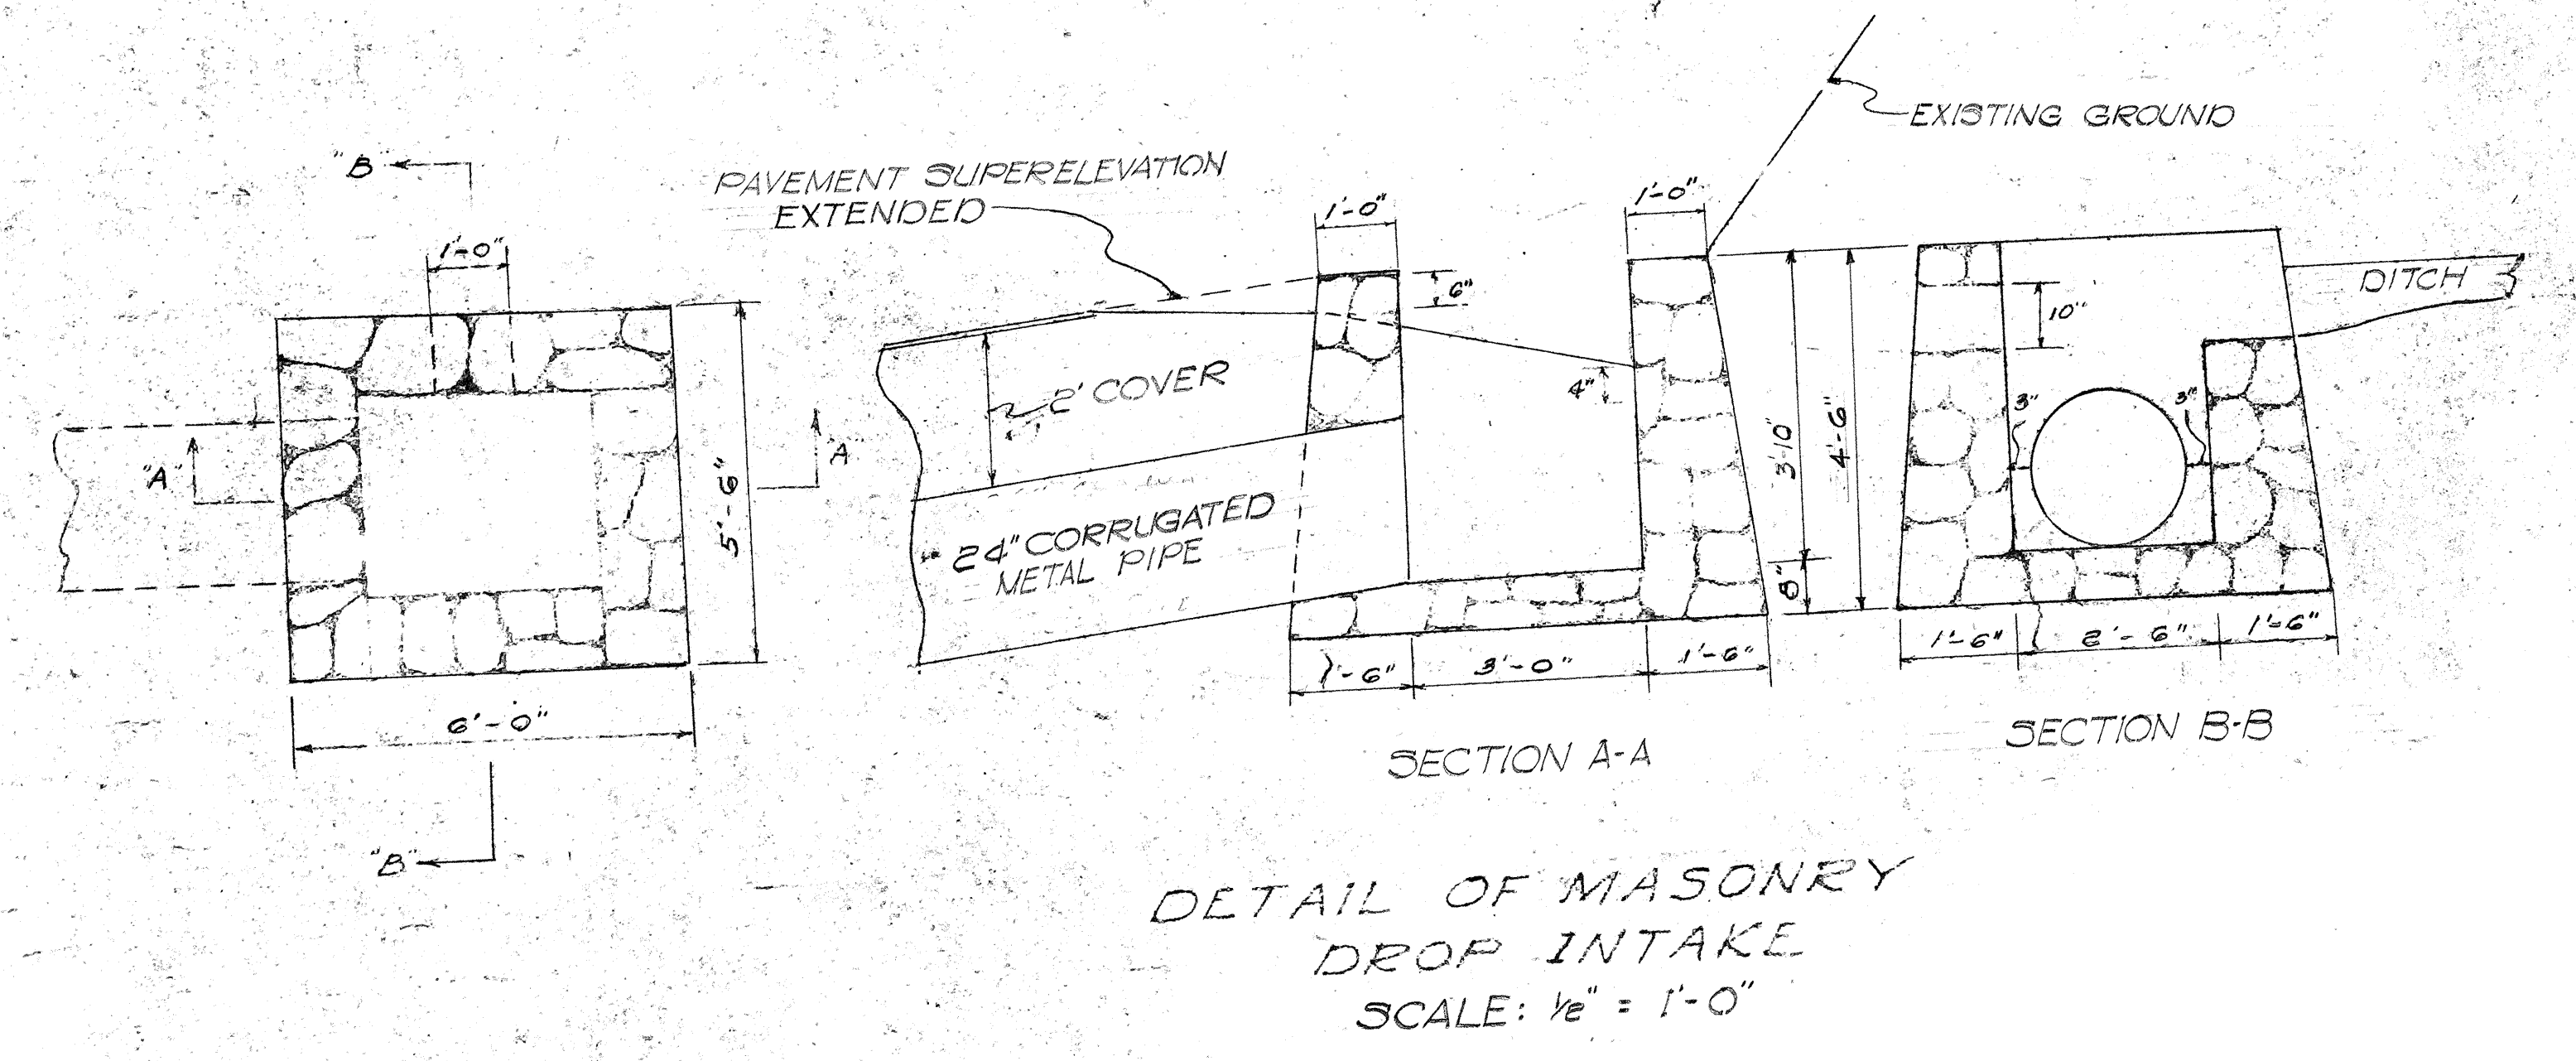

DEPARTMENT OF TRANSPORTATION
HIGHWAYS DIVISION
STATE OF HAWAII
RESURFACING A PORTION OF
HANA BELT ROAD
(KAILUA TO HONOMANU)
PROJ. NO. A360-01-62

FED. ROAD DIST. NO.	STATE	PROJ. NO.	FISCAL YEAR	SHEET NO.	TOTAL SHEETS
SAVAH	HA	A360-01-62	1962	11	11

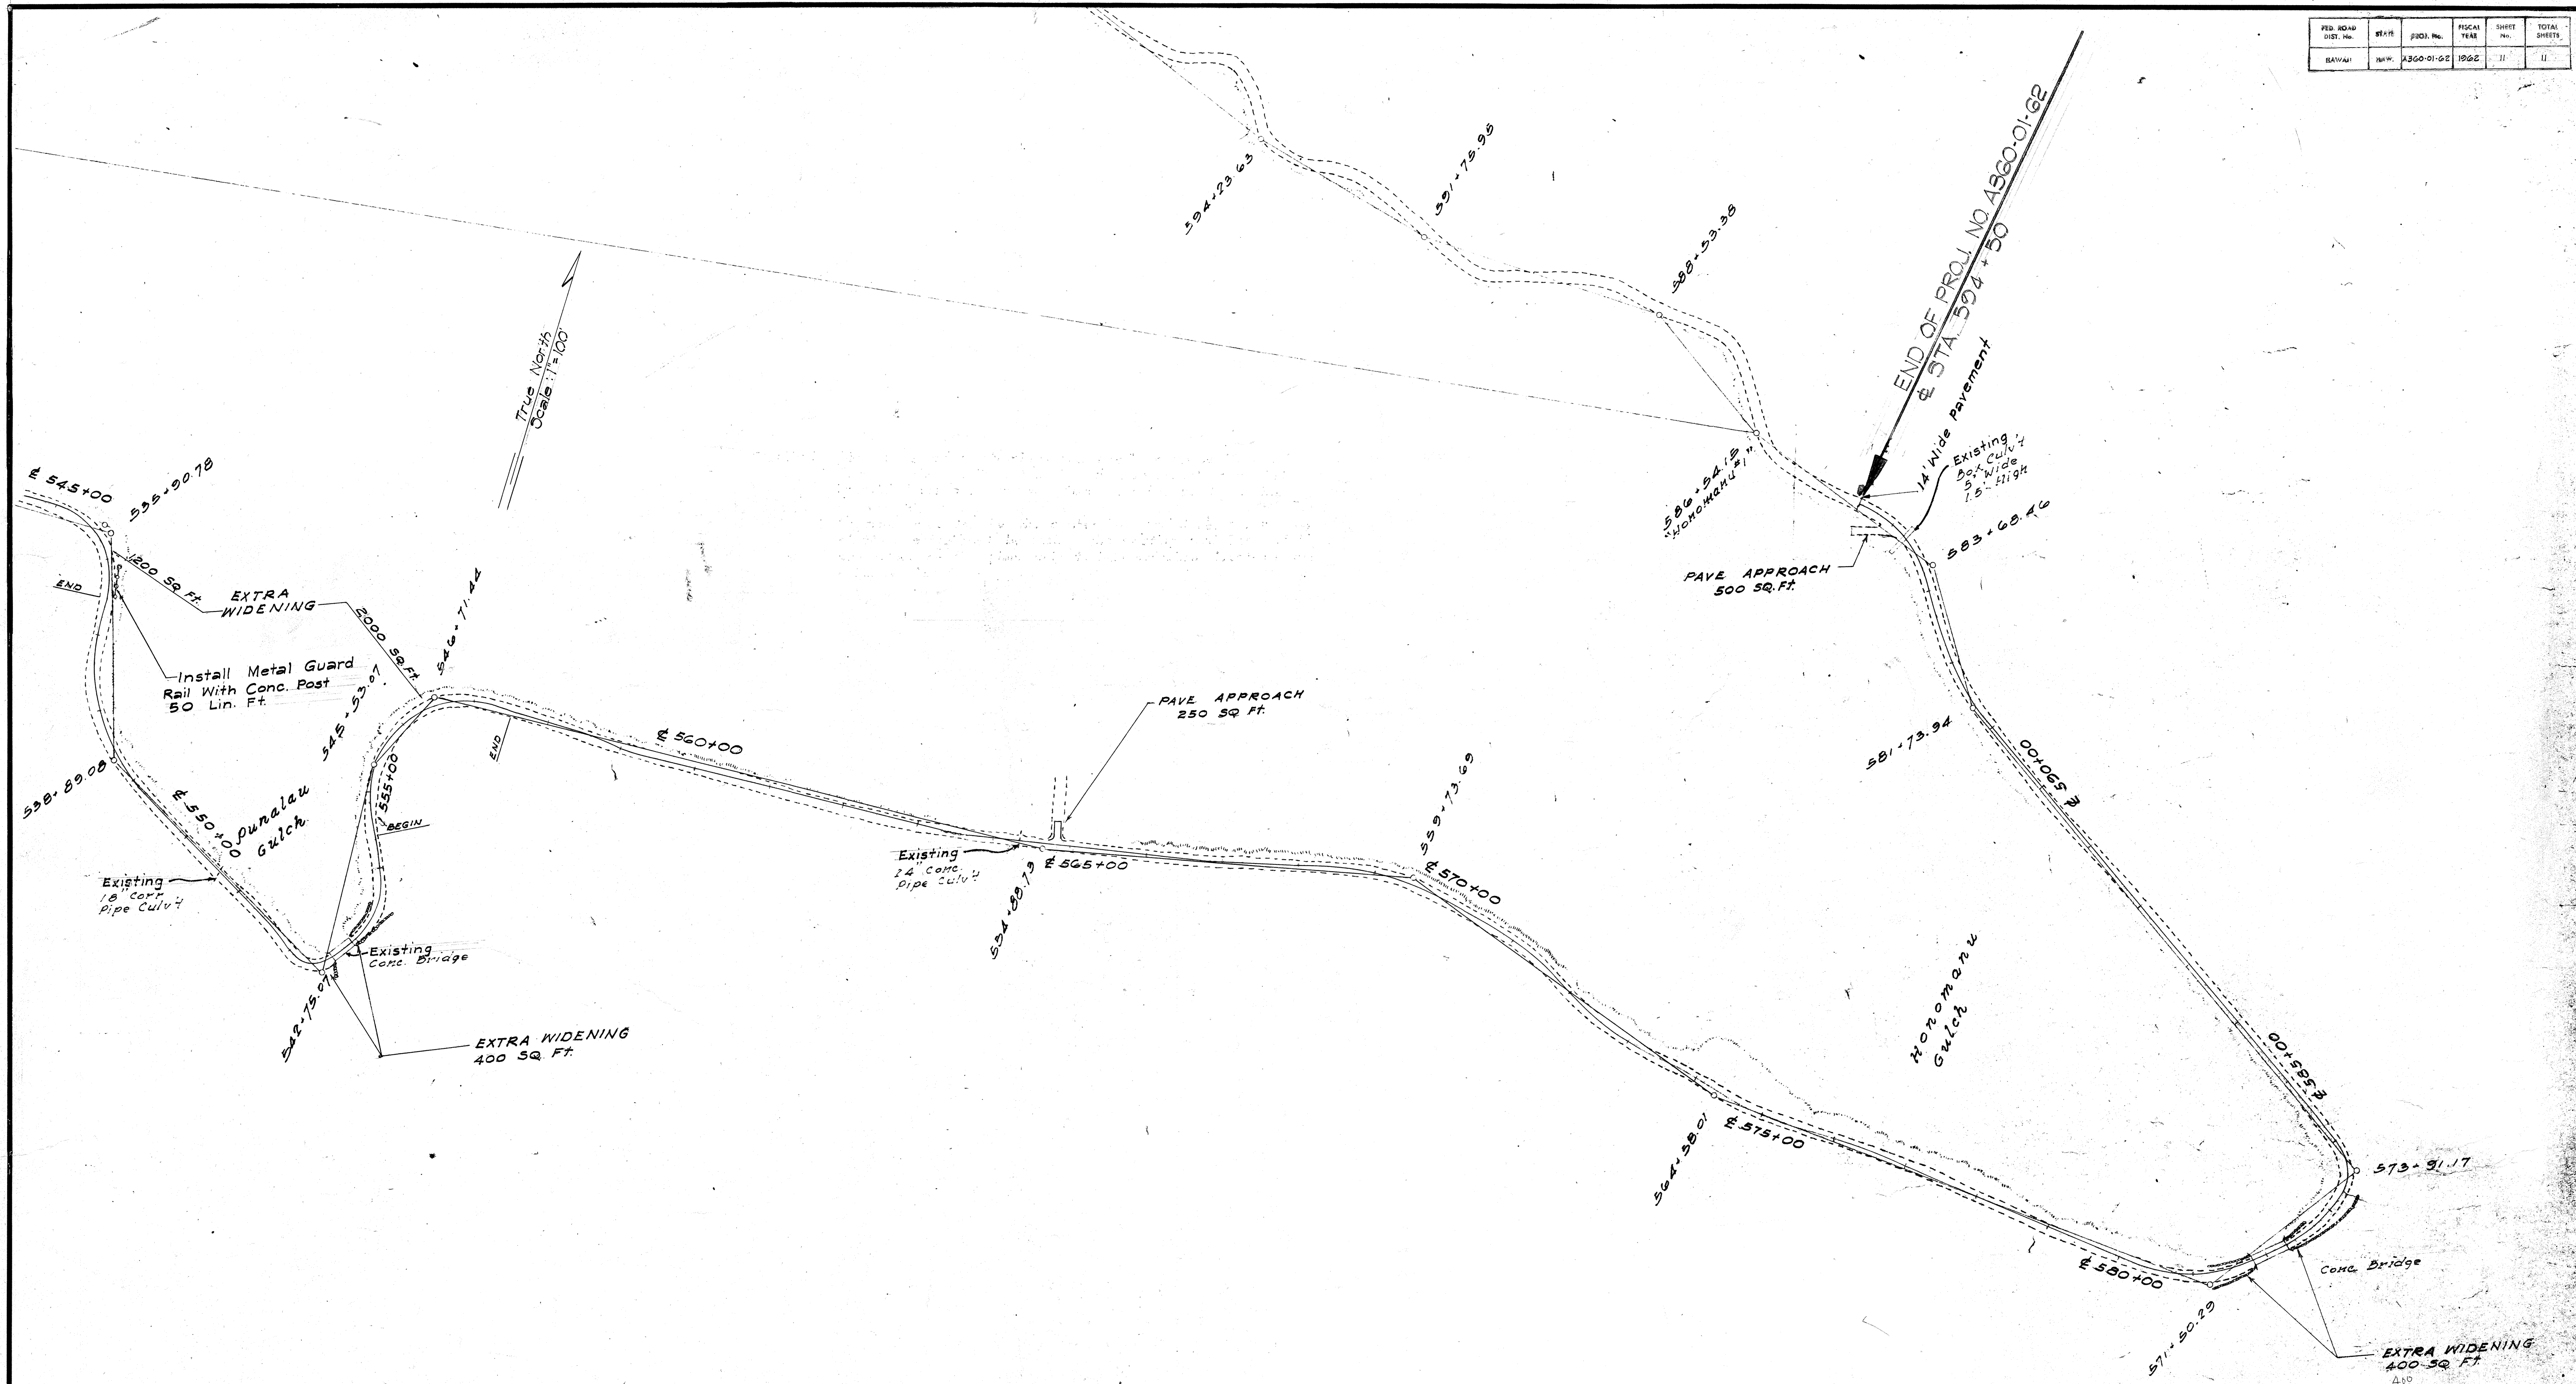

DEPARTMENT OF TRANSPORTATION
 HIGHWAYS DIVISION
 STATE OF HAWAII
 RESURFACING A PORTION OF
 HANA BELT ROAD
 (KAILUA TO HONOMANU)
 PROJ. NO A-360-01-62