

INDEX TO DRAWINGS	
SHEET NO.	DESCRIPTION
1	TITLE SHEET
2	TYPICAL SECTION
3-II	PLAN

STATE OF HAWAII

DEPARTMENT OF TRANSPORTATION

HIGHWAYS DIVISION

HONOLULU, HAWAII

"AS BUILT"

PLANS FOR

RESURFACING A PORTION OF



HANA BELT ROAD

(KAILUA TO HONOMANU)

PROJECT NO. A360-01-62

DISTRICT OF MAKAWAO

ISLAND OF MAUI

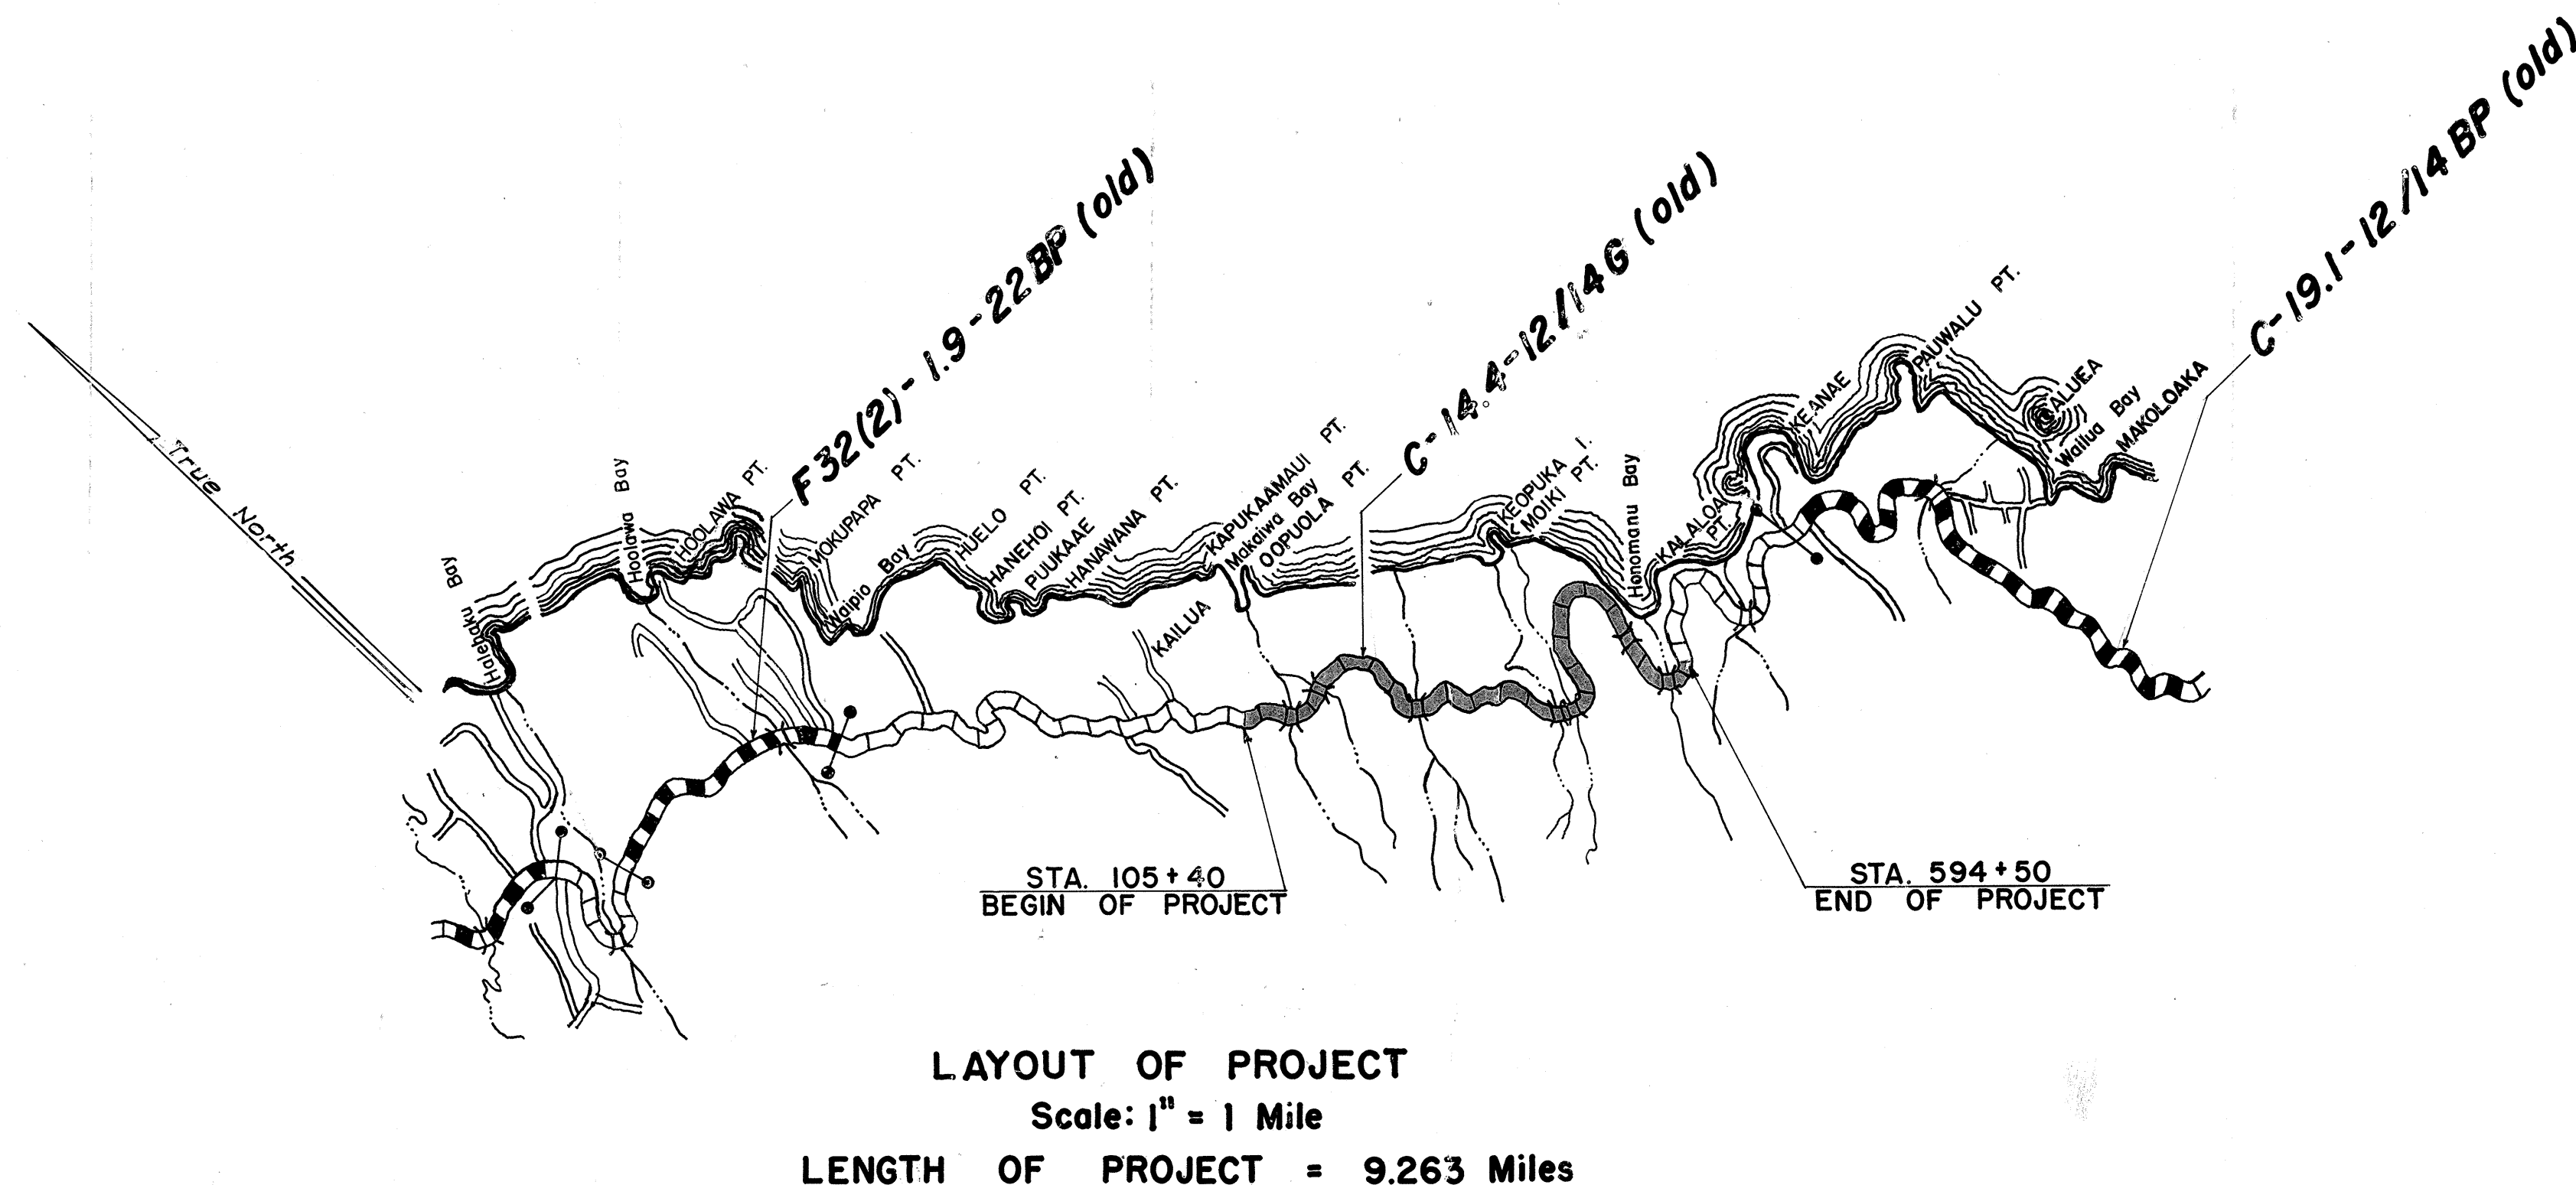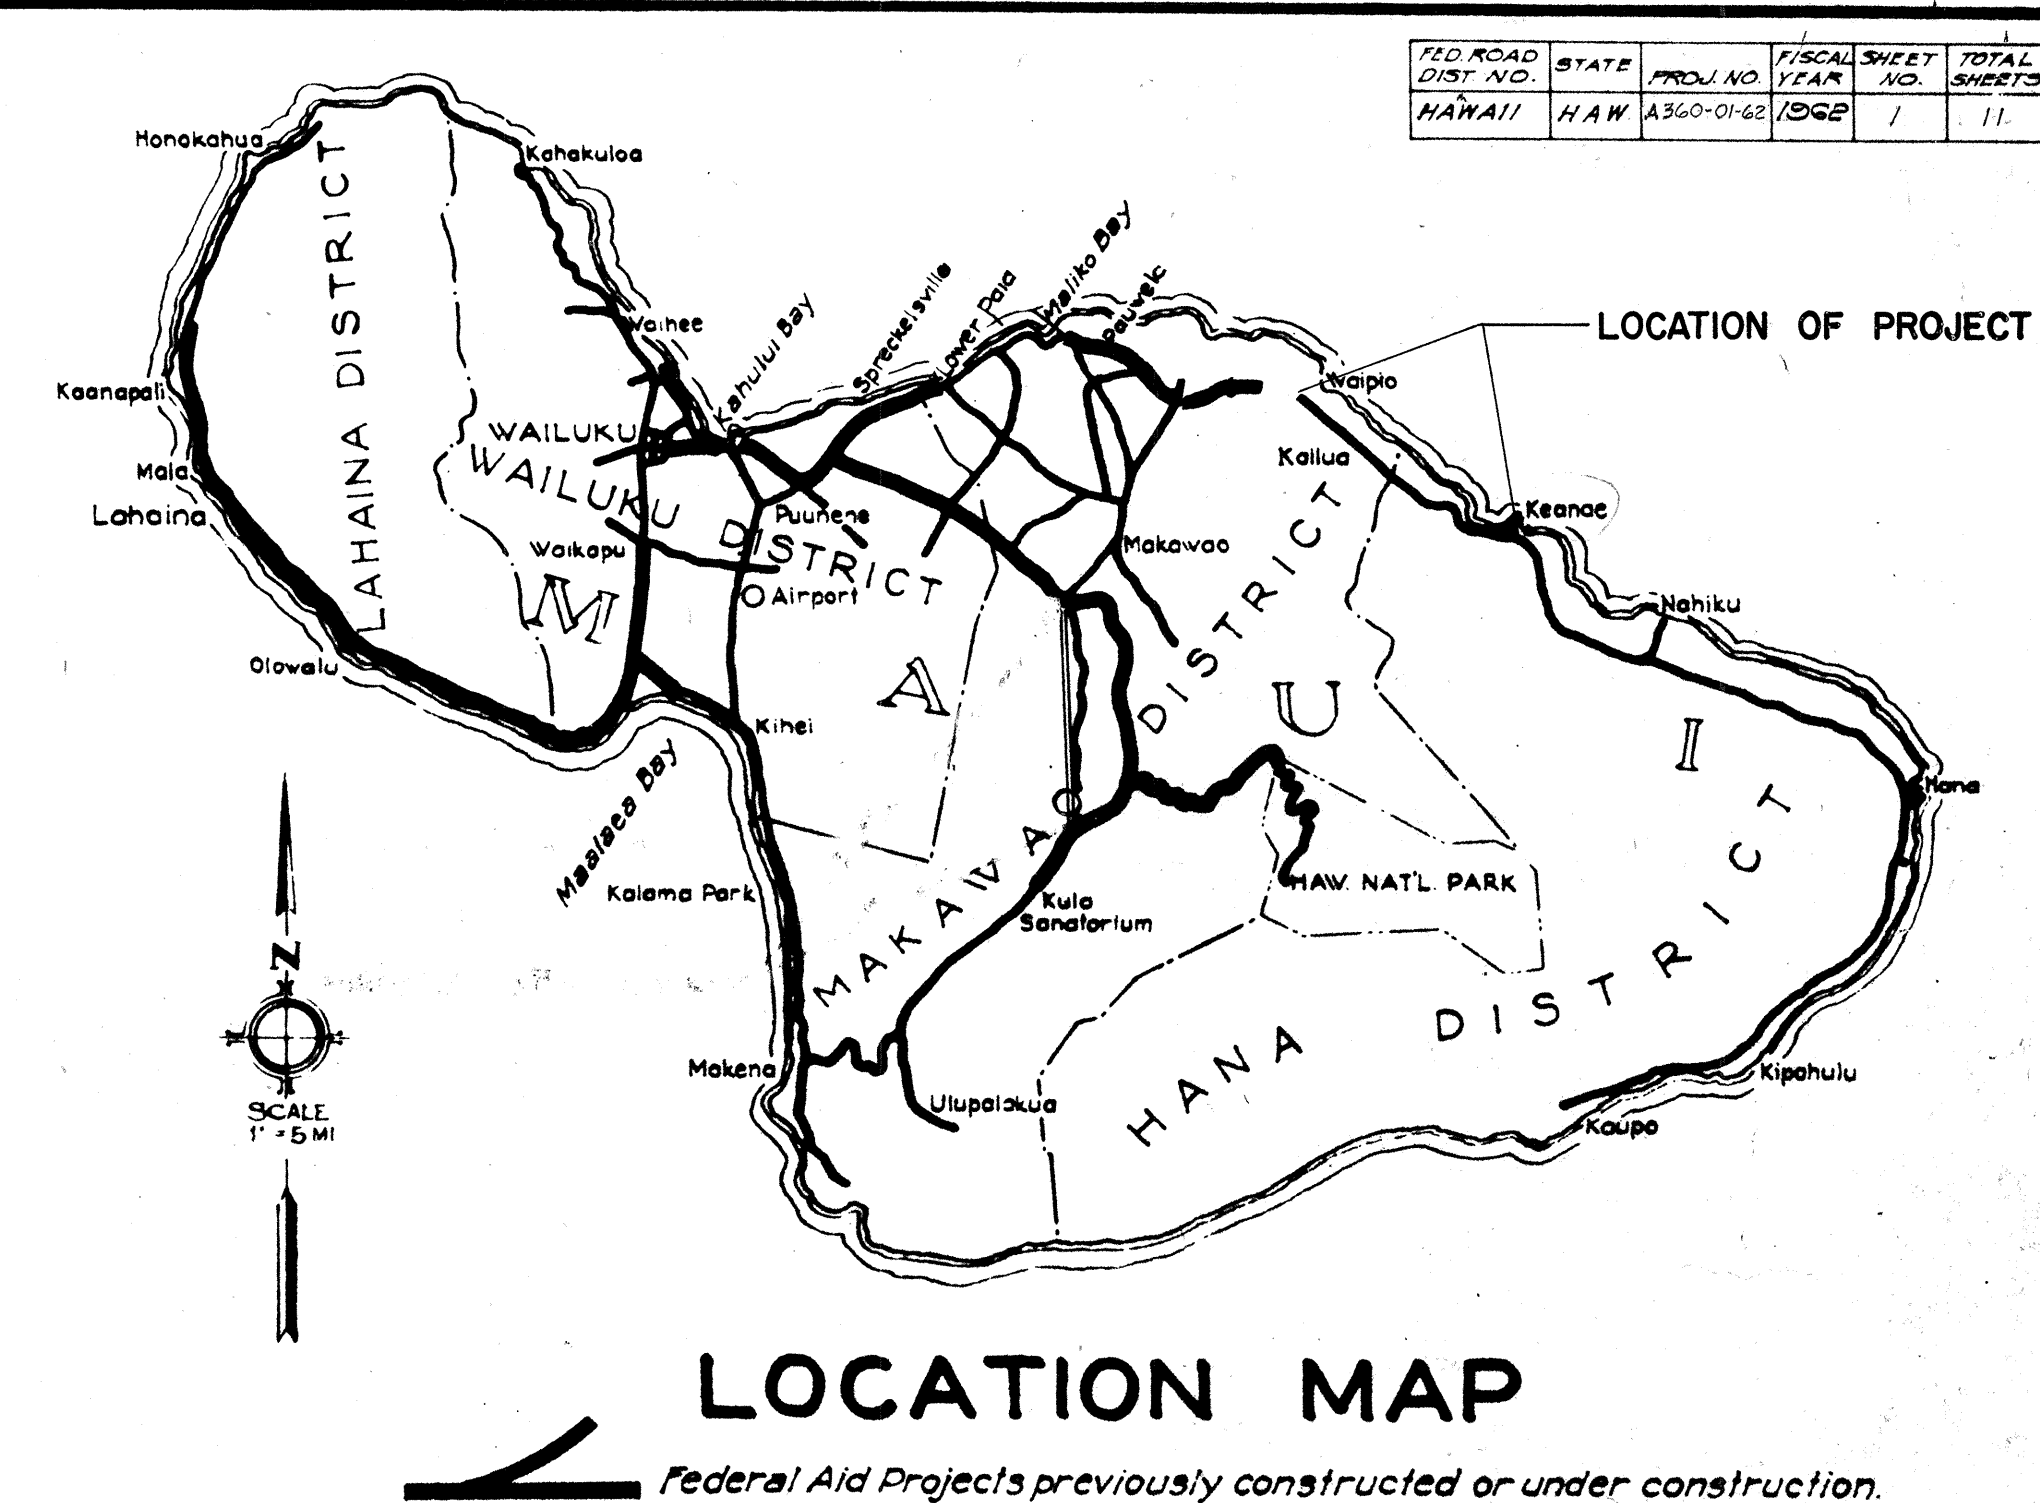

NOTE:
ALL CHANGES MADE DURING CONSTRUCTION
HAVE BEEN NOTED ON THESE TRACINGS IN
RED AND CHECKED BY:

Alfred C. Klahre
PROJECT ENGINEER
6/17/63
DATE

APPROVED DATE 7/2/62
Alfred C. Klahre
DIRECTOR OF TRANSPORTATION