


FED. ROAD DIST. No.	STATE	FED. AID PROJ. No.	FISCAL YEAR	SHEET No.	TOTAL SHEETS
HAWAII	HAW.	5-0360(3)	1963	18	38

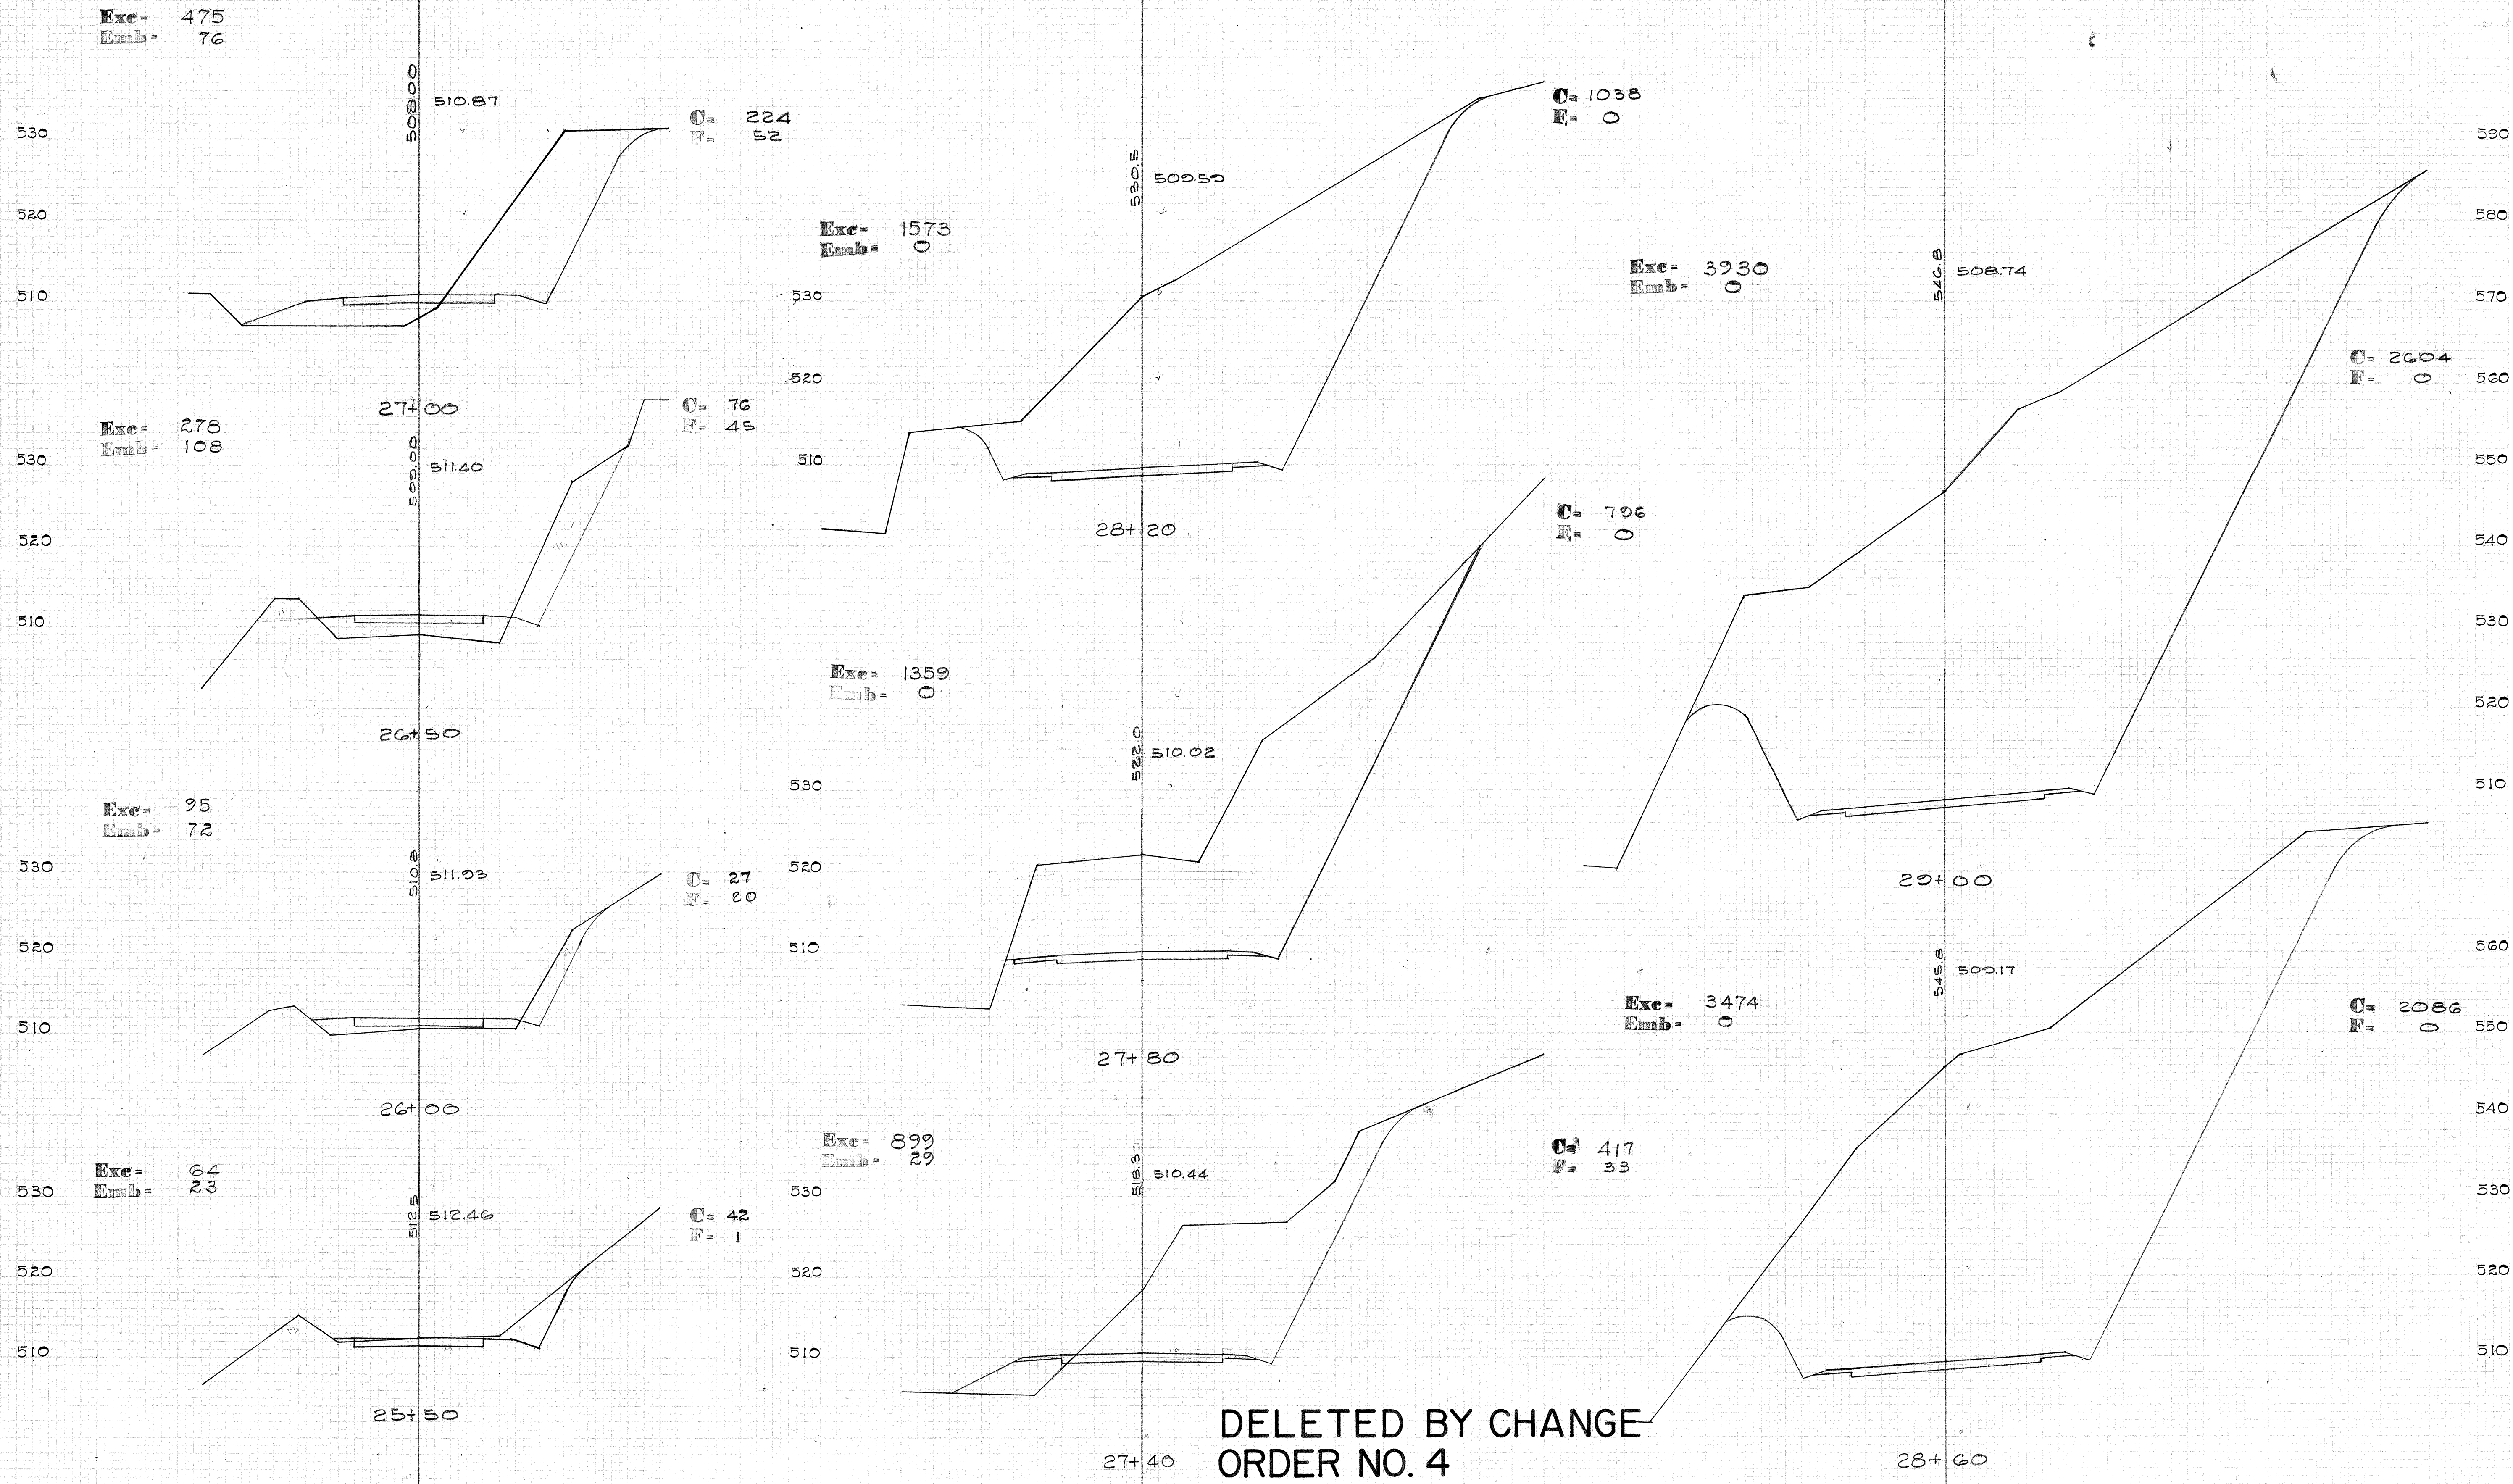


DELETED BY CHANGE
ORDER NO. 4


FED. ROAD DIST. NO.	STATE	FED. AID PROJ. NO.	FISCAL YEAR	SHEET NO.	TOTAL SHEETS
HAWAII	HAW.	3-03600	1963	19	38

DATE	BY	REVIEWED	DATE

DATE	BY	REVIEWED	DATE

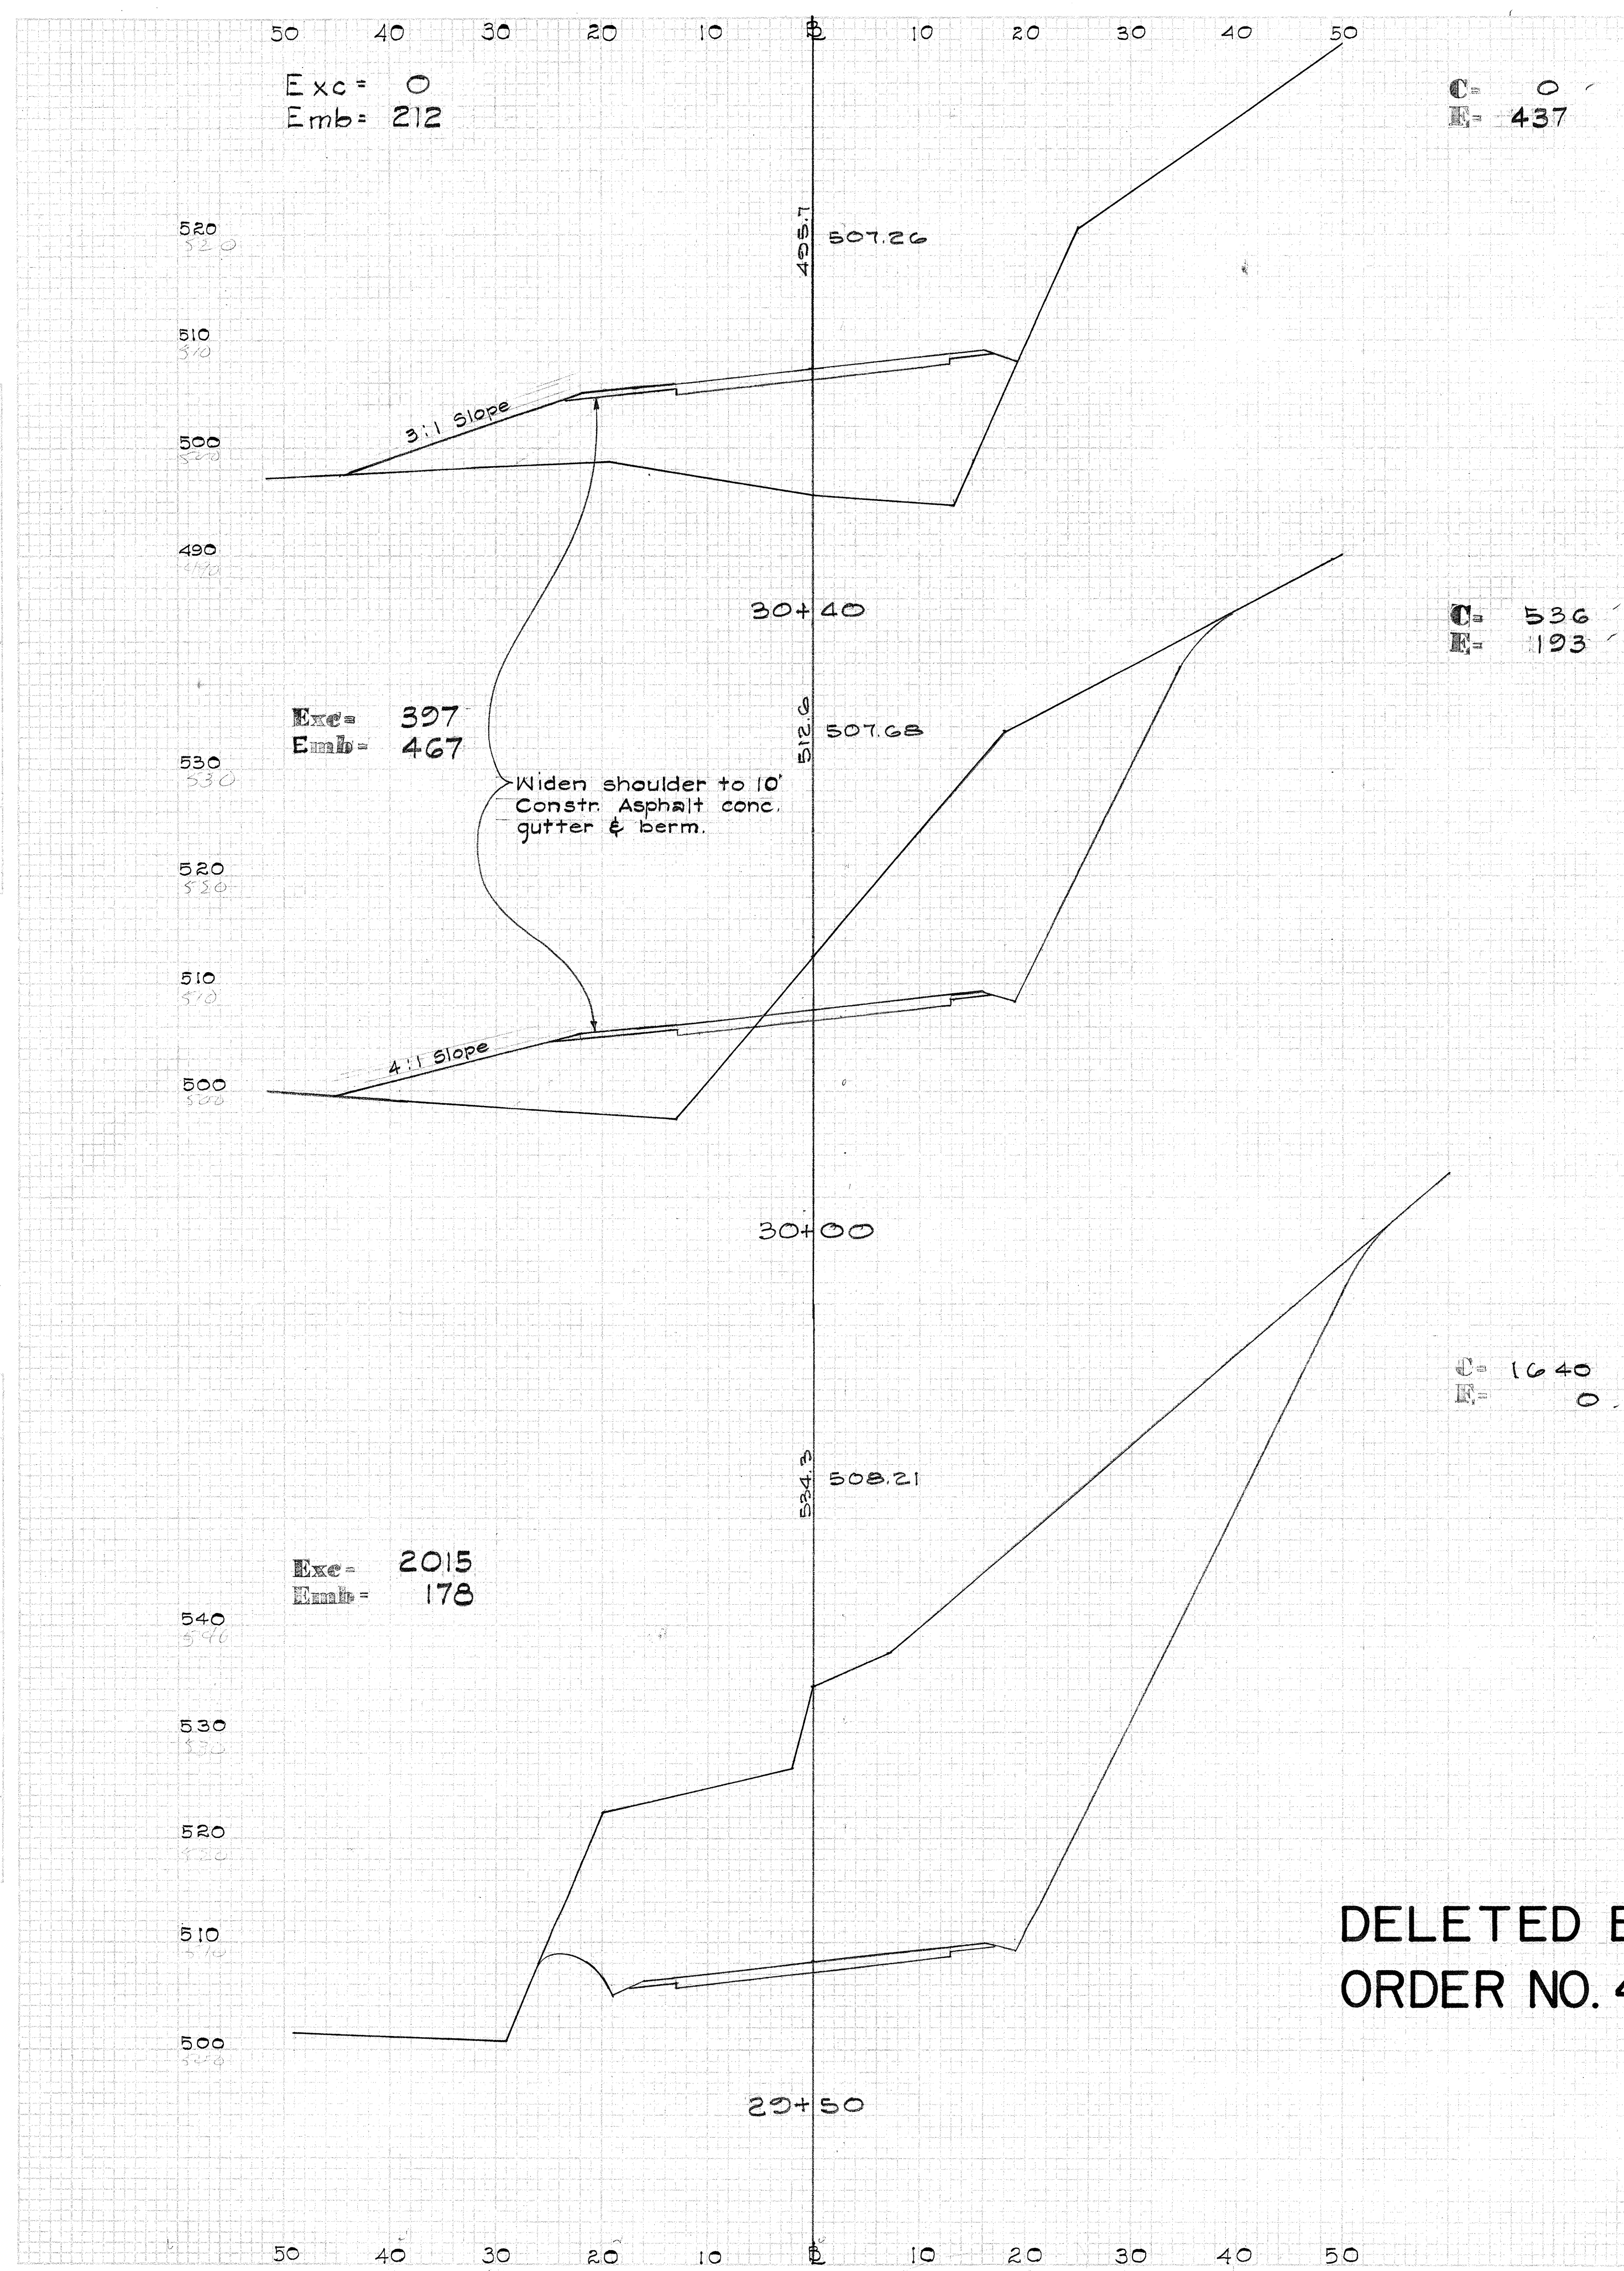

DELETED BY CHANGE
ORDER NO. 4

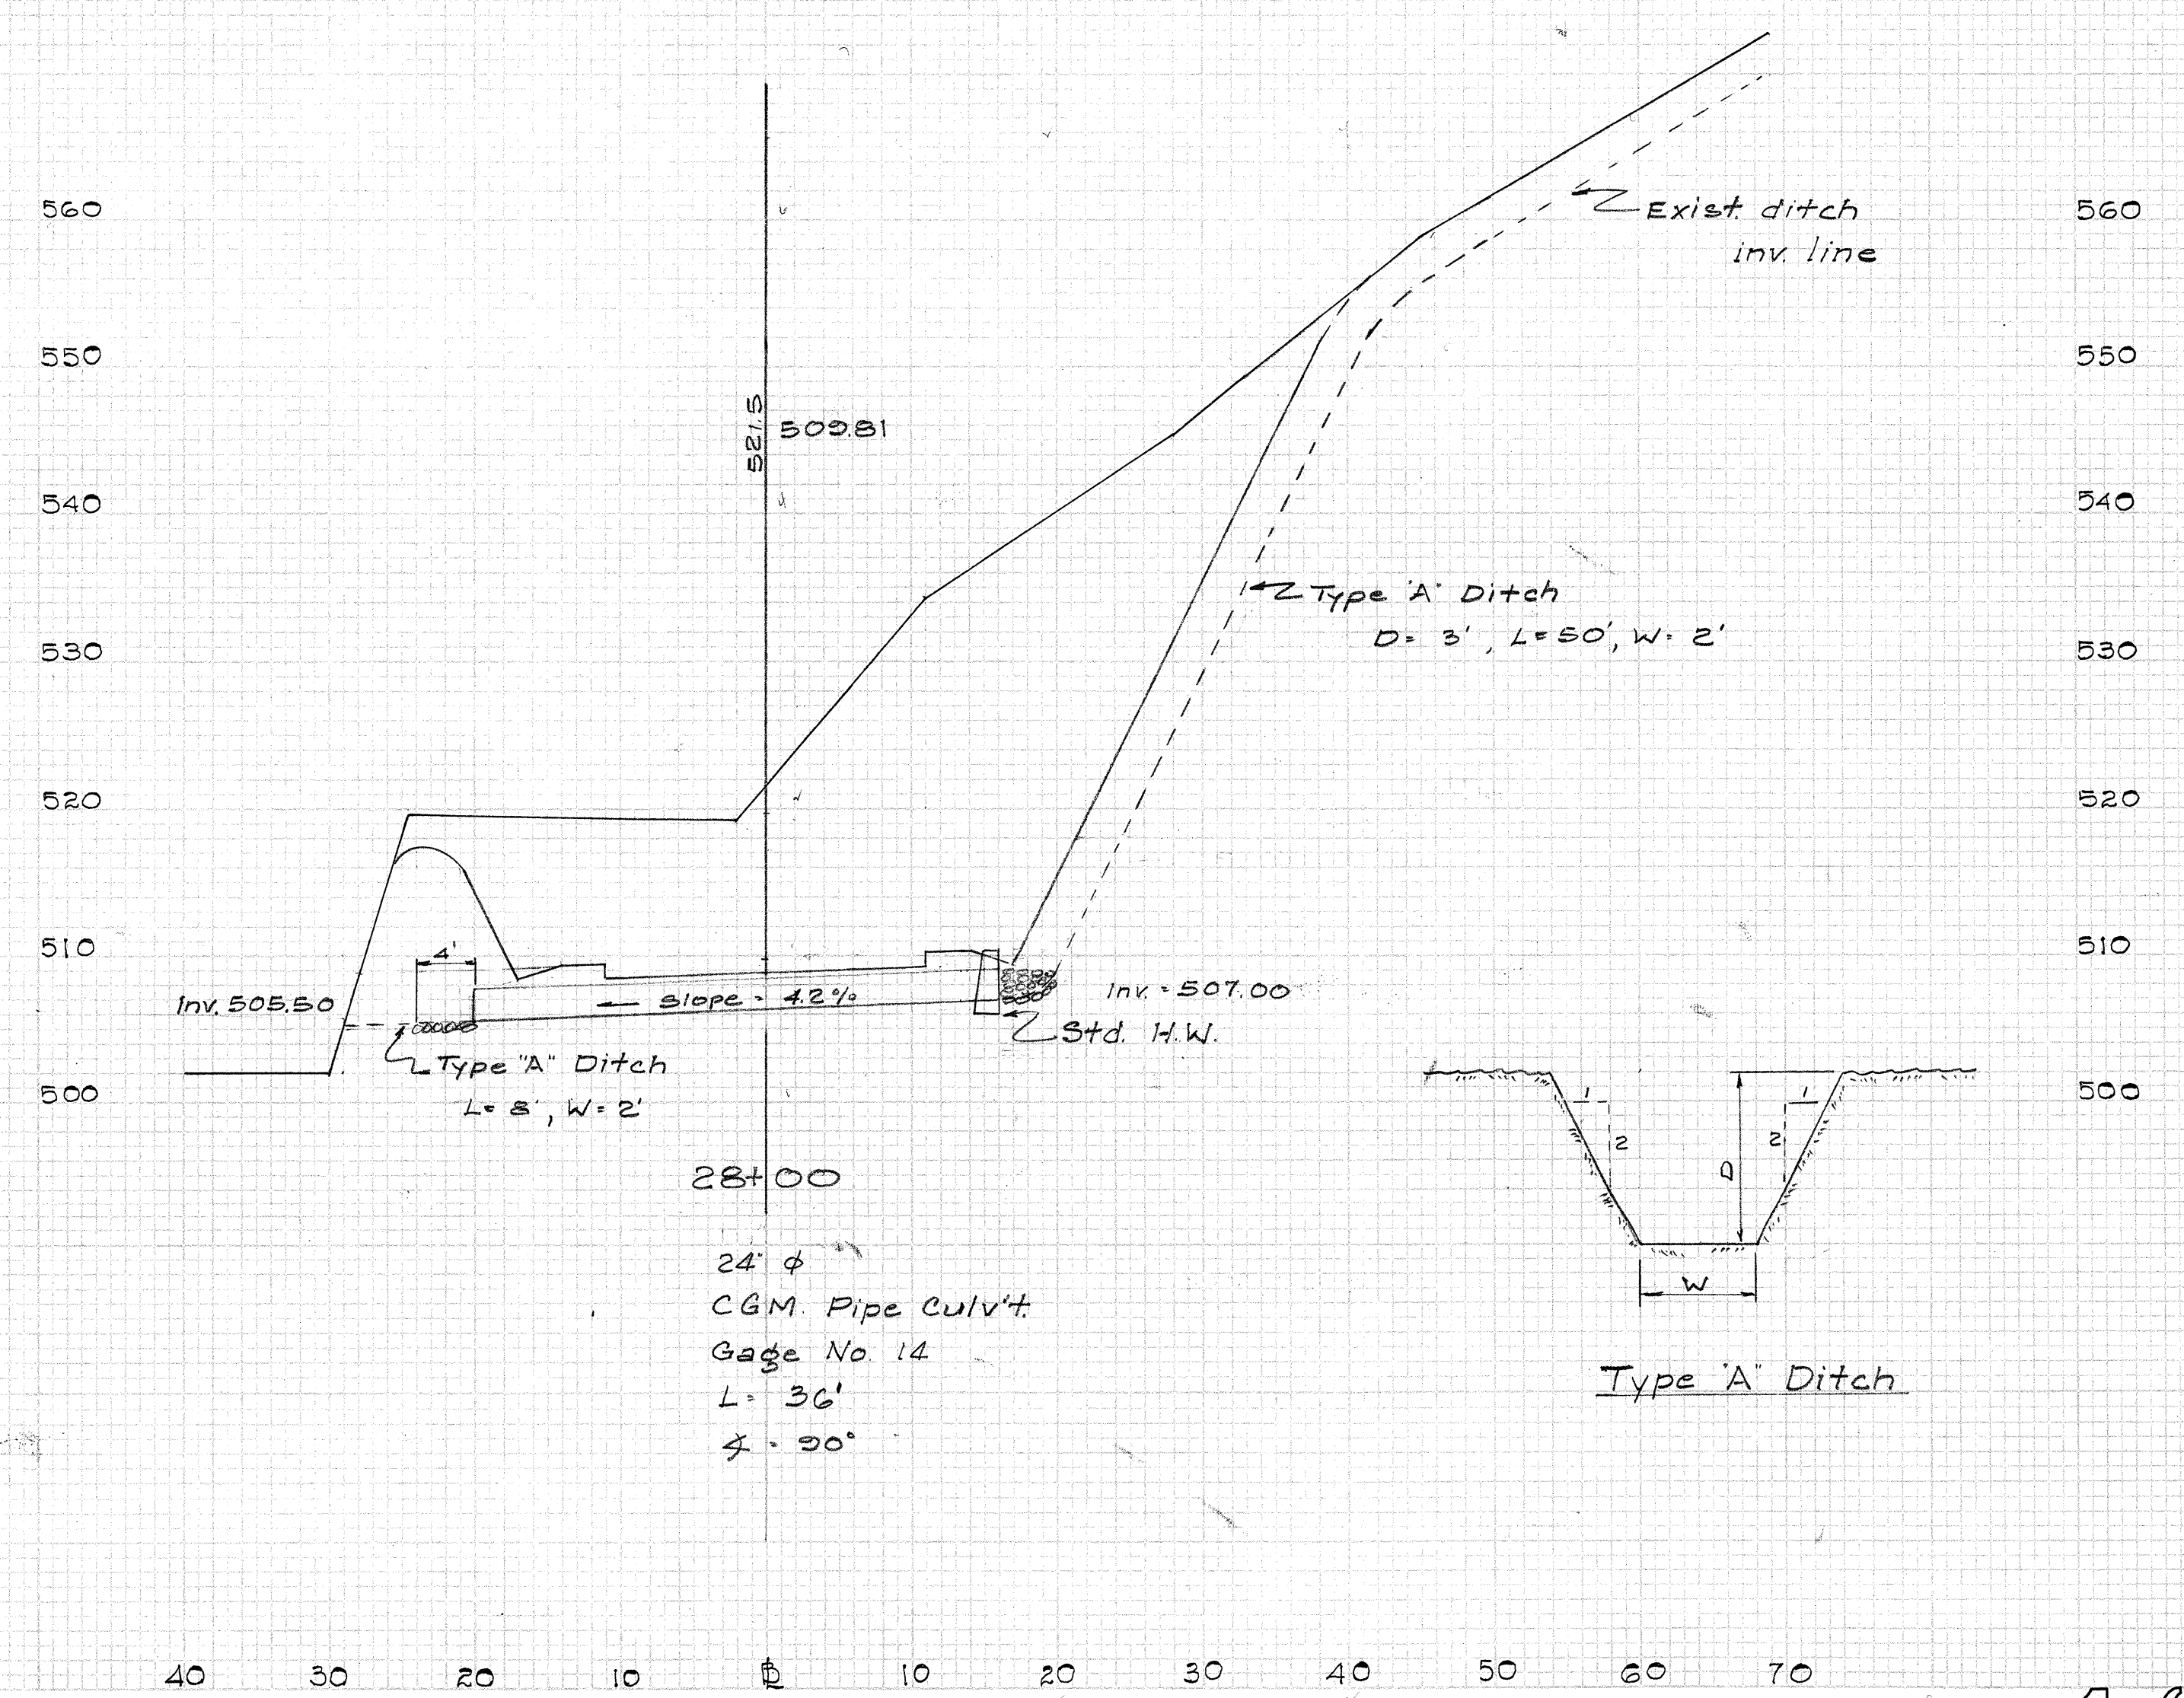

DESIGN	DATE
NO.	
REVISION	
BY	
CHECKED	
APPROVED	
NOTED	
DATE	

DESIGN	DATE
NO.	
REVISION	
BY	
CHECKED	
APPROVED	
NOTED	
DATE	


FED. ROAD DIST. NO.	STATE	FED. AID PROJ. NO.	FISCAL YEAR	SHEET NO.	TOTAL SHEETS
HAWAII	HAWAII	8-0360(3)	1963	21	38

Exc = 0
Emb = 22836

C = 0
E = 7822

Exc = 0
Emb = 14291


C = 0
E = 5040

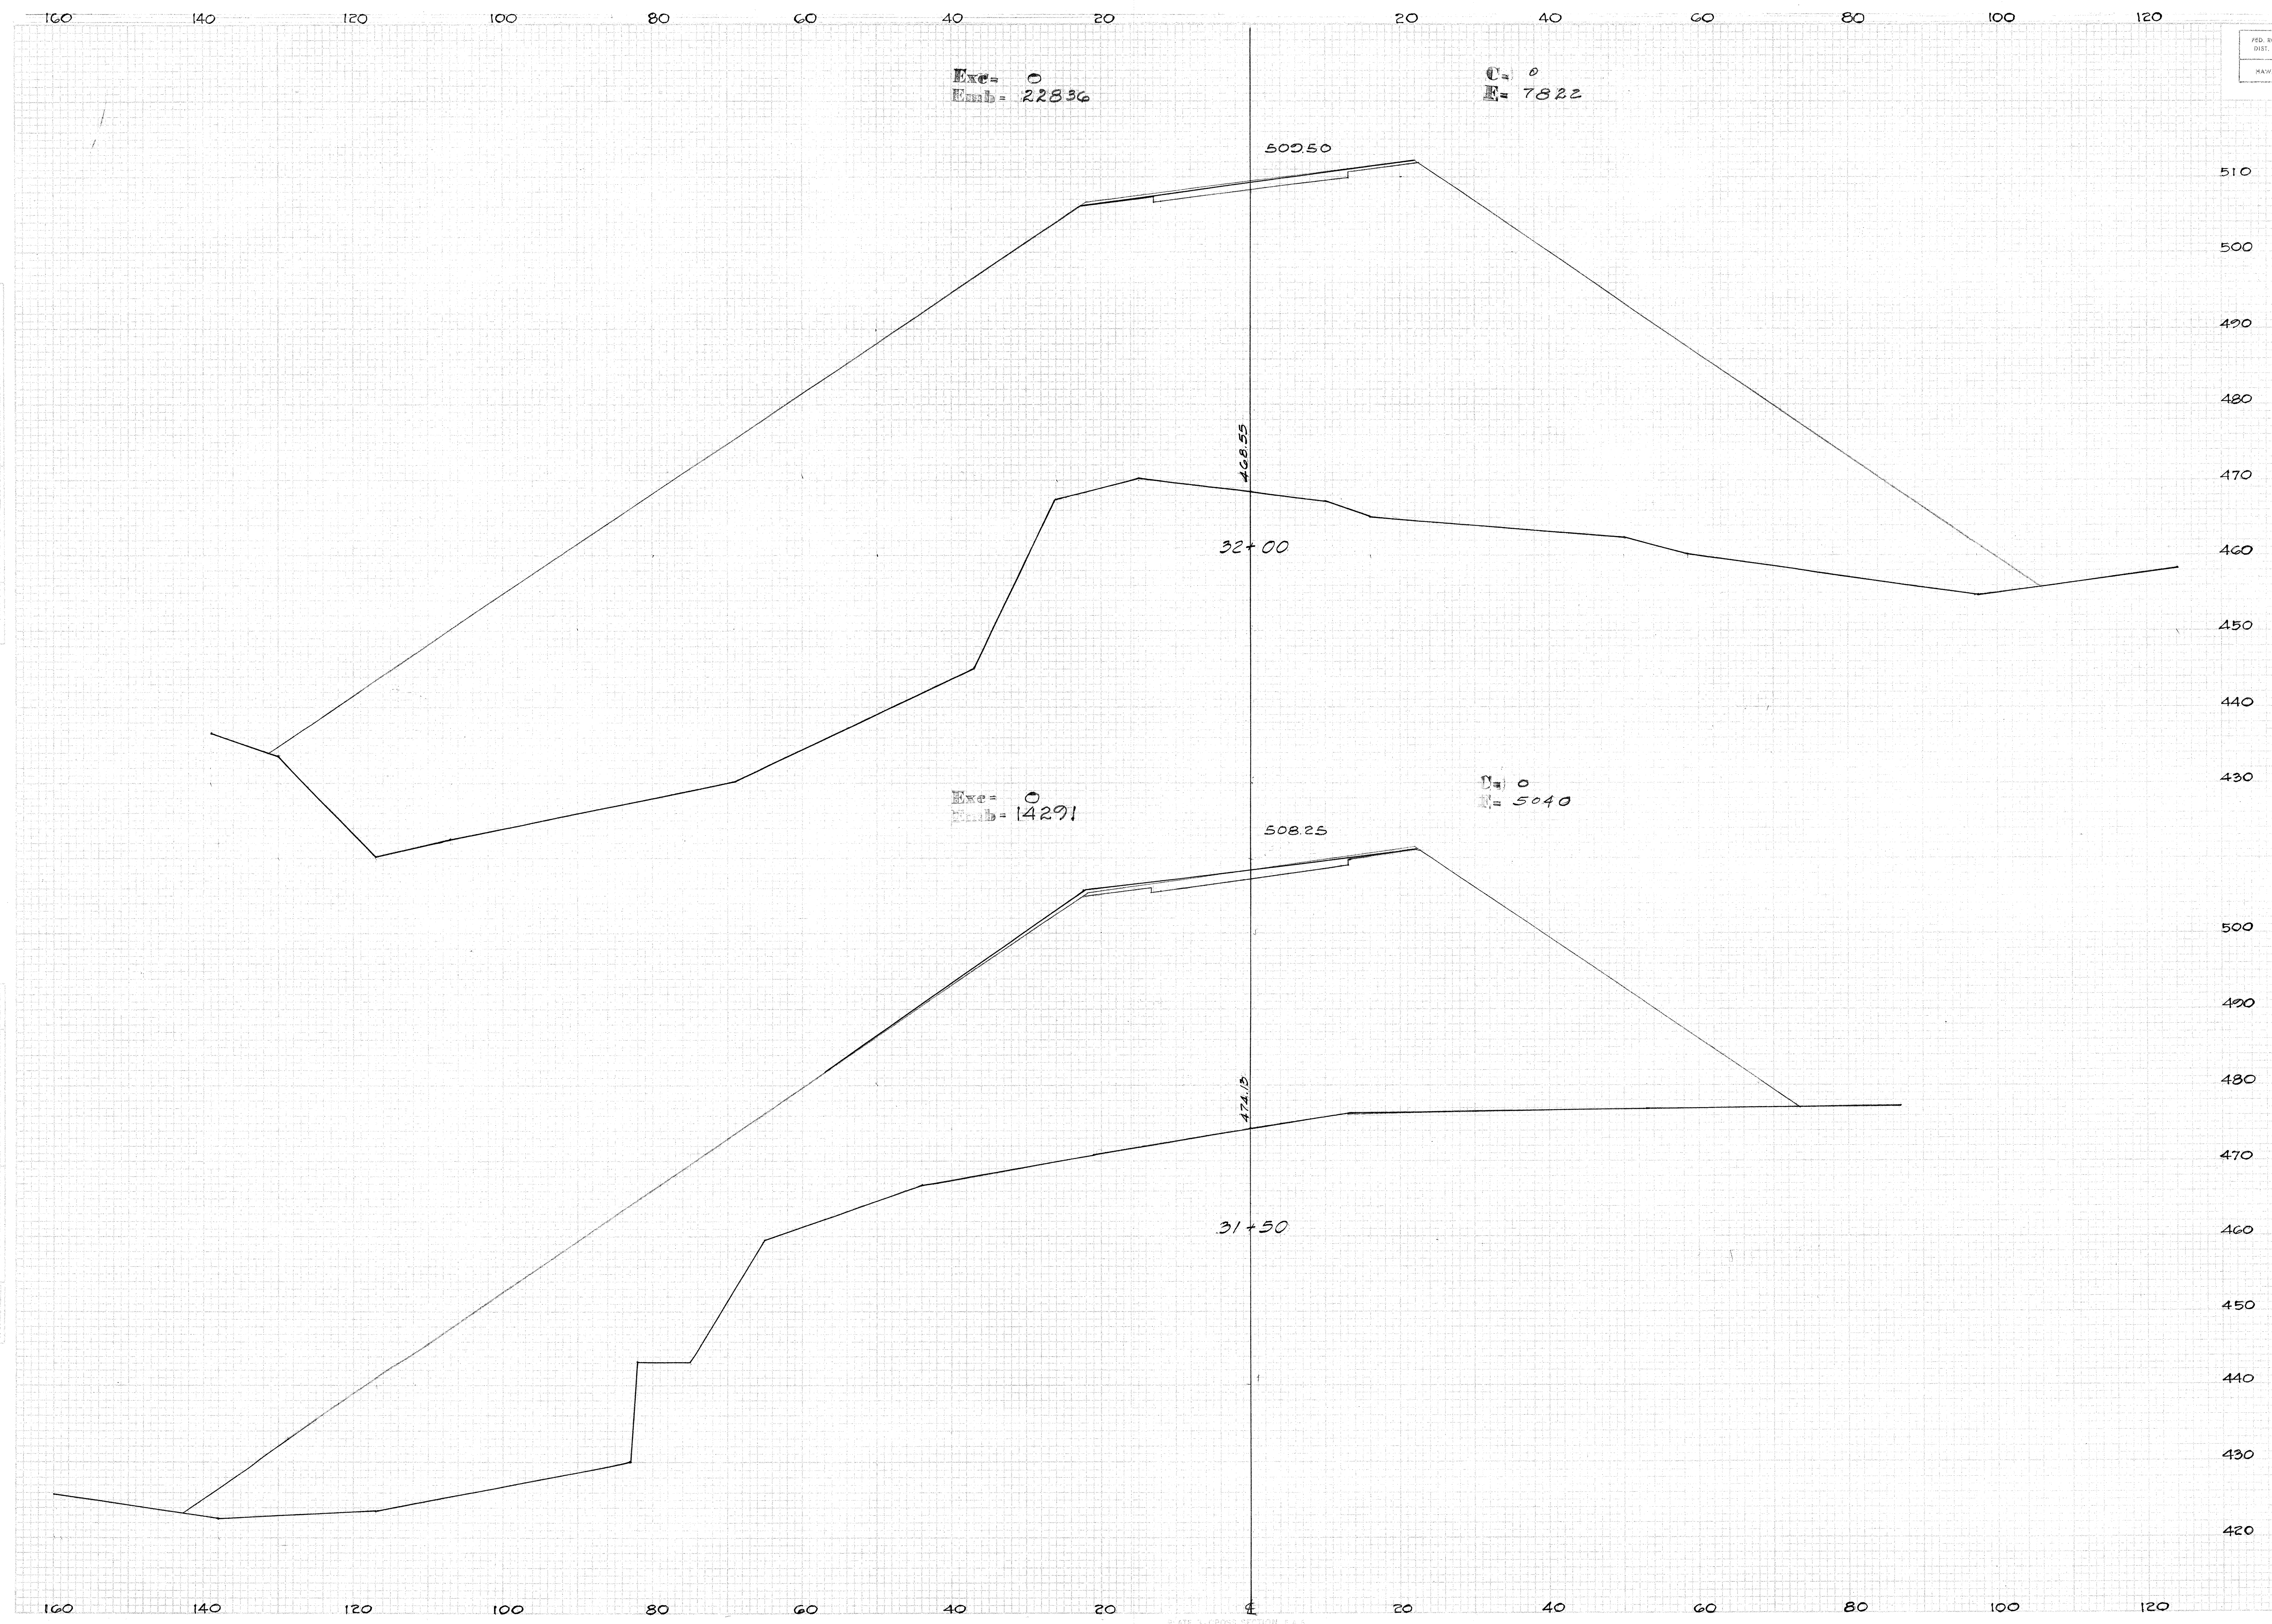

FINAL	SURVEYED	DATE
SURVEY	PLATTED	
NOTE BOOK	TEMPERATURE	
NO.	AREAS CHECKED	

ORIGINAL	SURVEYED	DATE
SURVEY	PLATTED	12-61
NOTE BOOK	TEMPERATURE	12-61
NO.	AREAS CHECKED	12-61


FED. ROAD DIST. NO.	STATE	FED. AID PROJ. NO.	FISCAL YEAR	SHEET NO.	TOTAL SHEETS
HAWAII	HAW.	3-0360(3)	1963	22	38

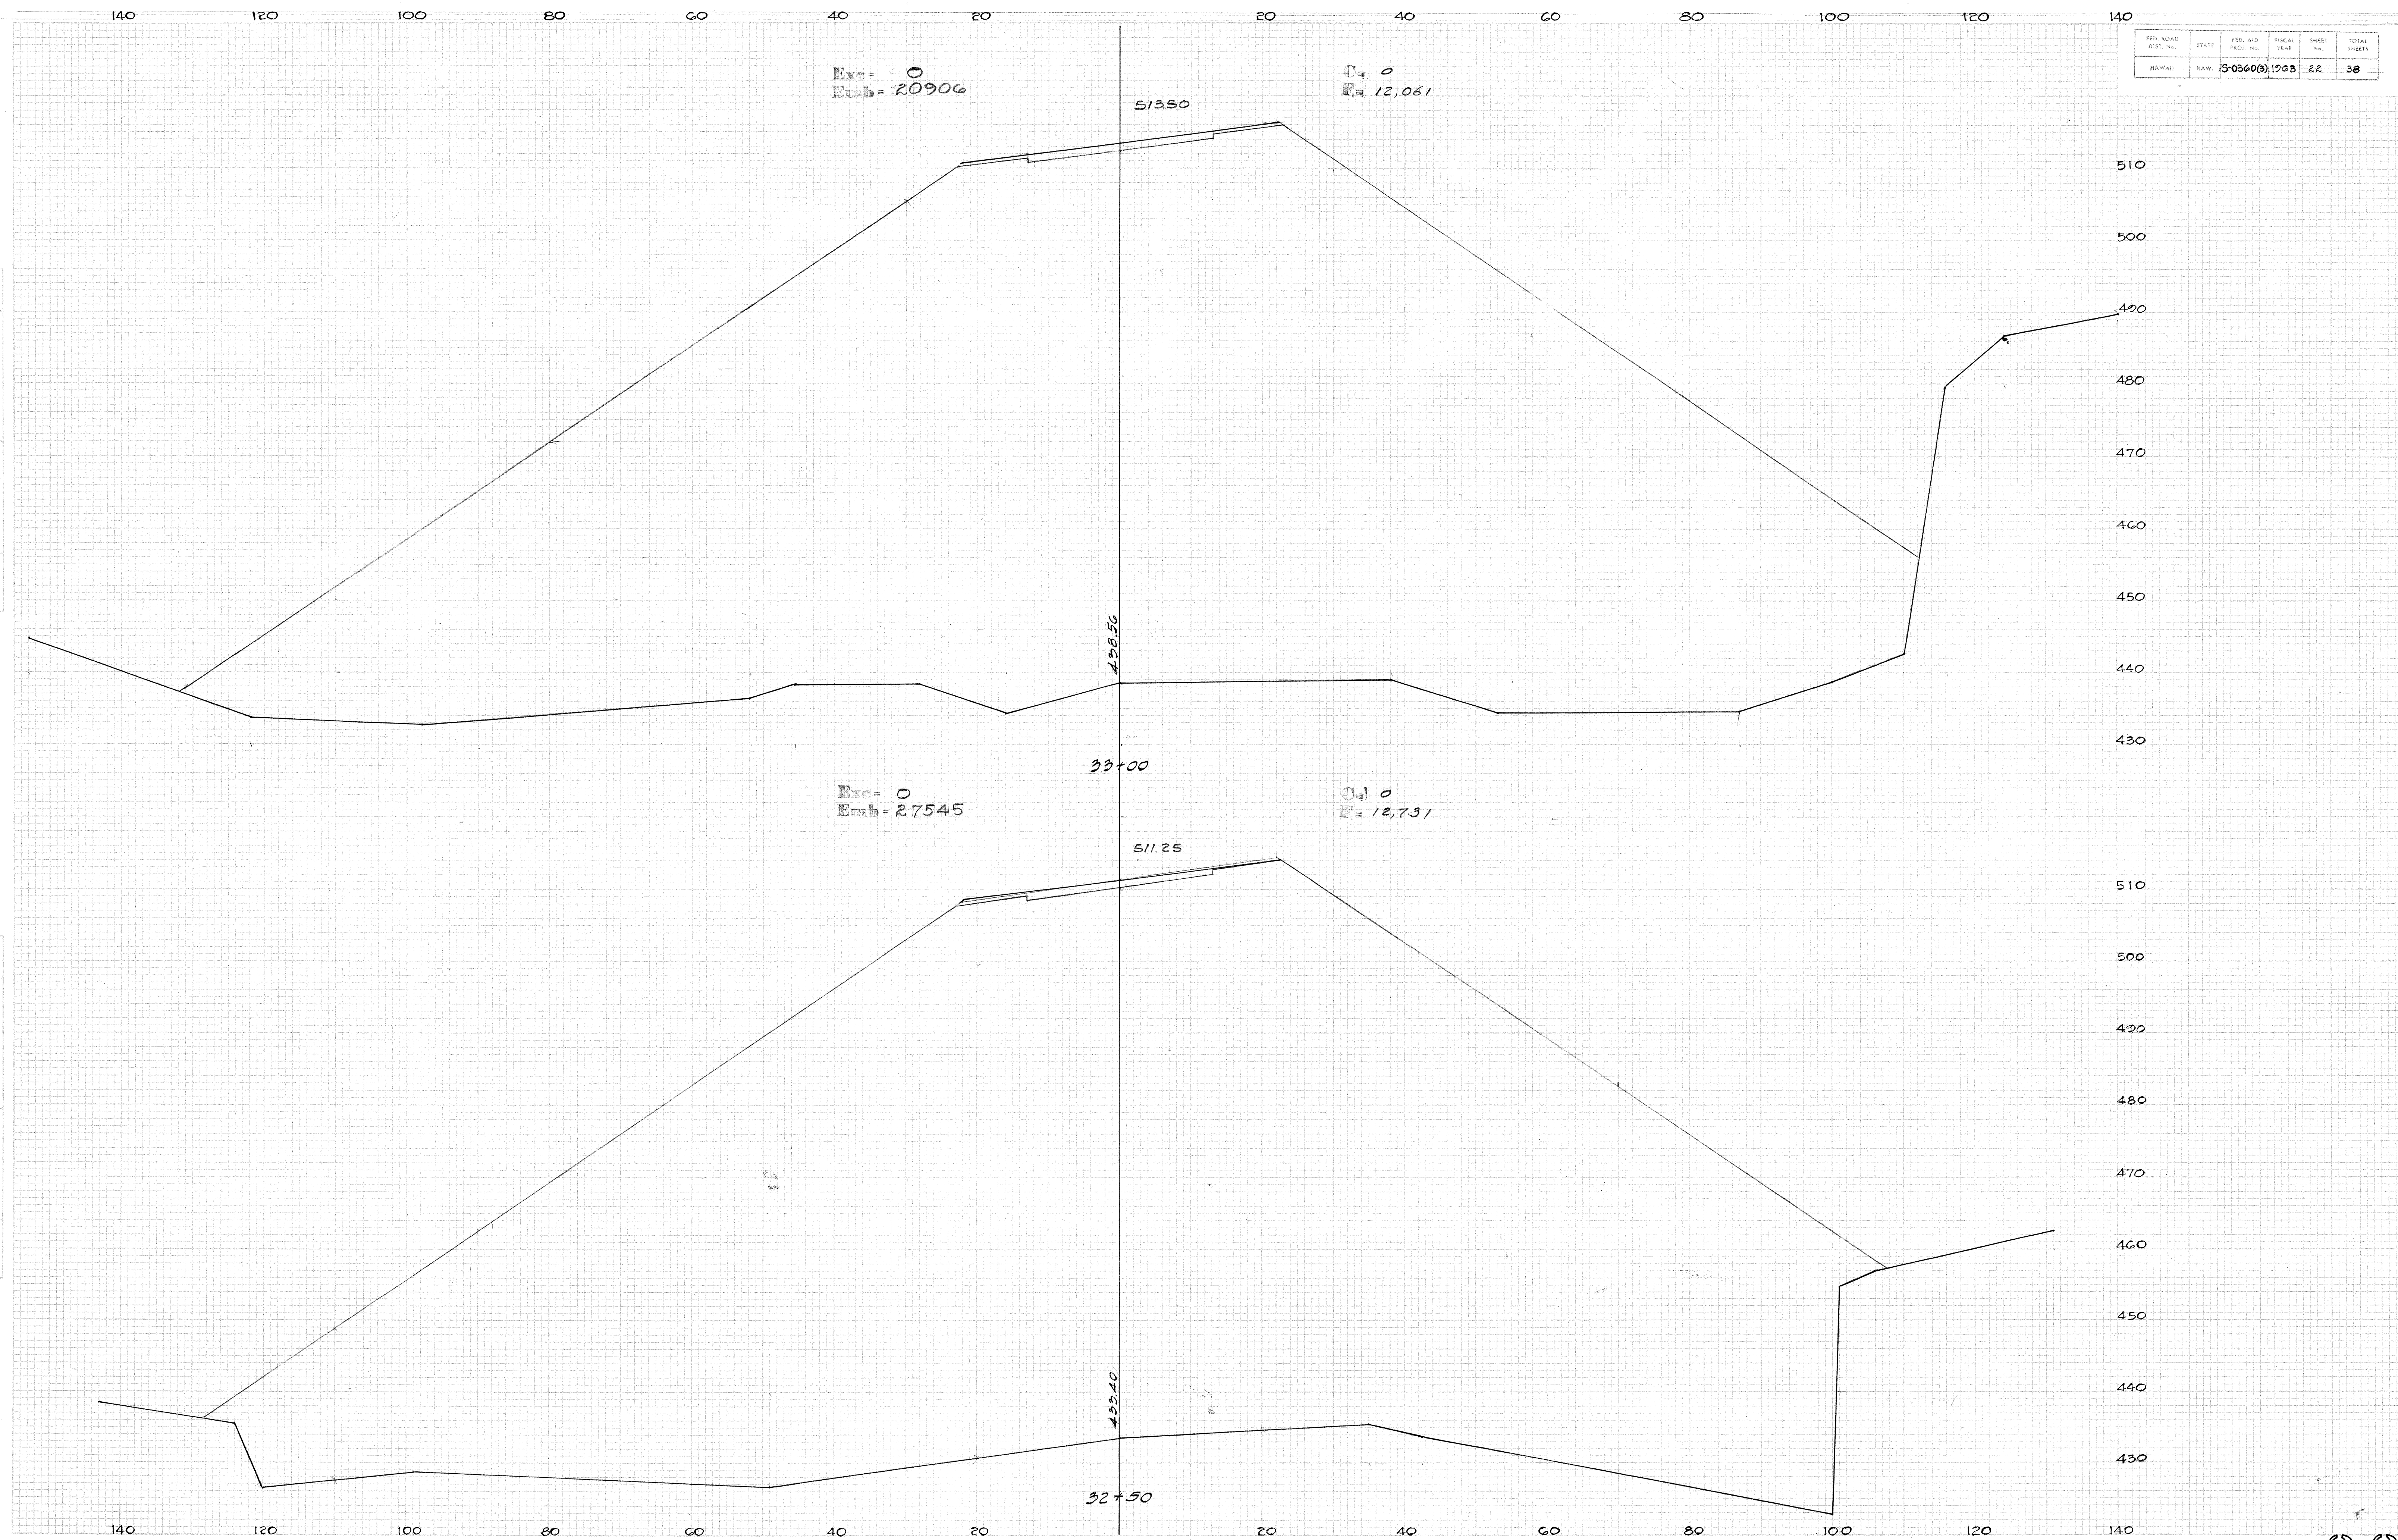

DATE	BY	SURVEYED	PLOTTED	NOTED	NO.
SURVEYED PLOTTED NOTED NO.					


DATE	BY	SURVEYED	PLOTTED	NOTED	NO.
12-1-61					
12-1-61					
12-1-61					
SURVEYED PLOTTED NOTED NO.					

FED. ROAD DIST. NO.	STATE	FED. AID PROJ. NO.	FISCAL YEAR	SHEET NO.	TOTAL SHEETS
1	HAWAII	0-0320(4)	1963	23	38

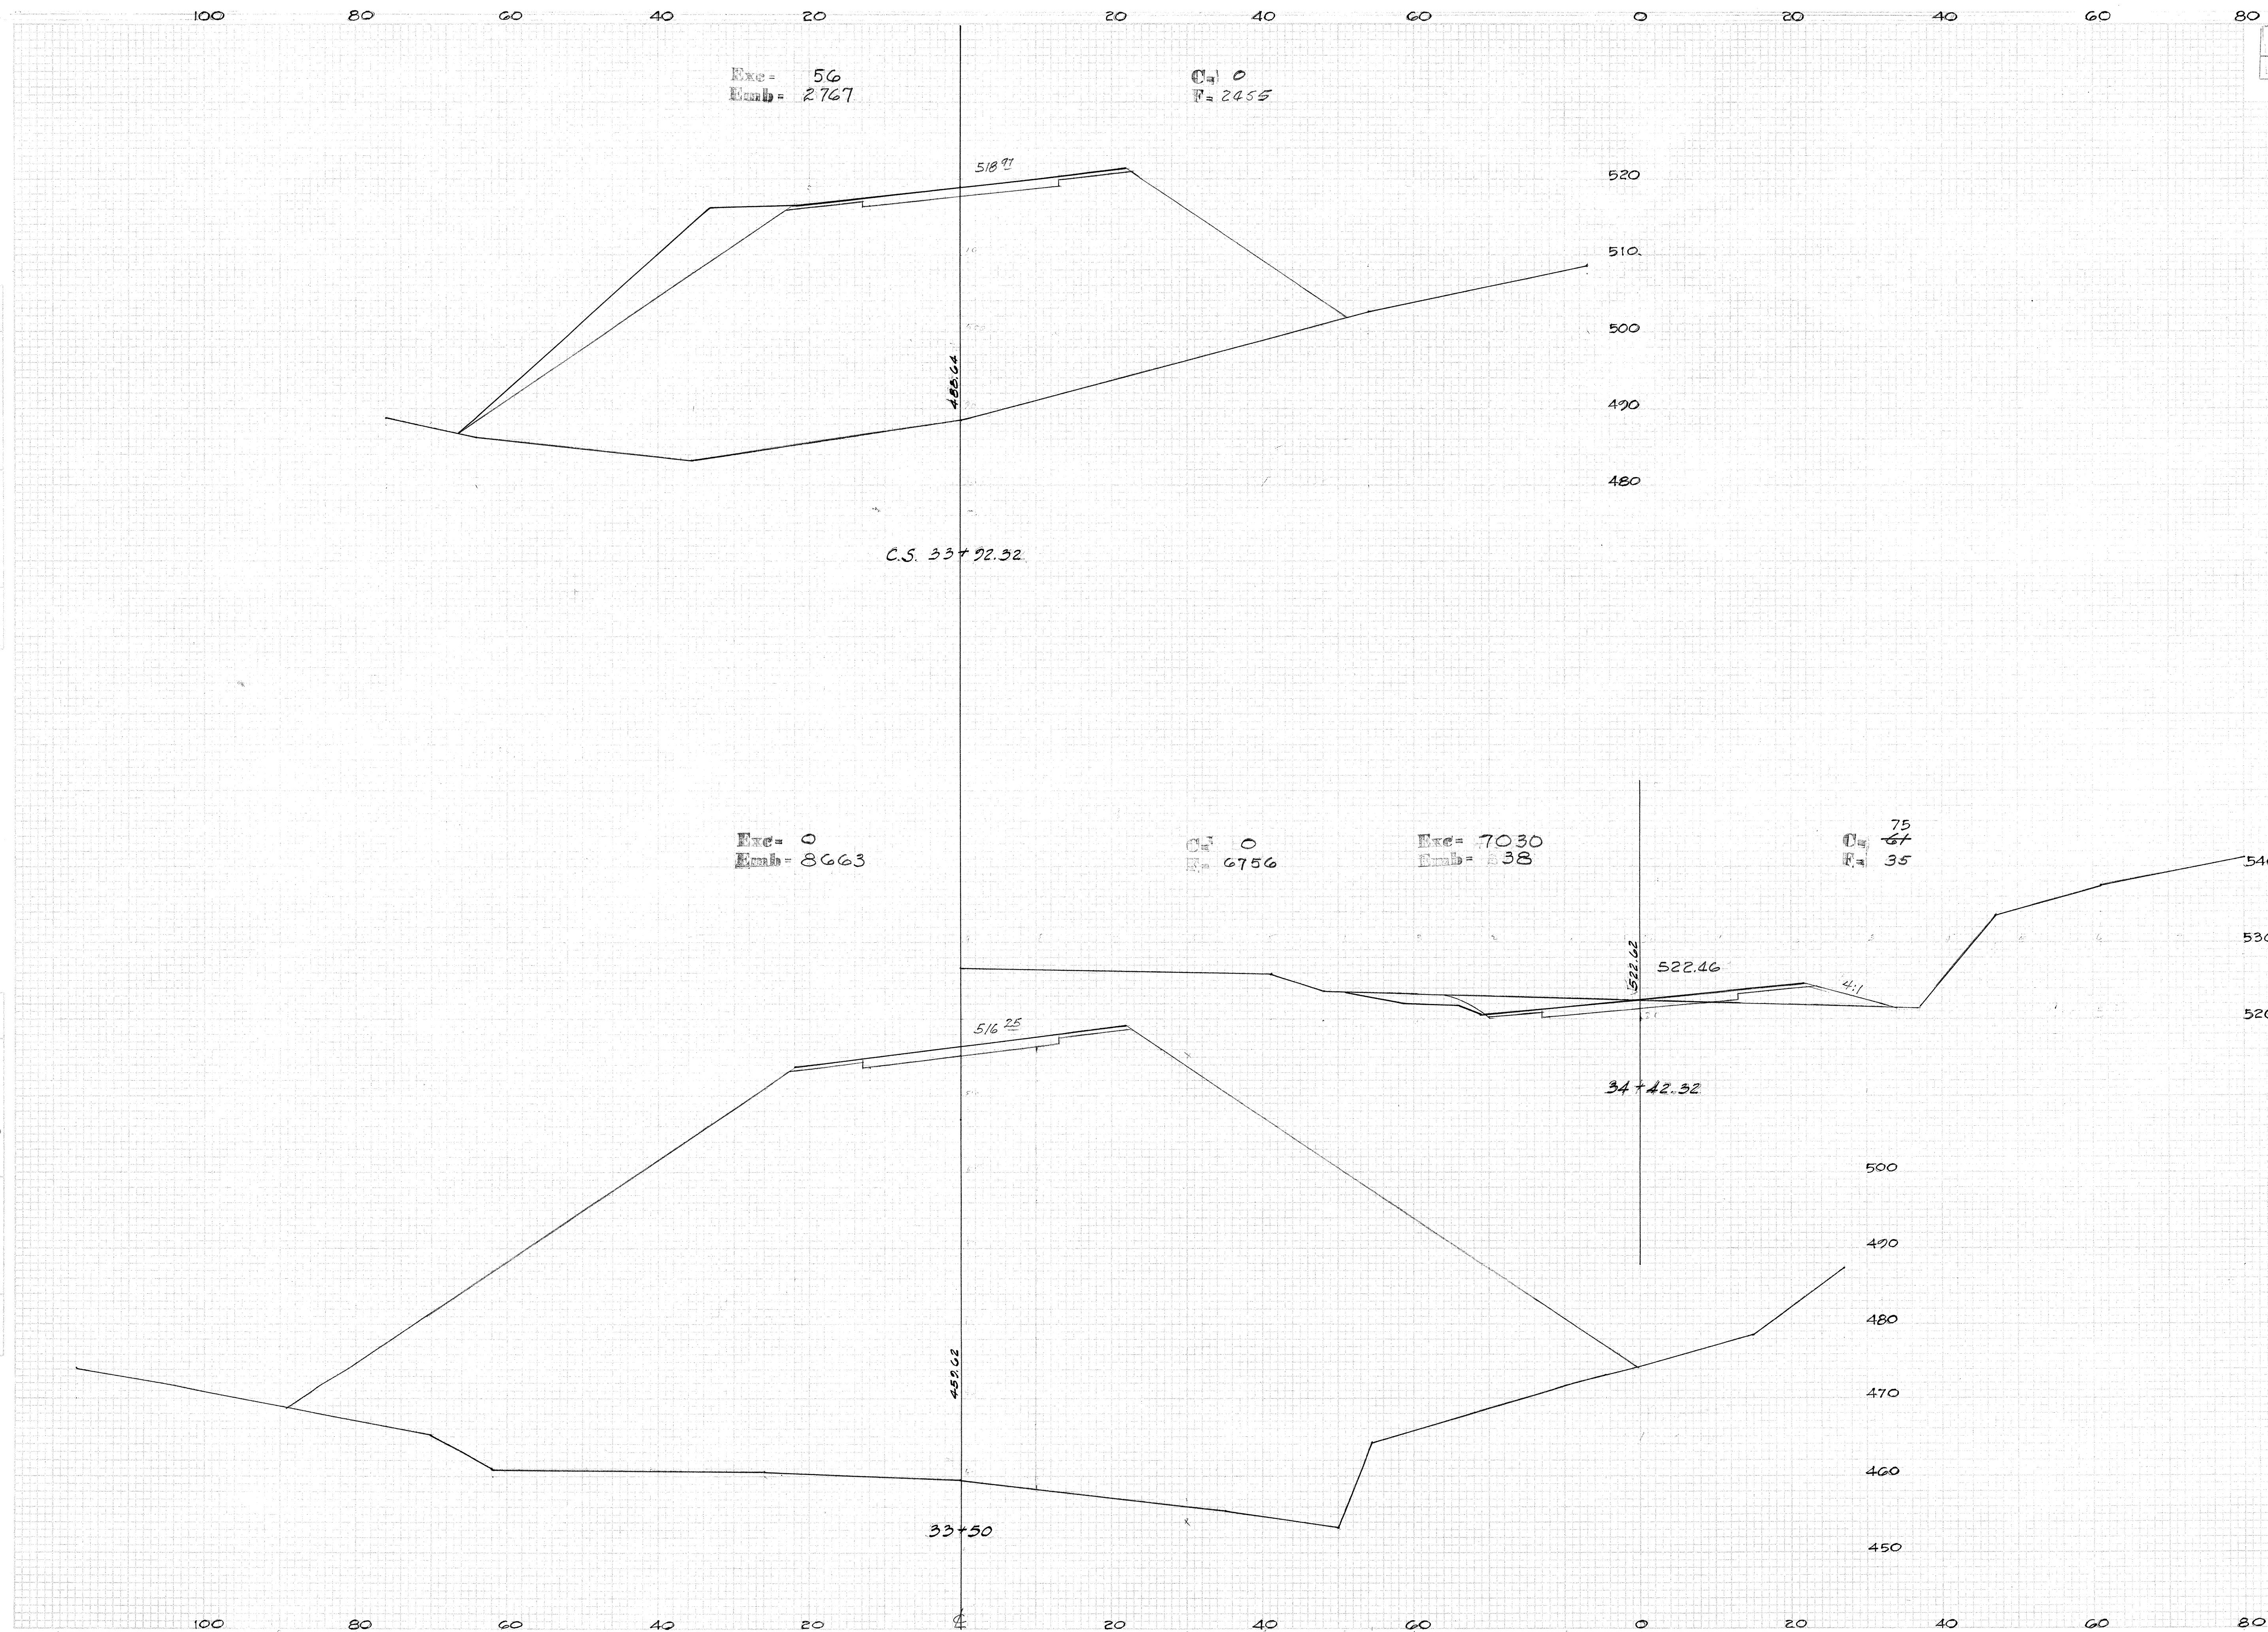

DATE
 BY
 CHECKED
 SURVEY
 PLANT
 NOTE BOOK
 REVISIONS
 1. 12-51
 2. 12-51
 3. 12-51
 4. 12-51
 5. 12-51
 6. 12-51
 7. 12-51
 8. 12-51
 9. 12-51
 10. 12-51

SURVEYED
 PLANT
 NOTE BOOK
 NO.
 1. 12-51
 2. 12-51
 3. 12-51
 4. 12-51
 5. 12-51
 6. 12-51
 7. 12-51
 8. 12-51
 9. 12-51
 10. 12-51

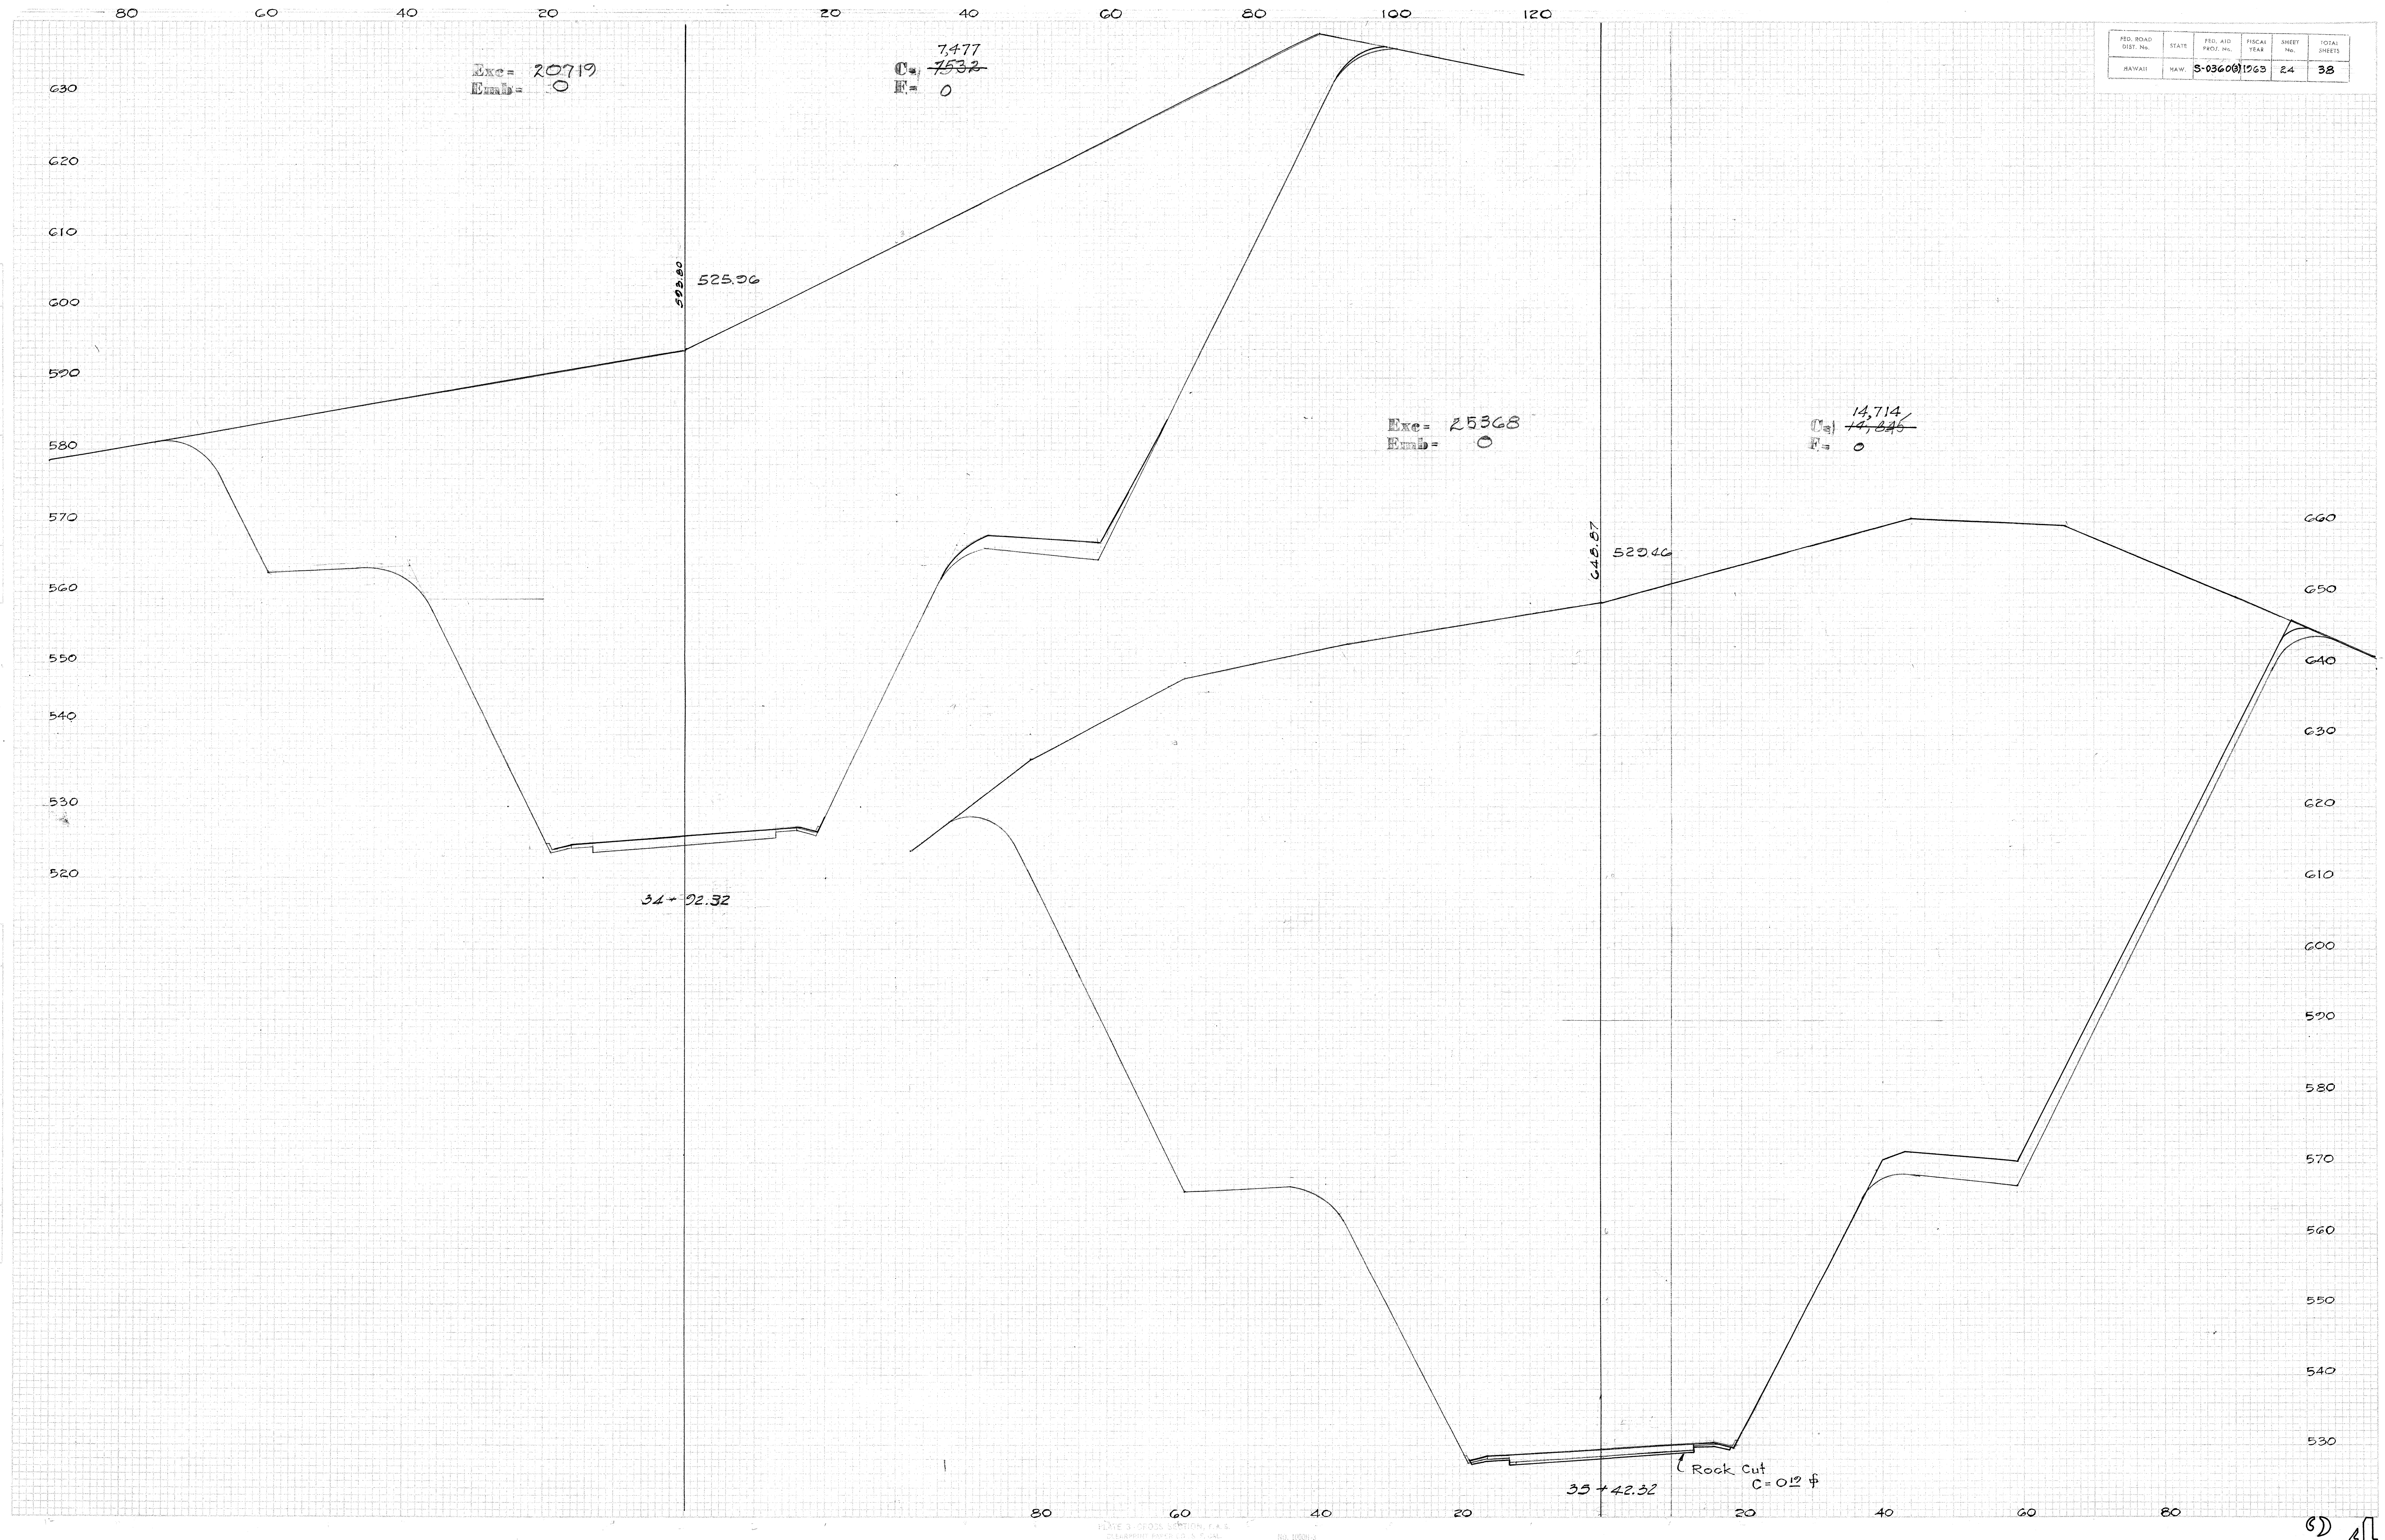


FED. ROAD DIST. NO.	STATE	FED. AID PROJ. NO.	FISCAL YEAR	SHEET NO.	TOTAL SHEETS
HAWAII	HAW.	S-03600	1963	24	38

DATE	
BY	
NO.	
FINAL	
SURVEY	
NOTE BOOK	
AREAS CHECKED	

DATE	12-21-61
BY	G. J. Slade
NO.	10000
FINAL	
SURVEY	
NOTE BOOK	
AREAS CHECKED	

FED. ROAD DIST. NO.	STATE	FED. AID PROJ. NO.	FISCAL YEAR	SHEET NO.	TOTAL SHEETS
HAWAII	HAWAII	S-0360(3)	1963	25	38

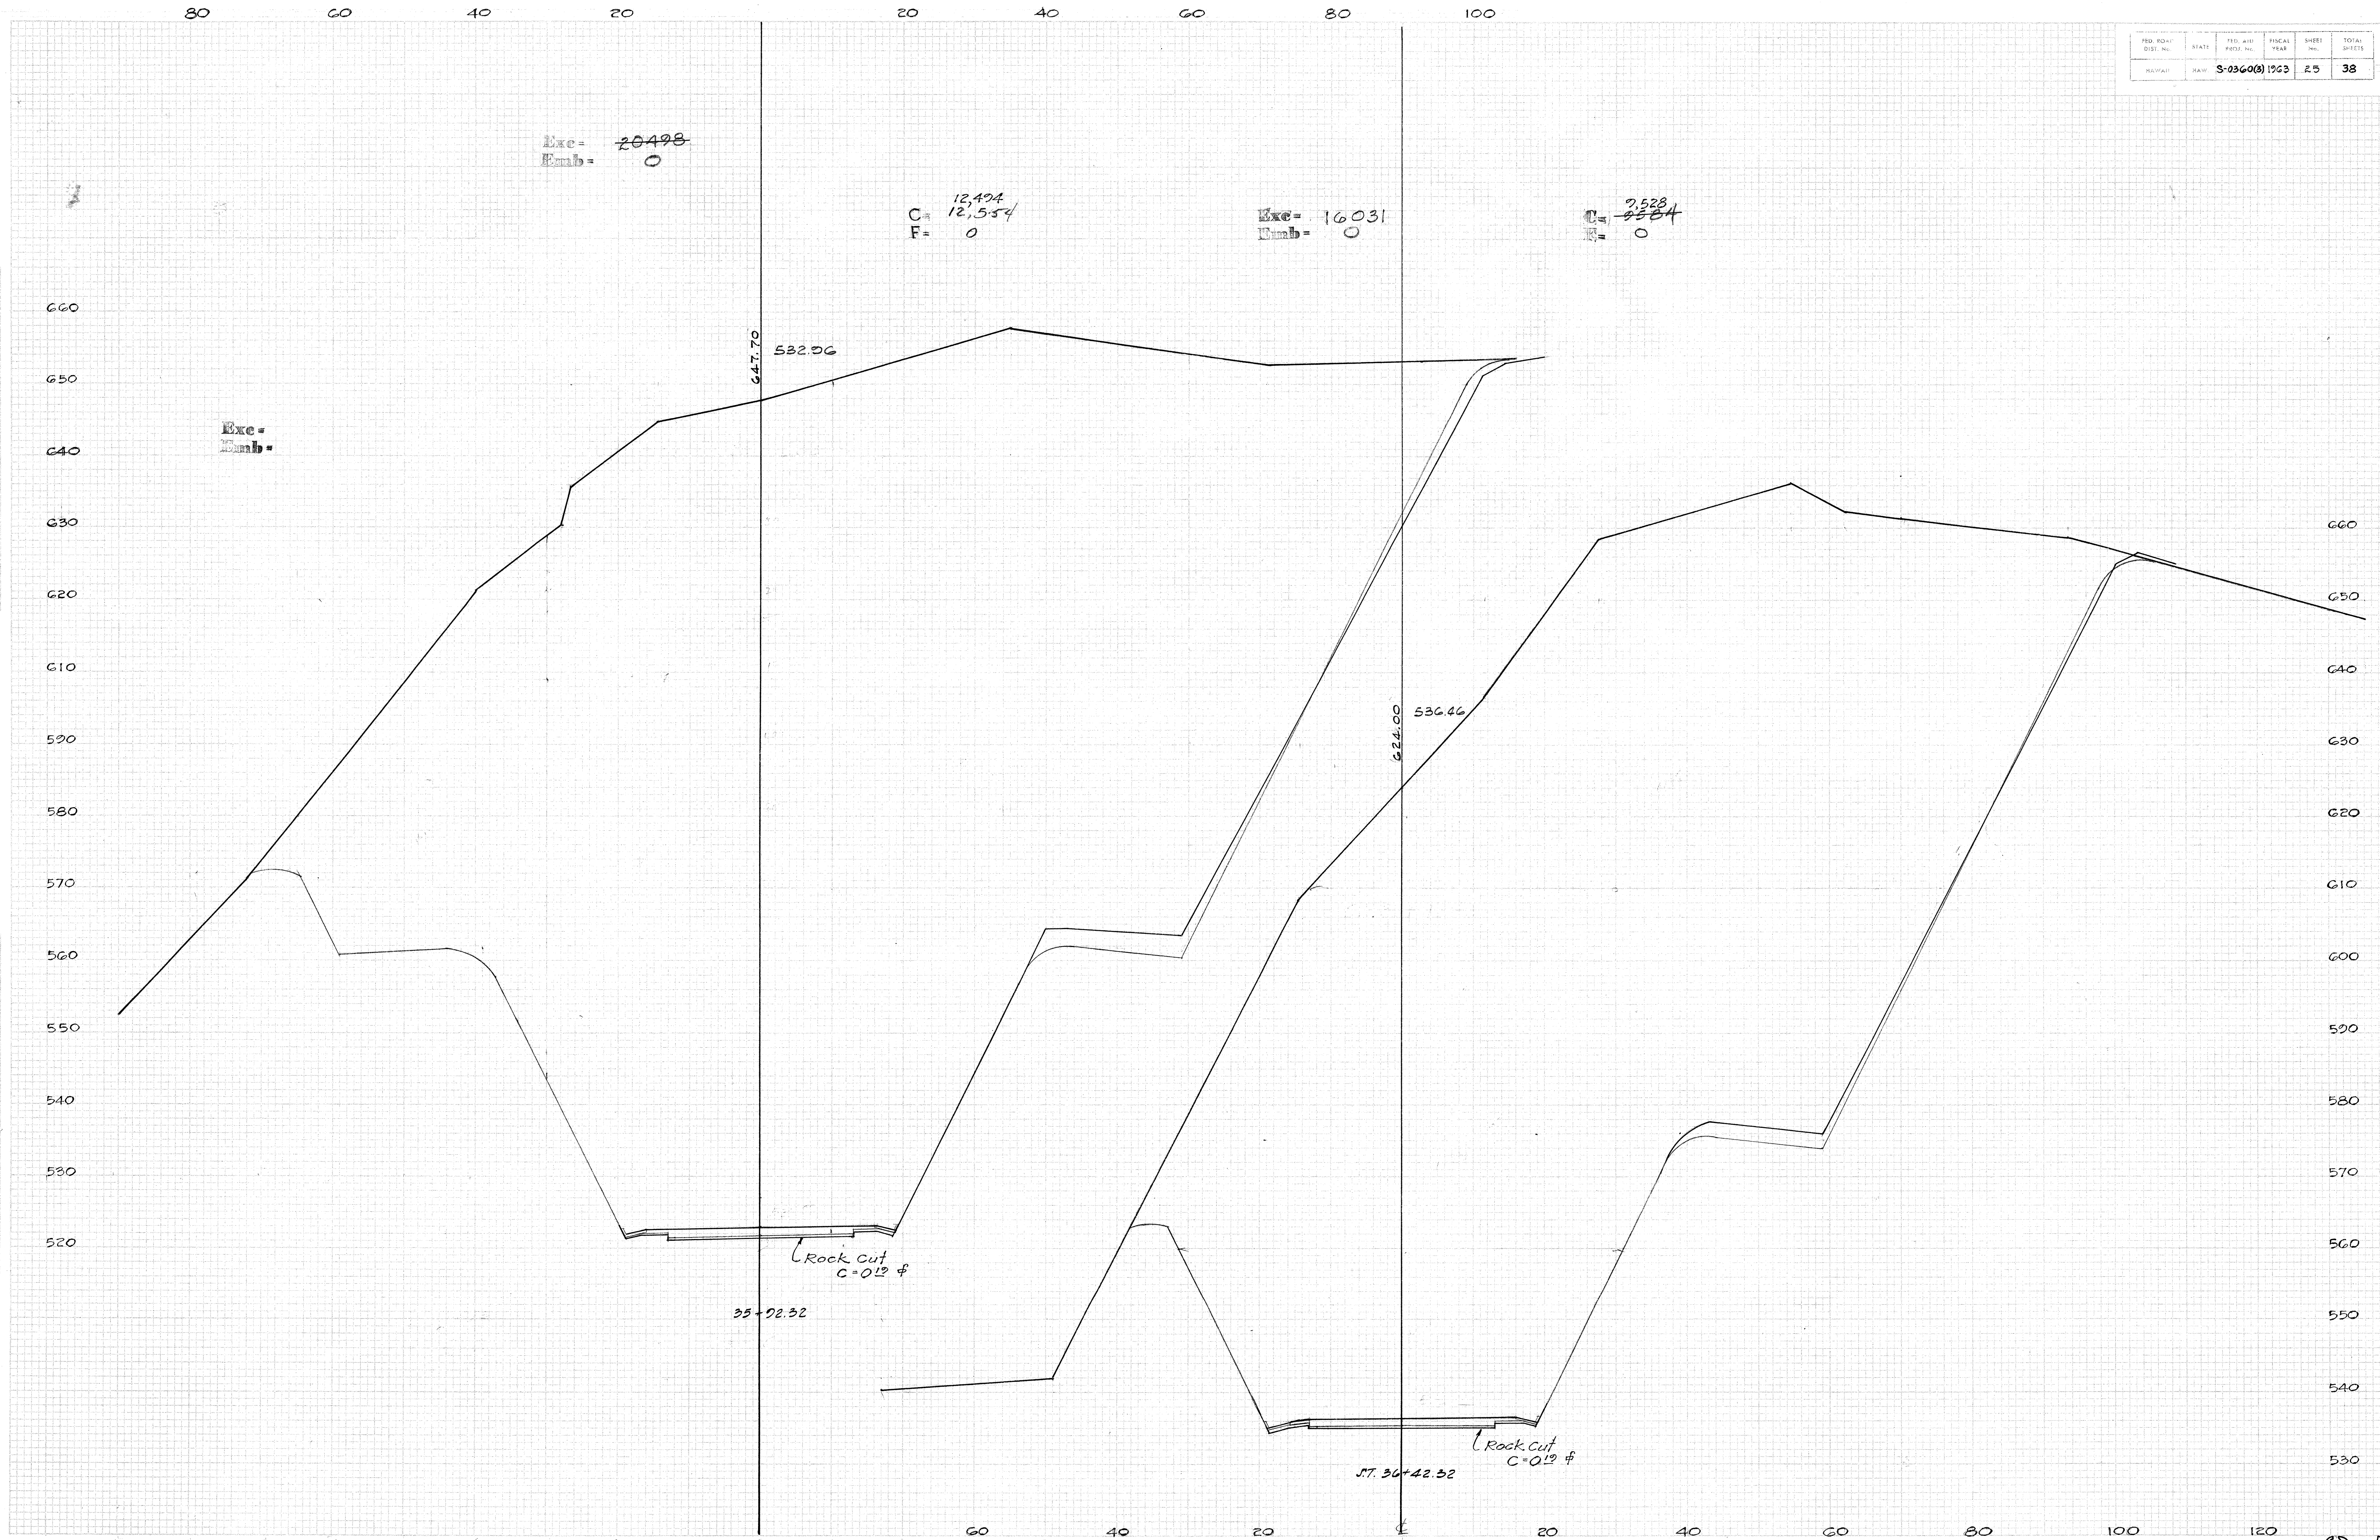


ORIGINAL	SURVEYED	BY	DATE
SURVEY	PLOTTED	Gracie, S. S. & J. W.	2-1-61
NOTE BOOK	TEMPLATE	S. 1122	12-61
NO.	AREAS CHECKED	S. 1122	2-61
		468-05A	12-19-61

FED. ROAD DIST. NO.	STATE	FED. AID PROJ. NO.	FISCAL YEAR	SHEET NO.	TOTAL SHEETS
	HAWAII	5-0360(9)	1963	30	58

DATE	BY	REVISION
12-26-61	CH	1
12-26-61	CH	2
12-26-61	CH	3
12-26-61	CH	100



DATE	BY	REVISION
12-26-61	CH	1
12-26-61	CH	2
12-26-61	CH	3
12-26-61	CH	100

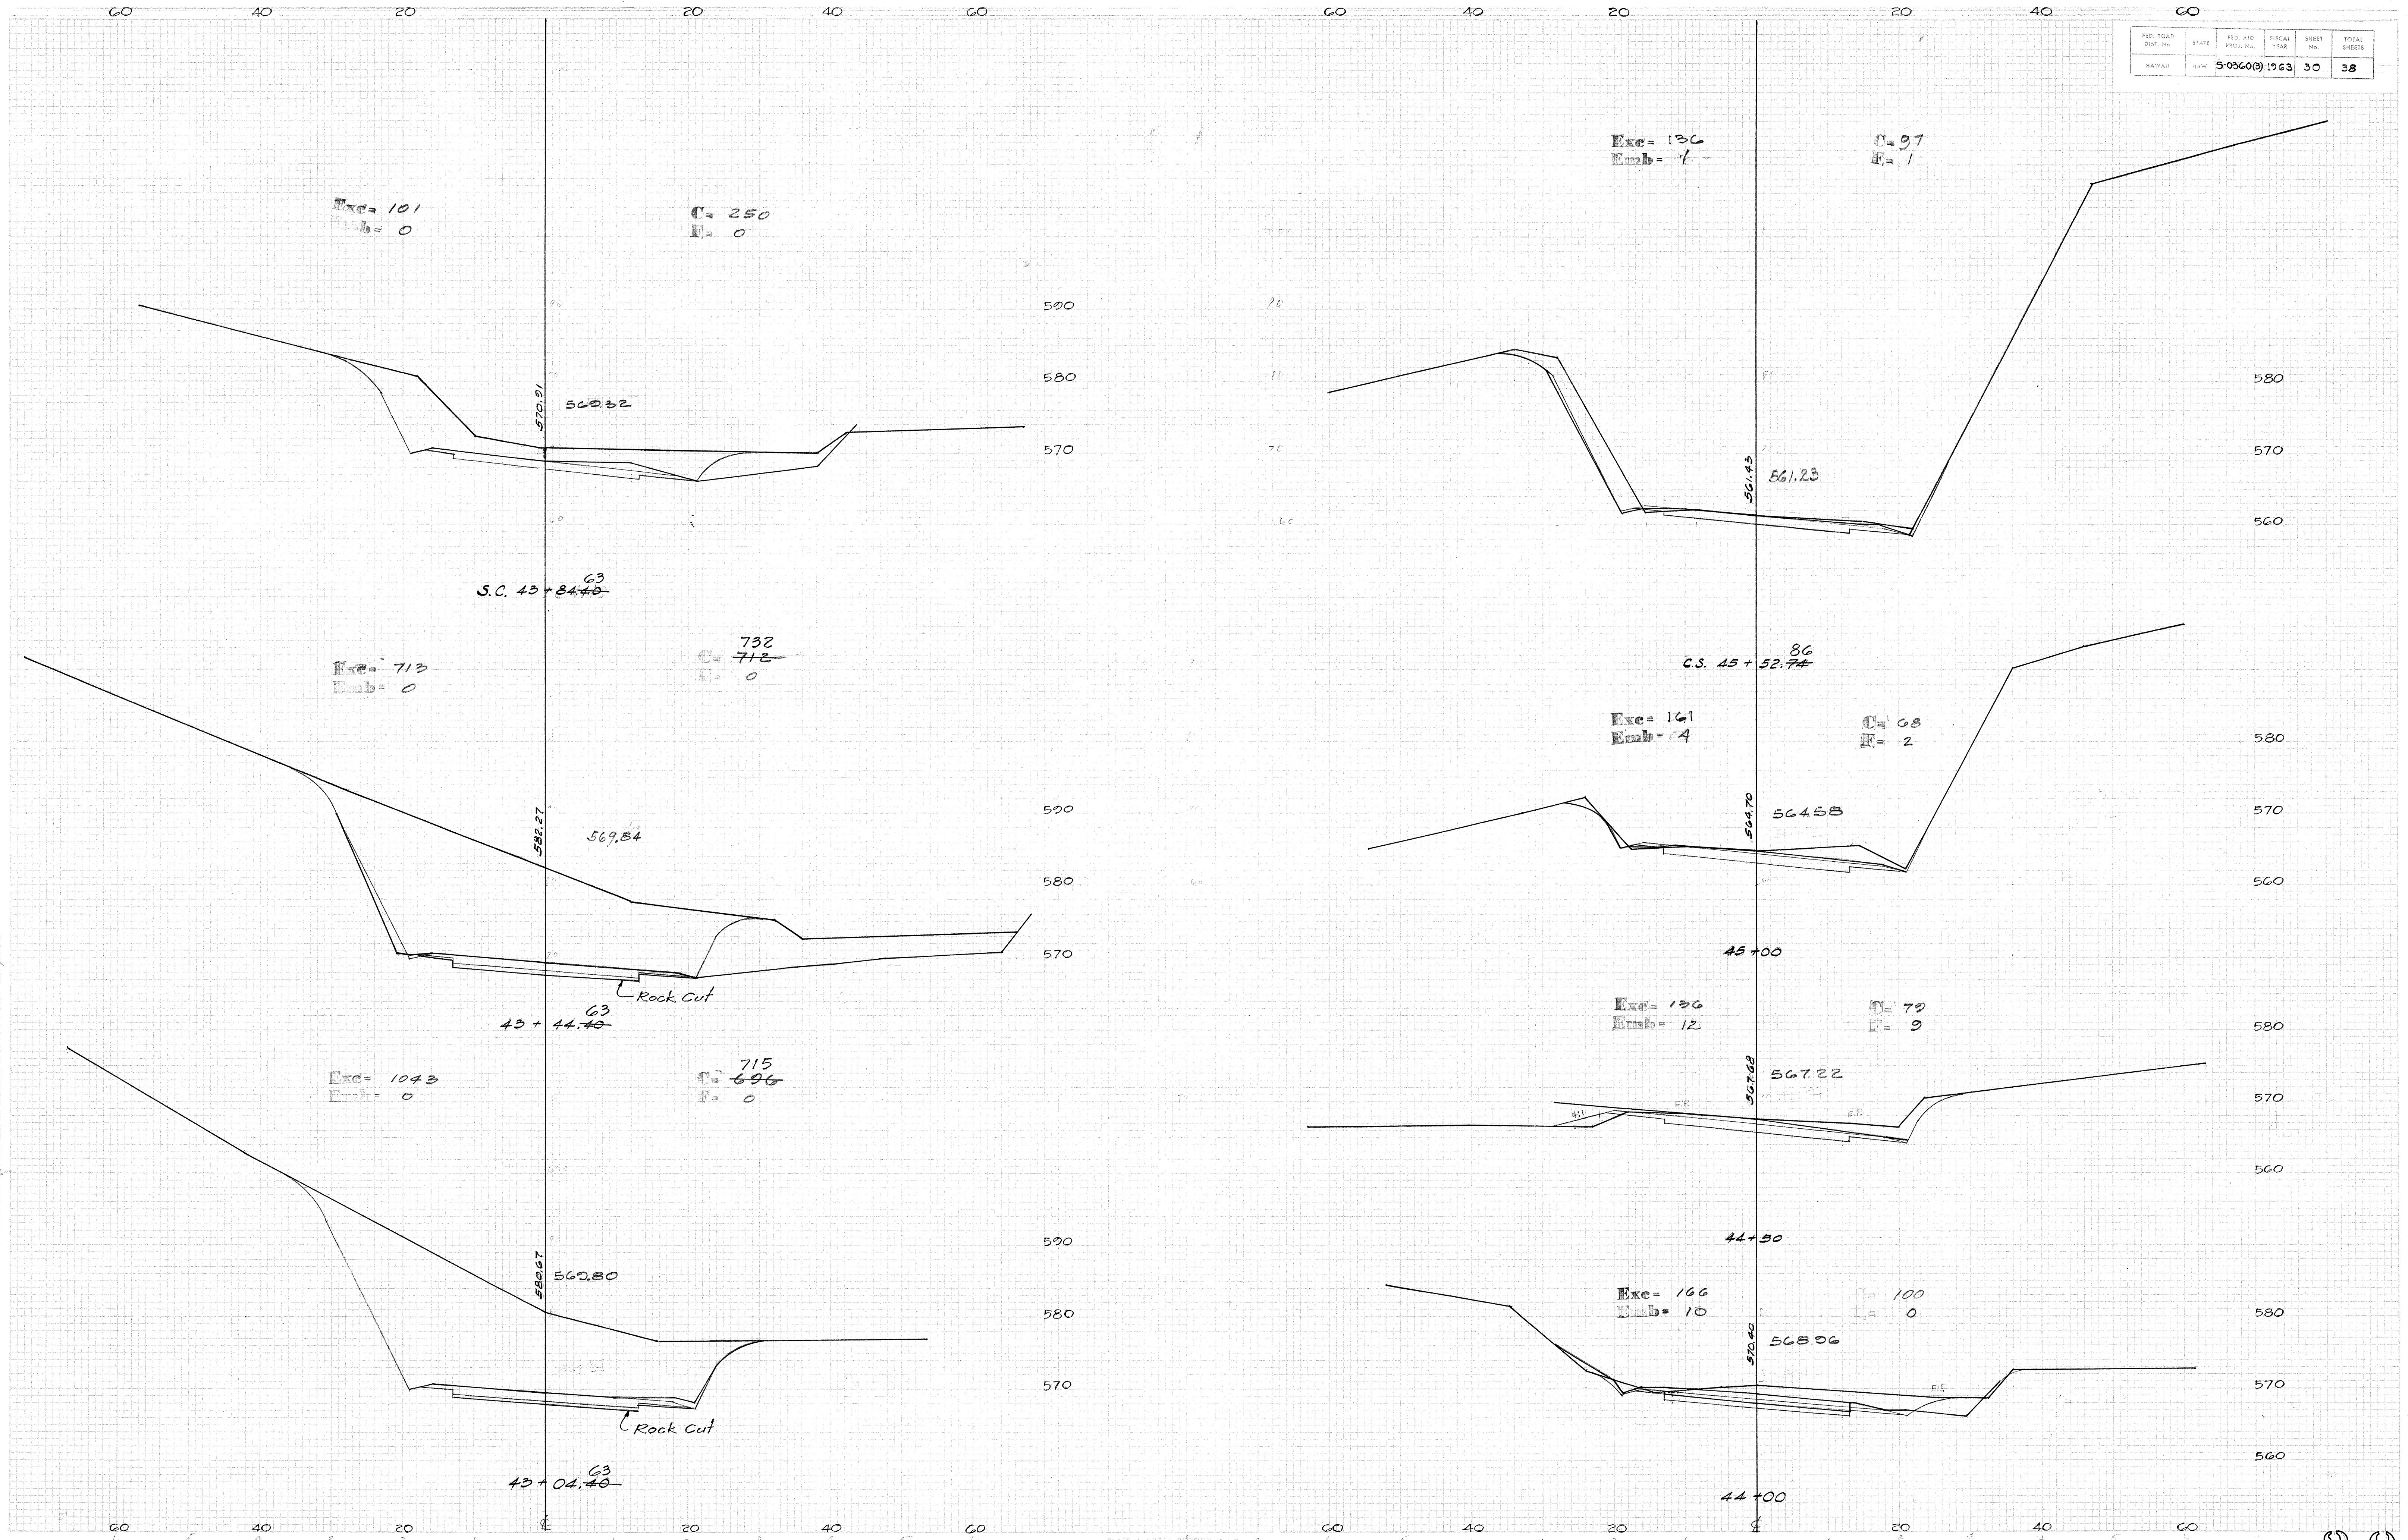





DATE	SV	NO.
12-61	51	1
12-61	51	1
12-61	51	1
12-61	51	1

DATE	SV	NO.
12-61	51	1
12-61	51	1
12-61	51	1
12-61	51	1

FED. ROAD DIST. NO.	STATE	FED. AID PROJ. NO.	FISCAL YEAR	SHEET NO.	TOTAL SHEETS
HAWAII	KAW.	5-0360(3)	1963	31	38

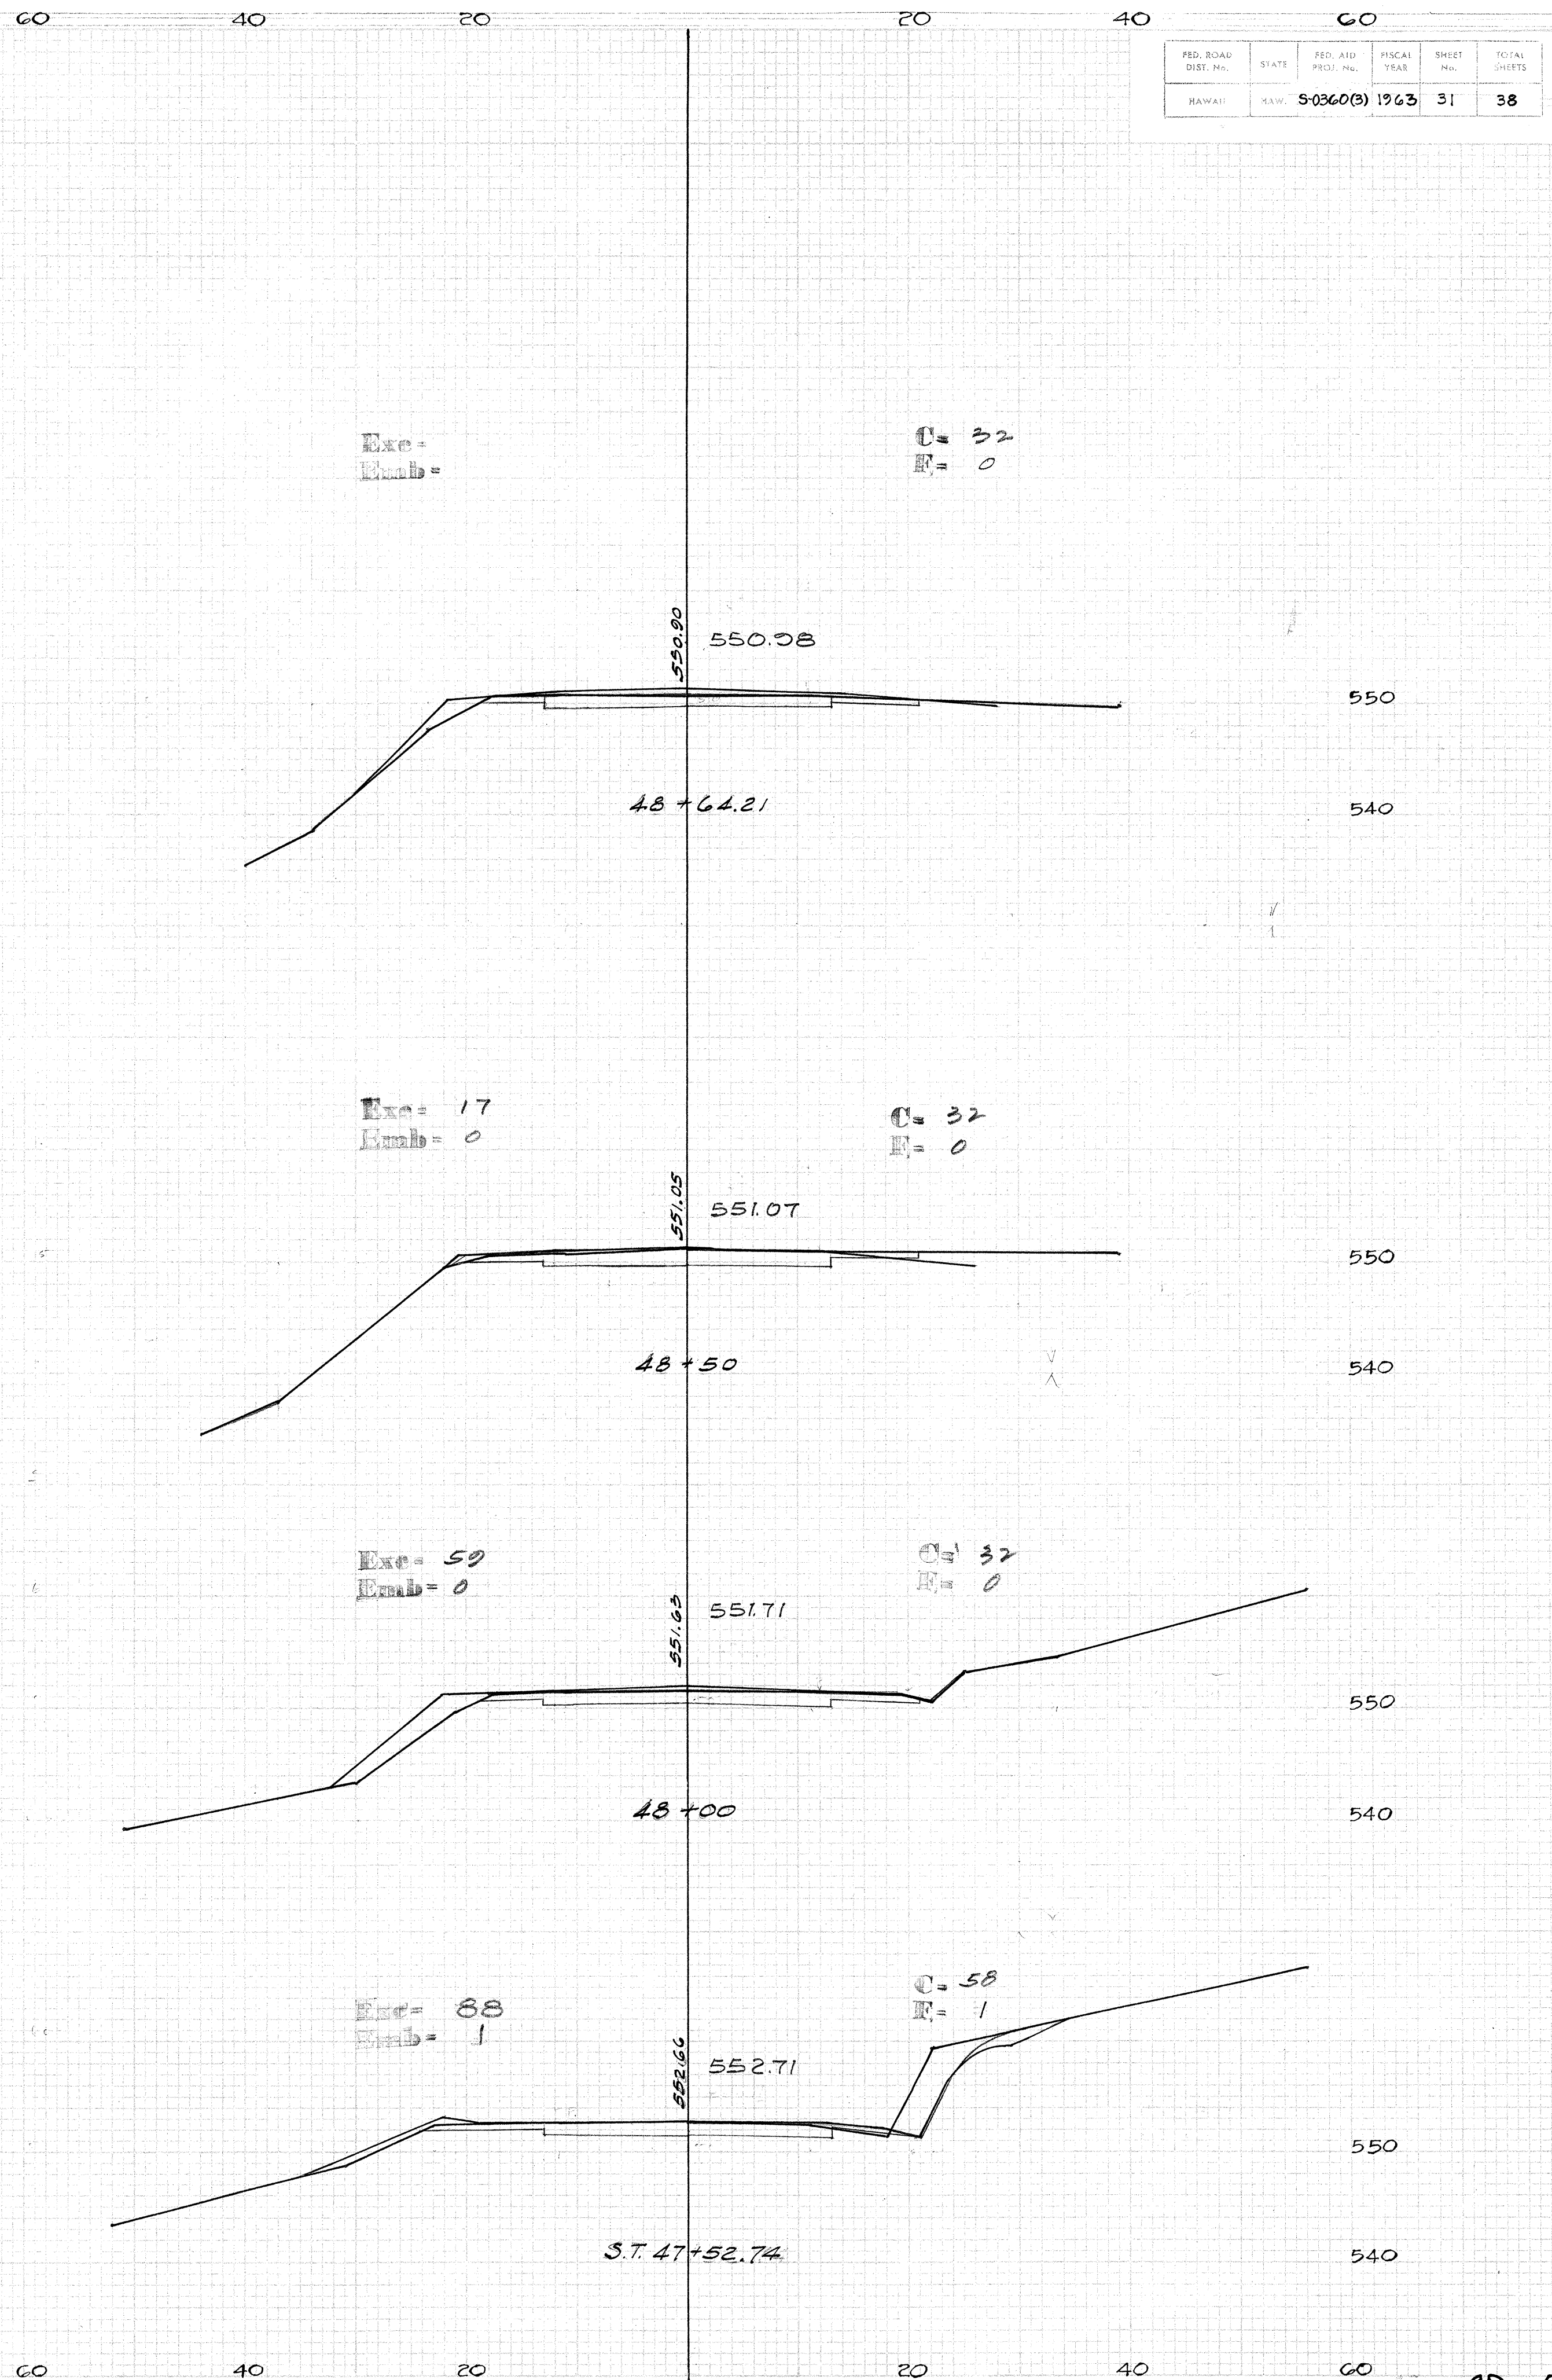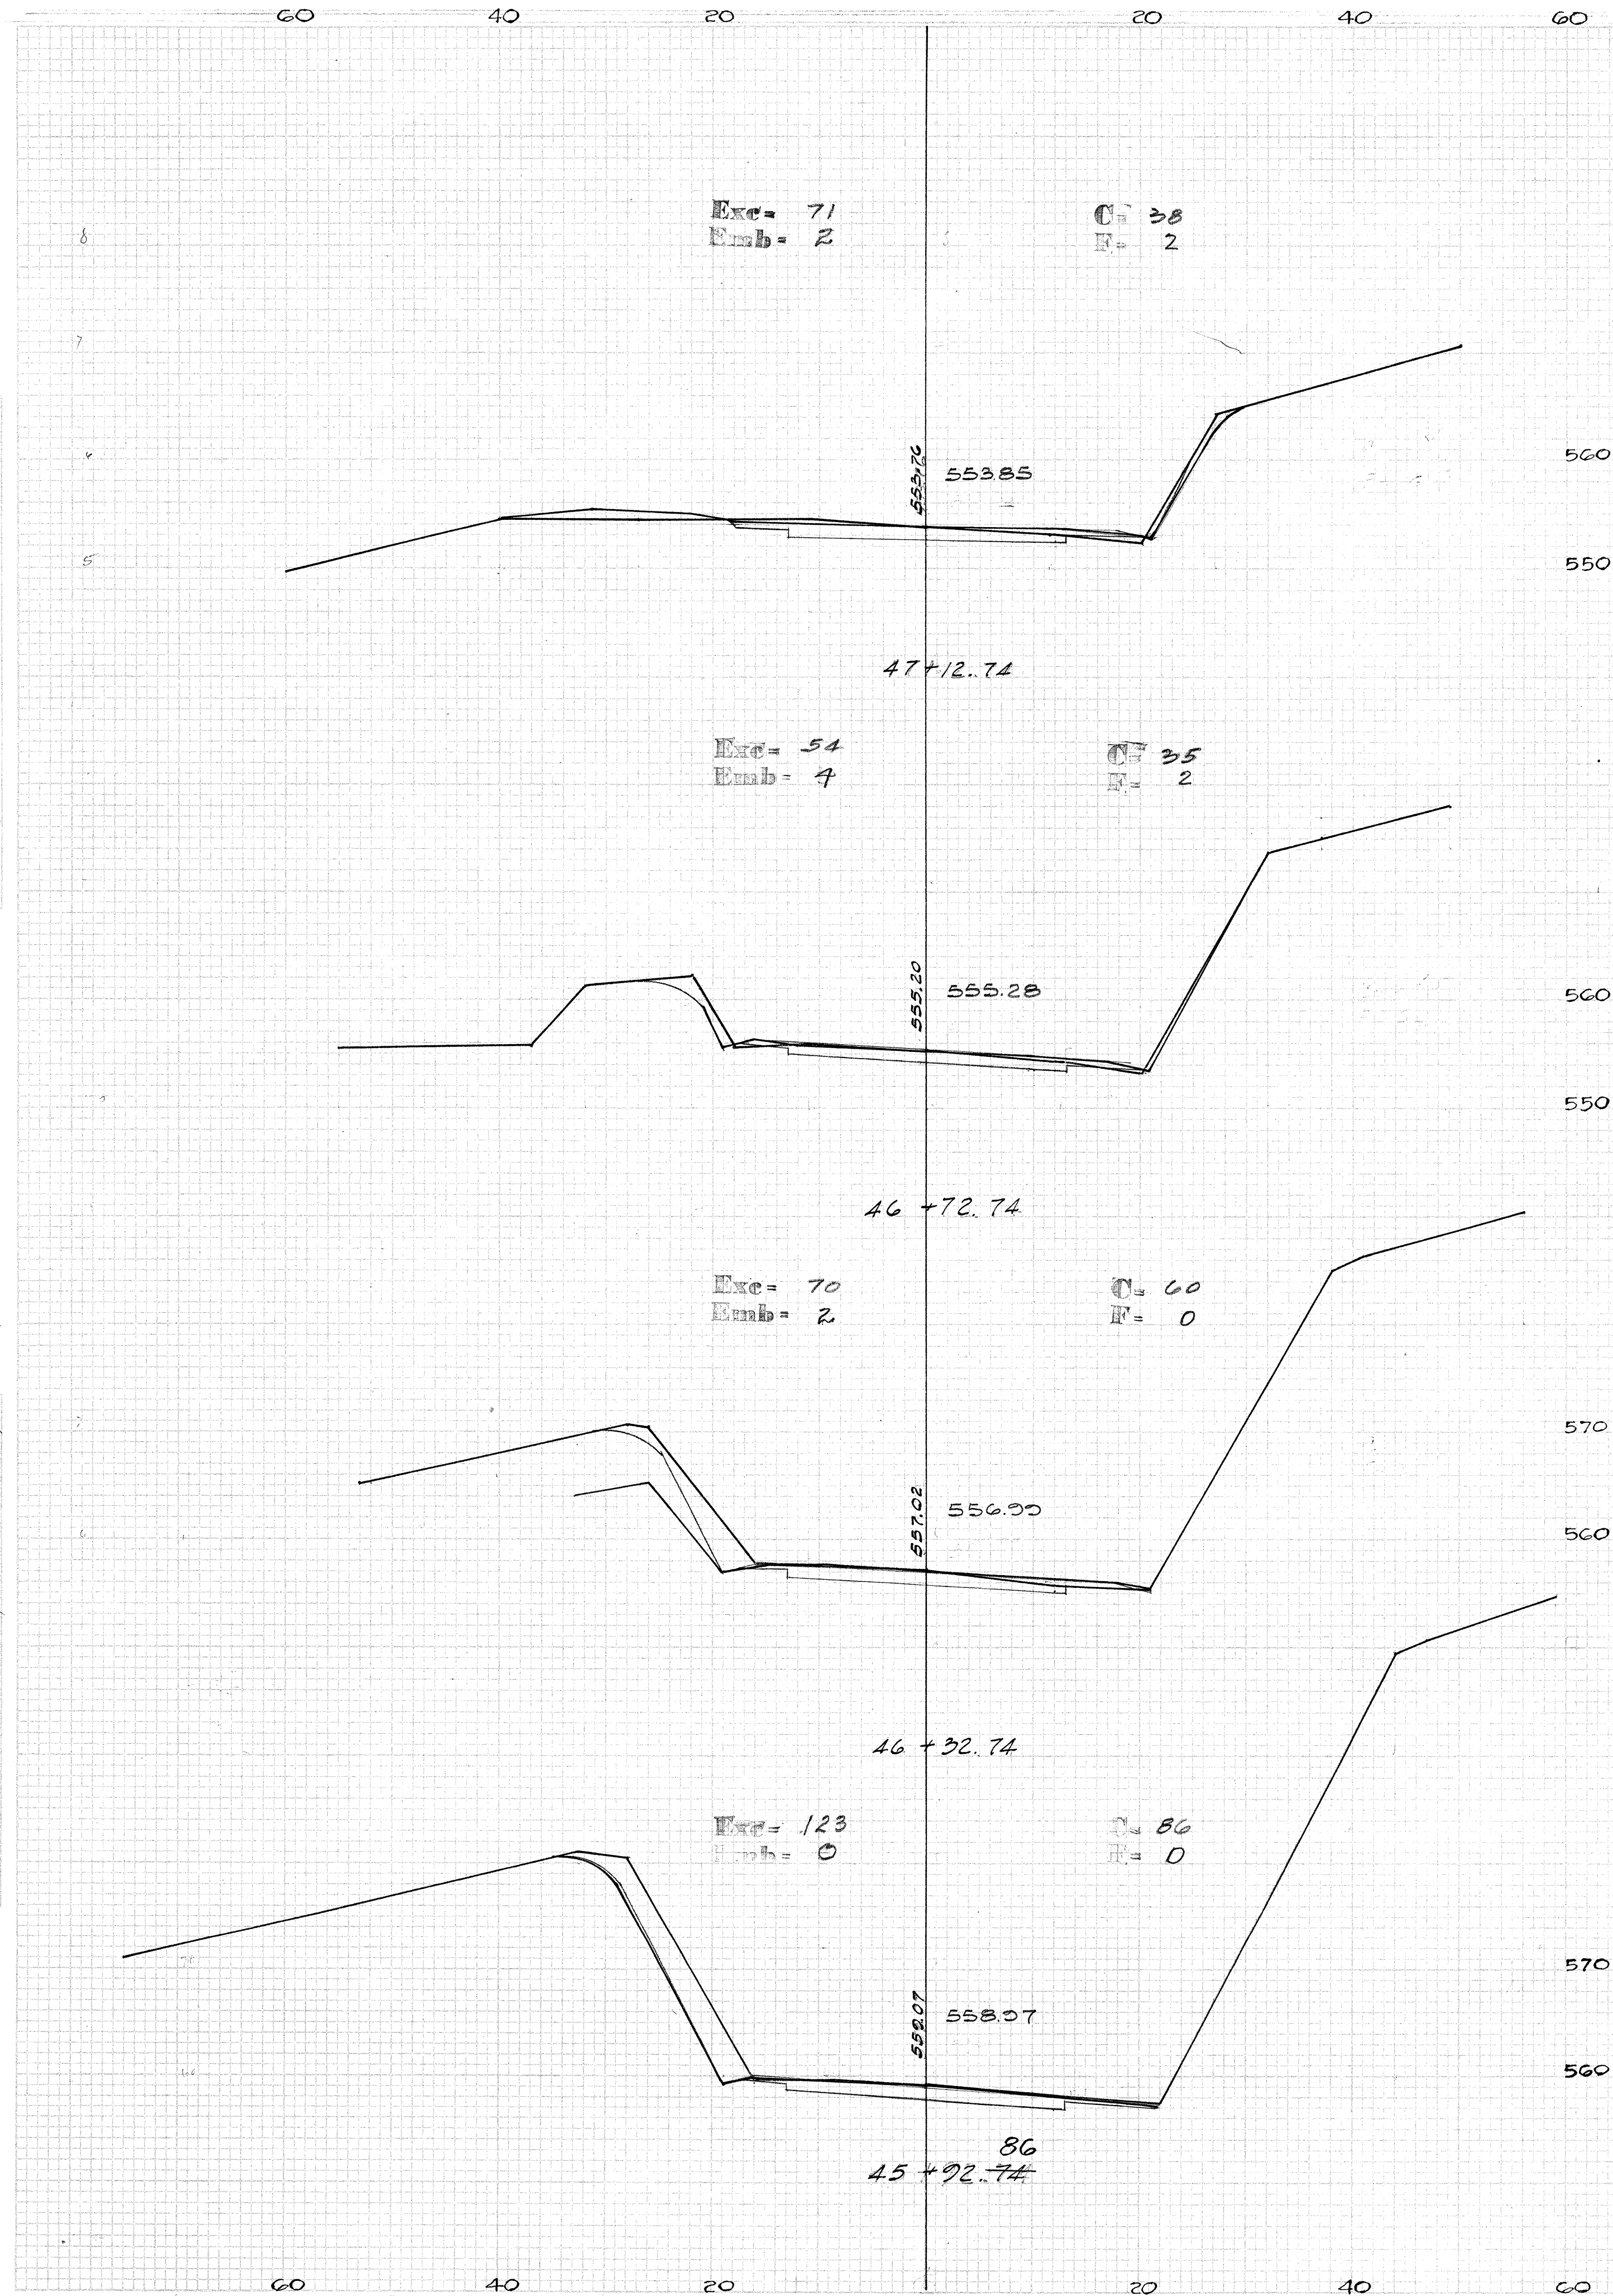

FED. ROAD DIST. NO.	STATE	FED. AID PROJ. NO.	FISCAL YEAR	SHEET NO.	TOTAL SHEETS
HAWAII	HAW	5-0360(3)	1963	32A	38

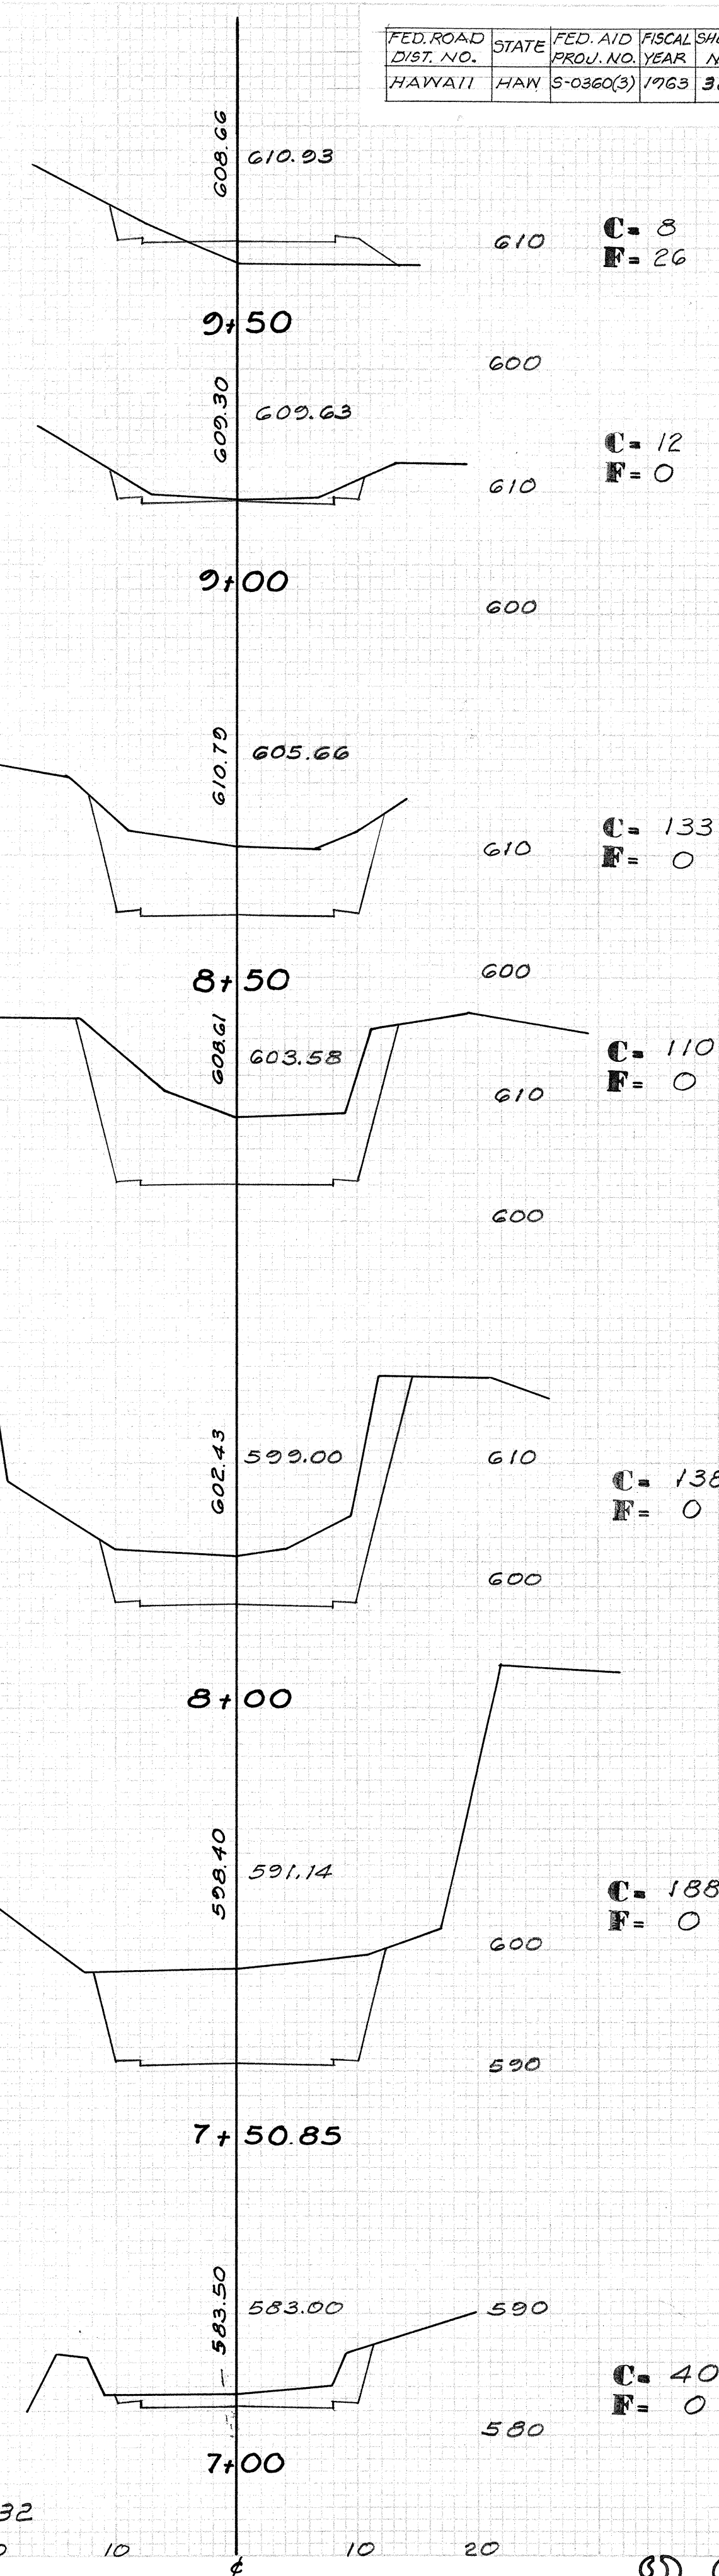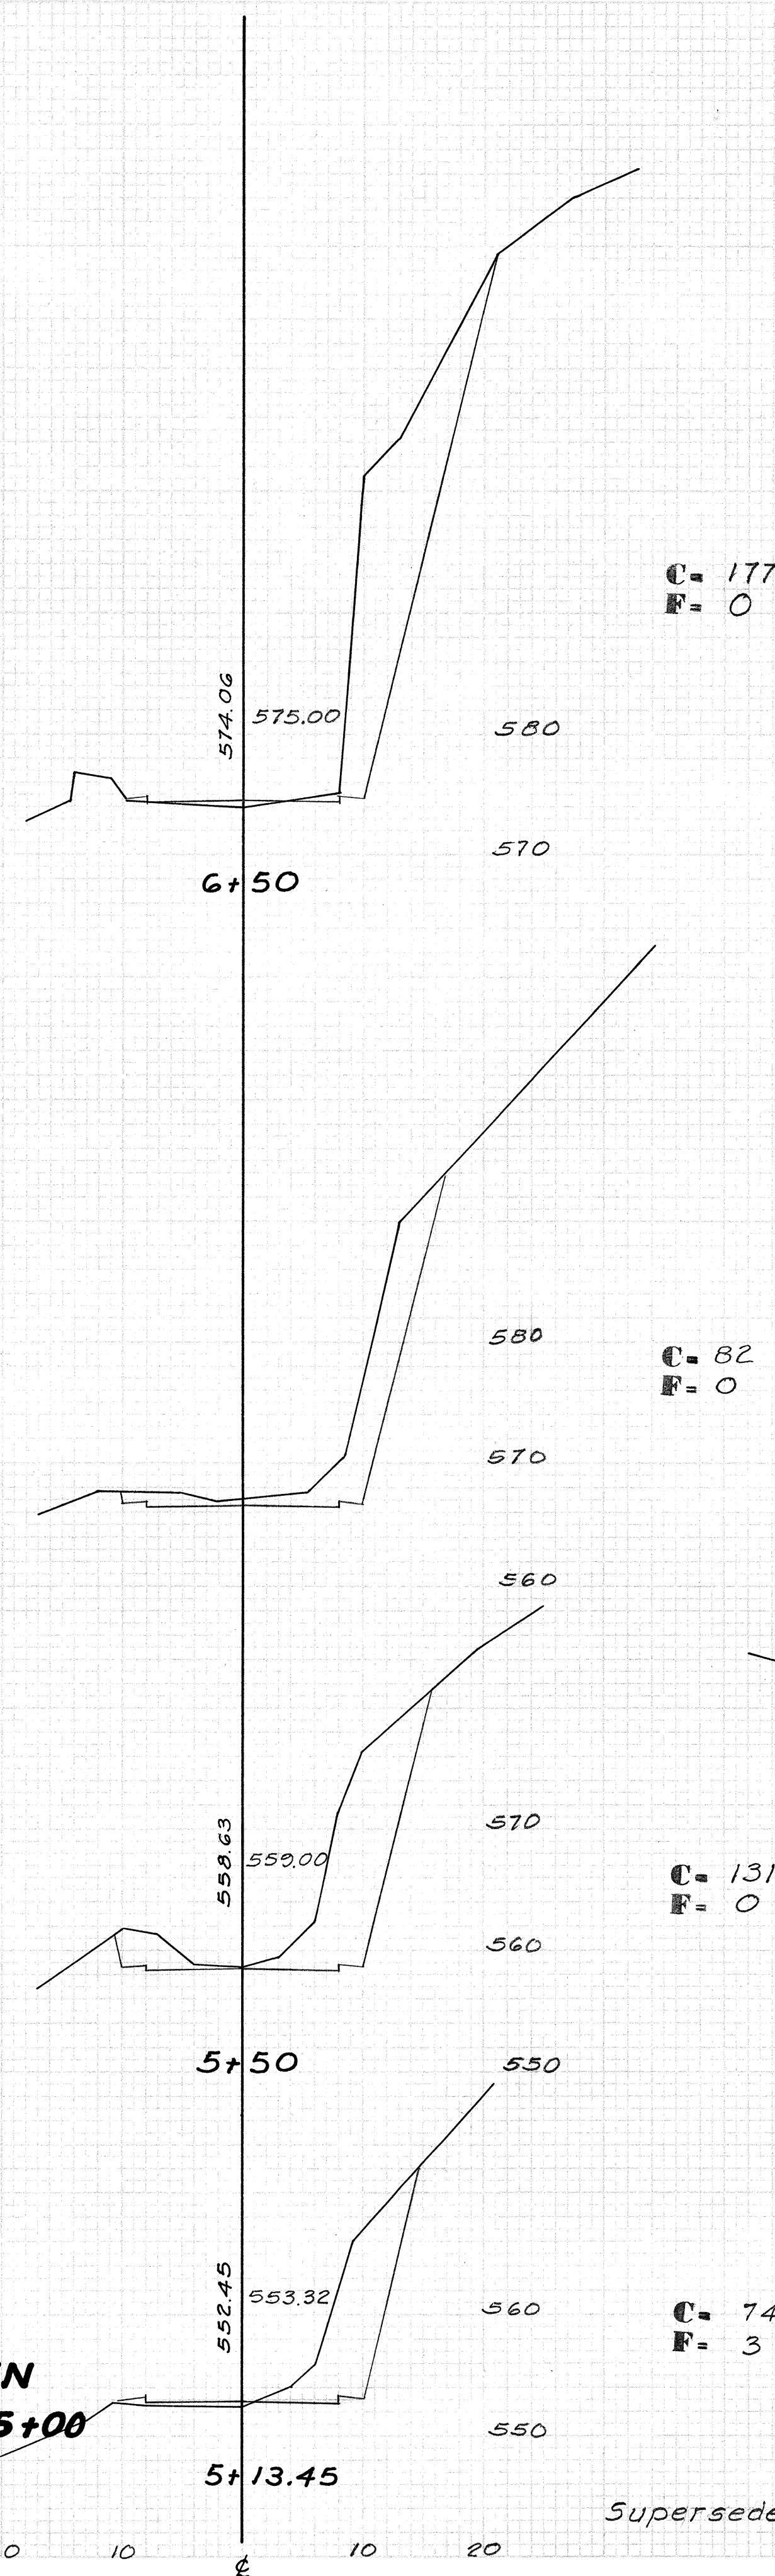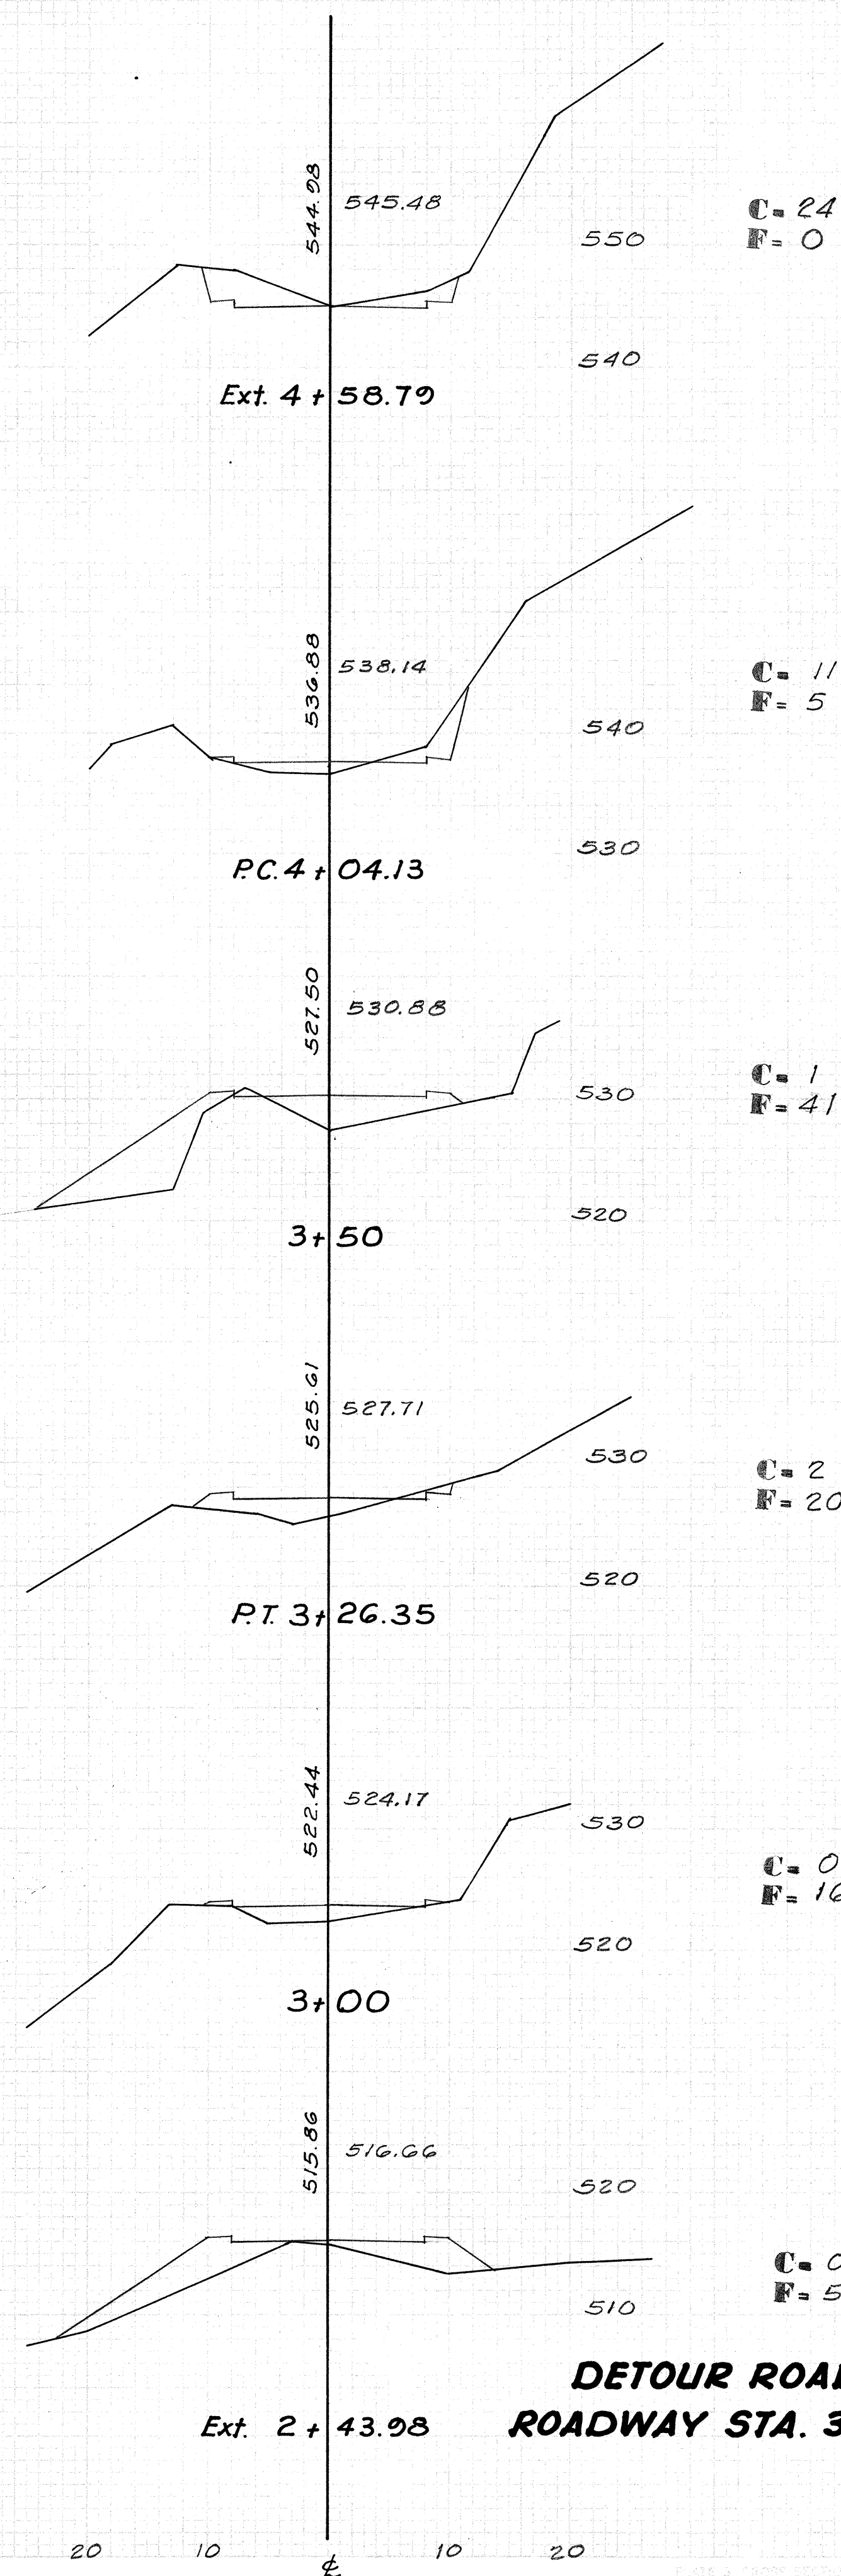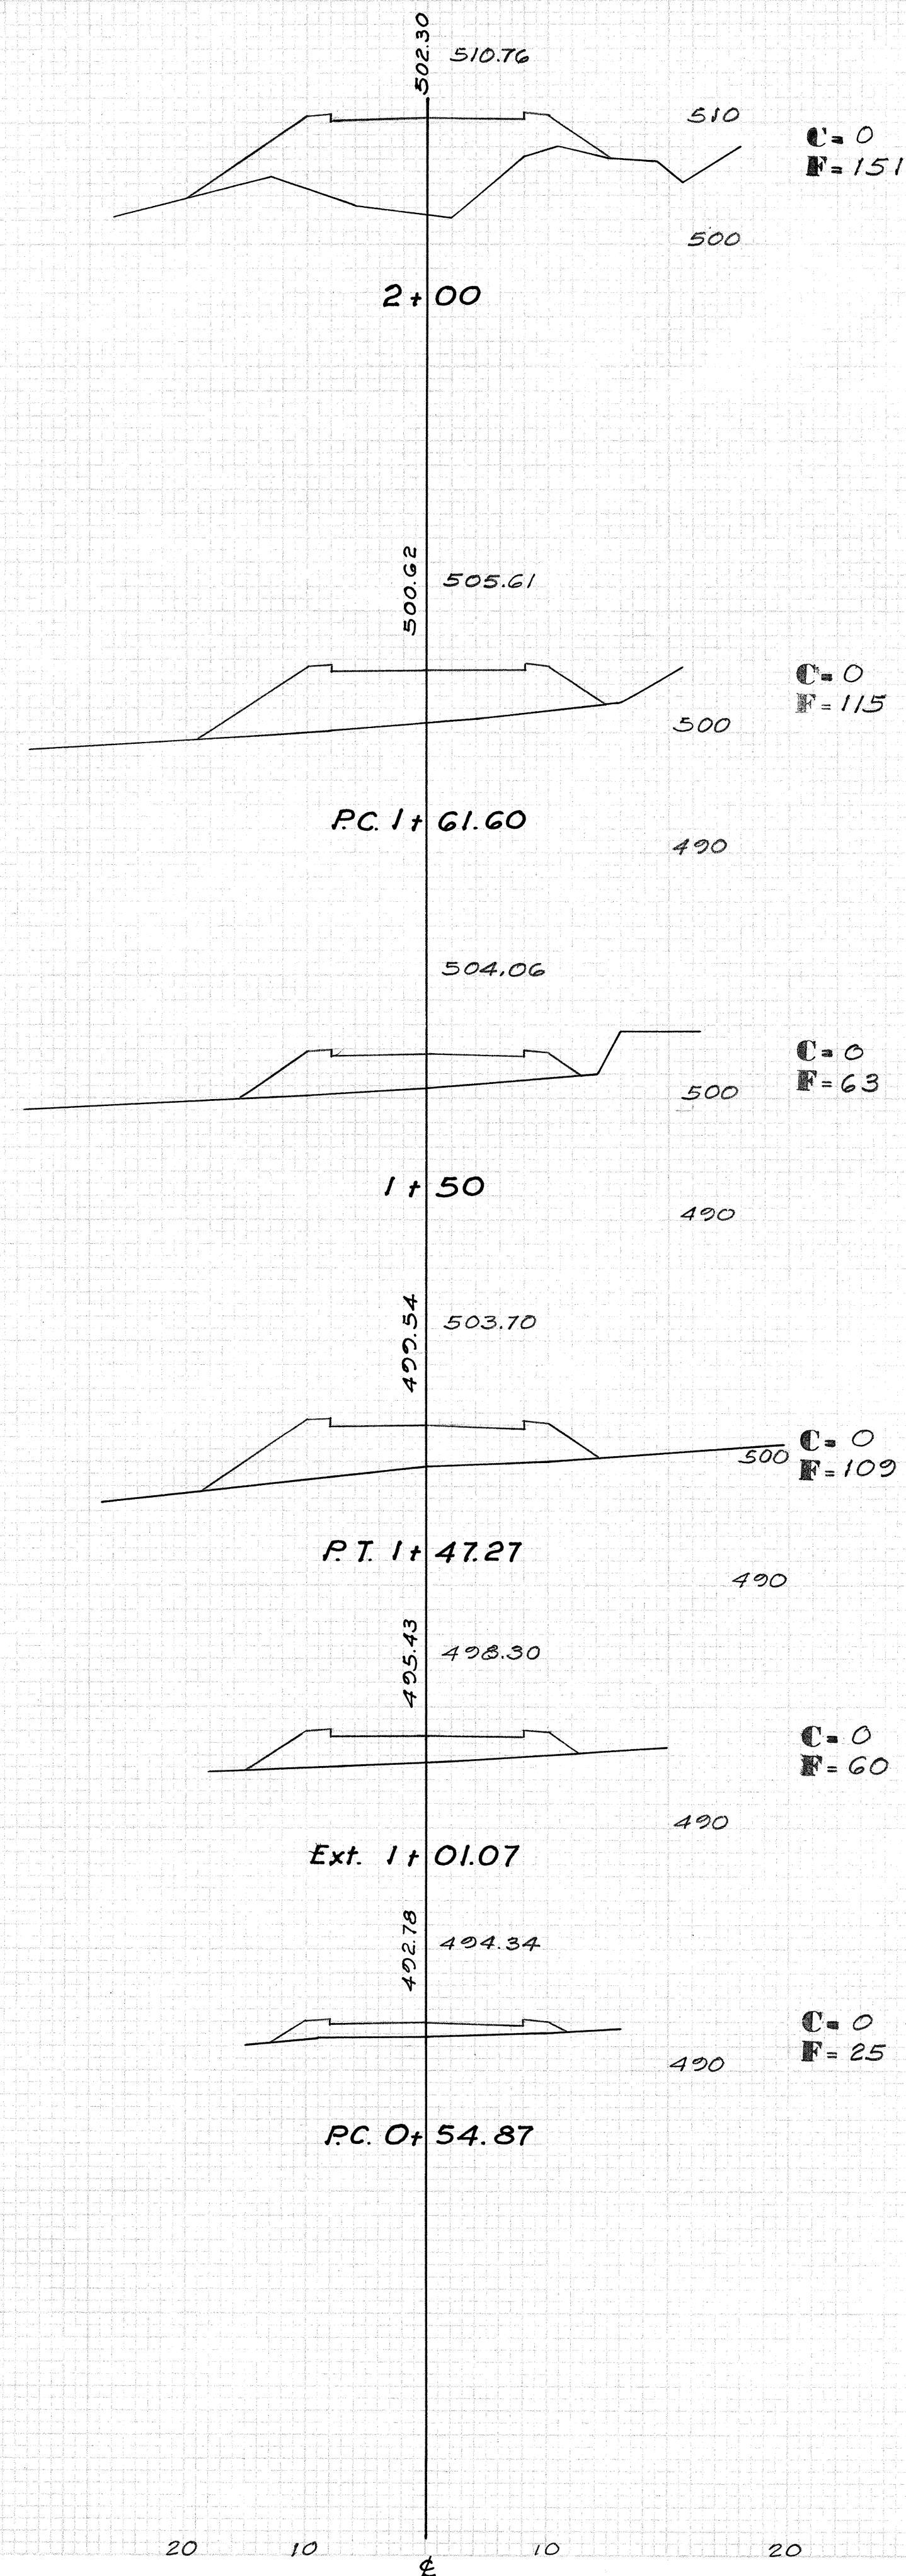

DETOUR ROAD BETWEEN
ROADWAY STA. 30+00 & 45+00

Supersedes Sht. No. 32

FED. ROAD DIST. NO.	STATE	FED. AID PROJ. NO.	FISCAL YEAR	SHEET NO.	TOTAL SHEETS
HAWAII	HAW	S-0360(3)	1963	33B	35

