



PLAN  
 SURVEYED BY DATE  
 PLOTTED BY  
 CHECKED BY  
 NOTE BOOK NO. RT. OF WAY CHECKED NO.

PROFILE  
 SURVEYED BY DATE  
 PLOTTED BY  
 CHECKED BY  
 NOTE BOOK NO. GRADES CHECKED S. M.S. NOTED STRUCTURE NOTATIONS CHECKED NO.

| FED. ROAD DIST. NO. | STATE | FED. AID PROJ. NO. | FISCAL YEAR | SHEET NO. | TOTAL SHEETS |
|---------------------|-------|--------------------|-------------|-----------|--------------|
| HAWAII              | HAW.  | S-0360(3)          | 1963        | 3         | 38           |

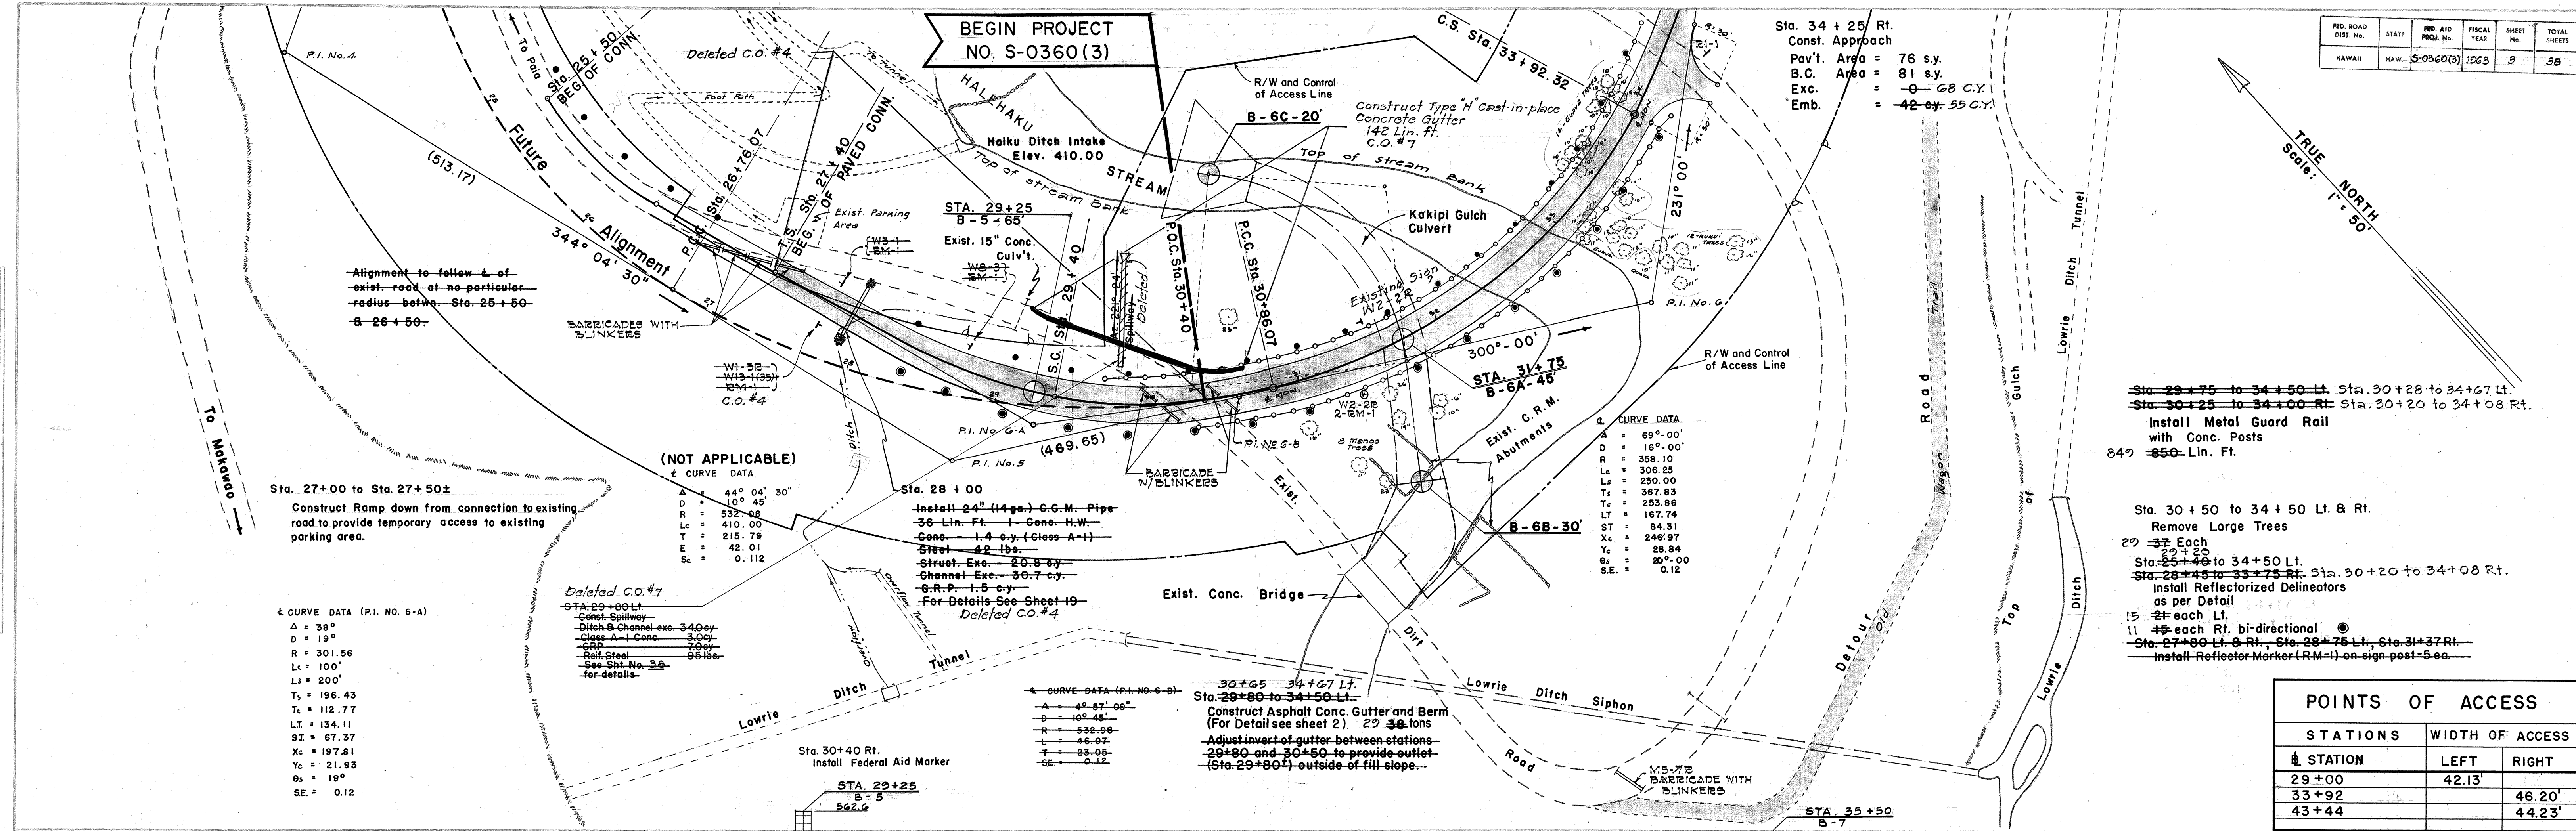


| POINTS OF ACCESS |                 |        |
|------------------|-----------------|--------|
| STATIONS         | WIDTH OF ACCESS |        |
| STATION          | LEFT            | RIGHT  |
| 29+00            | 42.13'          |        |
| 33+92            |                 | 46.20' |
| 43+44            |                 | 44.23' |

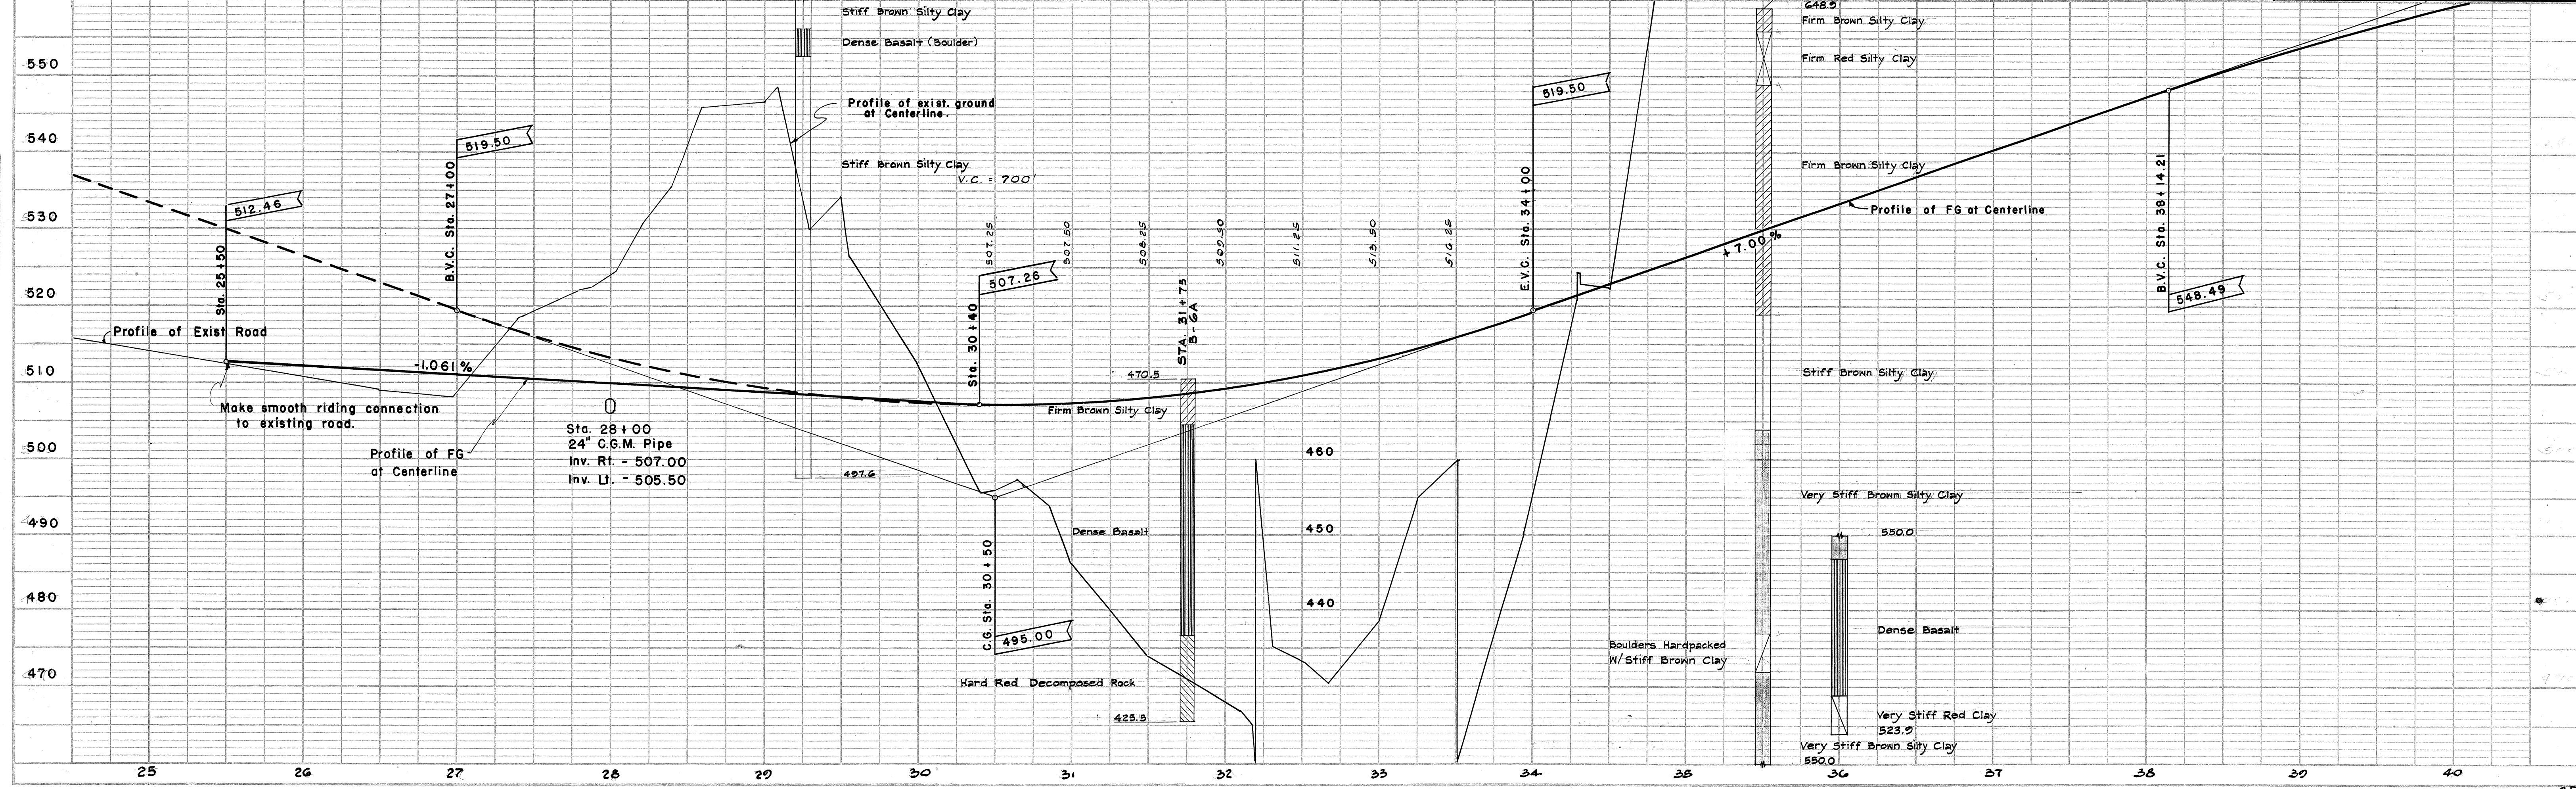

PLAN  
SURVEYED BY  
DATE  
NOTED BY  
CHECKED BY  
RT. OF WAY CHECKED  
NO.

PROFILE  
SURVEYED BY  
DATE  
NOTED BY  
CHECKED BY  
S. M.S. NOTED  
STRUCTURE NOTING CHD.  
NO.

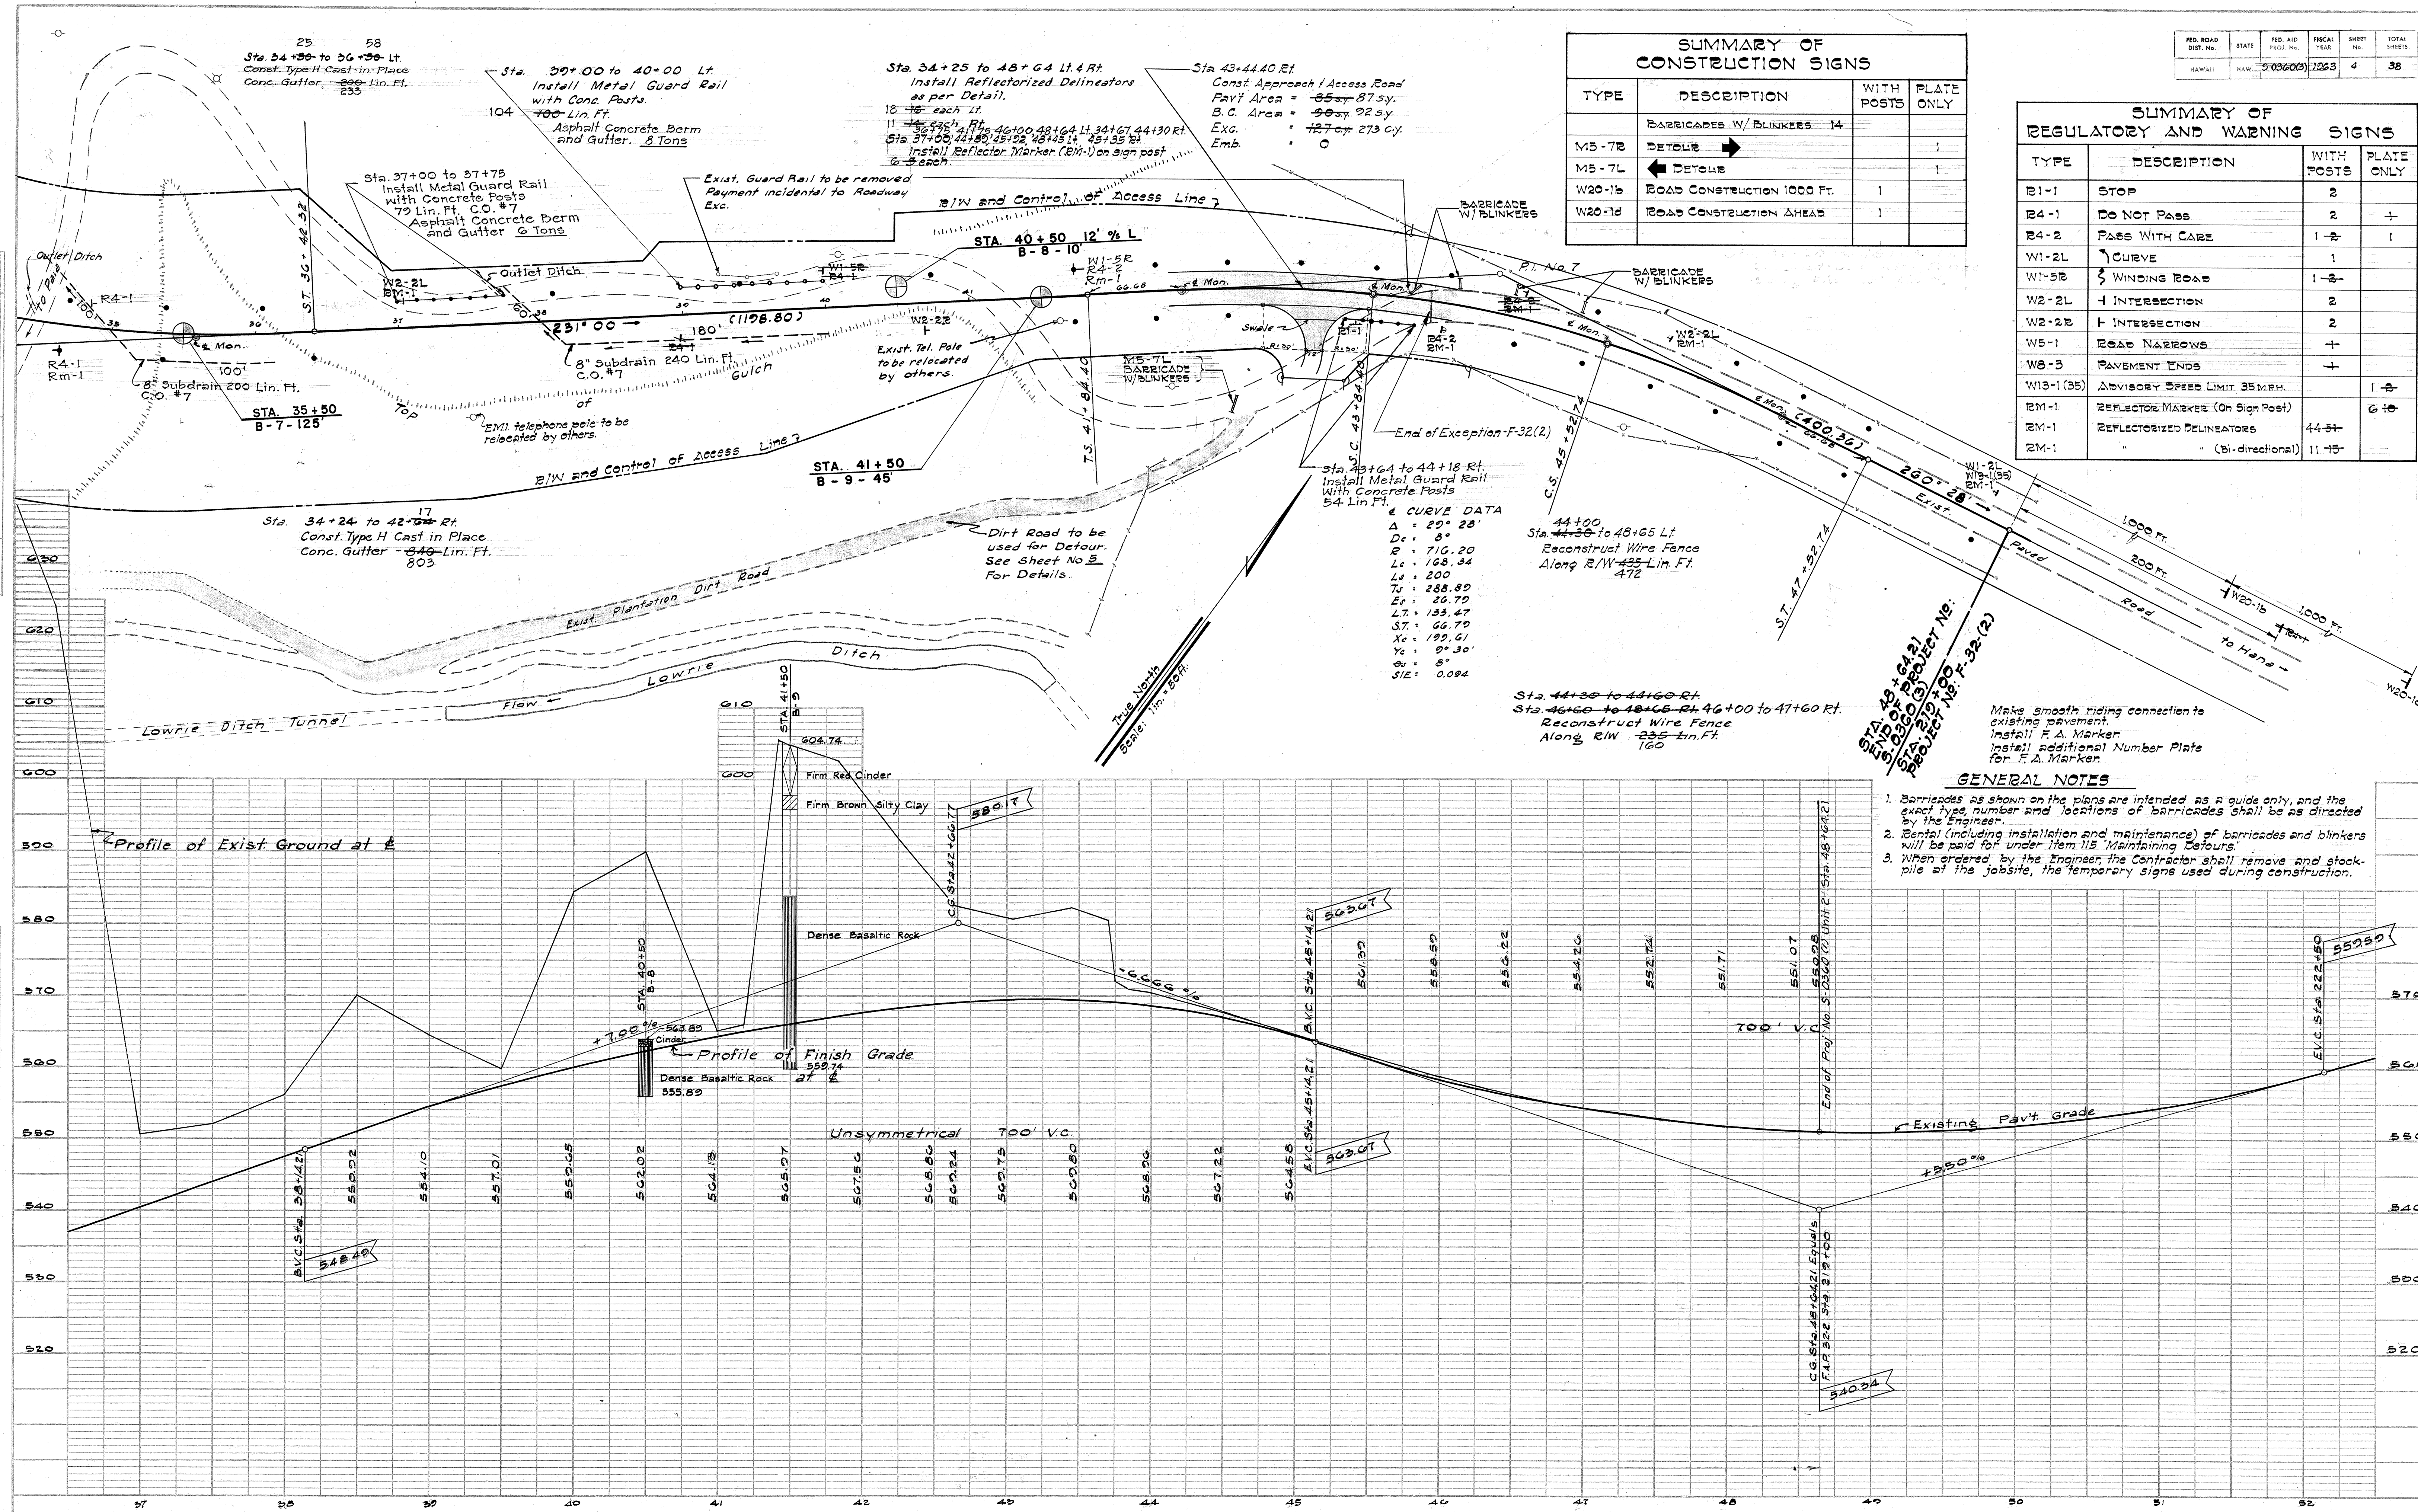

| SUMMARY OF CONSTRUCTION SIGNS |                            |            |            |
|-------------------------------|----------------------------|------------|------------|
| TYPE                          | DESCRIPTION                | WITH POSTS | PLATE ONLY |
| M5-7B                         | Barriers w/ blinkers       | 14         |            |
| M5-7L                         | Barriers w/ blinkers       |            | 1          |
| W20-1b                        | Road Construction 1000 Ft. | 1          |            |
| W20-1d                        | Road Construction Ahead    | 1          |            |

| SUMMARY OF REGULATORY AND WARNING SIGNS |                                 |            |            |
|-----------------------------------------|---------------------------------|------------|------------|
| TYPE                                    | DESCRIPTION                     | WITH POSTS | PLATE ONLY |
| R1-1                                    | STOP                            | 2          |            |
| R4-1                                    | DO NOT PASS                     | 2          | +          |
| R4-2                                    | PASS WITH CARE                  | 1-2        | 1          |
| W1-2L                                   | Curve                           | 1          |            |
| W1-5B                                   | Winding Road                    | 1-2        |            |
| W2-2L                                   | Intersection                    | 2          |            |
| W2-2B                                   | Intersection                    | 2          |            |
| W5-1                                    | Road Narrows                    | +          |            |
| W8-3                                    | Pavement Ends                   | +          |            |
| W13-1 (35)                              | Advisory Speed Limit 35 MPH.    |            | 1-2        |
| RM-1                                    | Reflector Marker (On Sign Post) |            | 6-10       |
| RM-1                                    | Reflectorized Delineators       | 44-54      |            |
| RM-1                                    | " (Bi-directional)              | 11-15      |            |


| FED. ROAD DIST. NO. | STATE | FED. AID PROJ. NO. | FISCAL YEAR | SHEET NO. | TOTAL SHEETS |
|---------------------|-------|--------------------|-------------|-----------|--------------|
| HAWAII              | HAW.  | 5-036003           | 1963        | 4         | 38           |

SW 1/4 Sec 29, T. 42 N., R. 12 E., S. 32 (2)  
SW 1/4 Sec 30, T. 42 N., R. 12 E., S. 32 (2)  
SW 1/4 Sec 31, T. 42 N., R. 12 E., S. 32 (2)  
SW 1/4 Sec 32, T. 42 N., R. 12 E., S. 32 (2)


- GENERAL NOTES**
- Barriers as shown on the plans are intended as a guide only, and the exact type, number and locations of barriers shall be as directed by the Engineer.
  - Rental (including installation and maintenance) of barriers and blinkers will be paid for under Item 115 Maintaining Detours.
  - When ordered by the Engineer the Contractor shall remove and stockpile at the jobsite, the temporary signs used during construction.

| EE  |           | SURVEYED _____           | BY _____ | DATE _____ |
|-----|-----------|--------------------------|----------|------------|
| EAN | NOTE BOOK | PLOTTED _____            |          |            |
|     |           | ALIGNMENT CHECKED _____  |          |            |
|     |           | RT. OF WAY CHECKED _____ |          |            |
| NO. |           |                          |          |            |

|                  |                                 |          |            |
|------------------|---------------------------------|----------|------------|
| <b>PROFILE</b>   | SURVEYED _____                  | BY _____ | DATE _____ |
| <b>NOTE BOOK</b> | PLOTTED _____                   |          |            |
| <b>NO.</b>       | GRADES CHECKED _____            |          |            |
|                  | B. M. 2 NOTED _____             |          |            |
|                  | STRUCTURE NOTATIONS CH'WD _____ |          |            |


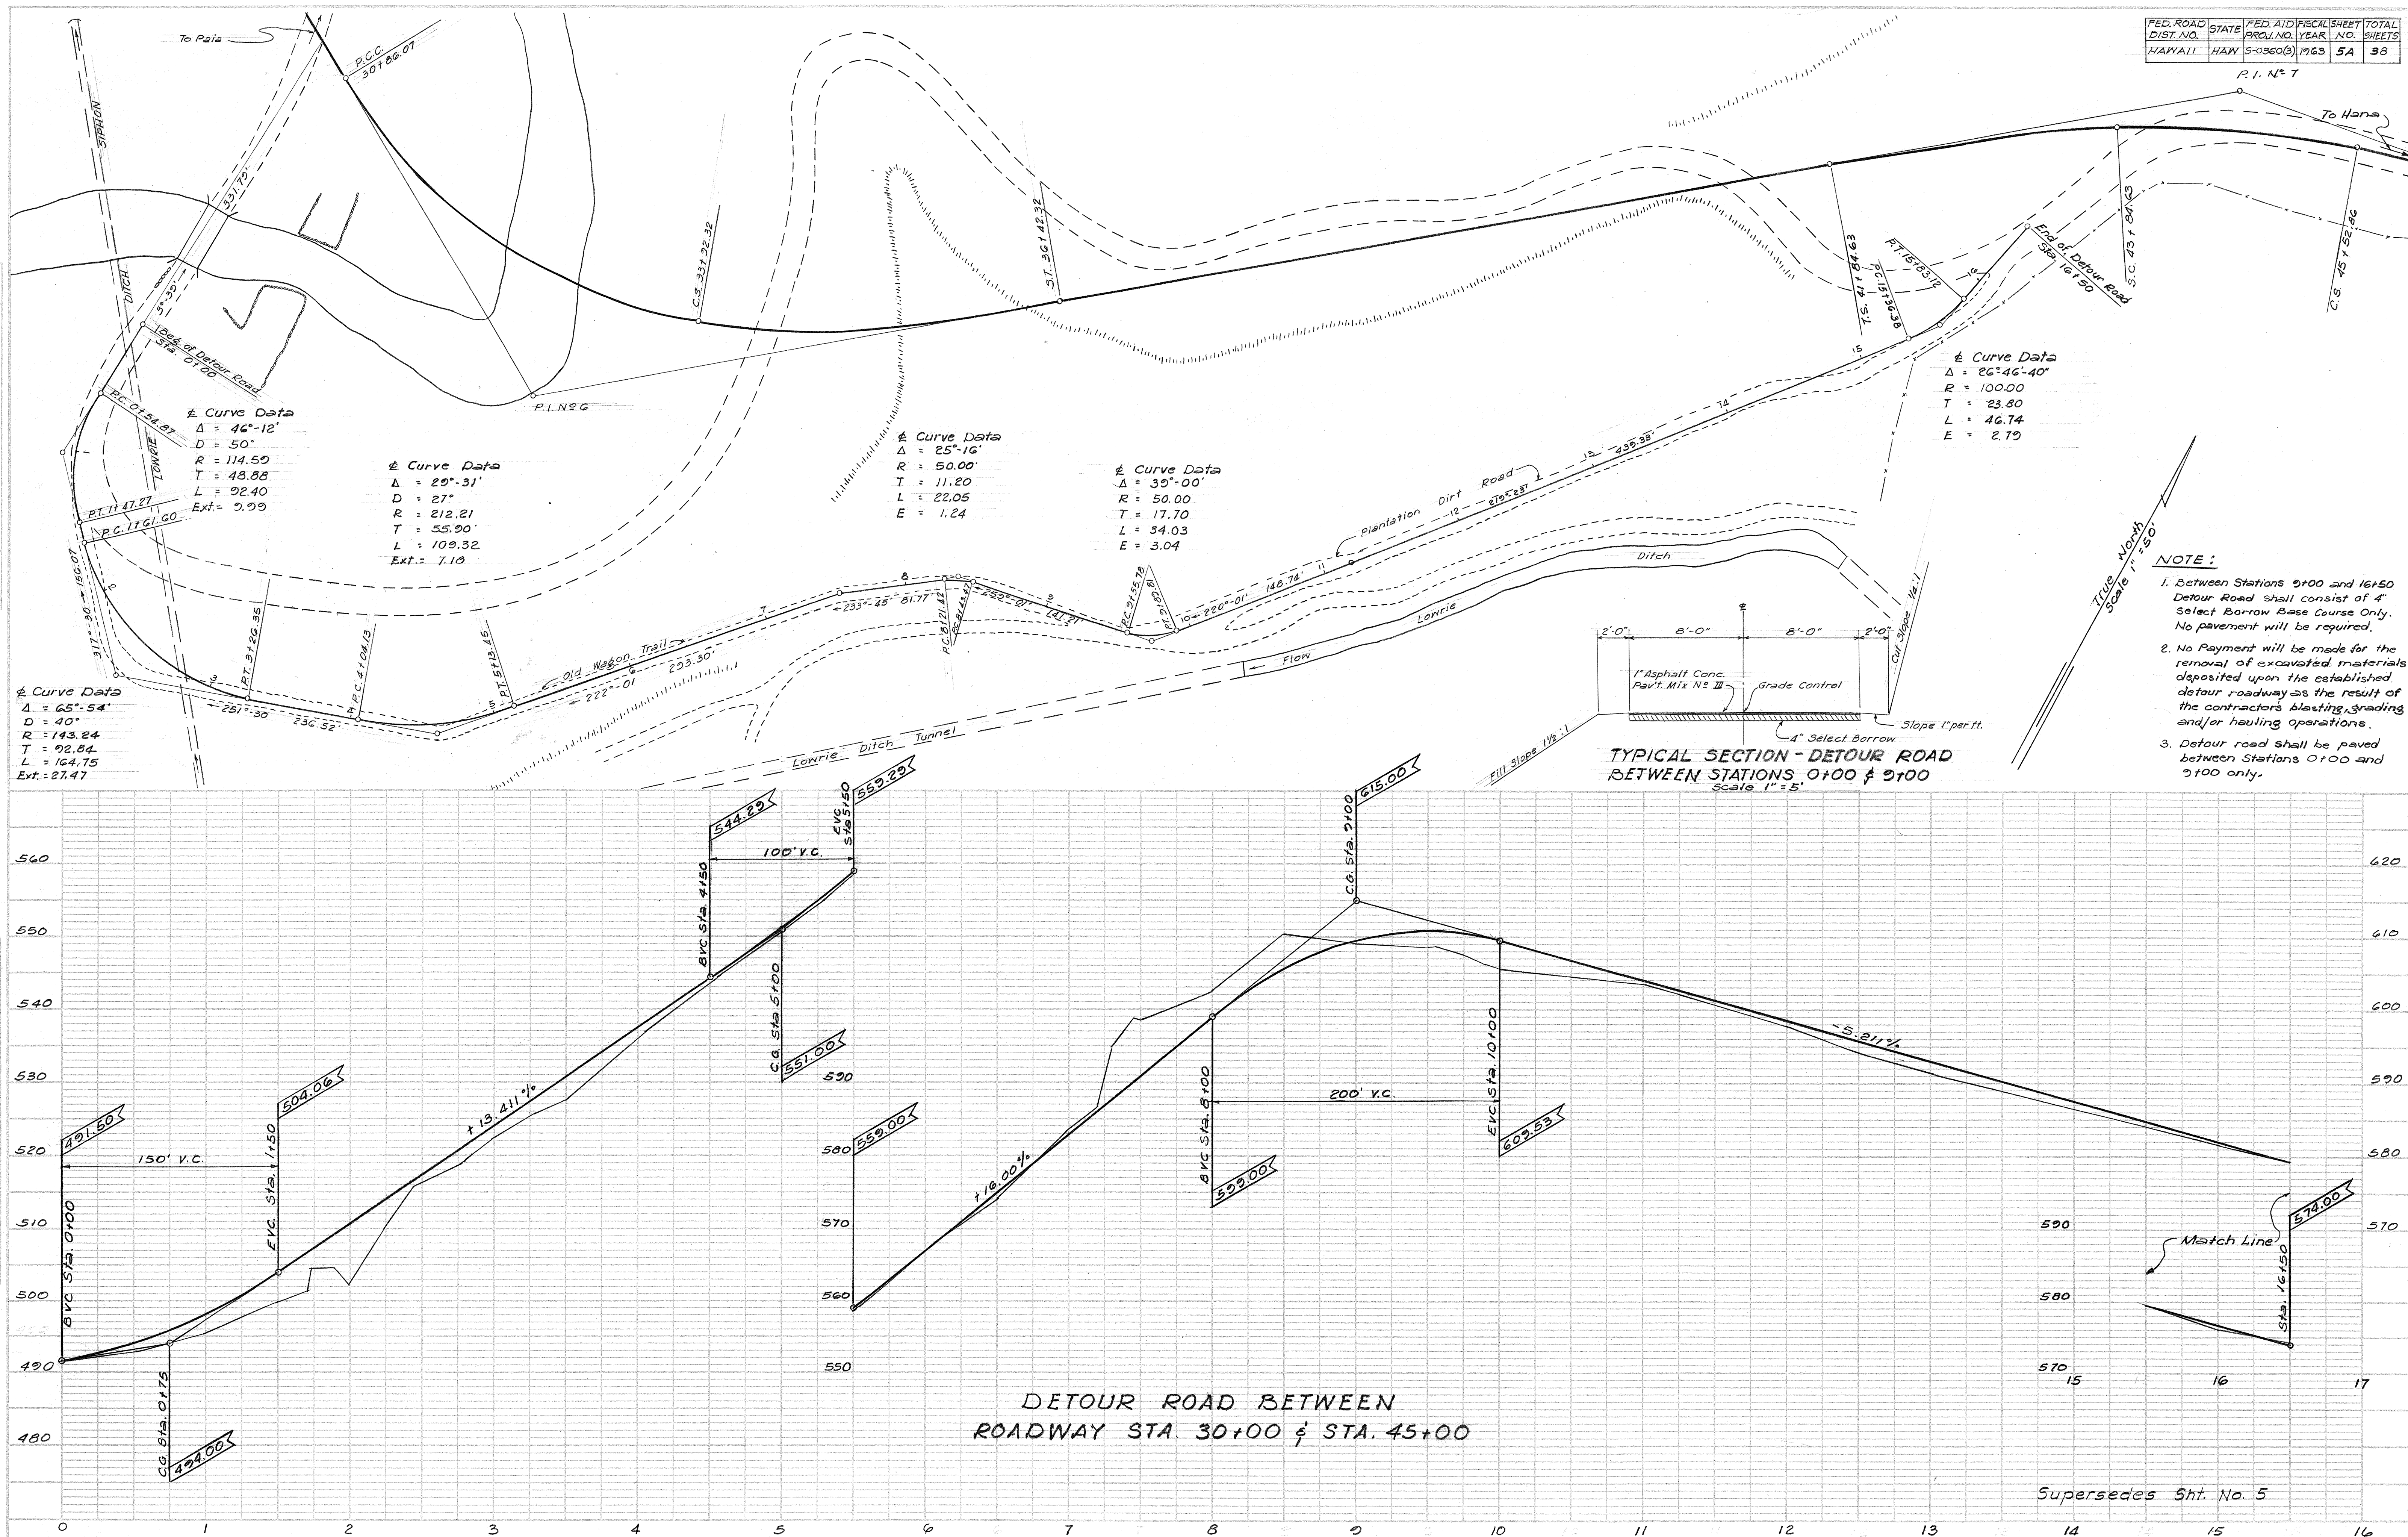


|                                                           |          |      |
|-----------------------------------------------------------|----------|------|
| PLAN                                                      | SURVEYED | DATE |
| NO.                                                       | BY       |      |
| NOTE: ROOMS PLOTTED, ALIGNED, CHECKED, AT OF WAY CHECKED. |          |      |

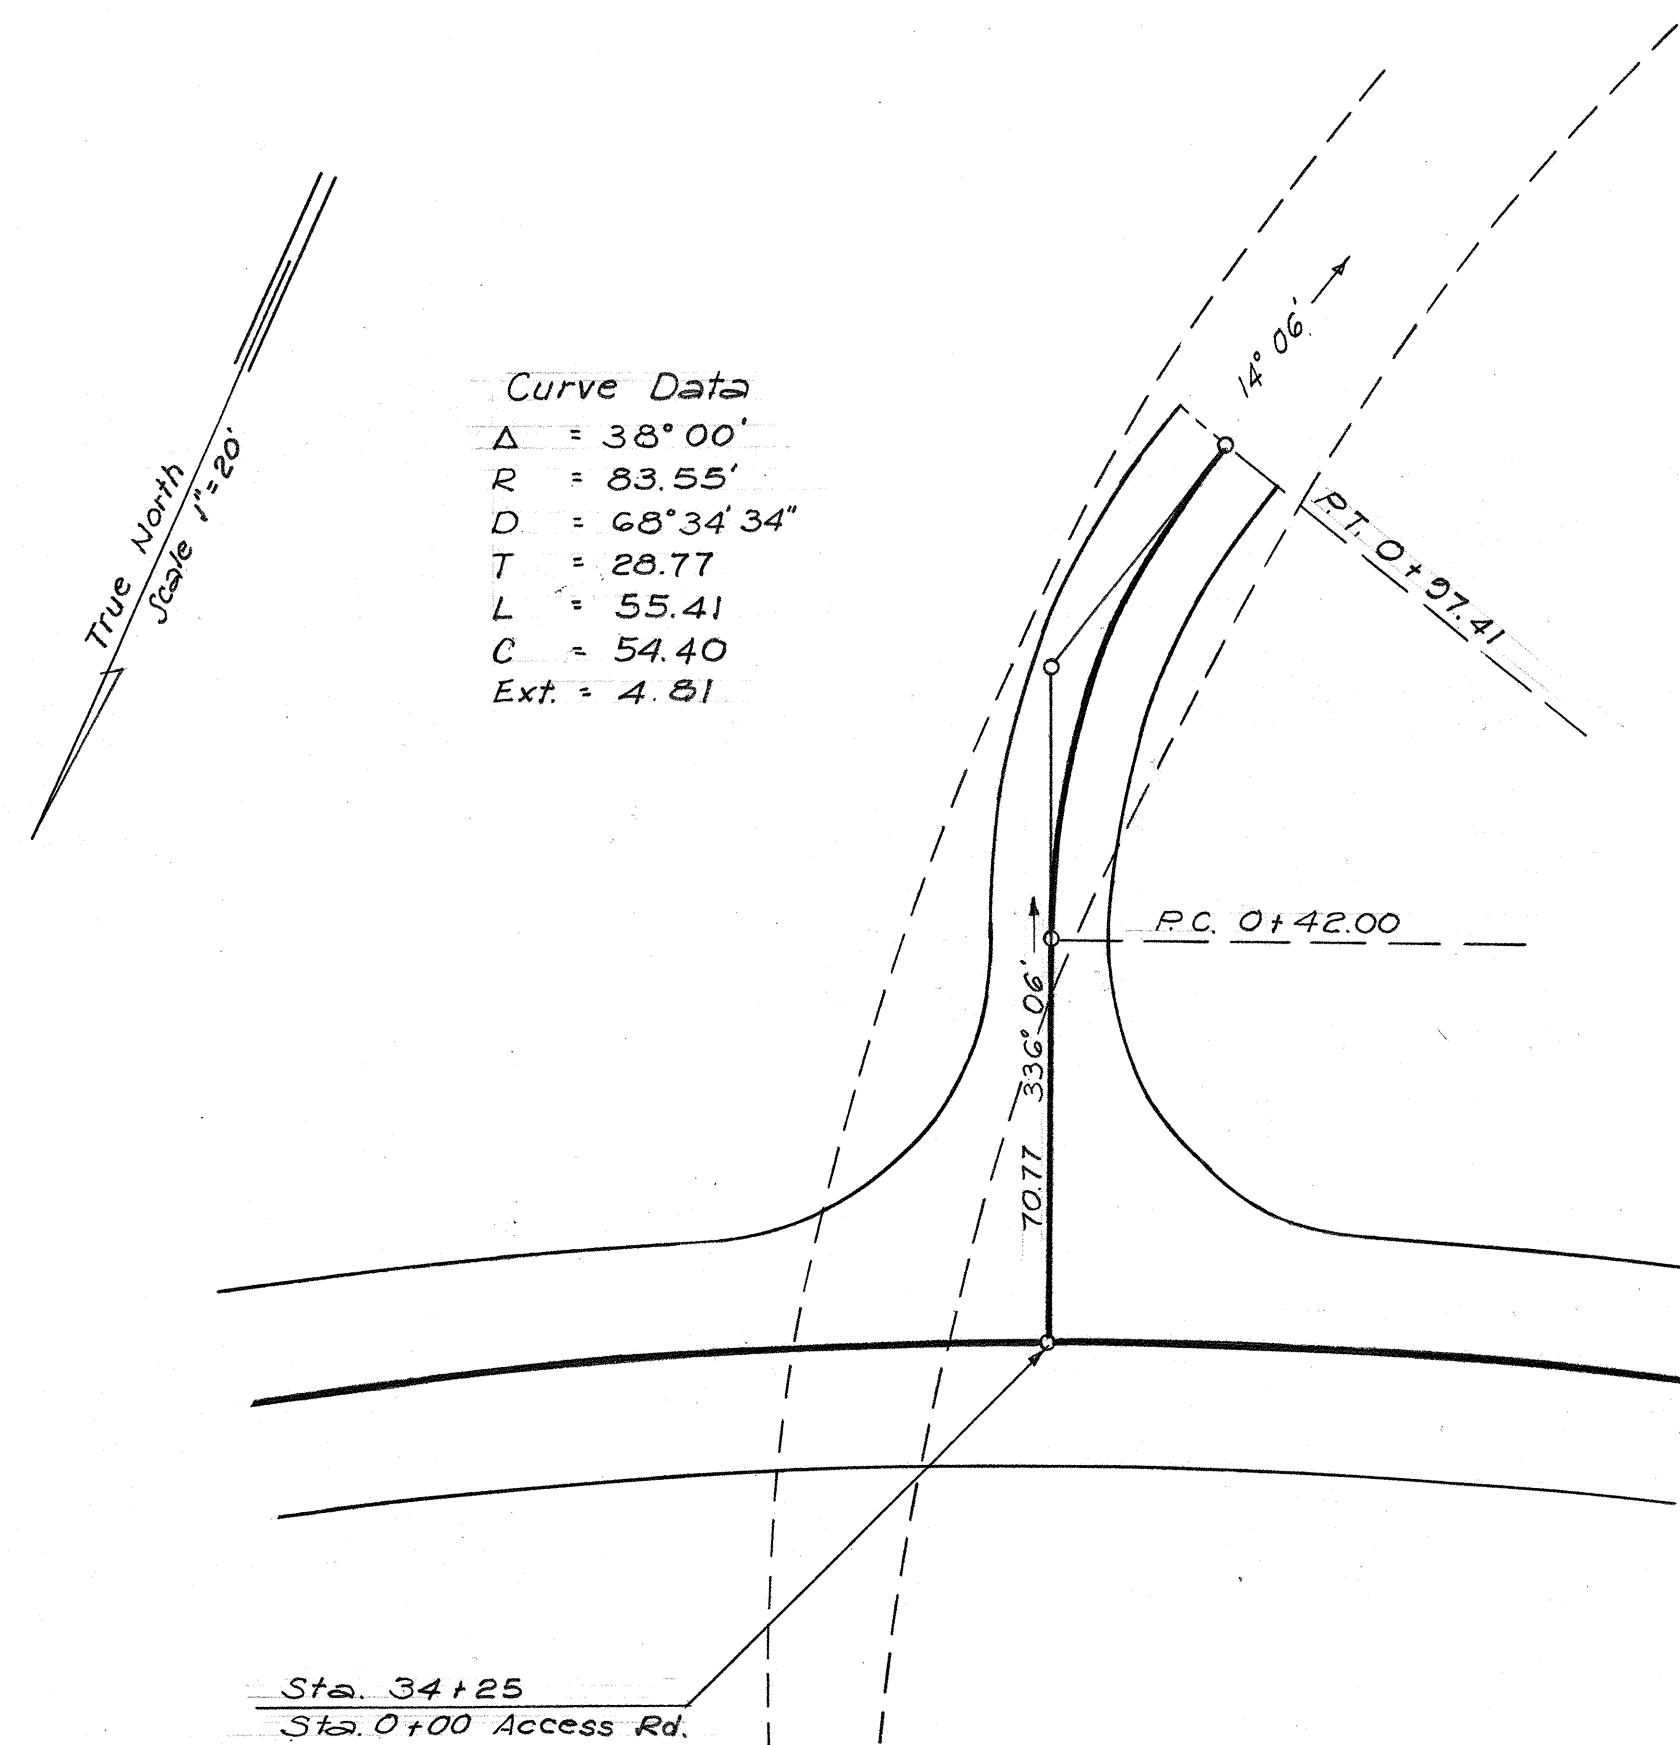

ACCESS ROAD AT STA. 34+25

|                                                                 |          |      |
|-----------------------------------------------------------------|----------|------|
| PROFILE                                                         | SURVEYED | DATE |
| NO.                                                             | BY       |      |
| NOTE: ROOMS PLOTTED, GRADES CHECKED, STRUCTURE LOCATIONS CH'NG. |          |      |

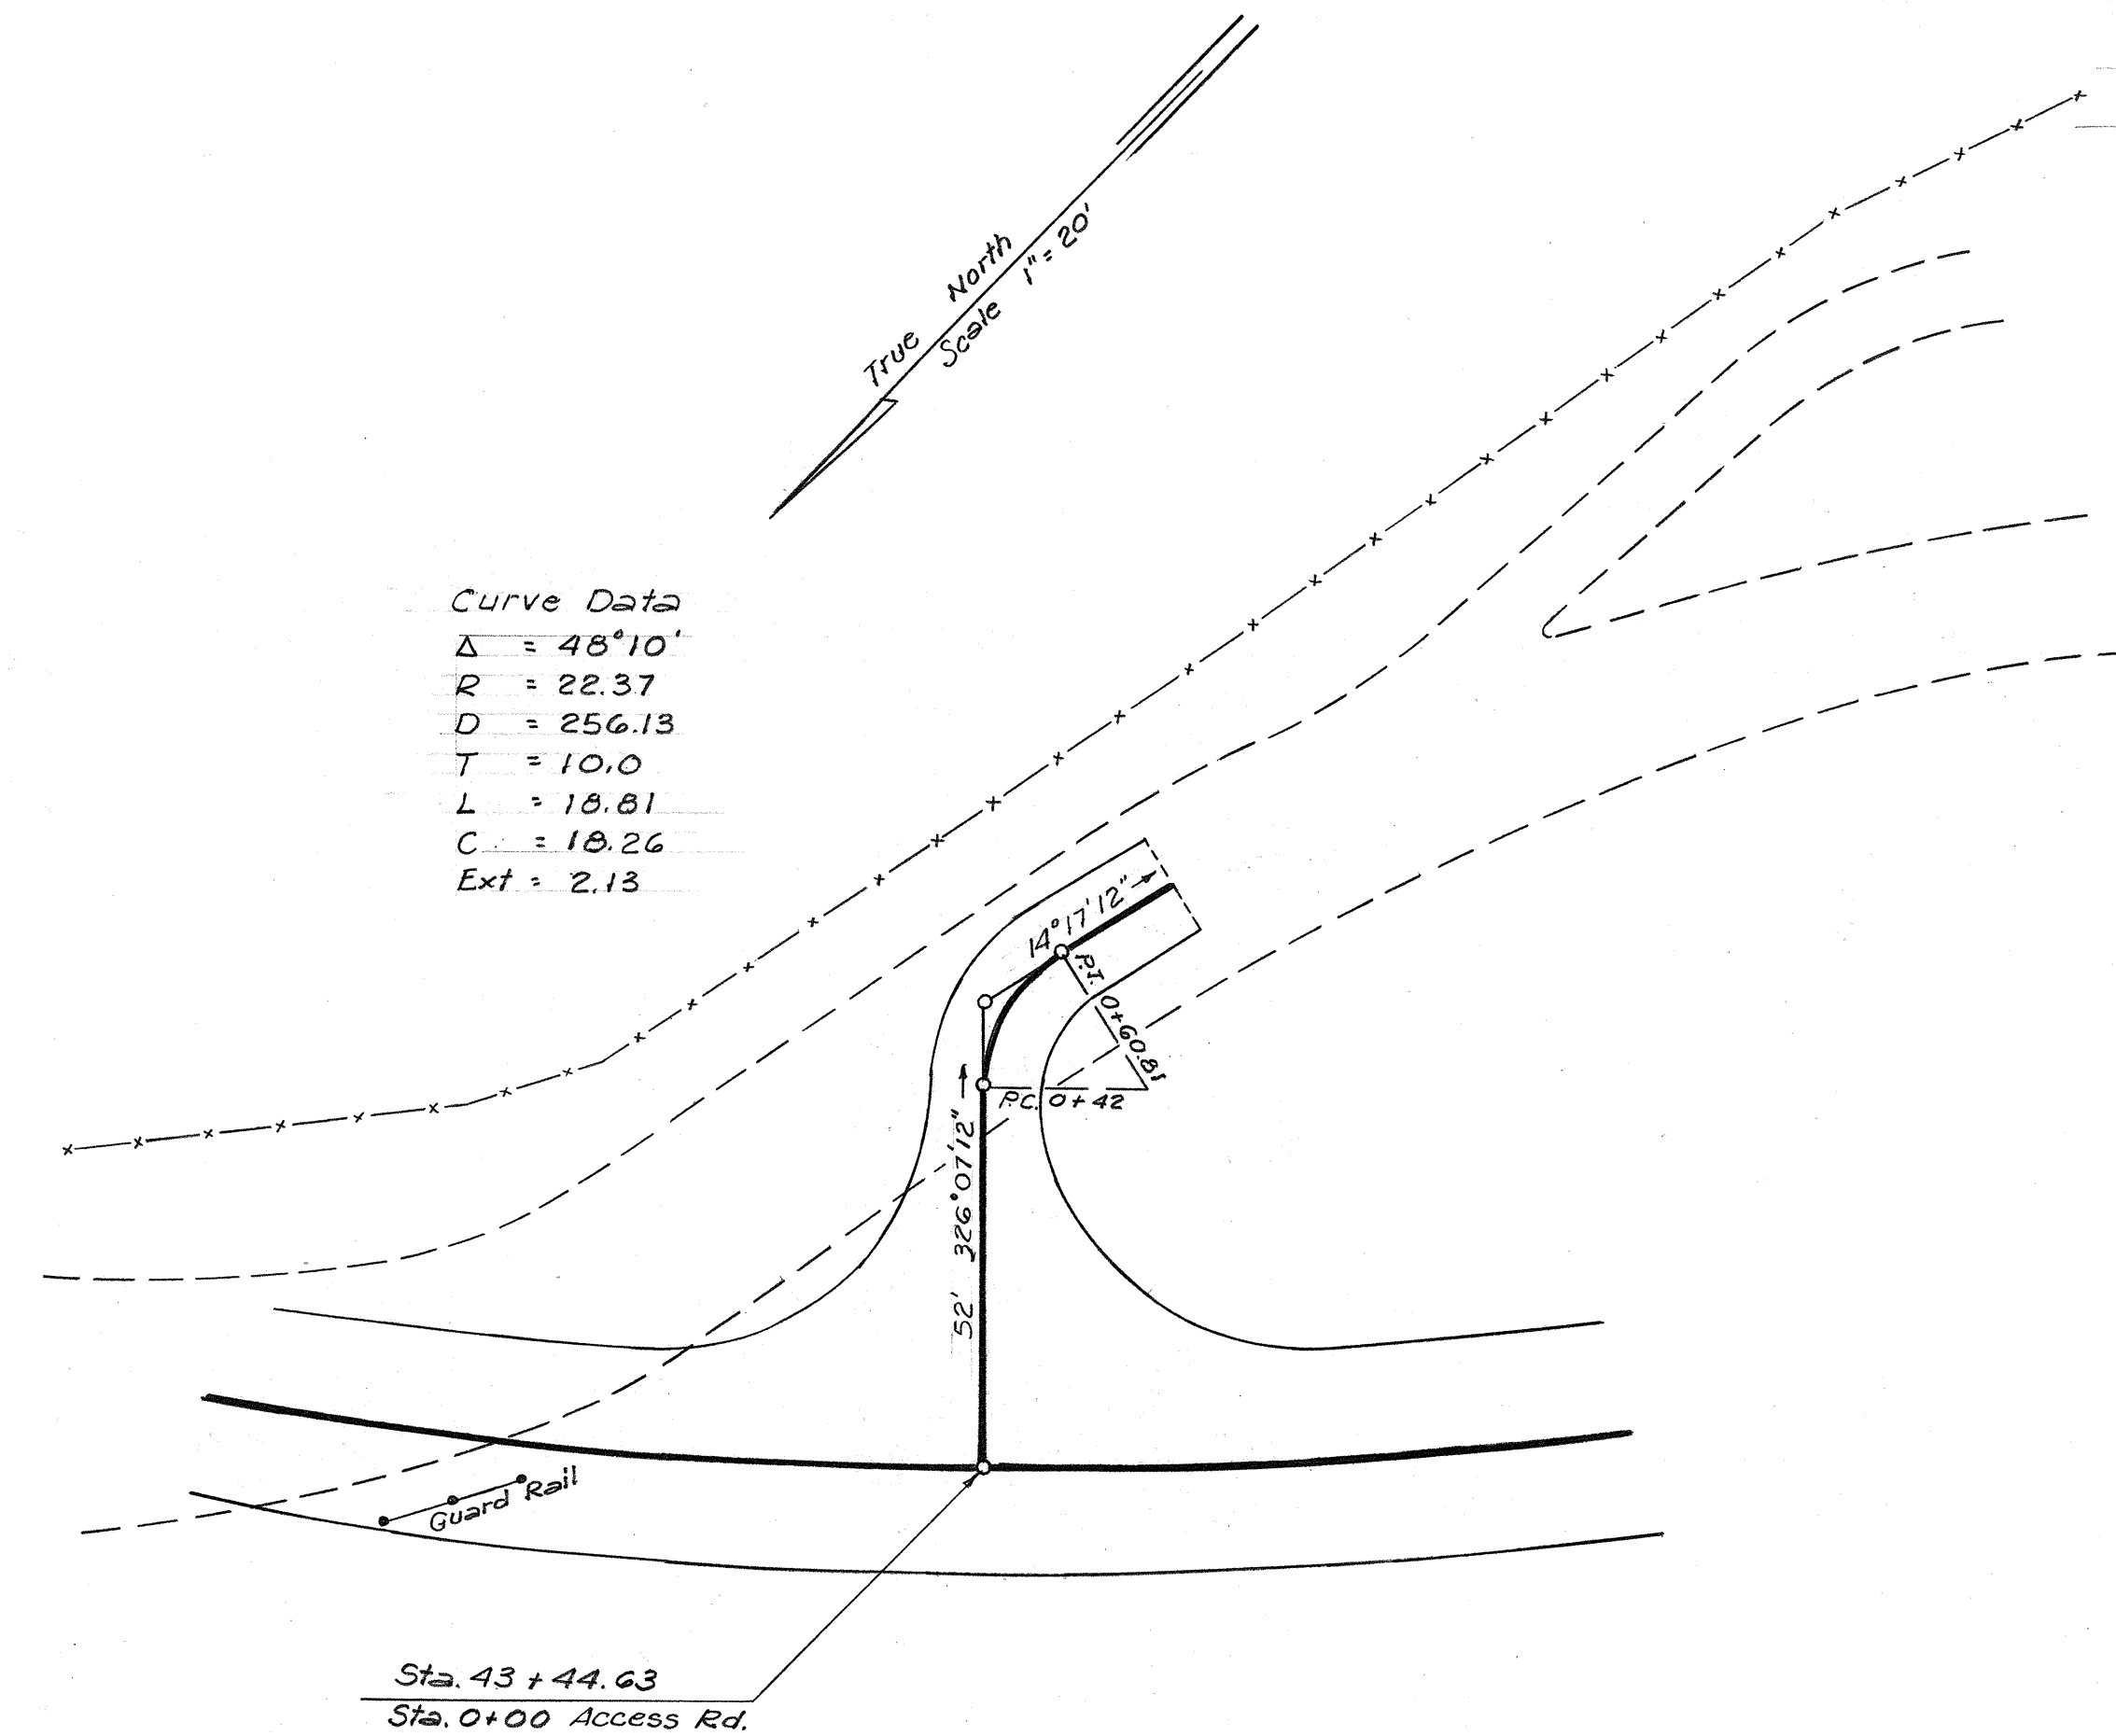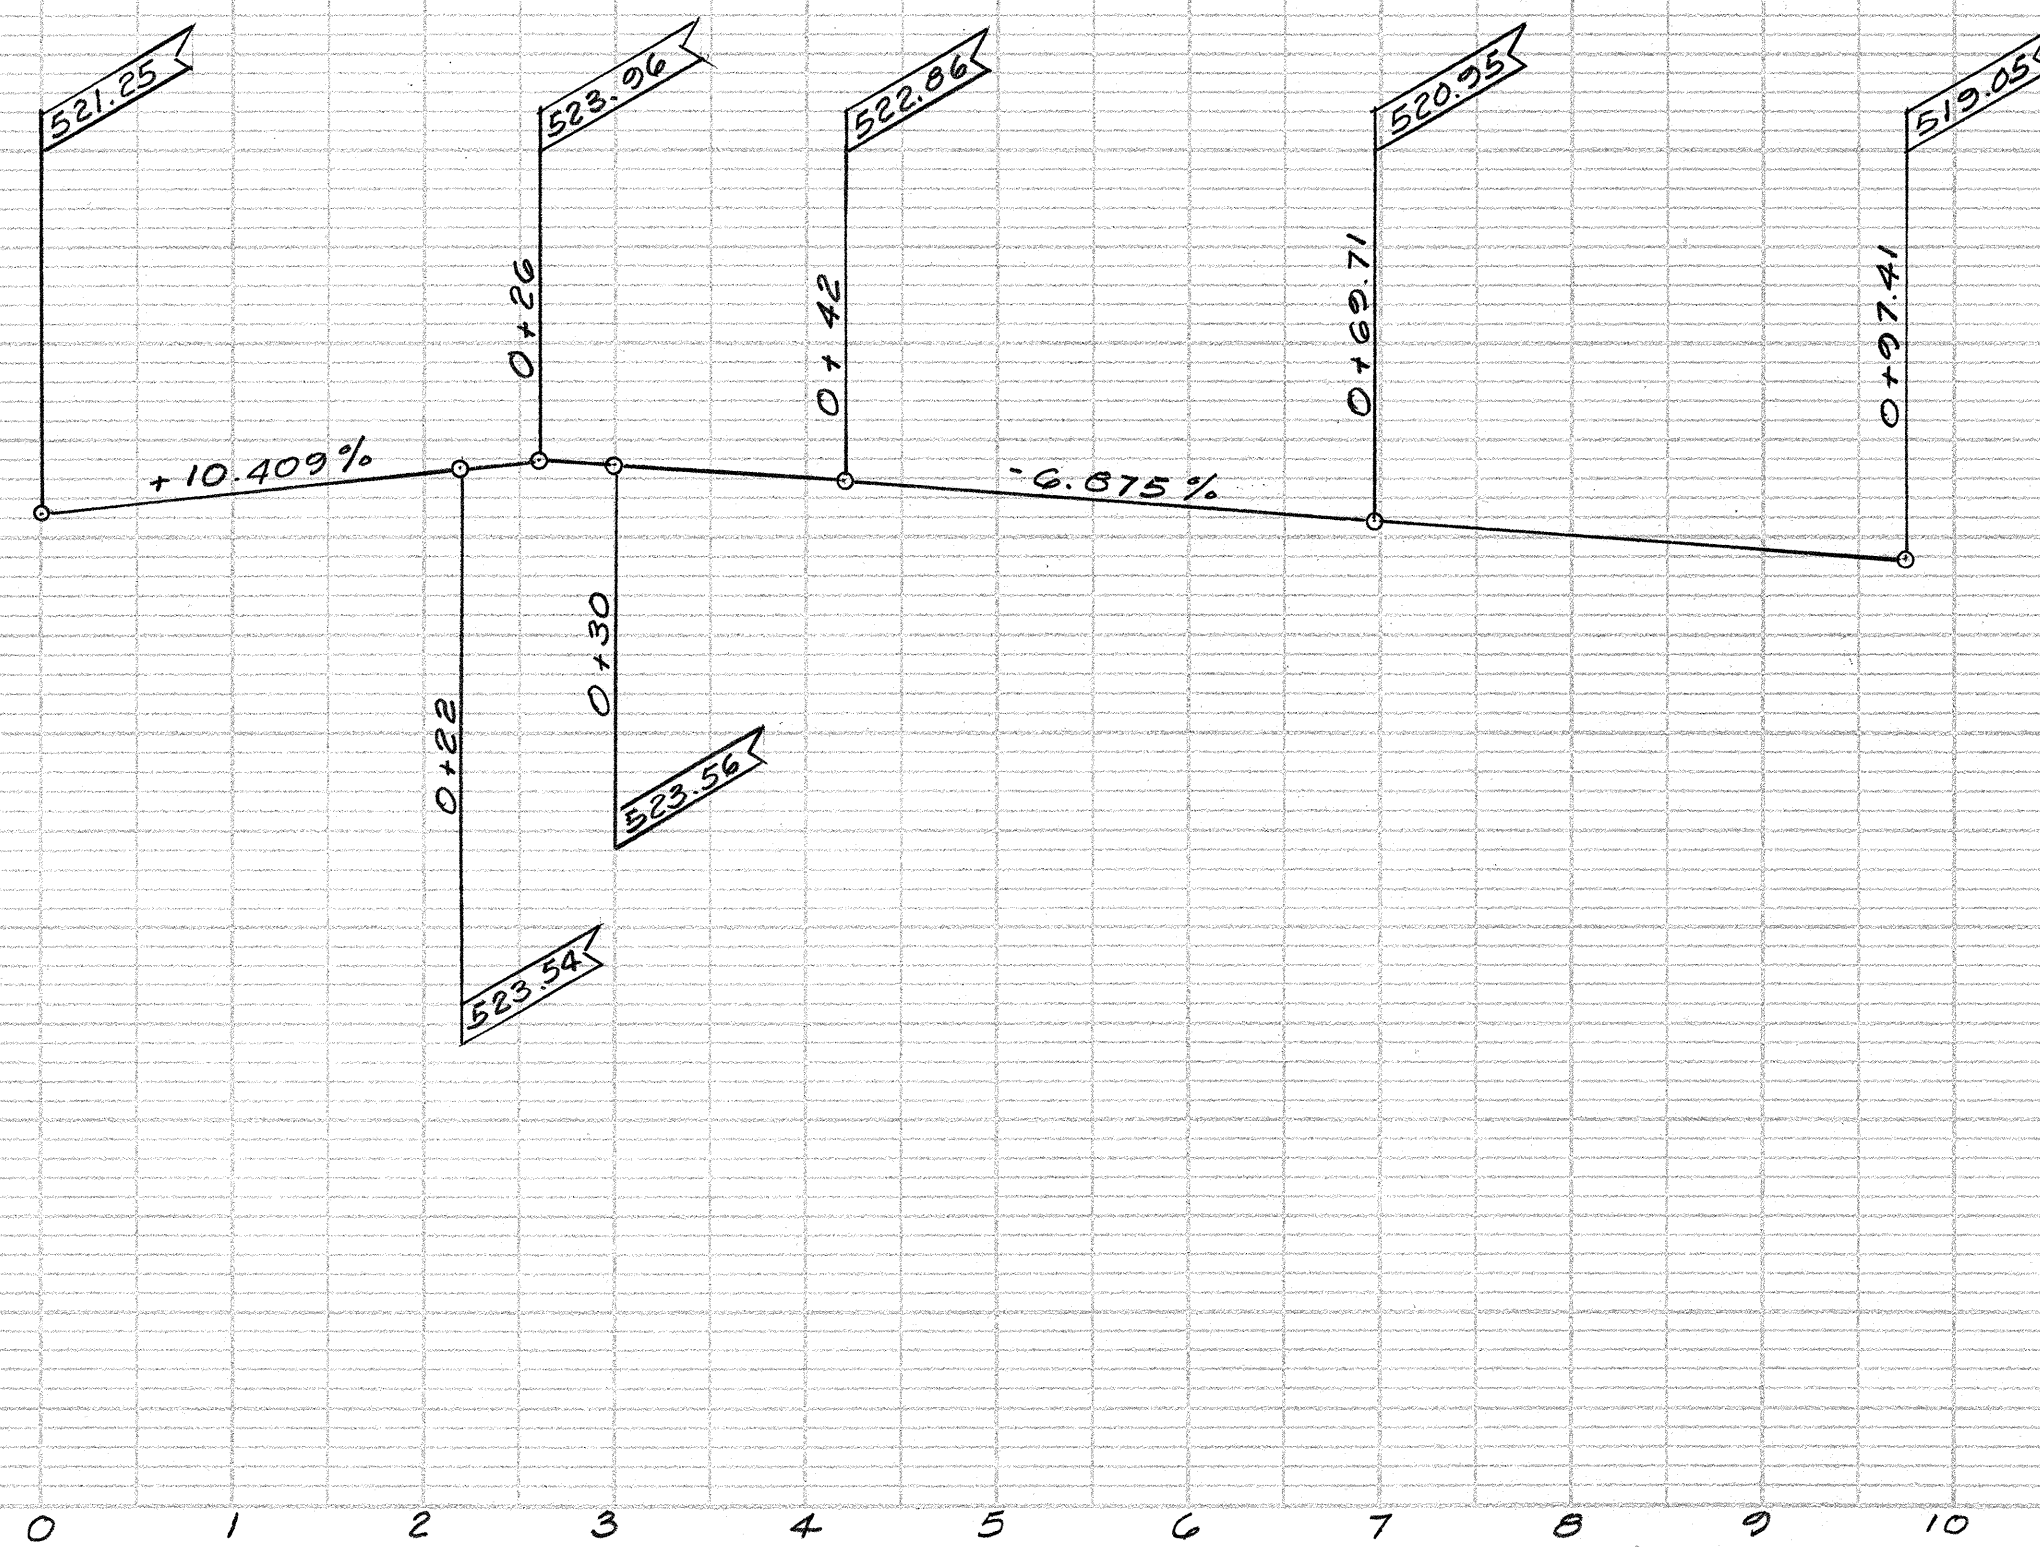

ACCESS ROAD AT STA. 43+44.63

