
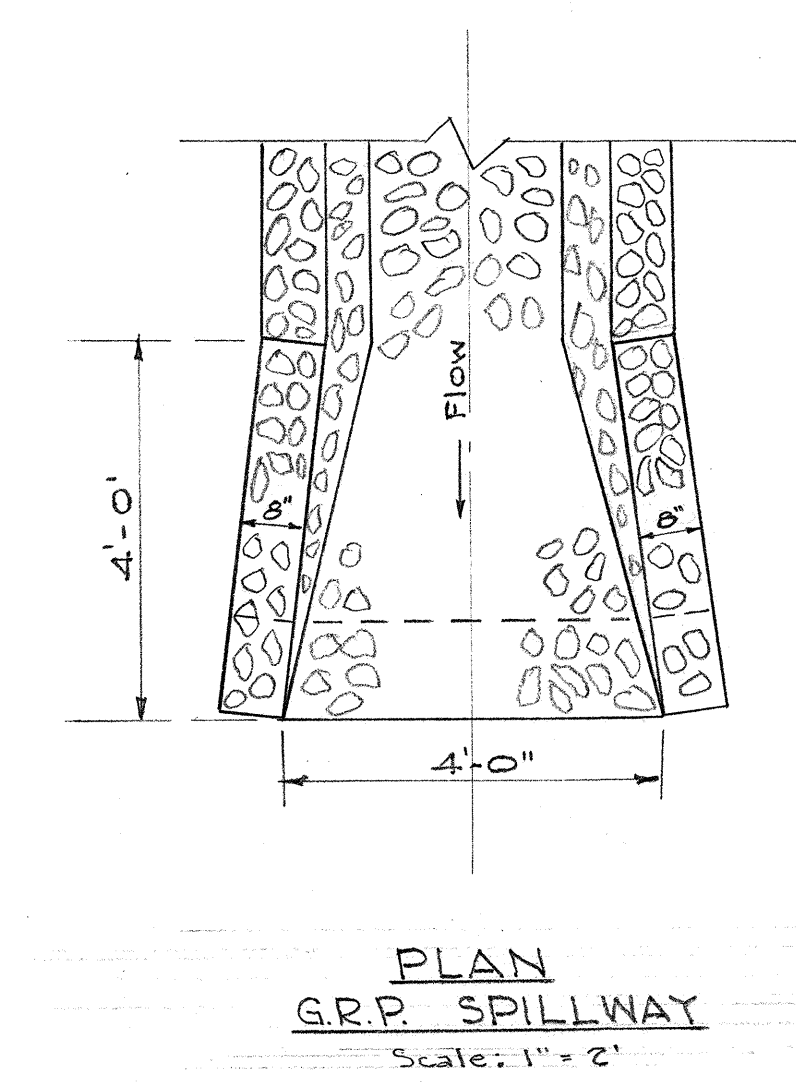
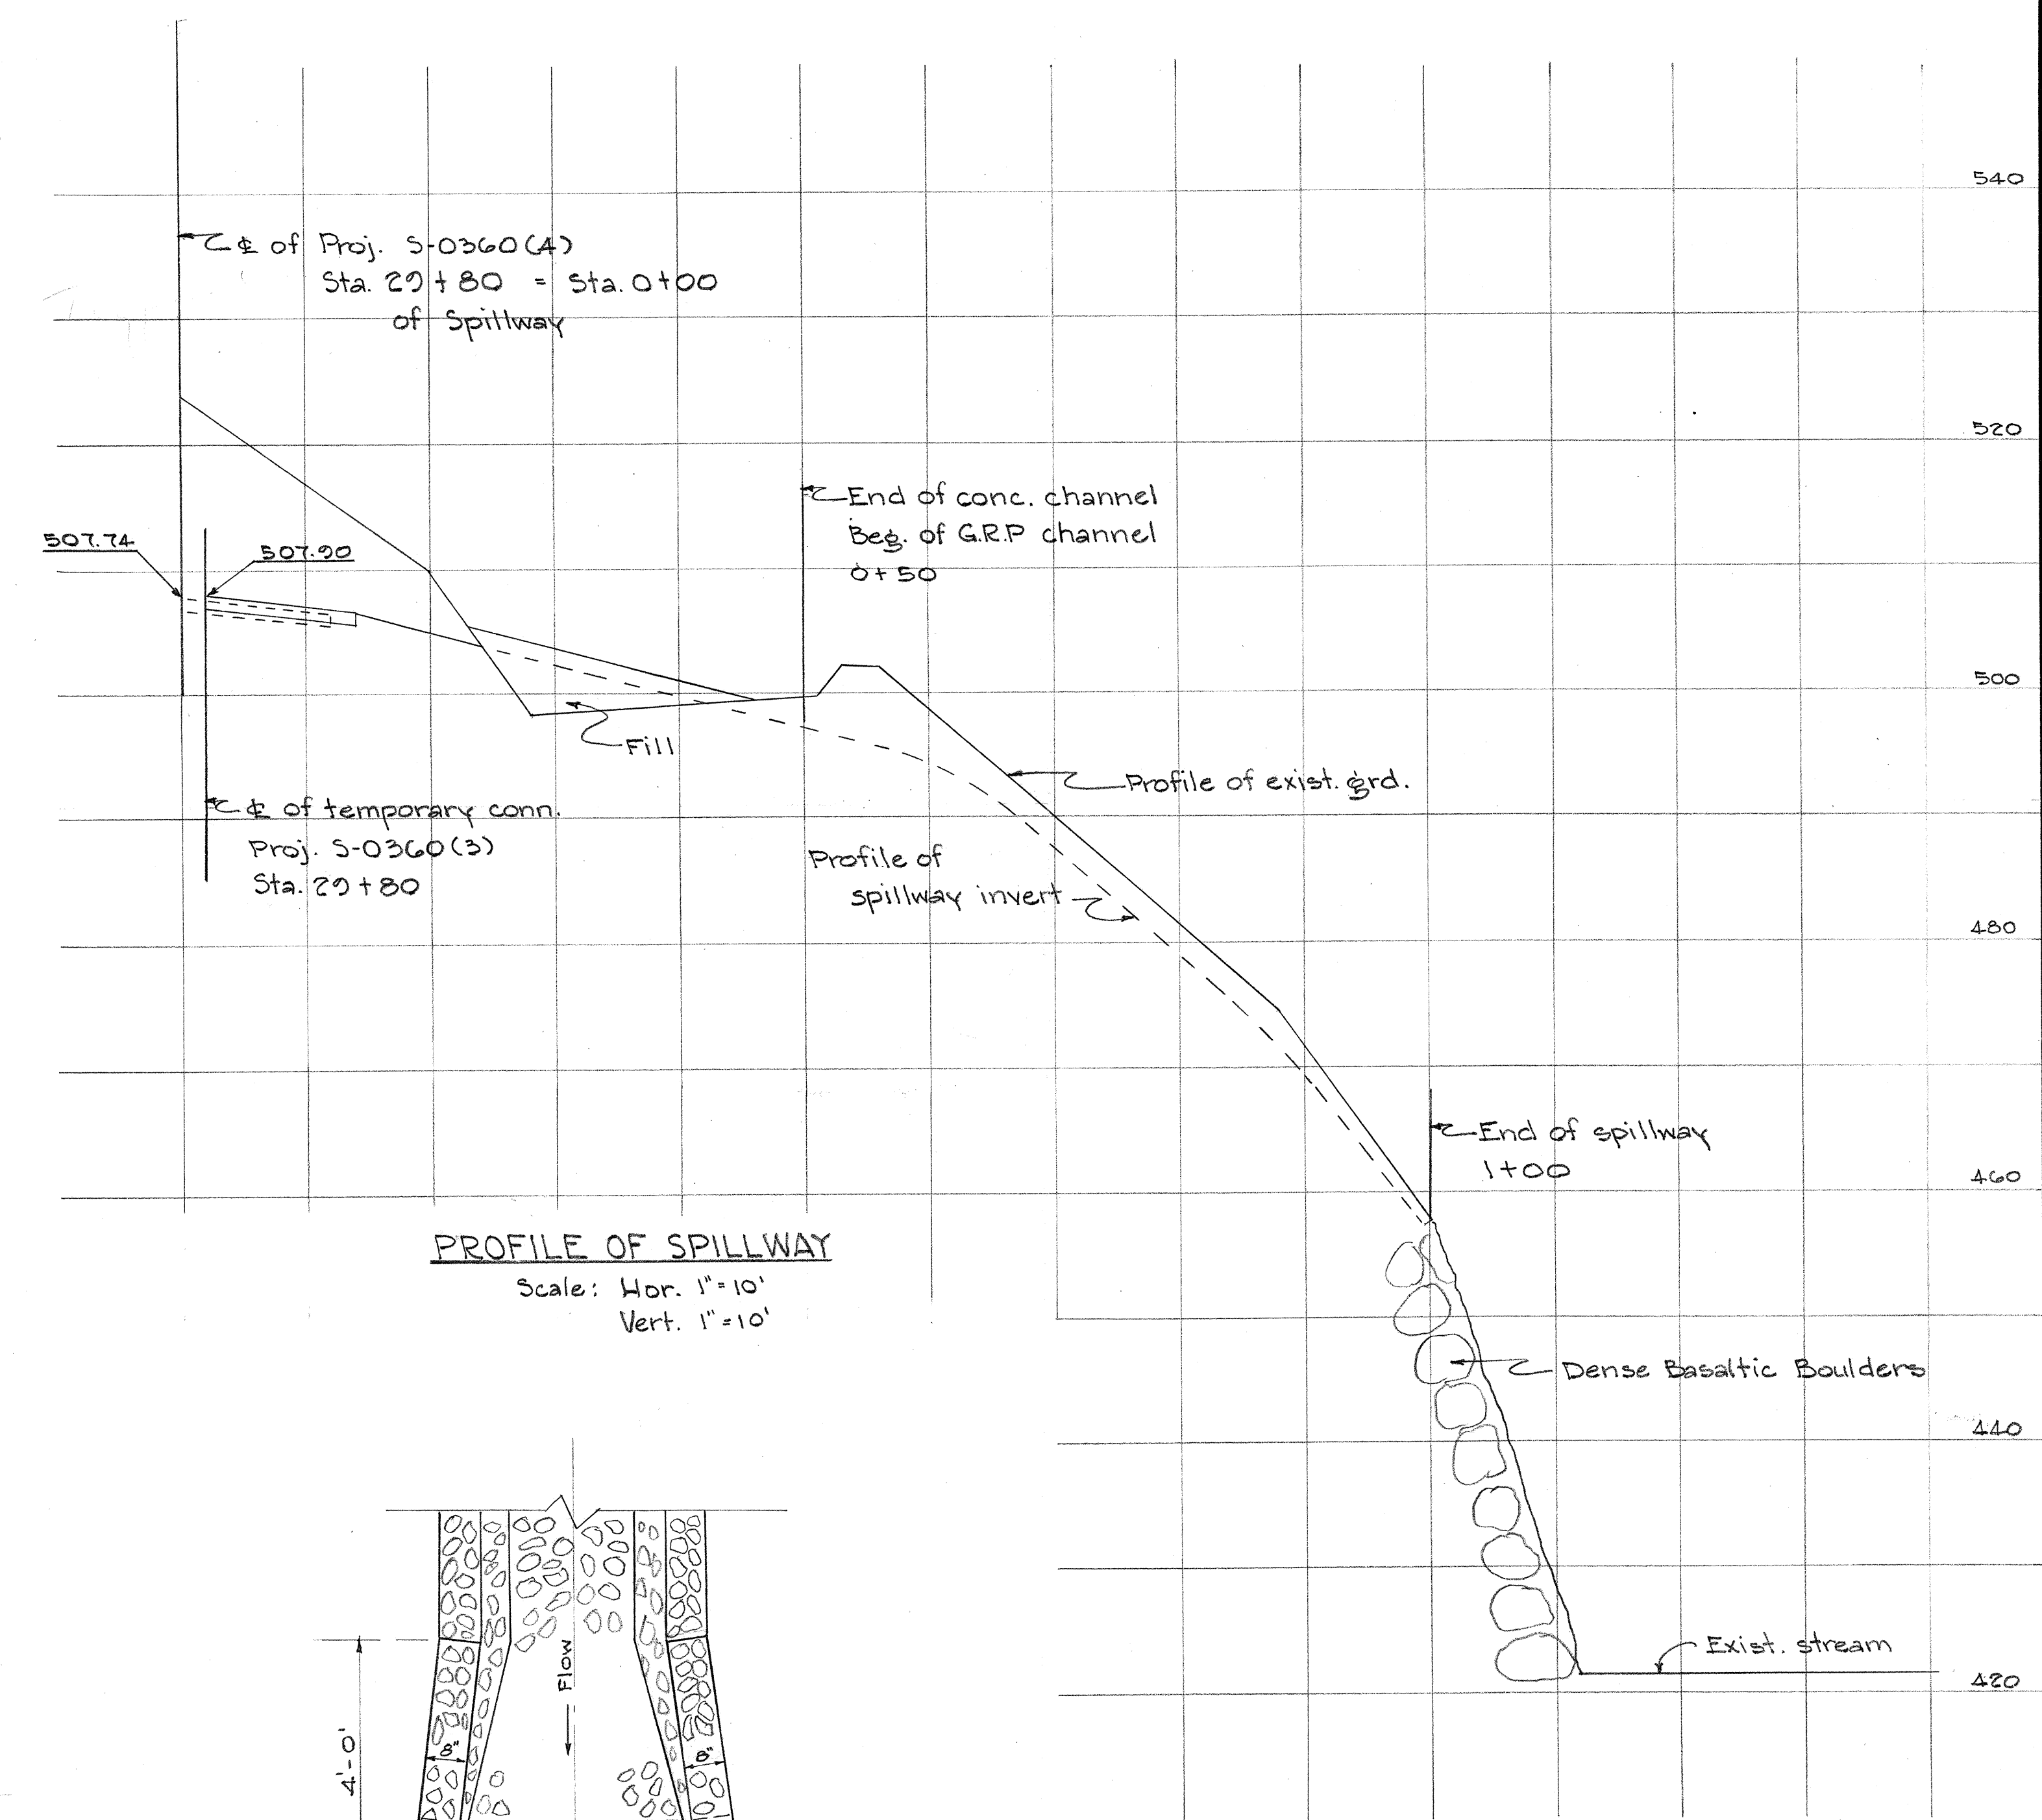
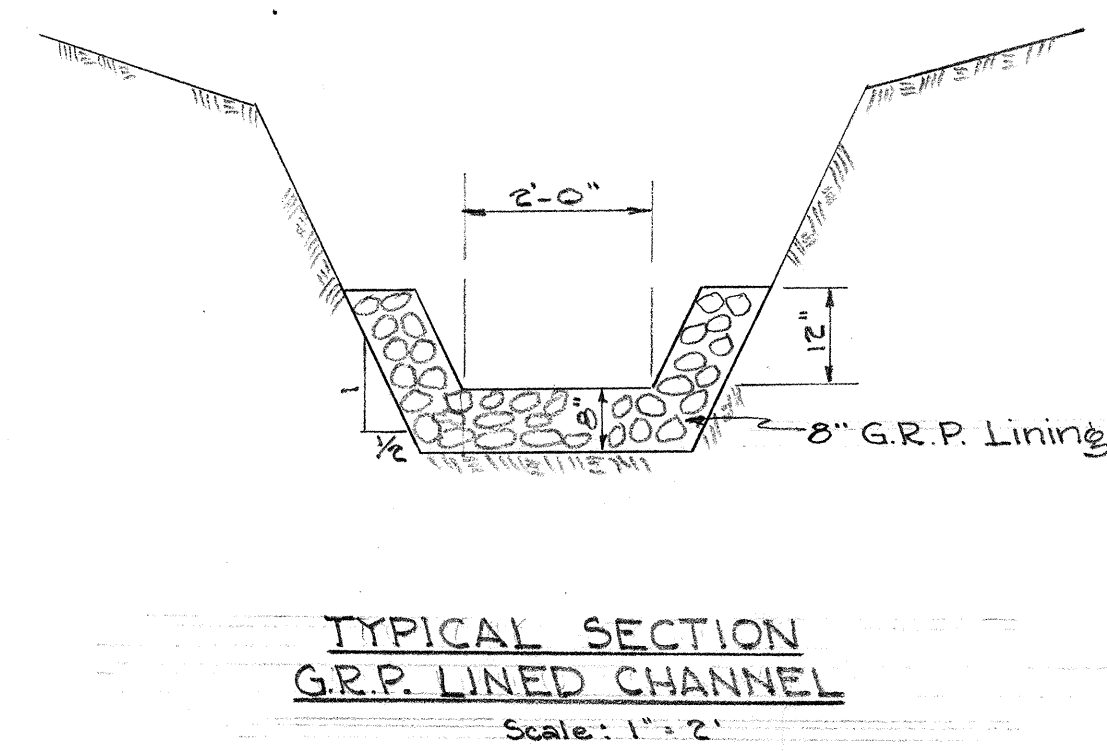
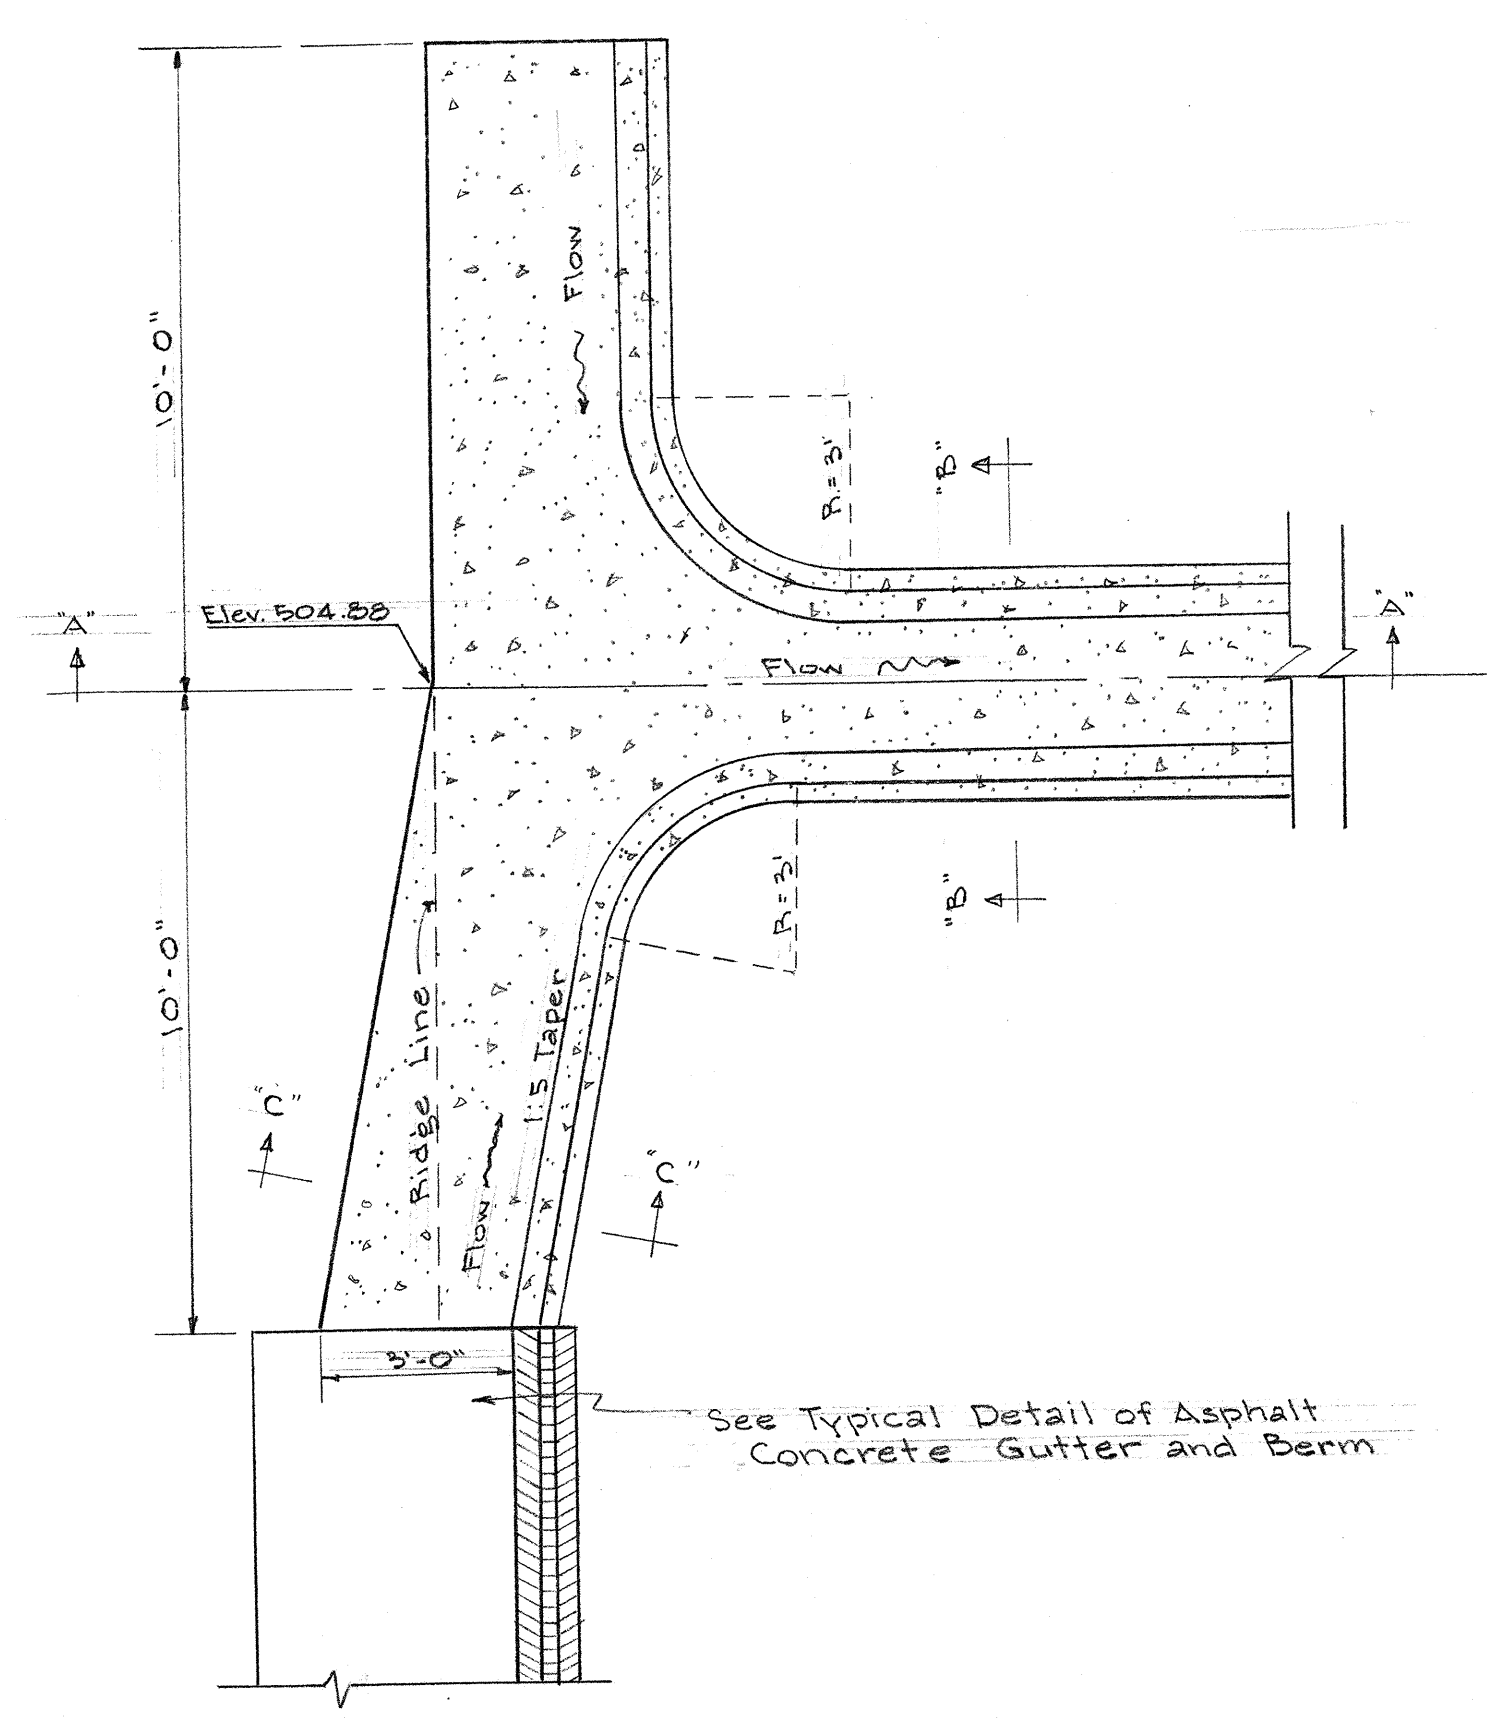
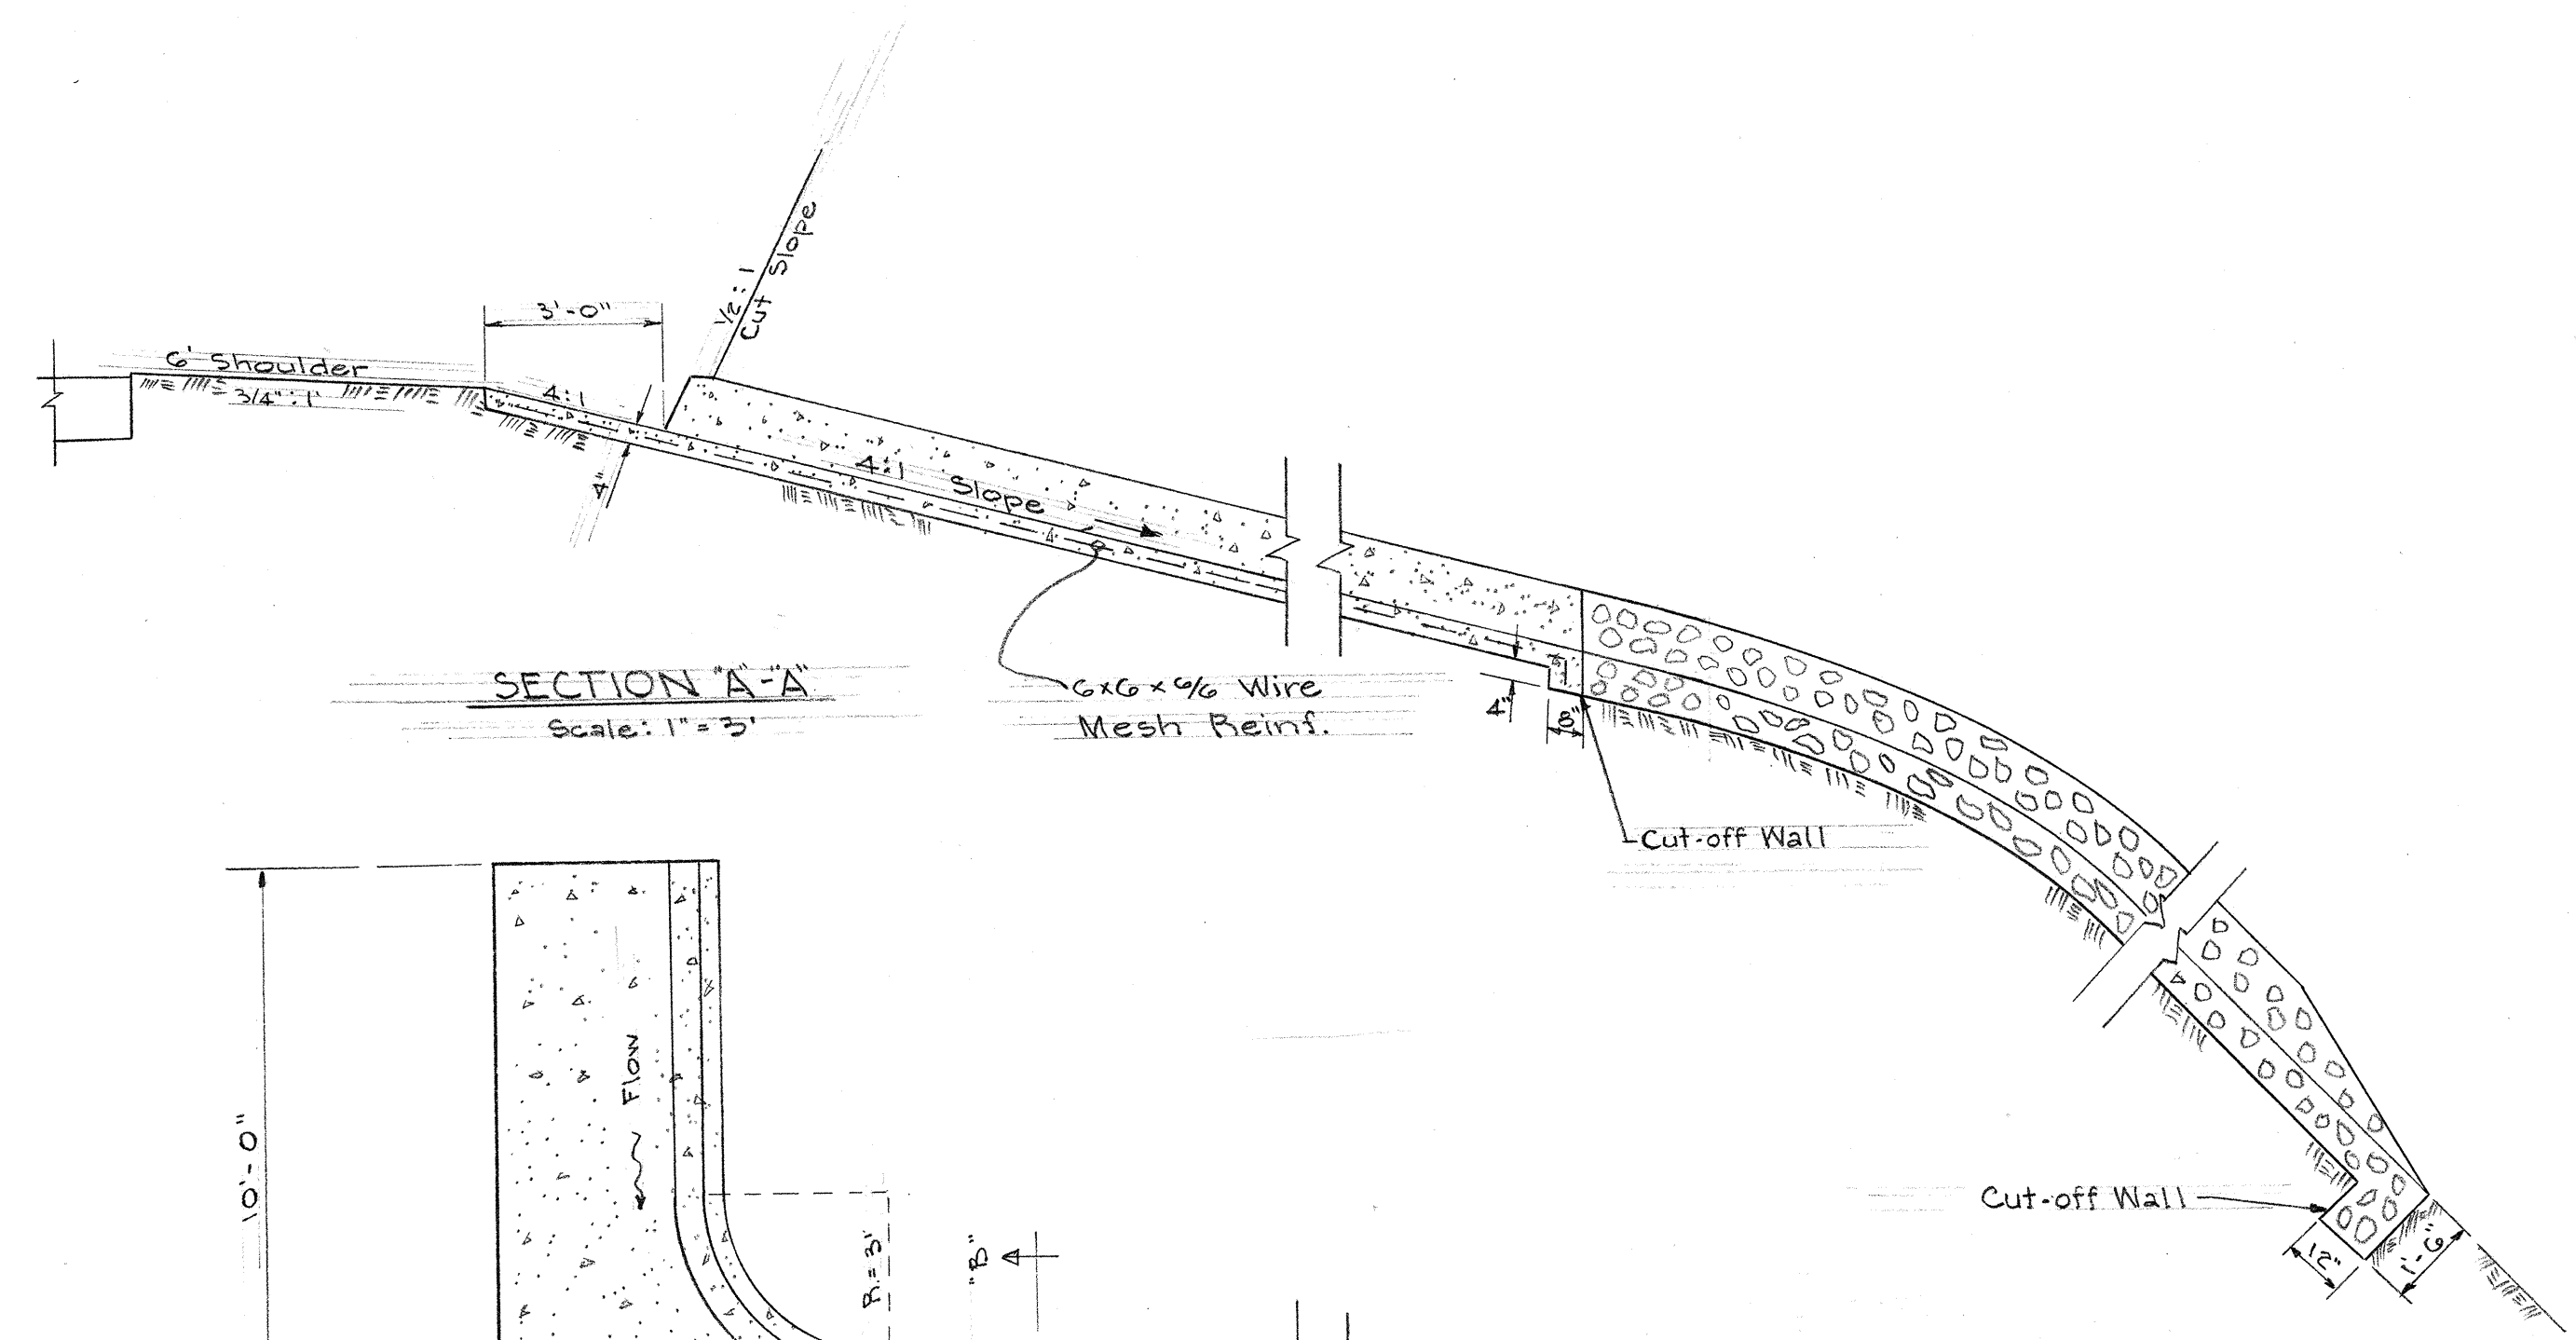


FED. ROAD DIST. NO.	STATE	FED. AID PROJ. NO.	FISCAL YEAR	SHEET NO.	TOTAL SHEETS
HAWAII	HAW.	5-0360(3)	1963	38	38

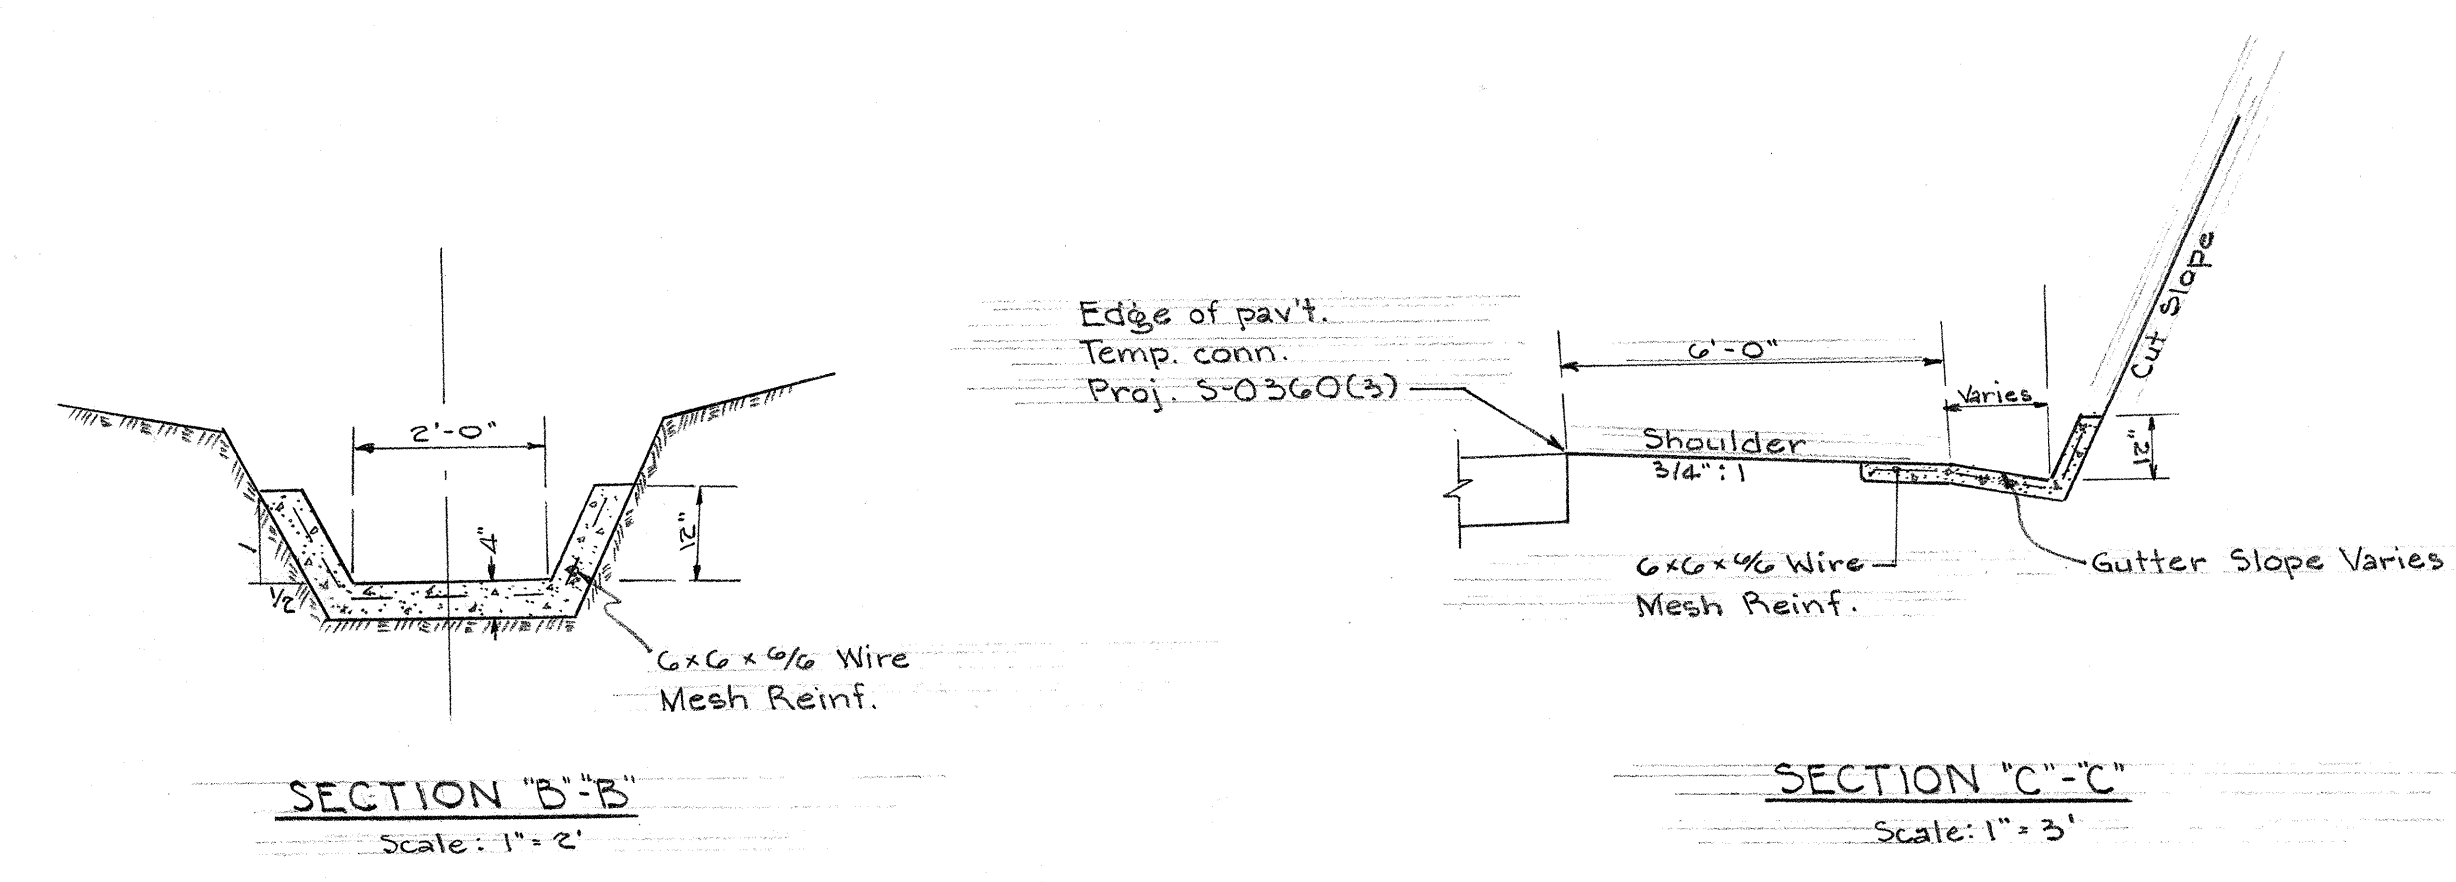

DELETED BY CHANGE ORDER NO. 7

STATE OF HAWAII
DEPARTMENT OF TRANSPORTATION
HIGHWAYS DIVISION
DETAIL OF SPILLWAY AT
STATION 29+80
HANA BELT ROAD
Kakipi Gulch Section
FAS PROJ. NO. S-0360(3)