

INDEX TO DRAWINGS	
SHEET NO	DESCRIPTION
1	TITLE SHEET
2	TYPICAL SECTION
3 - 5-11	PLAN & PROFILE
6 - 7	MISCELLANEOUS DETAILS
8 - 17	STANDARD DETAILS
18 - 33	CROSS SECTIONS
34 - 37	BOX CULVERT DETAILS
38	SPILLWAY DETAIL

32A, 33A, 33B
37A, 37B, 37C, 37D

CONVENTIONAL SIGNS


Centerline	125
Boundary Lines	01
Fences (Named)	x-x-x-x
Existing Roadways	---
Circular Culvert	---
Box Culvert	---
Bridge	---
Telephone Pole	○
Electric Power Pole	○
Water Main	W ₁ W ₂ (W ₁ , B, 15, Etc)
Storm Drain	SD ₁ SD ₂ (SD ₁ , 24, Etc)
Concrete Drop Intake	C.D.I.
Standard Catch Basin	S.C.B.
Standard Manhole	○ M.H.S.
Sewer Manhole	○ S.M.H.
Telephone Manhole	● T.M.H.
Fire Hydrant	○ F.H.
Trees (Named)	Mango, BB, Coco*
Railroad	+

STATE OF HAWAII DEPARTMENT OF TRANSPORTATION HIGHWAYS DIVISION HONOLULU, HAWAII

AS BUILT PLANS OF HANA BELT ROAD KAKIPI GULCH F. A. S. PROJECT NO S-0360(3) DISTRICT OF MAKAWAO ISLAND OF MAUI


SCALE

PLAN	1 IN. = 50 FT.
PROFILE	HOR. 1 IN. = 50 FT. VER. 1 IN. = 10 FT.
X-SECTIONS	HOR. 1 IN. = 10 FT. VER. 1 IN. = 10 FT.

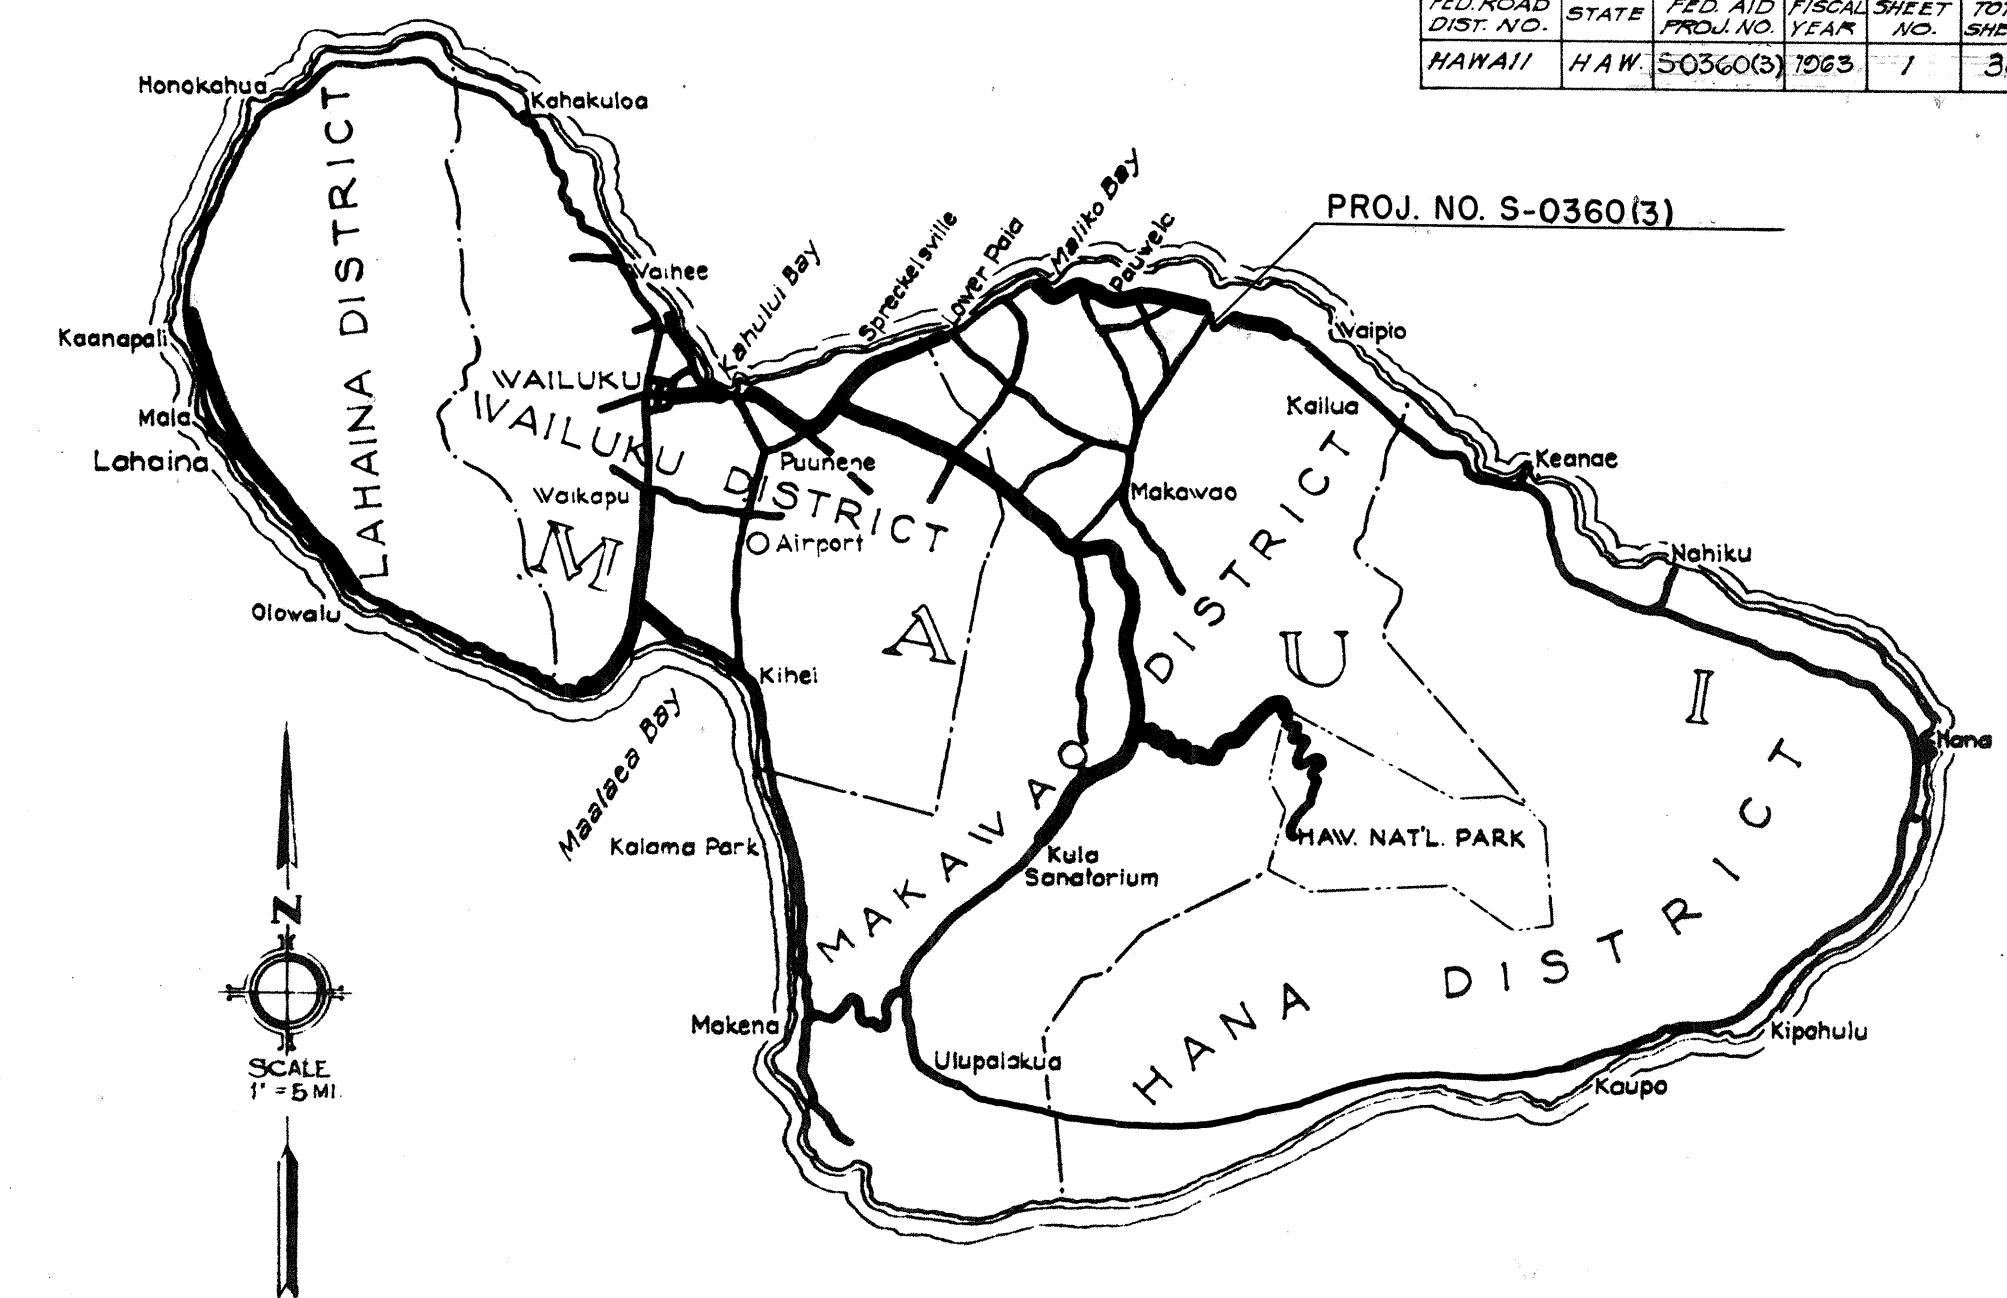

LOCATION MAP

Federal Aid Projects previously constructed or under construction.

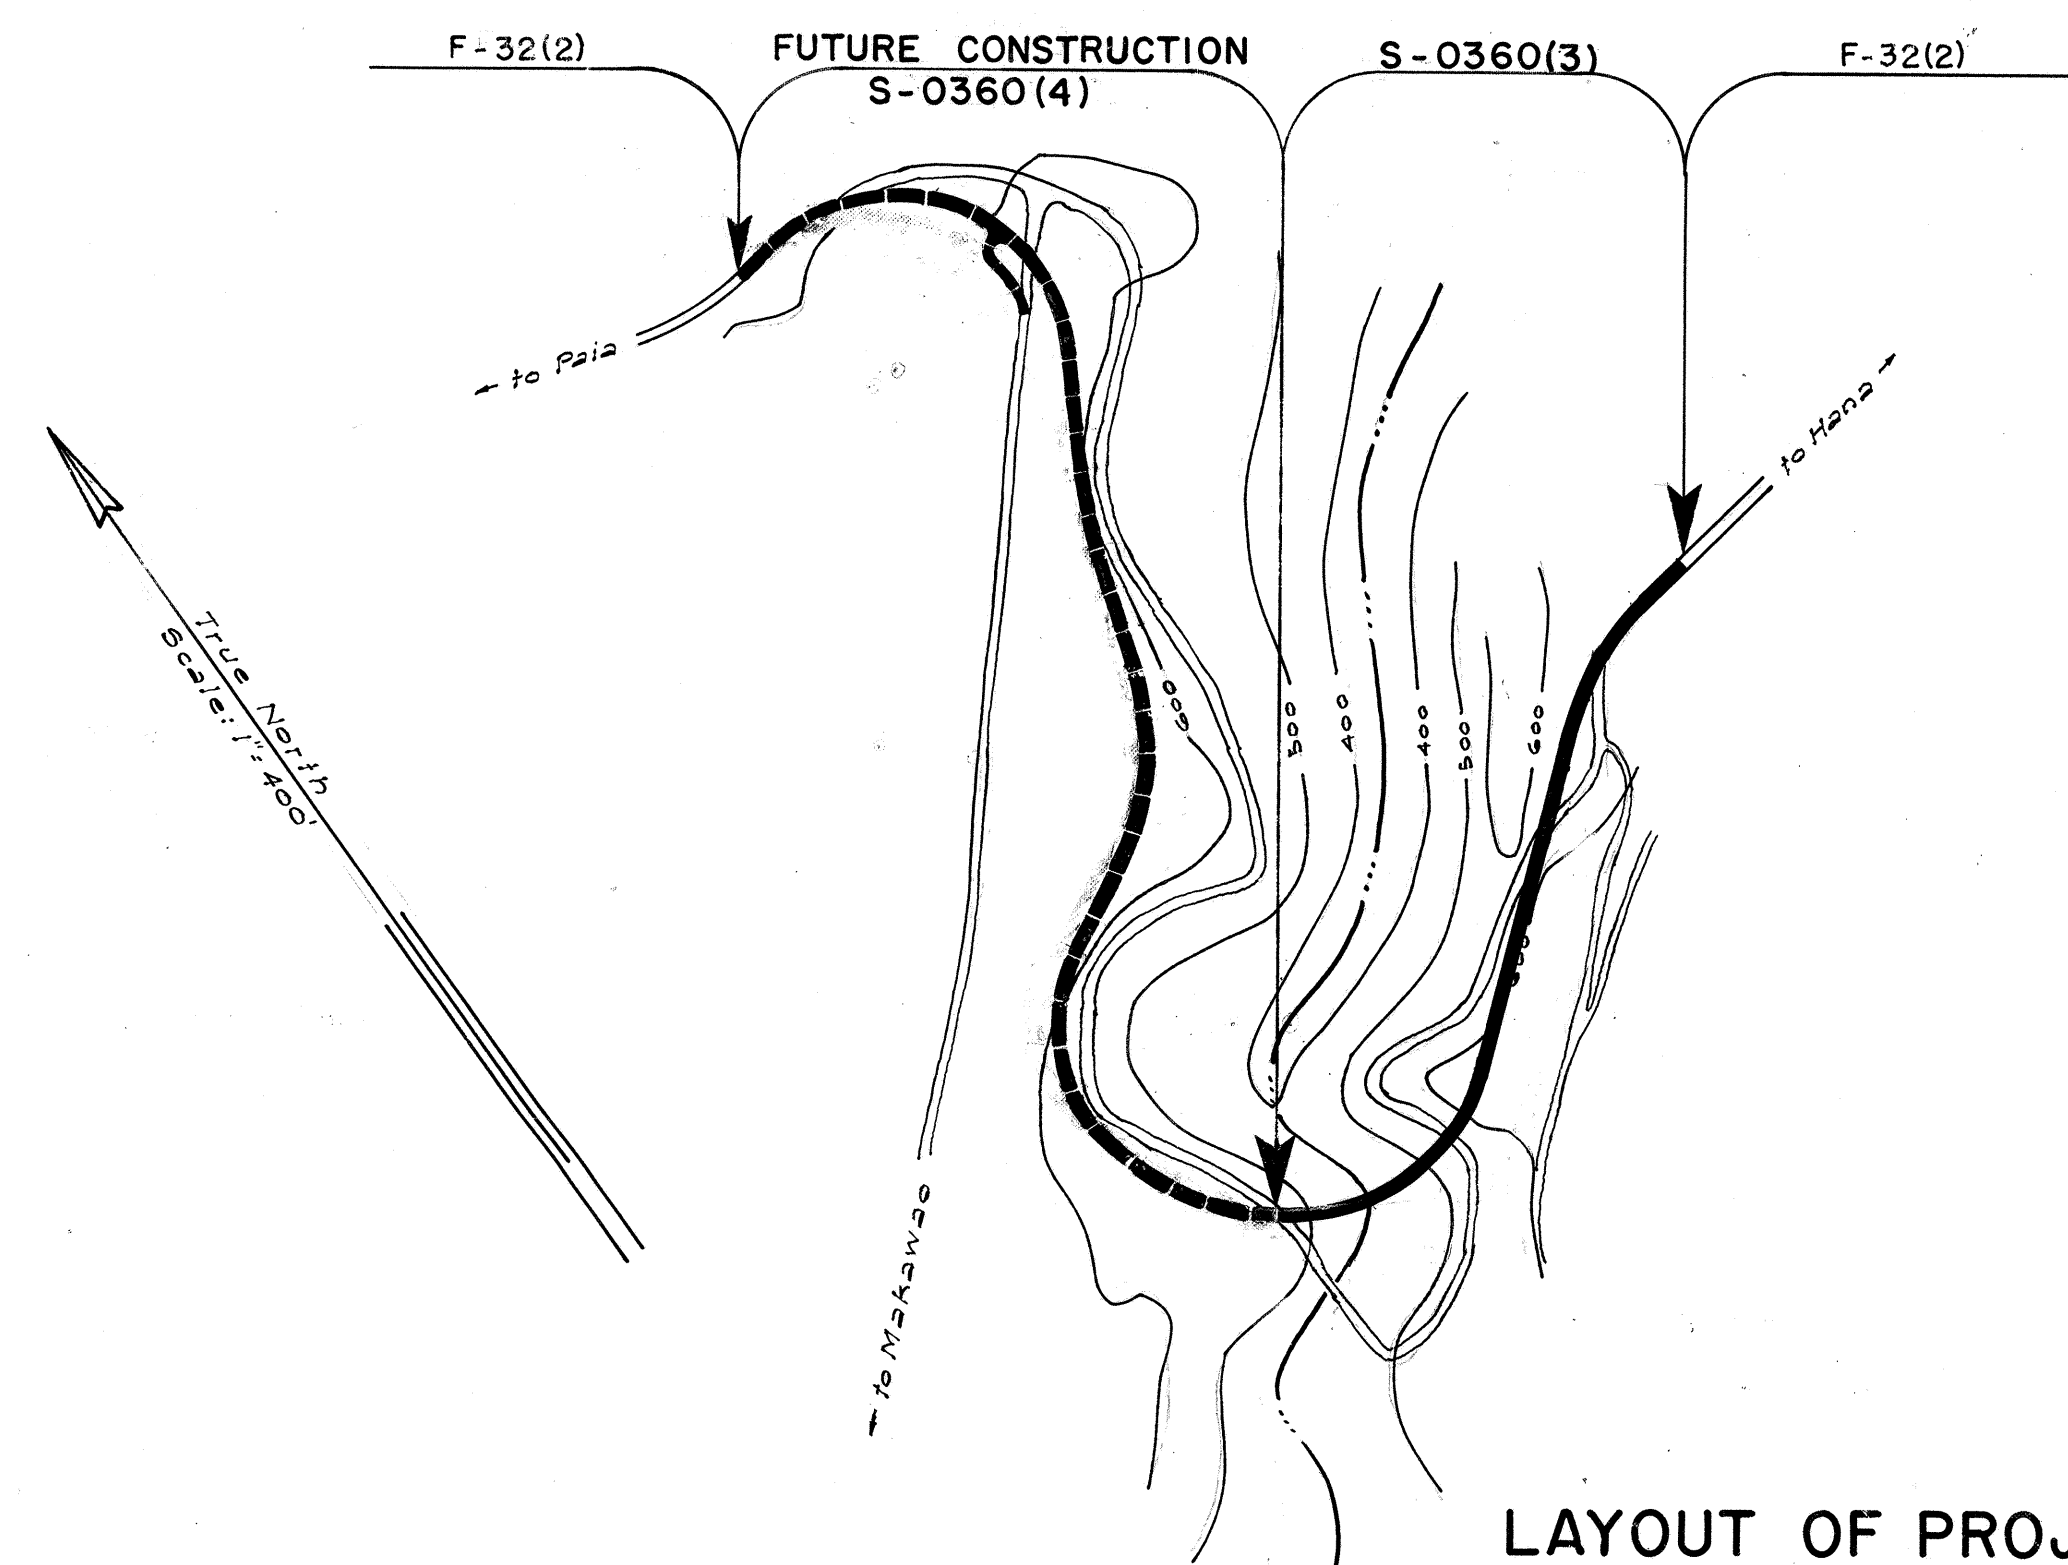

LAYOUT OF PROJECT

SCALE: 1" = 400'

DESIGN CLASSIFICATION

ADT (1961)	200
DESIGN ADT	600
DHV	14%
D	60/40
T	7%
V	40 M.P.H

NOTE:

ALL CHANGES MADE DURING CONSTRUCTION
HAVE BEEN NOTED IN RED ON THESE TRACINGS
AND CHECKED BY:

Harold A. Kuenen
RESIDENT ENGINEER

3/8/66

DATE

APPROVED: DATE 4/8/63
Felix Matunda
DIRECTOR OF TRANSPORTATION

DEPARTMENT OF COMMERCE
BUREAU OF PUBLIC ROADS
APPROVED:
DIVISION ENGINEER DATE

GROSS LENGTH OF PROJECT	0.345 MILE
BRIDGES OVER 20' SPAN	0.005
NET LENGTH OF ROADWAY	0.340 MILE