| INDEX TO DRAWINGS | | |
|-------------------|--|--|
| SHEET NO | DESCRIPTION | |
| | TITLE SHEET | |
| 2 | TYPICAL SECTIONS | |
| 3-6 | PLAN & PROFILE | |
| 7-9 | SPECIAL ROADWAY DETAILS | |
| l:0 | WARNING, REGULATORY & CONSTRUCTION SIGNS | |
| 11-14 | STANDARD DETAILS | |
| 15-27 | CROSS SECTIONS | |

STATE OF HAWAII

DEPARTMENT OF TRANSPORTATION

HIGHWAYS DIVISION

HONOLULU, HAWAII

"AS BUILT"
PLANS OF

HANA BELT ROAD KAKIPI GULCH SECTION

F. A. S. PROJECT No S-0360(4)

DISTRICT OF MAKAWAO
ISLAND OF MAUI

SCALE


PLAN

I IN. = 50 FT.

PROFILE

HOR. | IN. = 50 FT. VER. | IN. = 10 FT.

X-SECTIONS HOR. | IN. = 10 FT. VER. | IN. = 10 FT.

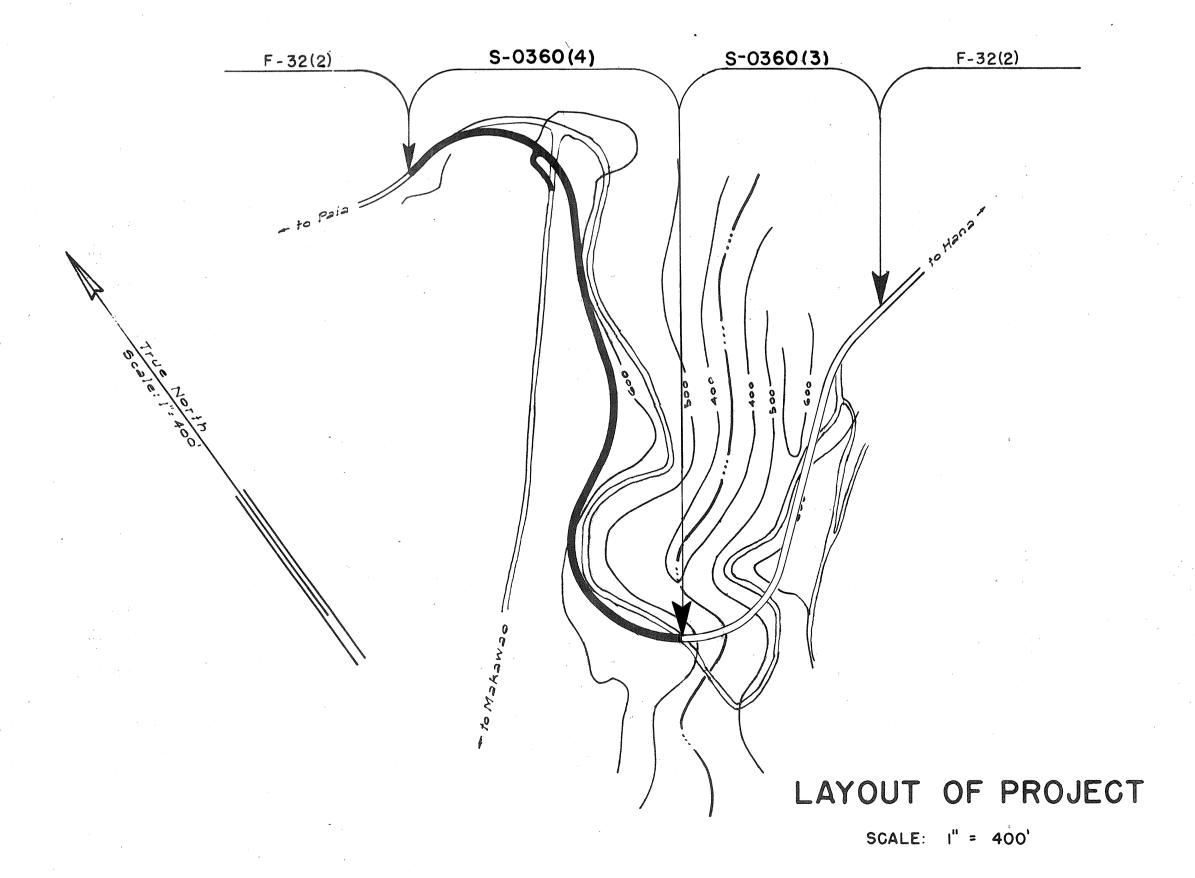

DESIGN CLASSIFICATION

NET LENGTH OF ROADWAY-----0.576 MI.


| ADT (1961) | 200 |
|------------|----------|
| DESIGN ADT | 600 |
| DHV | 14% |
| D | 60/4 |
| T | 7% |
| V | 40 M.P.I |

APPROVED: DATE 20 June 63

Lujio Matsucla

DIRECTOR OF TRANSPORTATION

GROSS LENGTH OF PROJECT----- O.576 MI.
BRIDGES OVER 20' SPAN----- O MI.

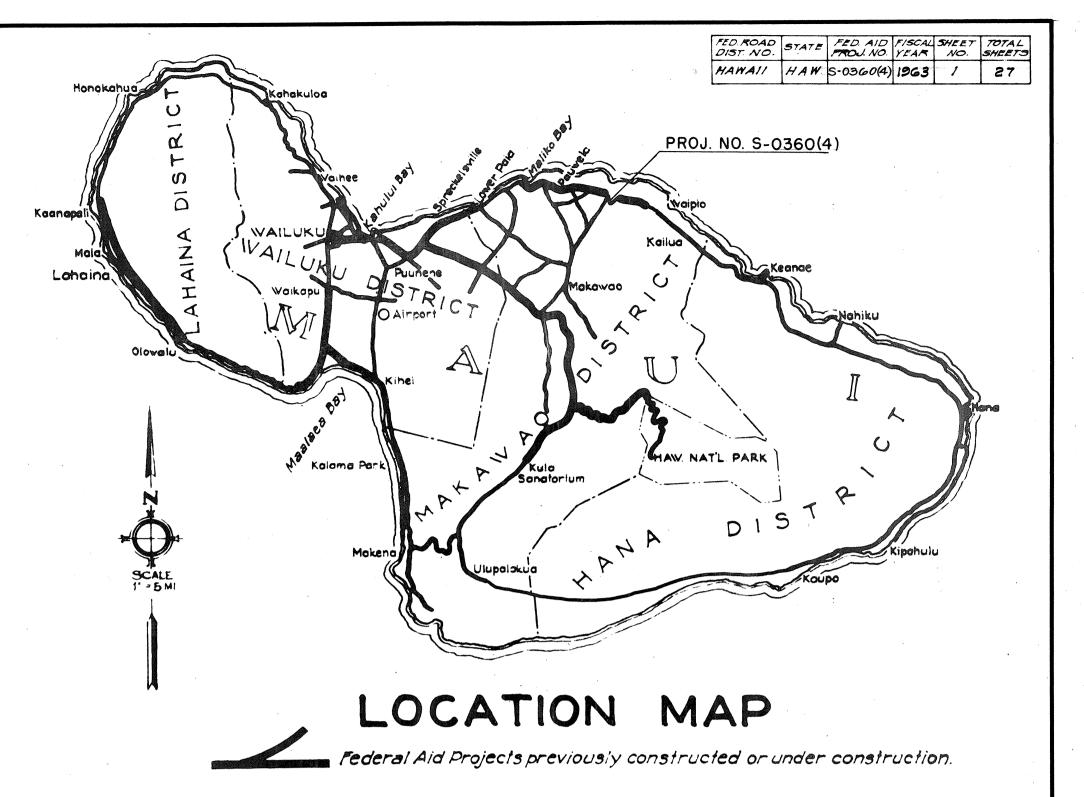

NOTE:

ALL CHANGES MADE DURING CONSTRUCTION HAVE BEEN NOTED IN RED ON THESE TRACINGS AND CHECKED BY:

PARTIE L'ALENANTE RESIDENT ENGINEER

DATE

DEPARTMENT OF COMMERCE BUREAU OF PUBLIC ROADS

APPROVED:

DIVISION ENGINEER

DATE