

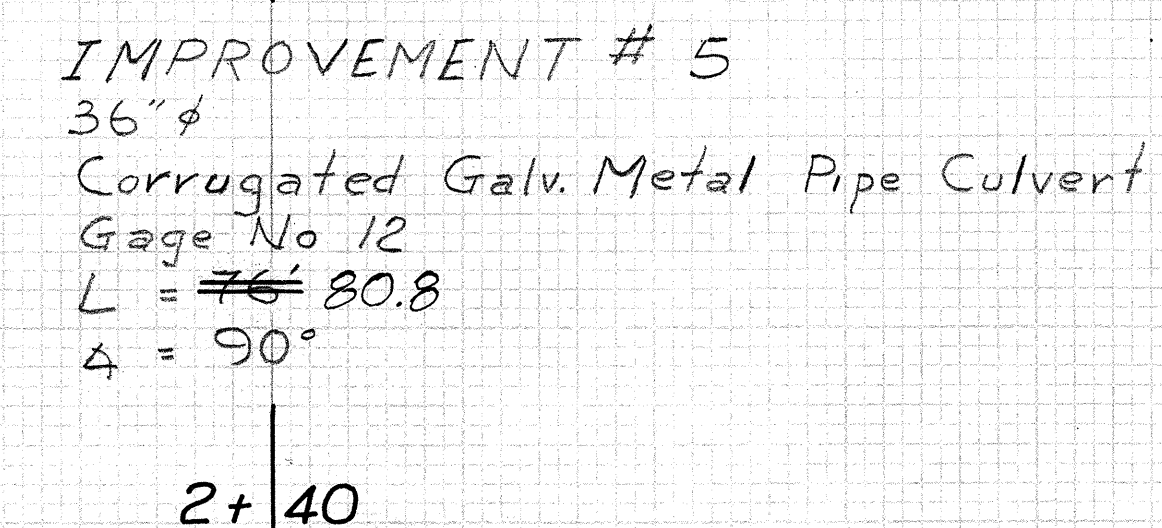
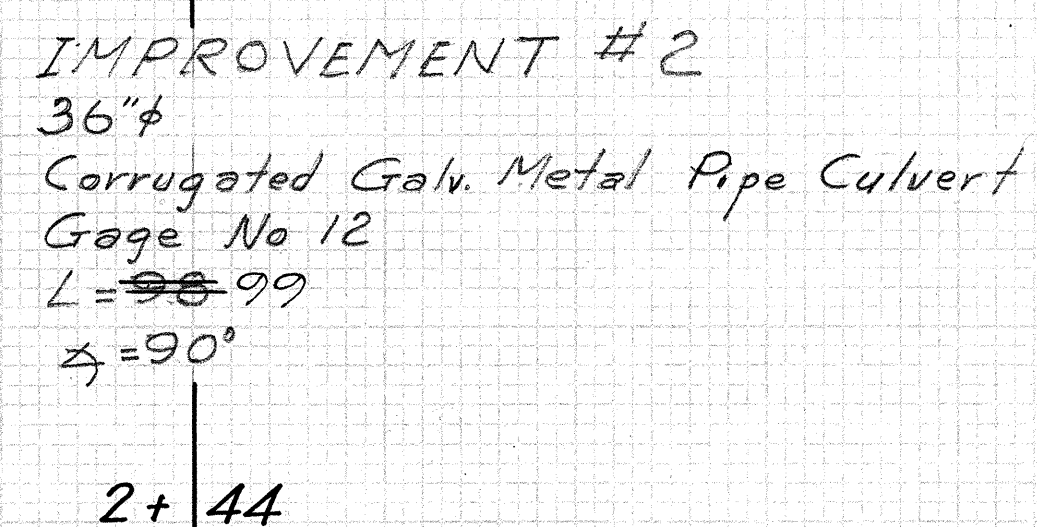
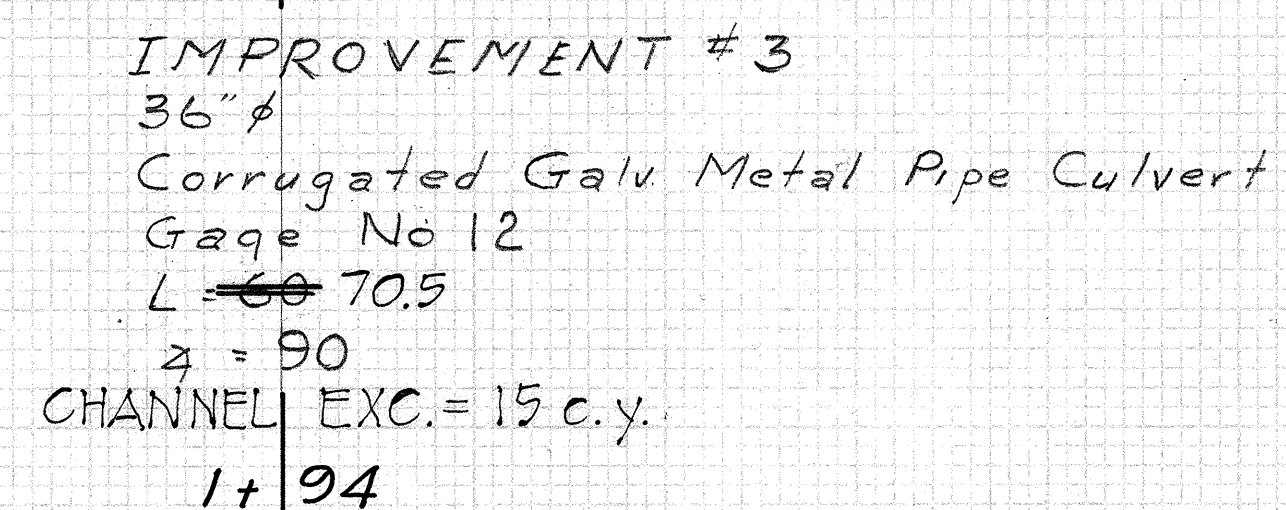
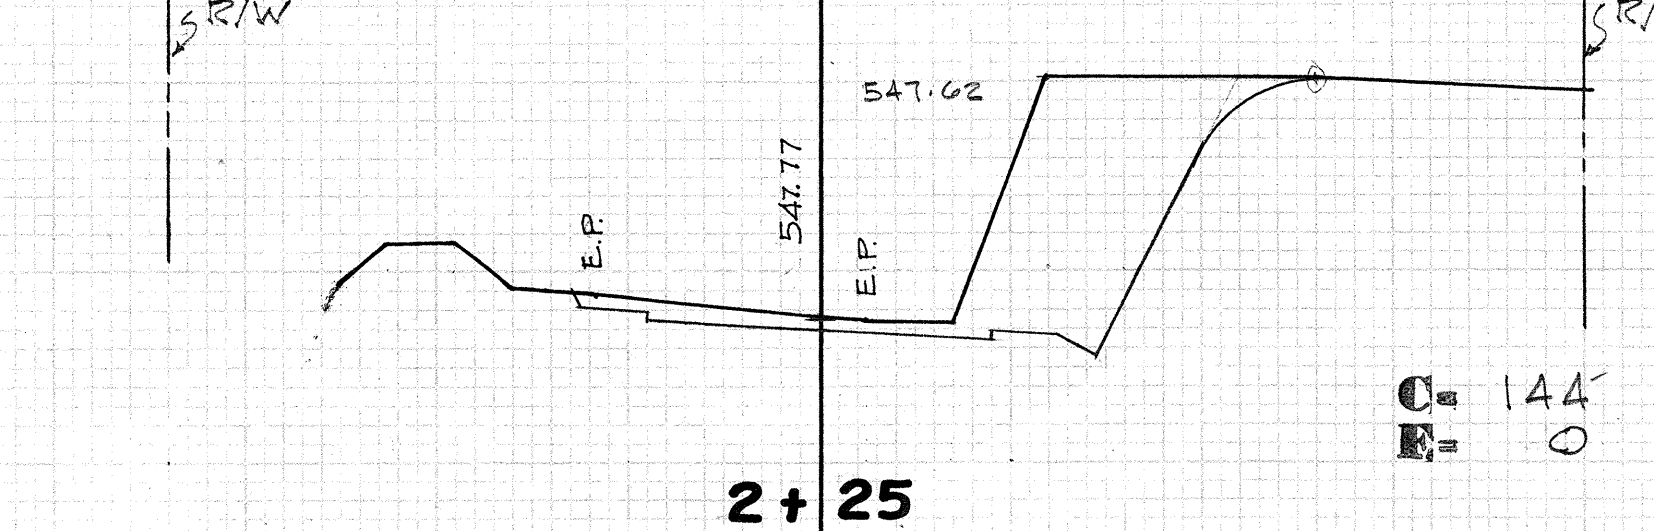
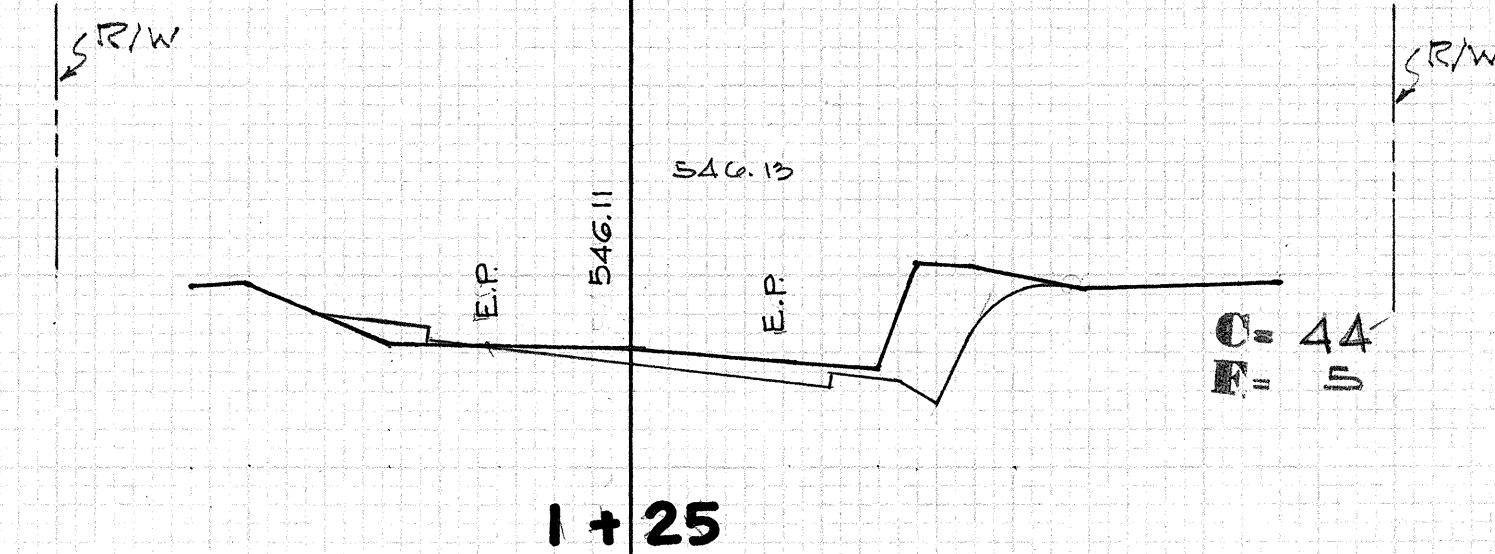
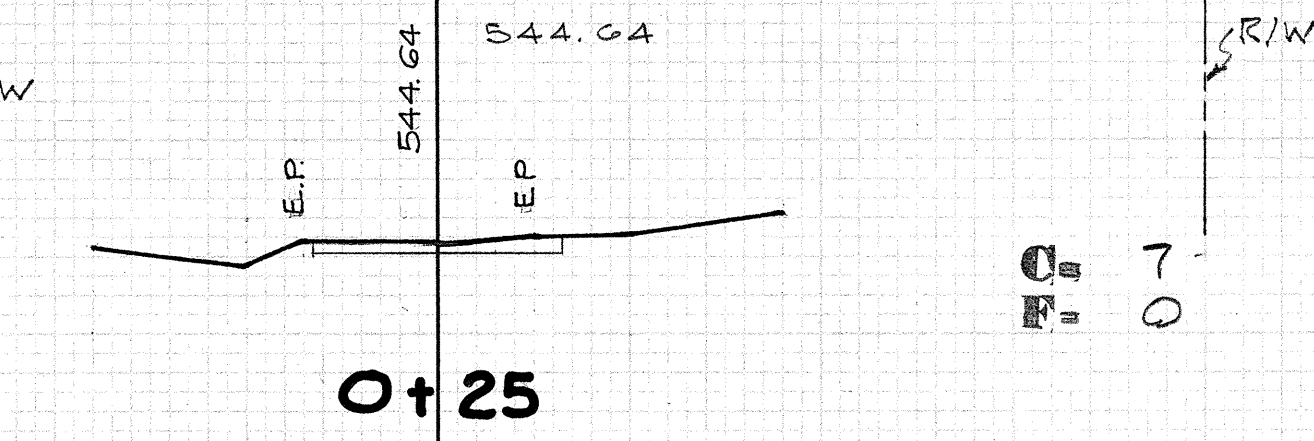
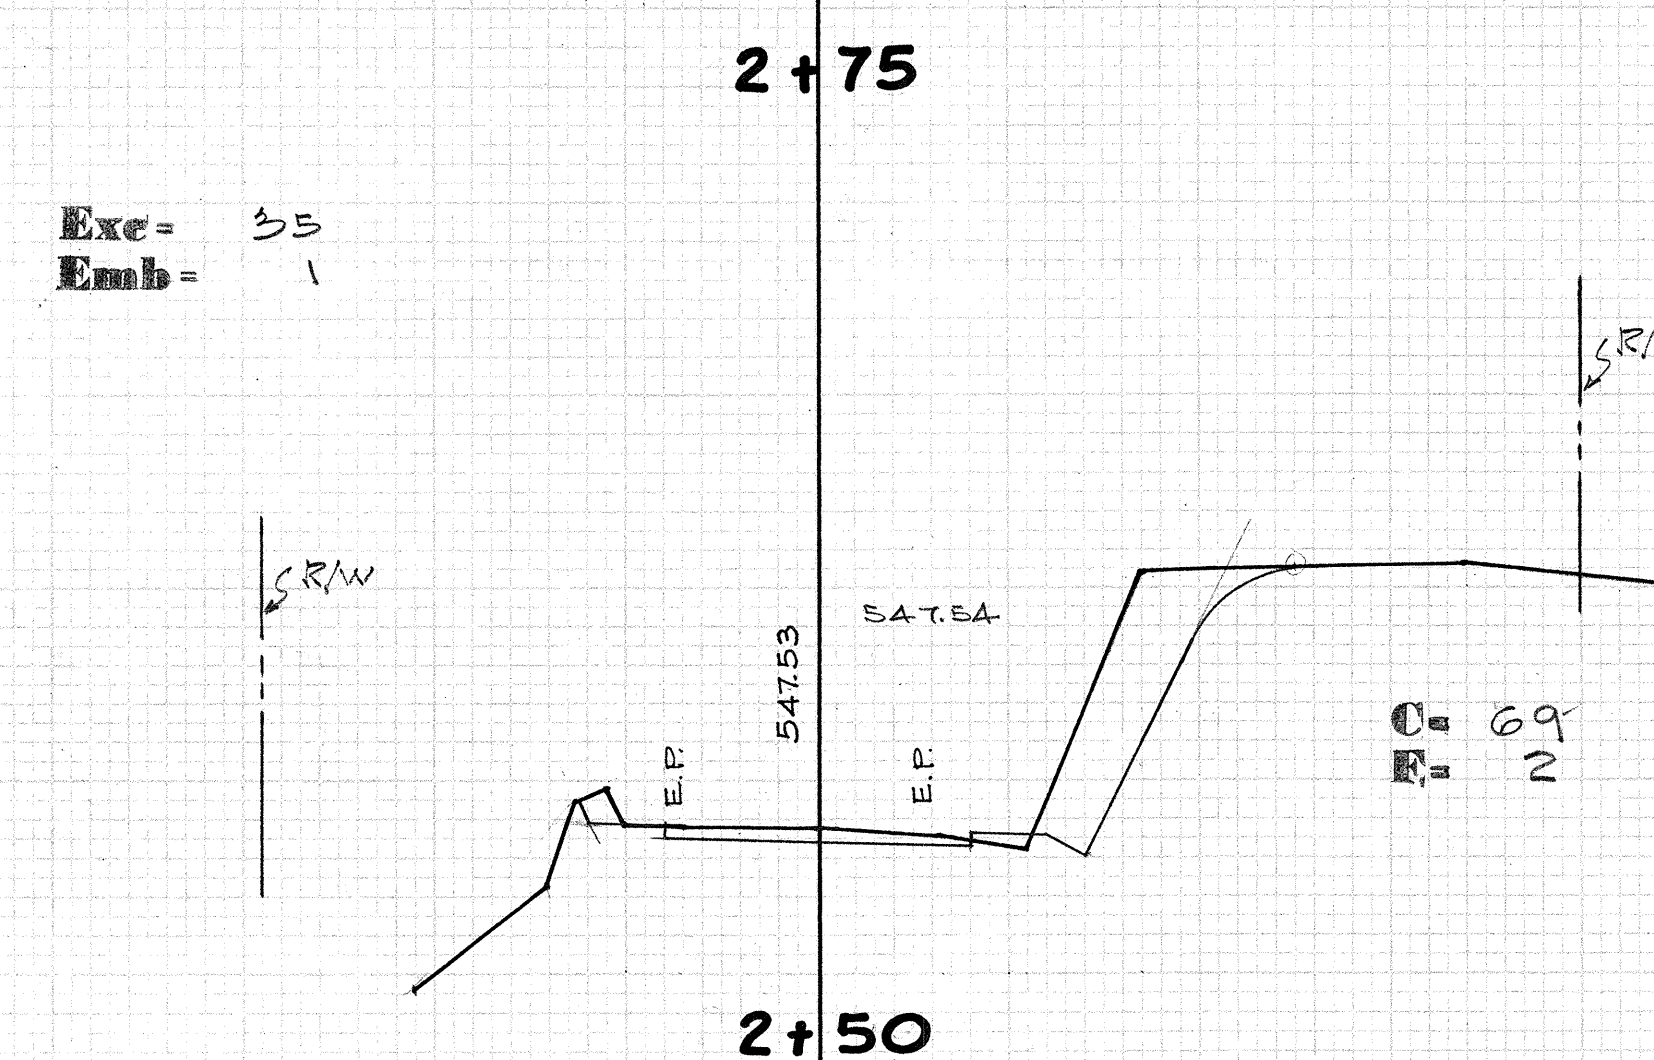
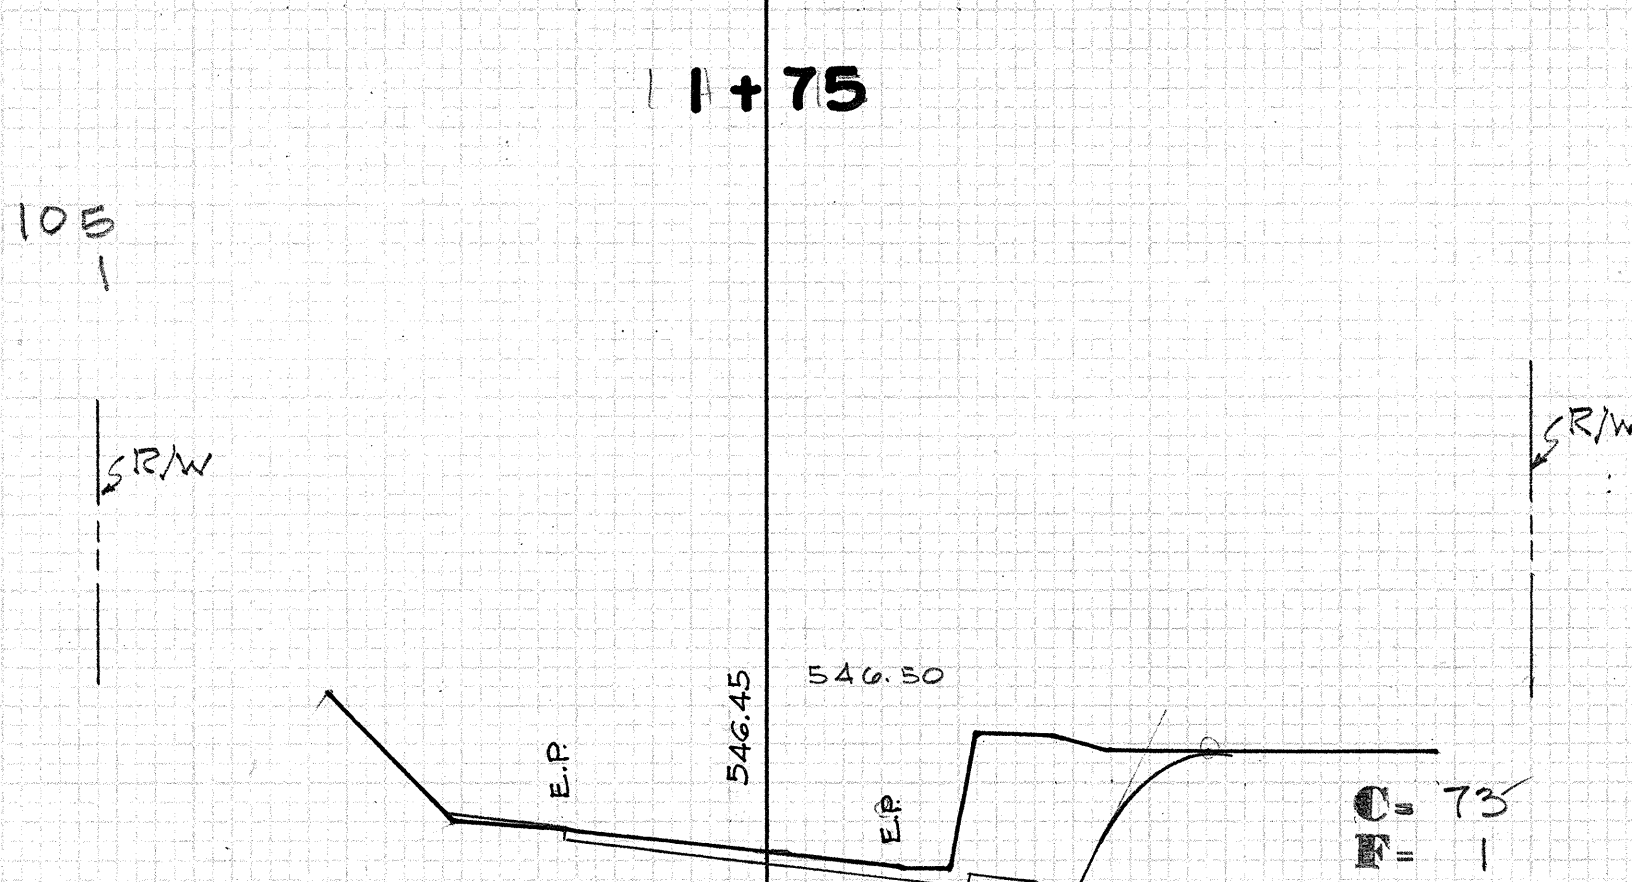
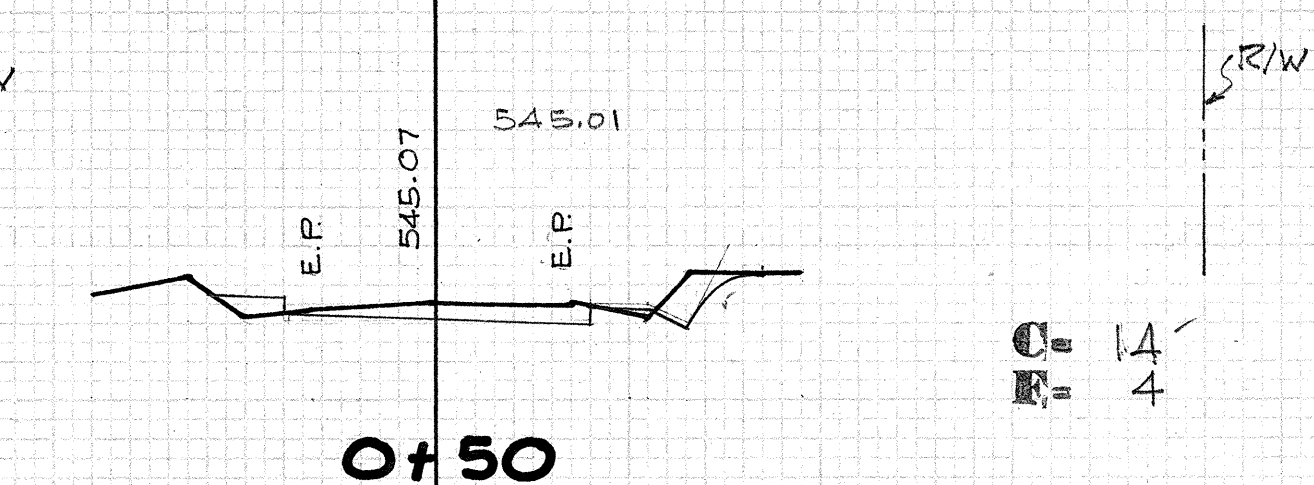
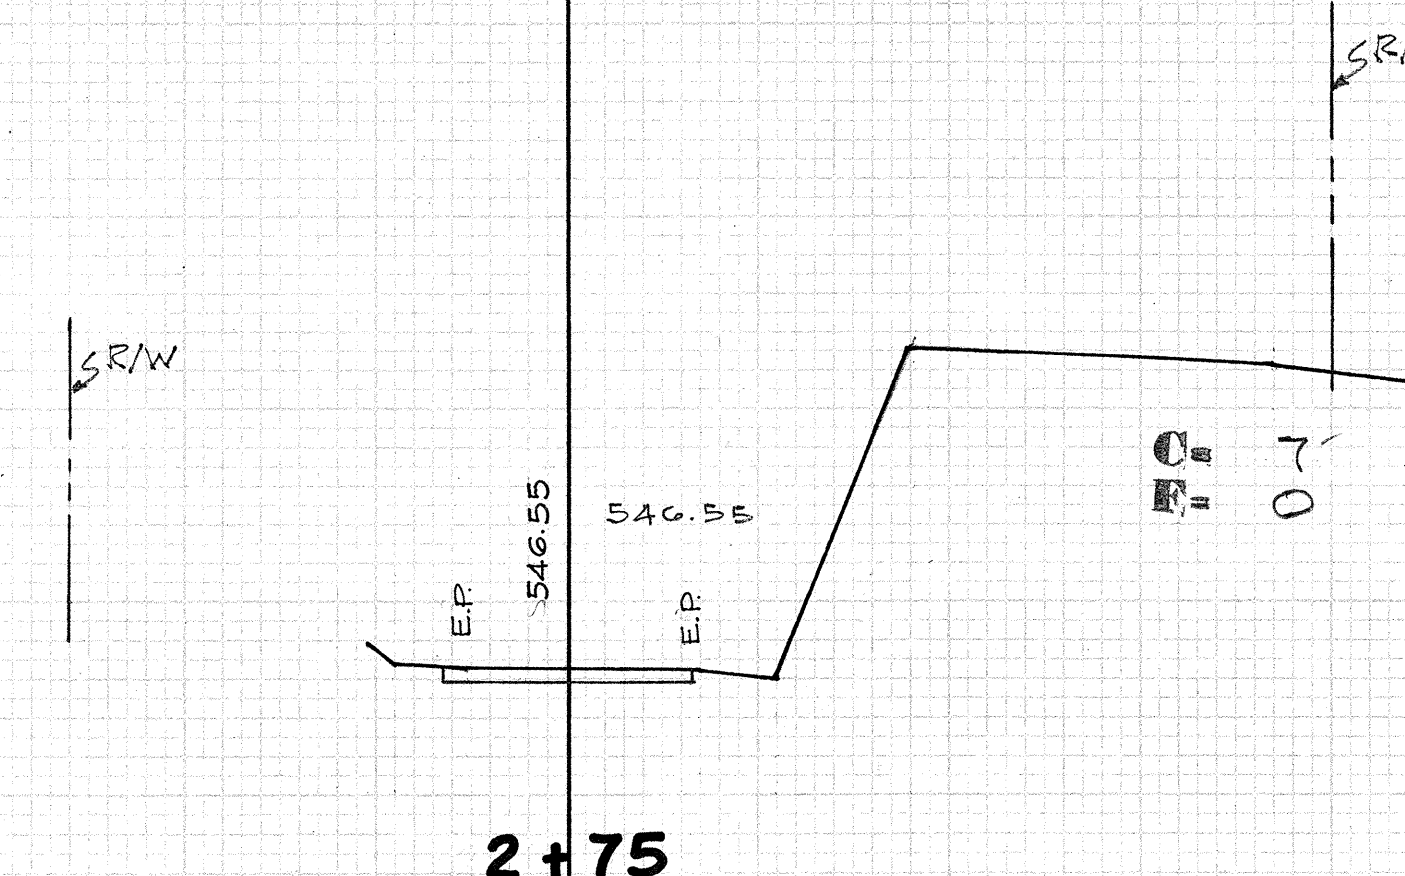
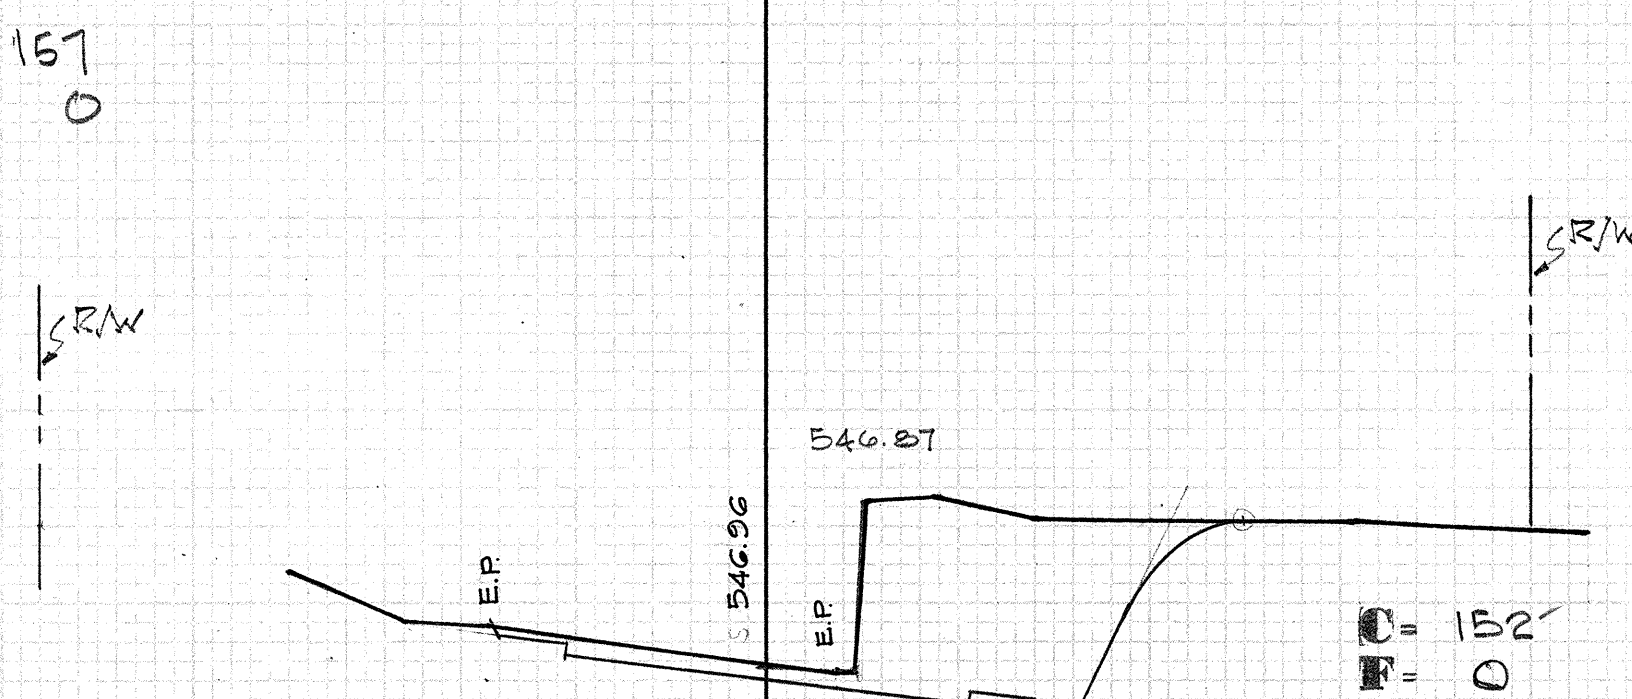
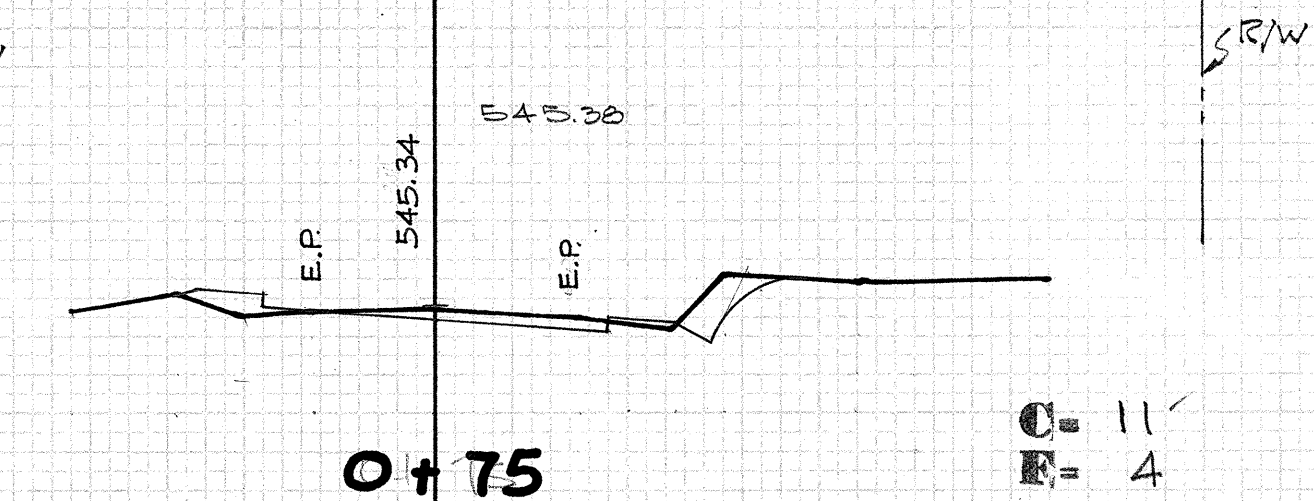
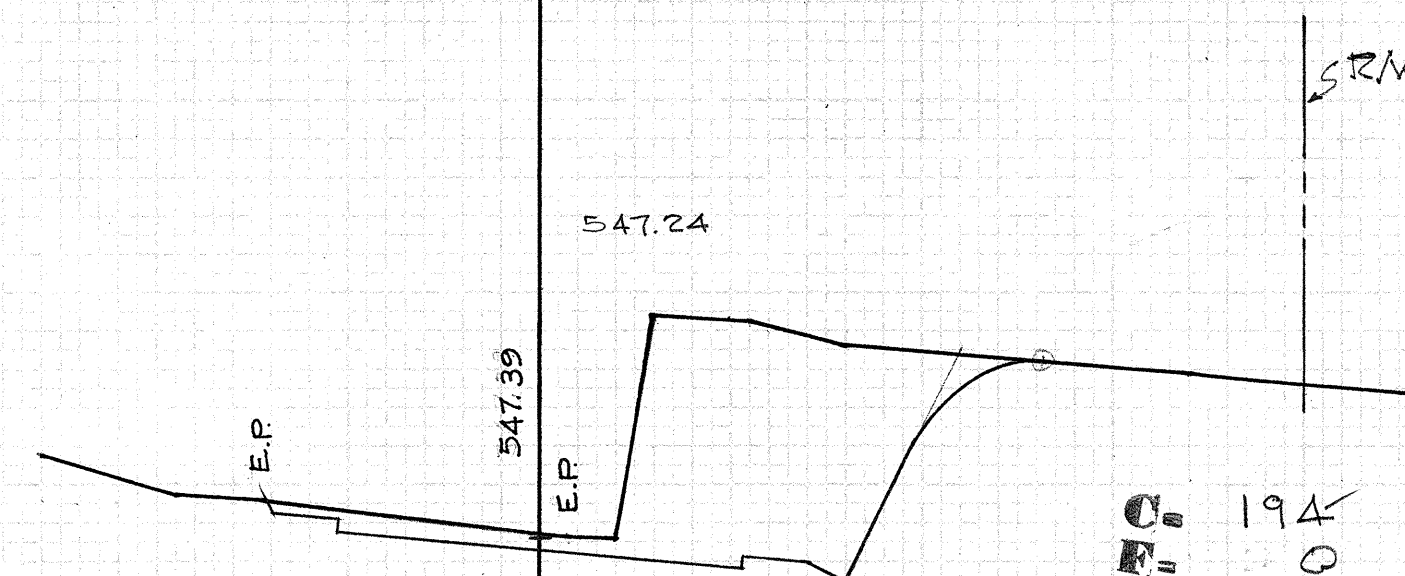
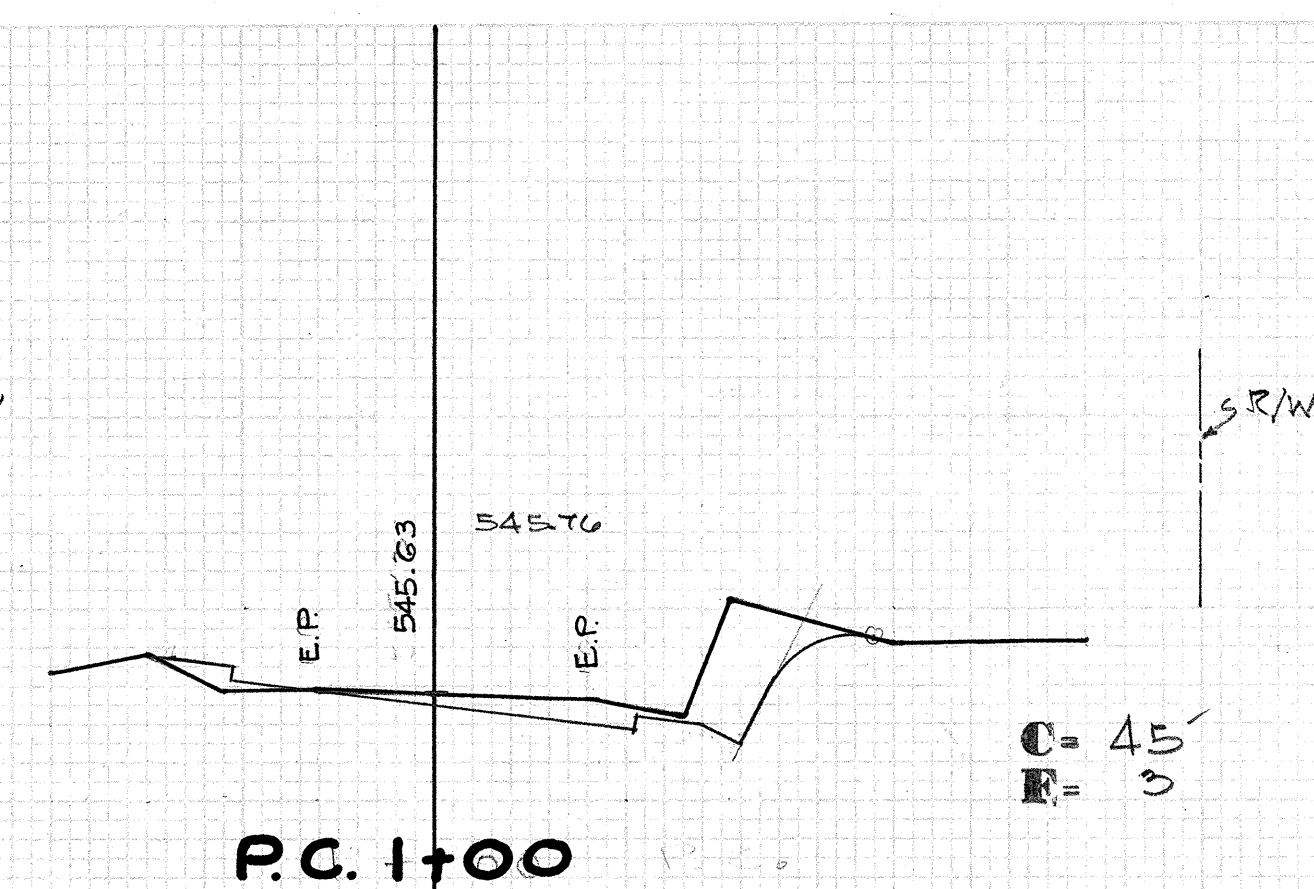
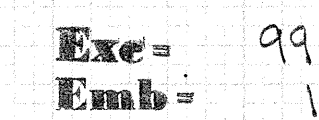
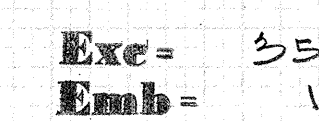


ORIGINAL	SURVEYED _____	BY _____	DATE _____
SURVEY	PLOTTED _____	<i>JNG. M. S. G. Y. T.</i>	<i>1-28-62</i>
NOTE BOOK	TEMPLATE _____	<i>94</i>	<i>9-2-62</i>
FO.	AREAS _____	<i>94</i>	<i>9-2-64</i>
	AREAS CHECKED _____		

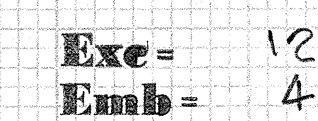

FED. ROAD DIST. No.	STATE	PROJ. No.	FISCAL YEAR	SHEET No.	TOTAL SHEETS
HAWAII	HAW.	C-360-01-63	1966	10	18

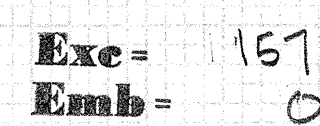


IMPROVEMENT NO. 1

FED. ROAD DIST. NO.	STATE	PROJ. NO.	FISCAL YEAR	SHEET NO.	TOTAL SHEETS
HAWAII	HAW.	C-300-01-65	1966	12	18

DATE: 7-64
BY: [Signature]
CHECKED: [Signature]
DESIGNED: [Signature]
SURVEY: [Signature]
NOTE BOOK: [Signature]
AREA CHECKED: [Signature]

DATE: 7-64
BY: [Signature]
CHECKED: [Signature]
DESIGNED: [Signature]
SURVEY: [Signature]
NOTE BOOK: [Signature]
AREA CHECKED: [Signature]





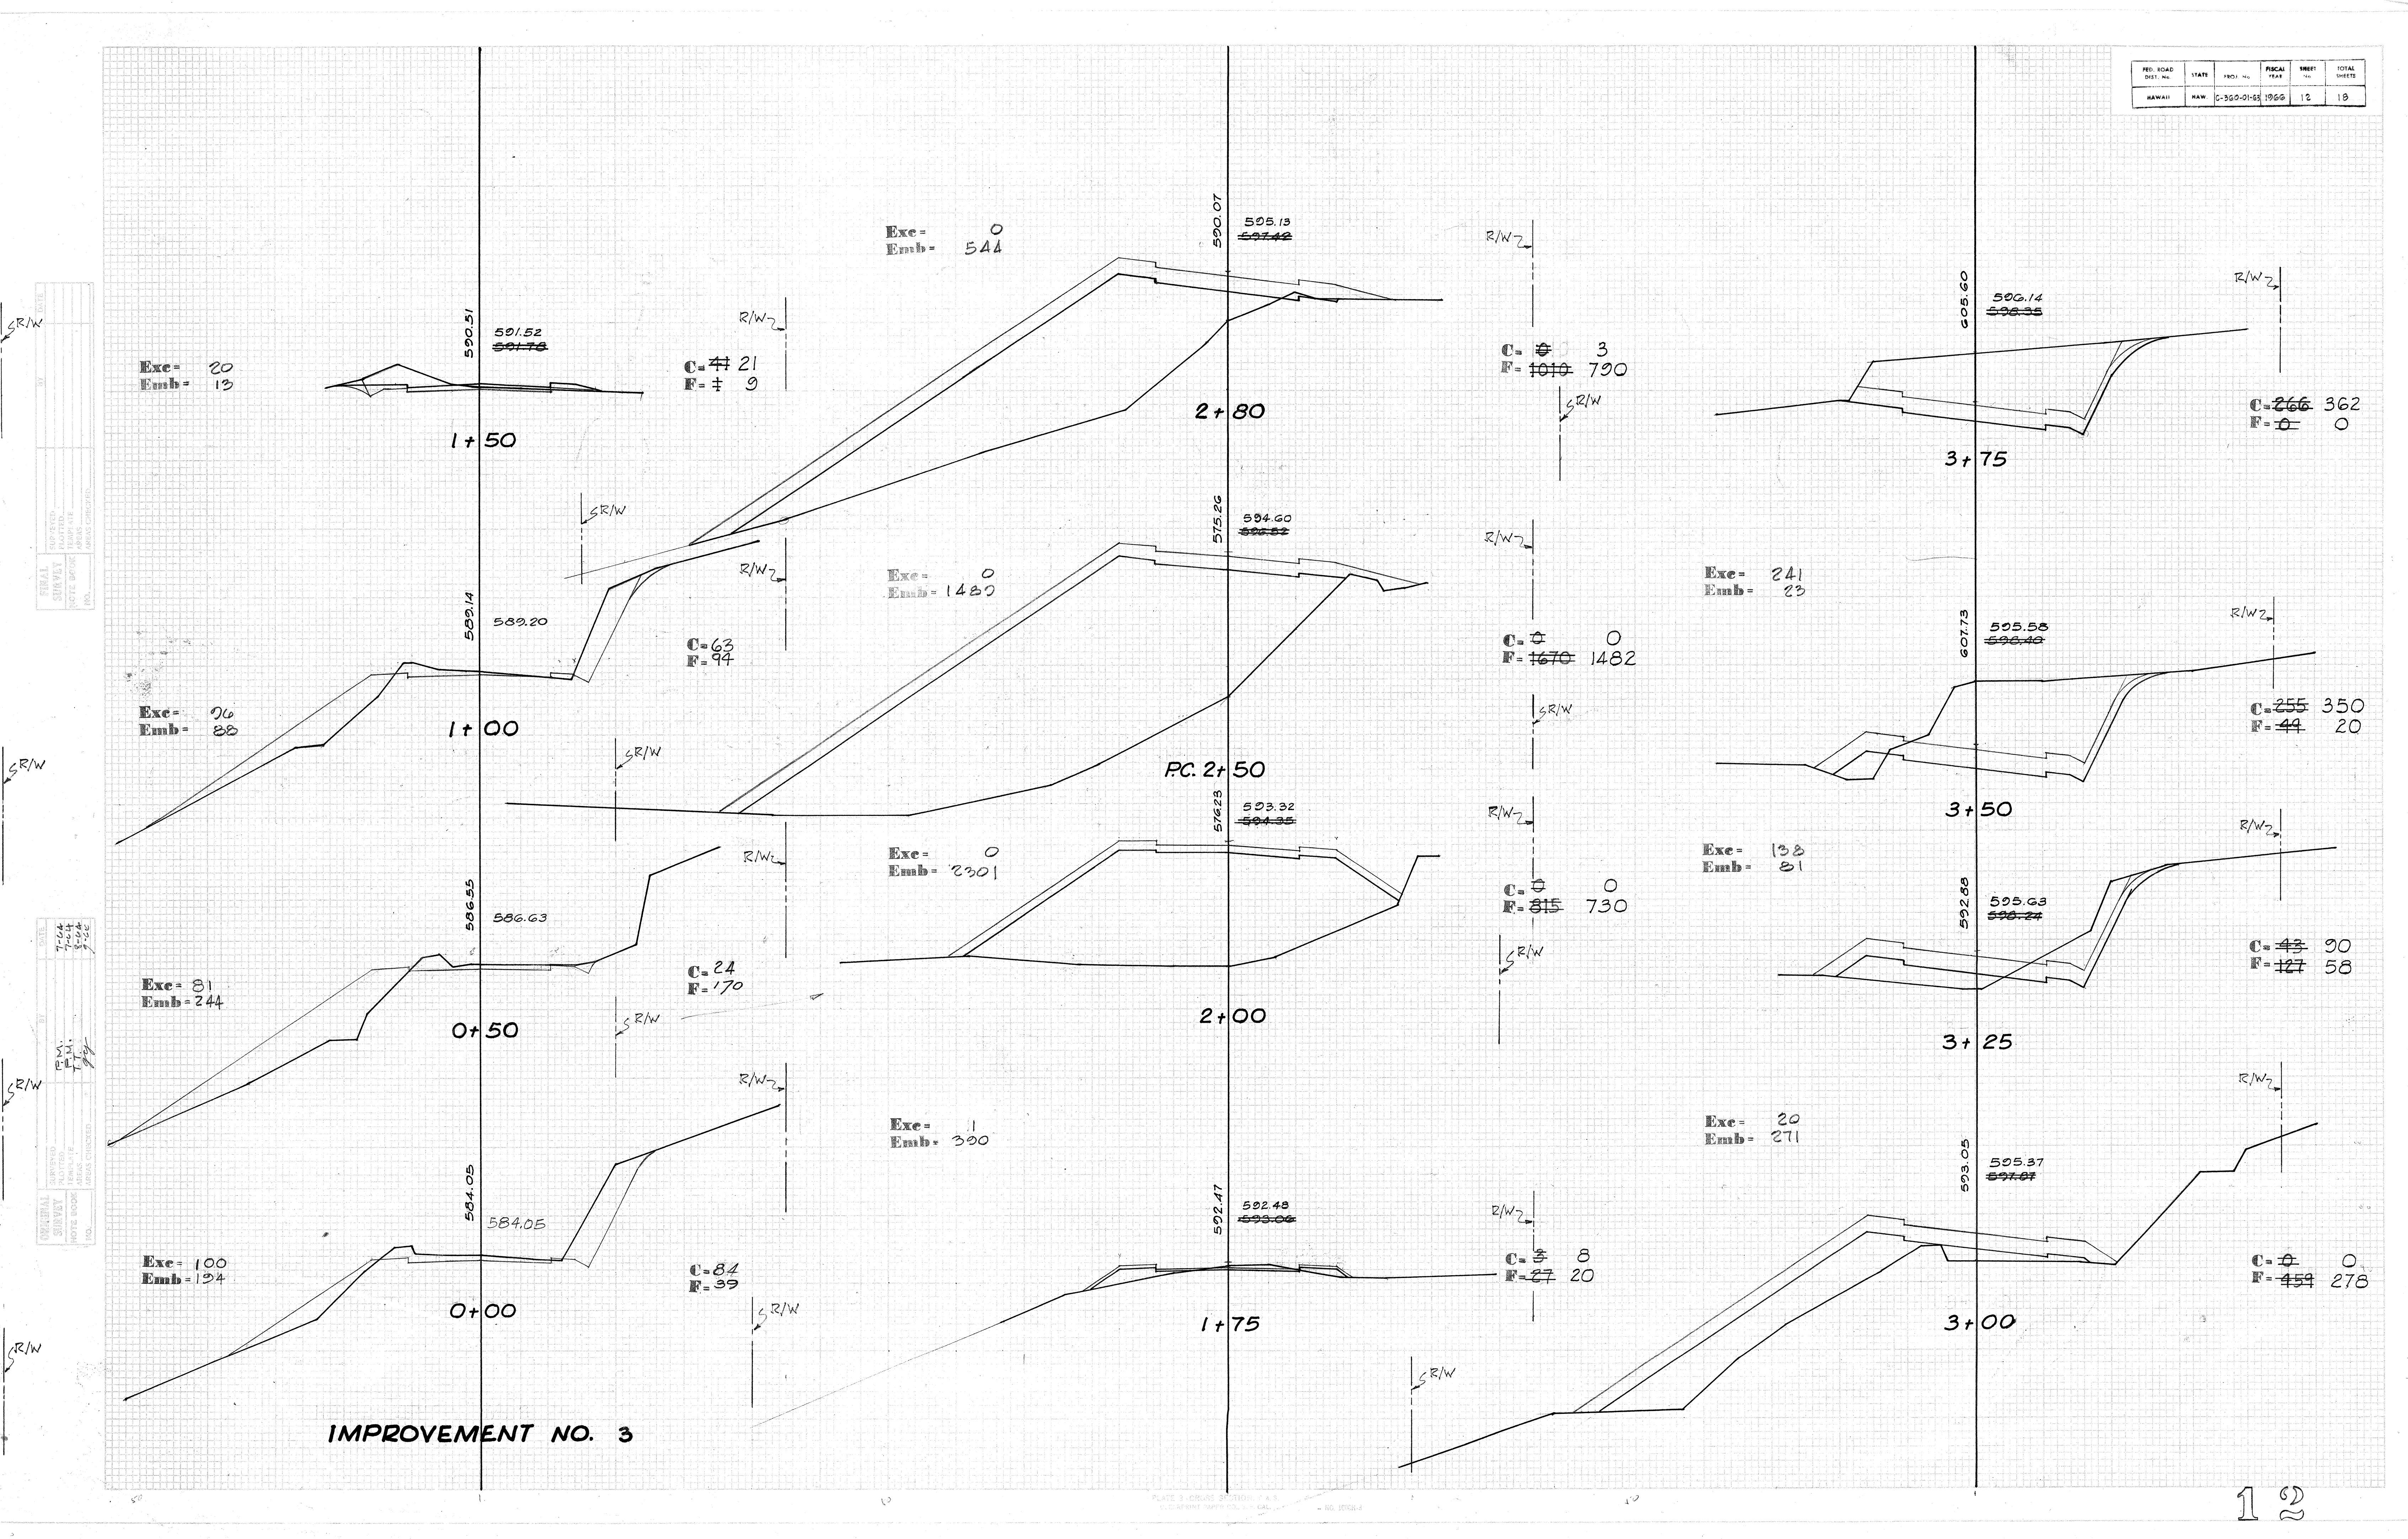


IMPROVEMENT NO. 3

PRO. ROAD DIST. NO.	STATE	PROJ. NO.	FISCAL YEAR	SHEET NO.	TOTAL SHEETS
HAWAII	HAW.	0300-01-63	1966	13	18

FINAL	DATE
SURVEY	5-64
NOTE BOOK	7-64
NO.	9-64

ORIGINAL	DATE
SURVEY	5-64
NOTE BOOK	7-64
NO.	9-64

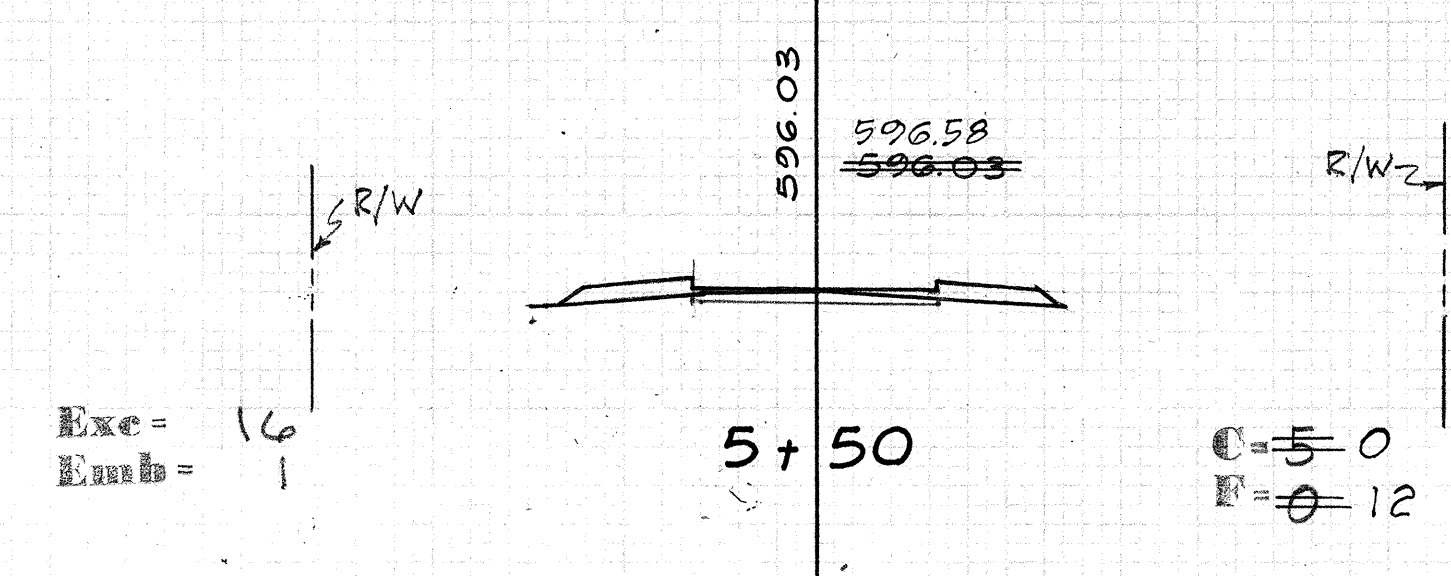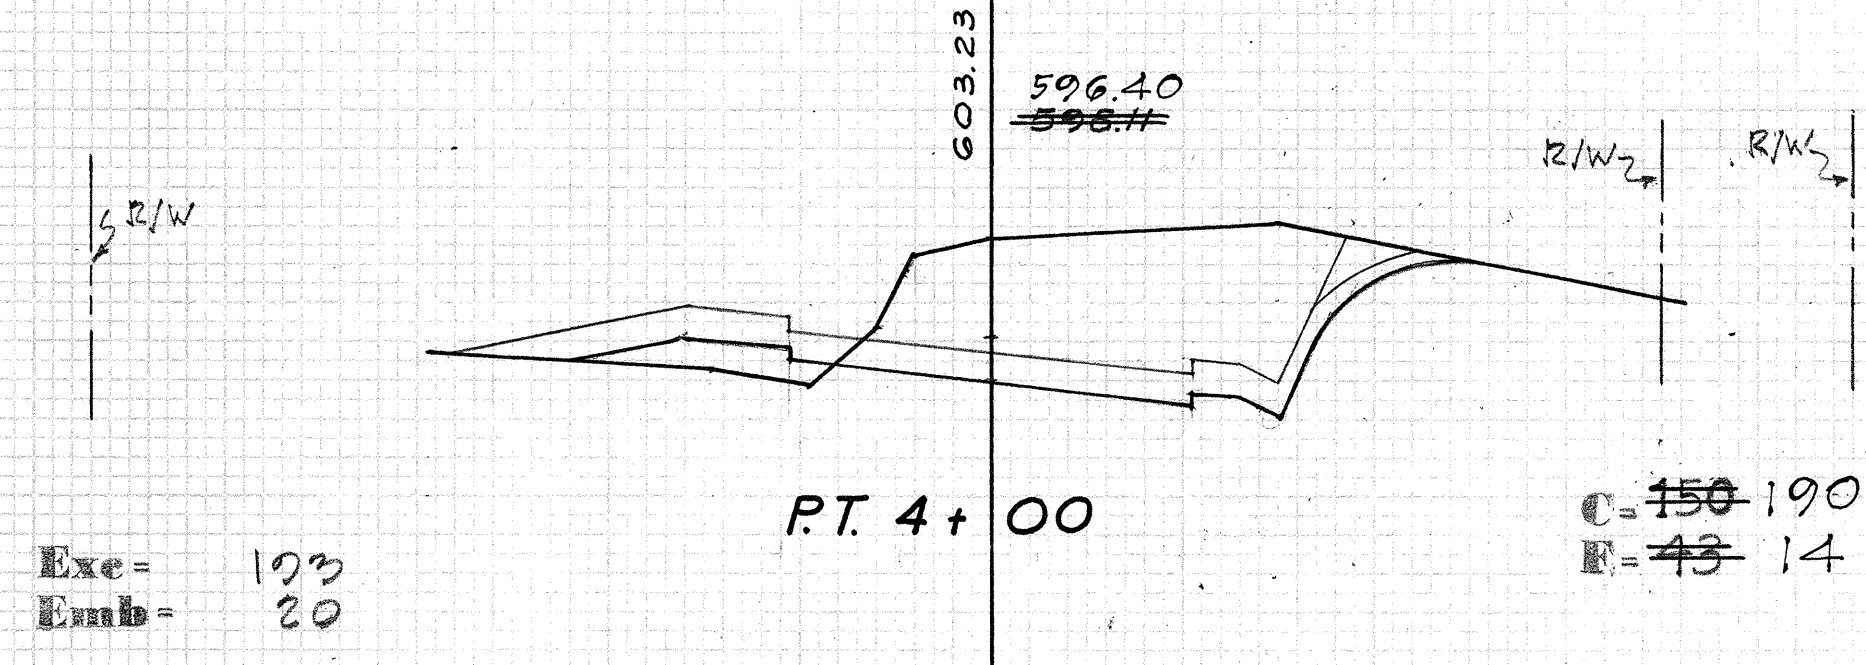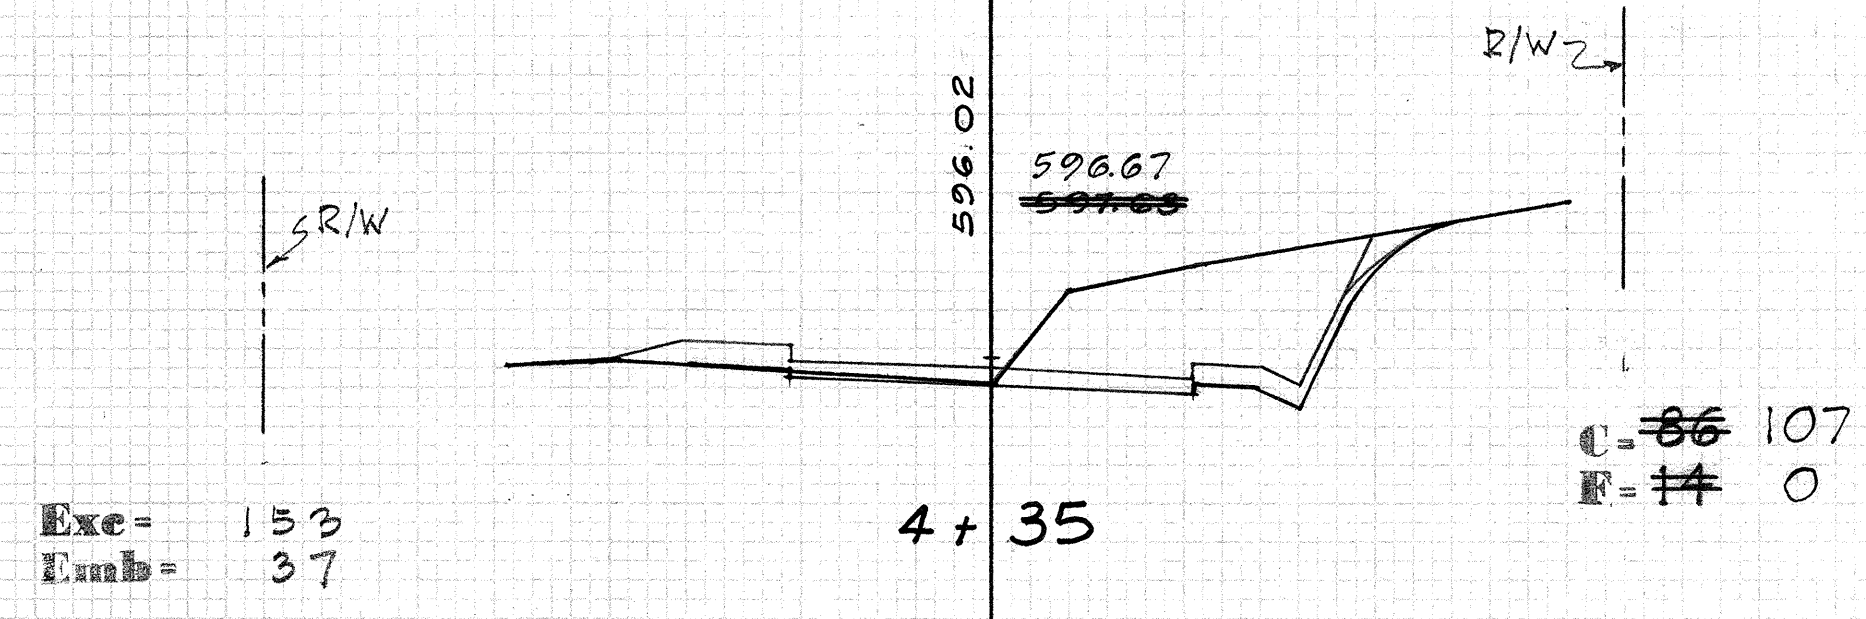
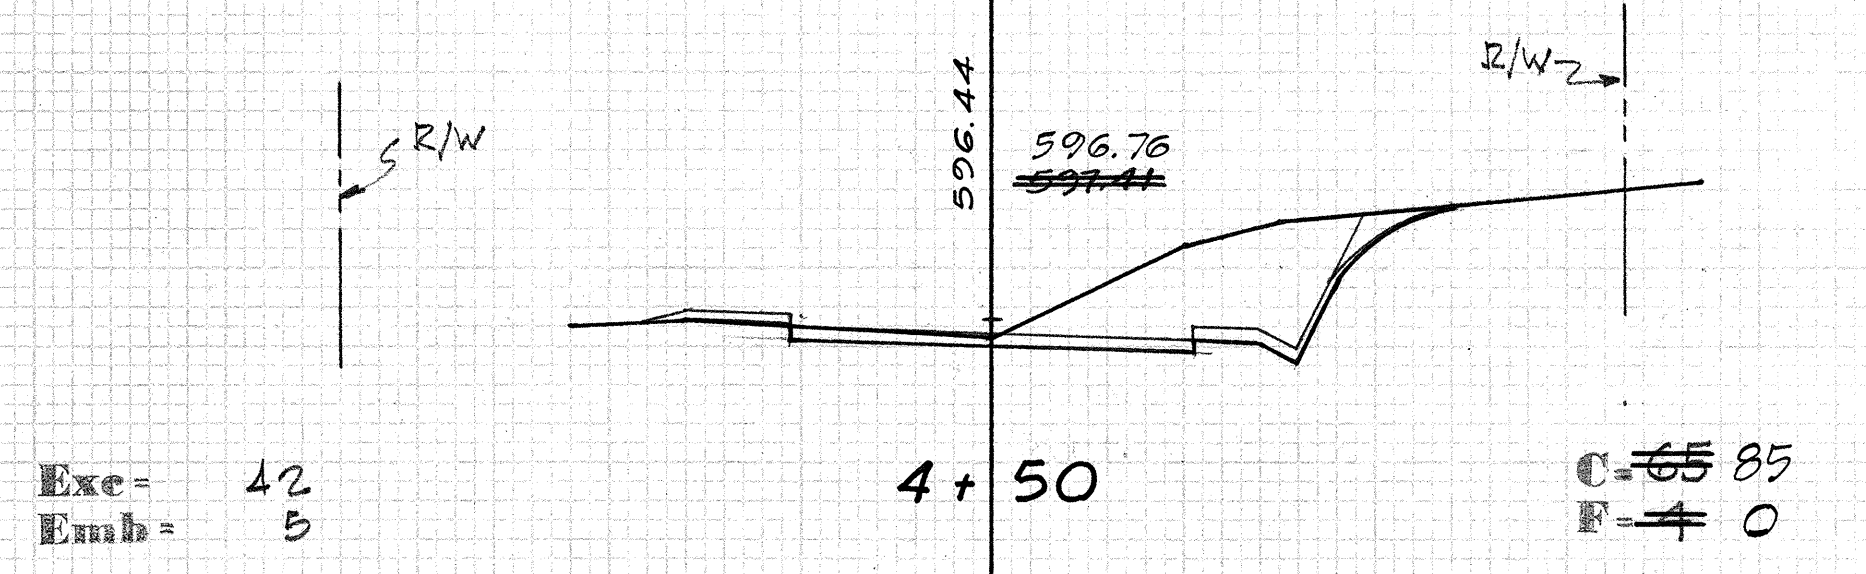
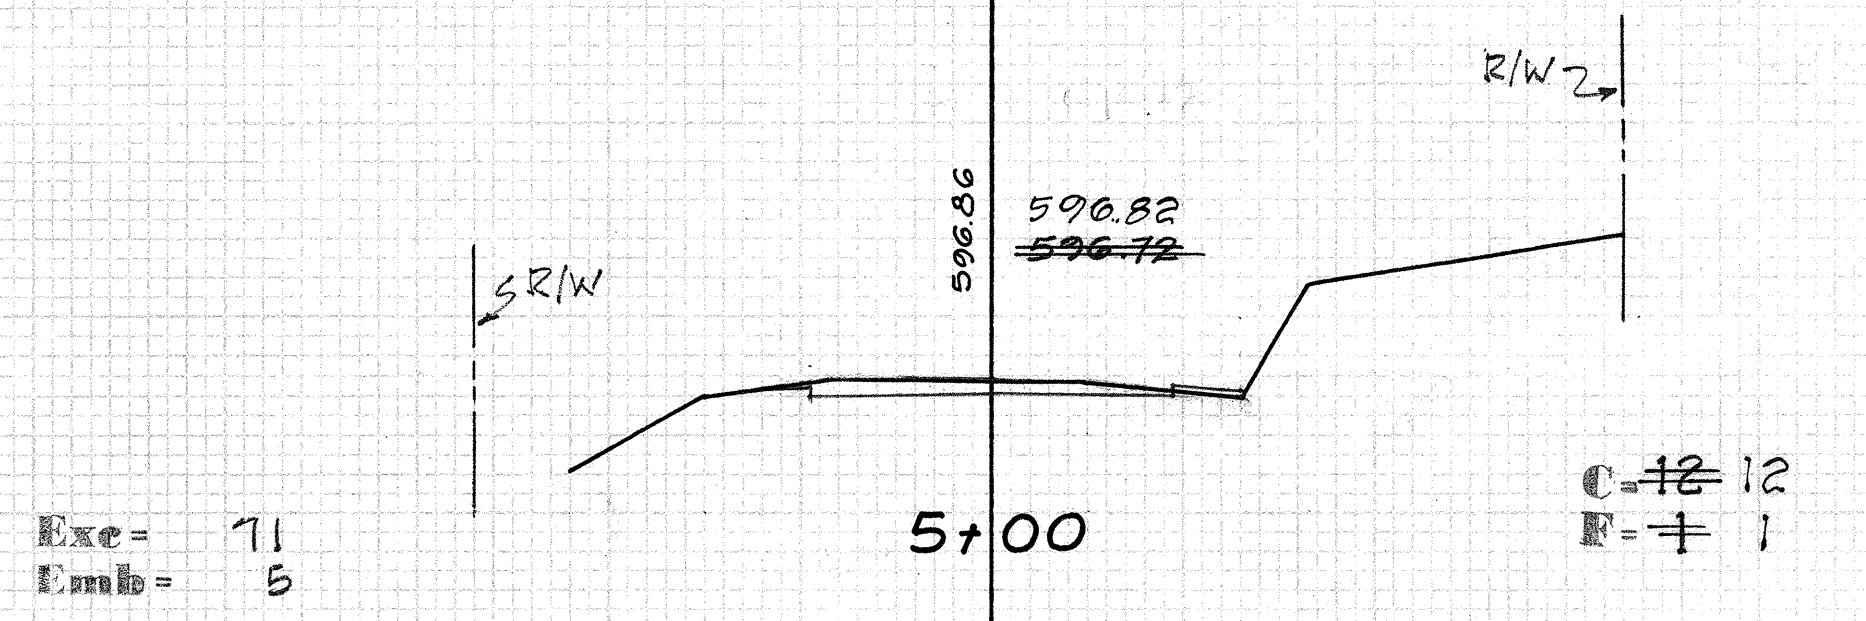


IMPROVEMENT NO. 3

FED. ROAD DIST. No.	STATE	PROJ. No.	FISCAL YEAR	SHEET No.	TOTAL SHEETS
HAWAII	HAW.	C-300-D-63	1966	14	18

FINAL SURVEY	SURVEYED	BY	DATE
	PLOTTED		
	TEMPLATE		
	AREAS		
	AREAS CHECKED		
NO. _____			

ORIGINAL SURVEY	BY		DATE
SURVEYED			9-62
PLOTTED	P.L. & T.T.		
TEMPLE	P.L. & M.S.		9-62
AREAS	P.L.		9-62
AREAS CHECKED	E.V.		9-62
NO.			

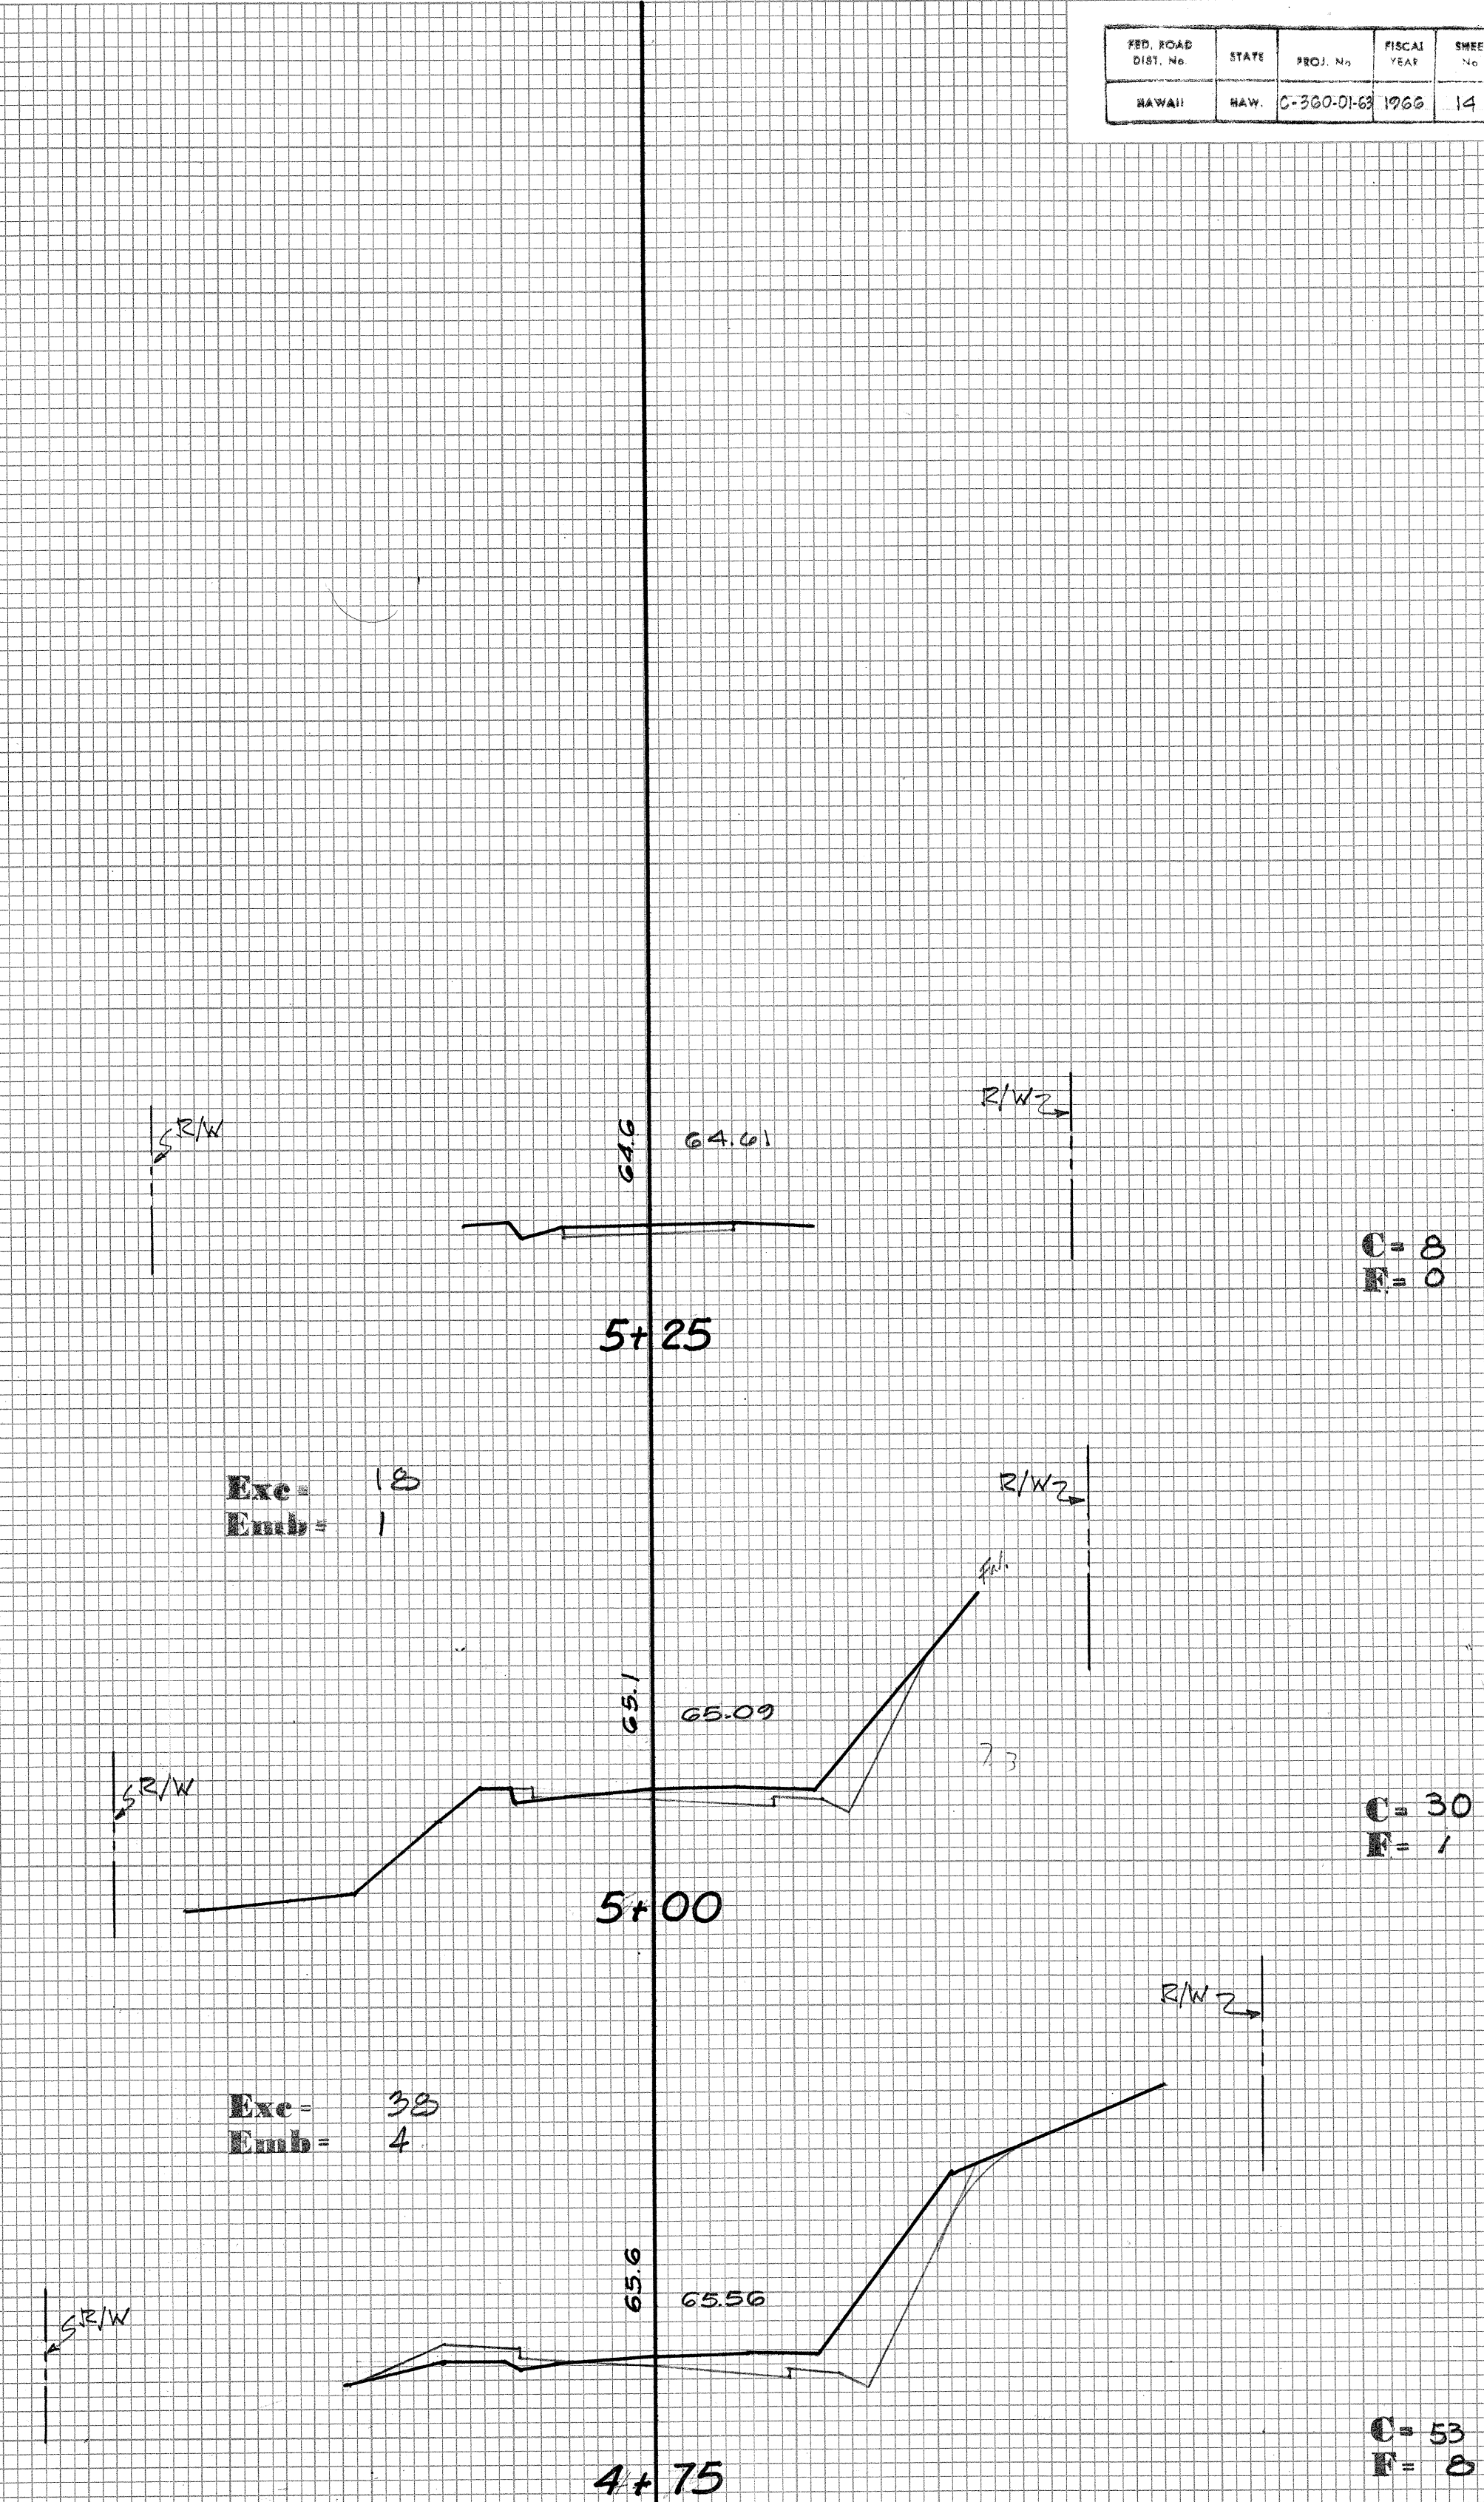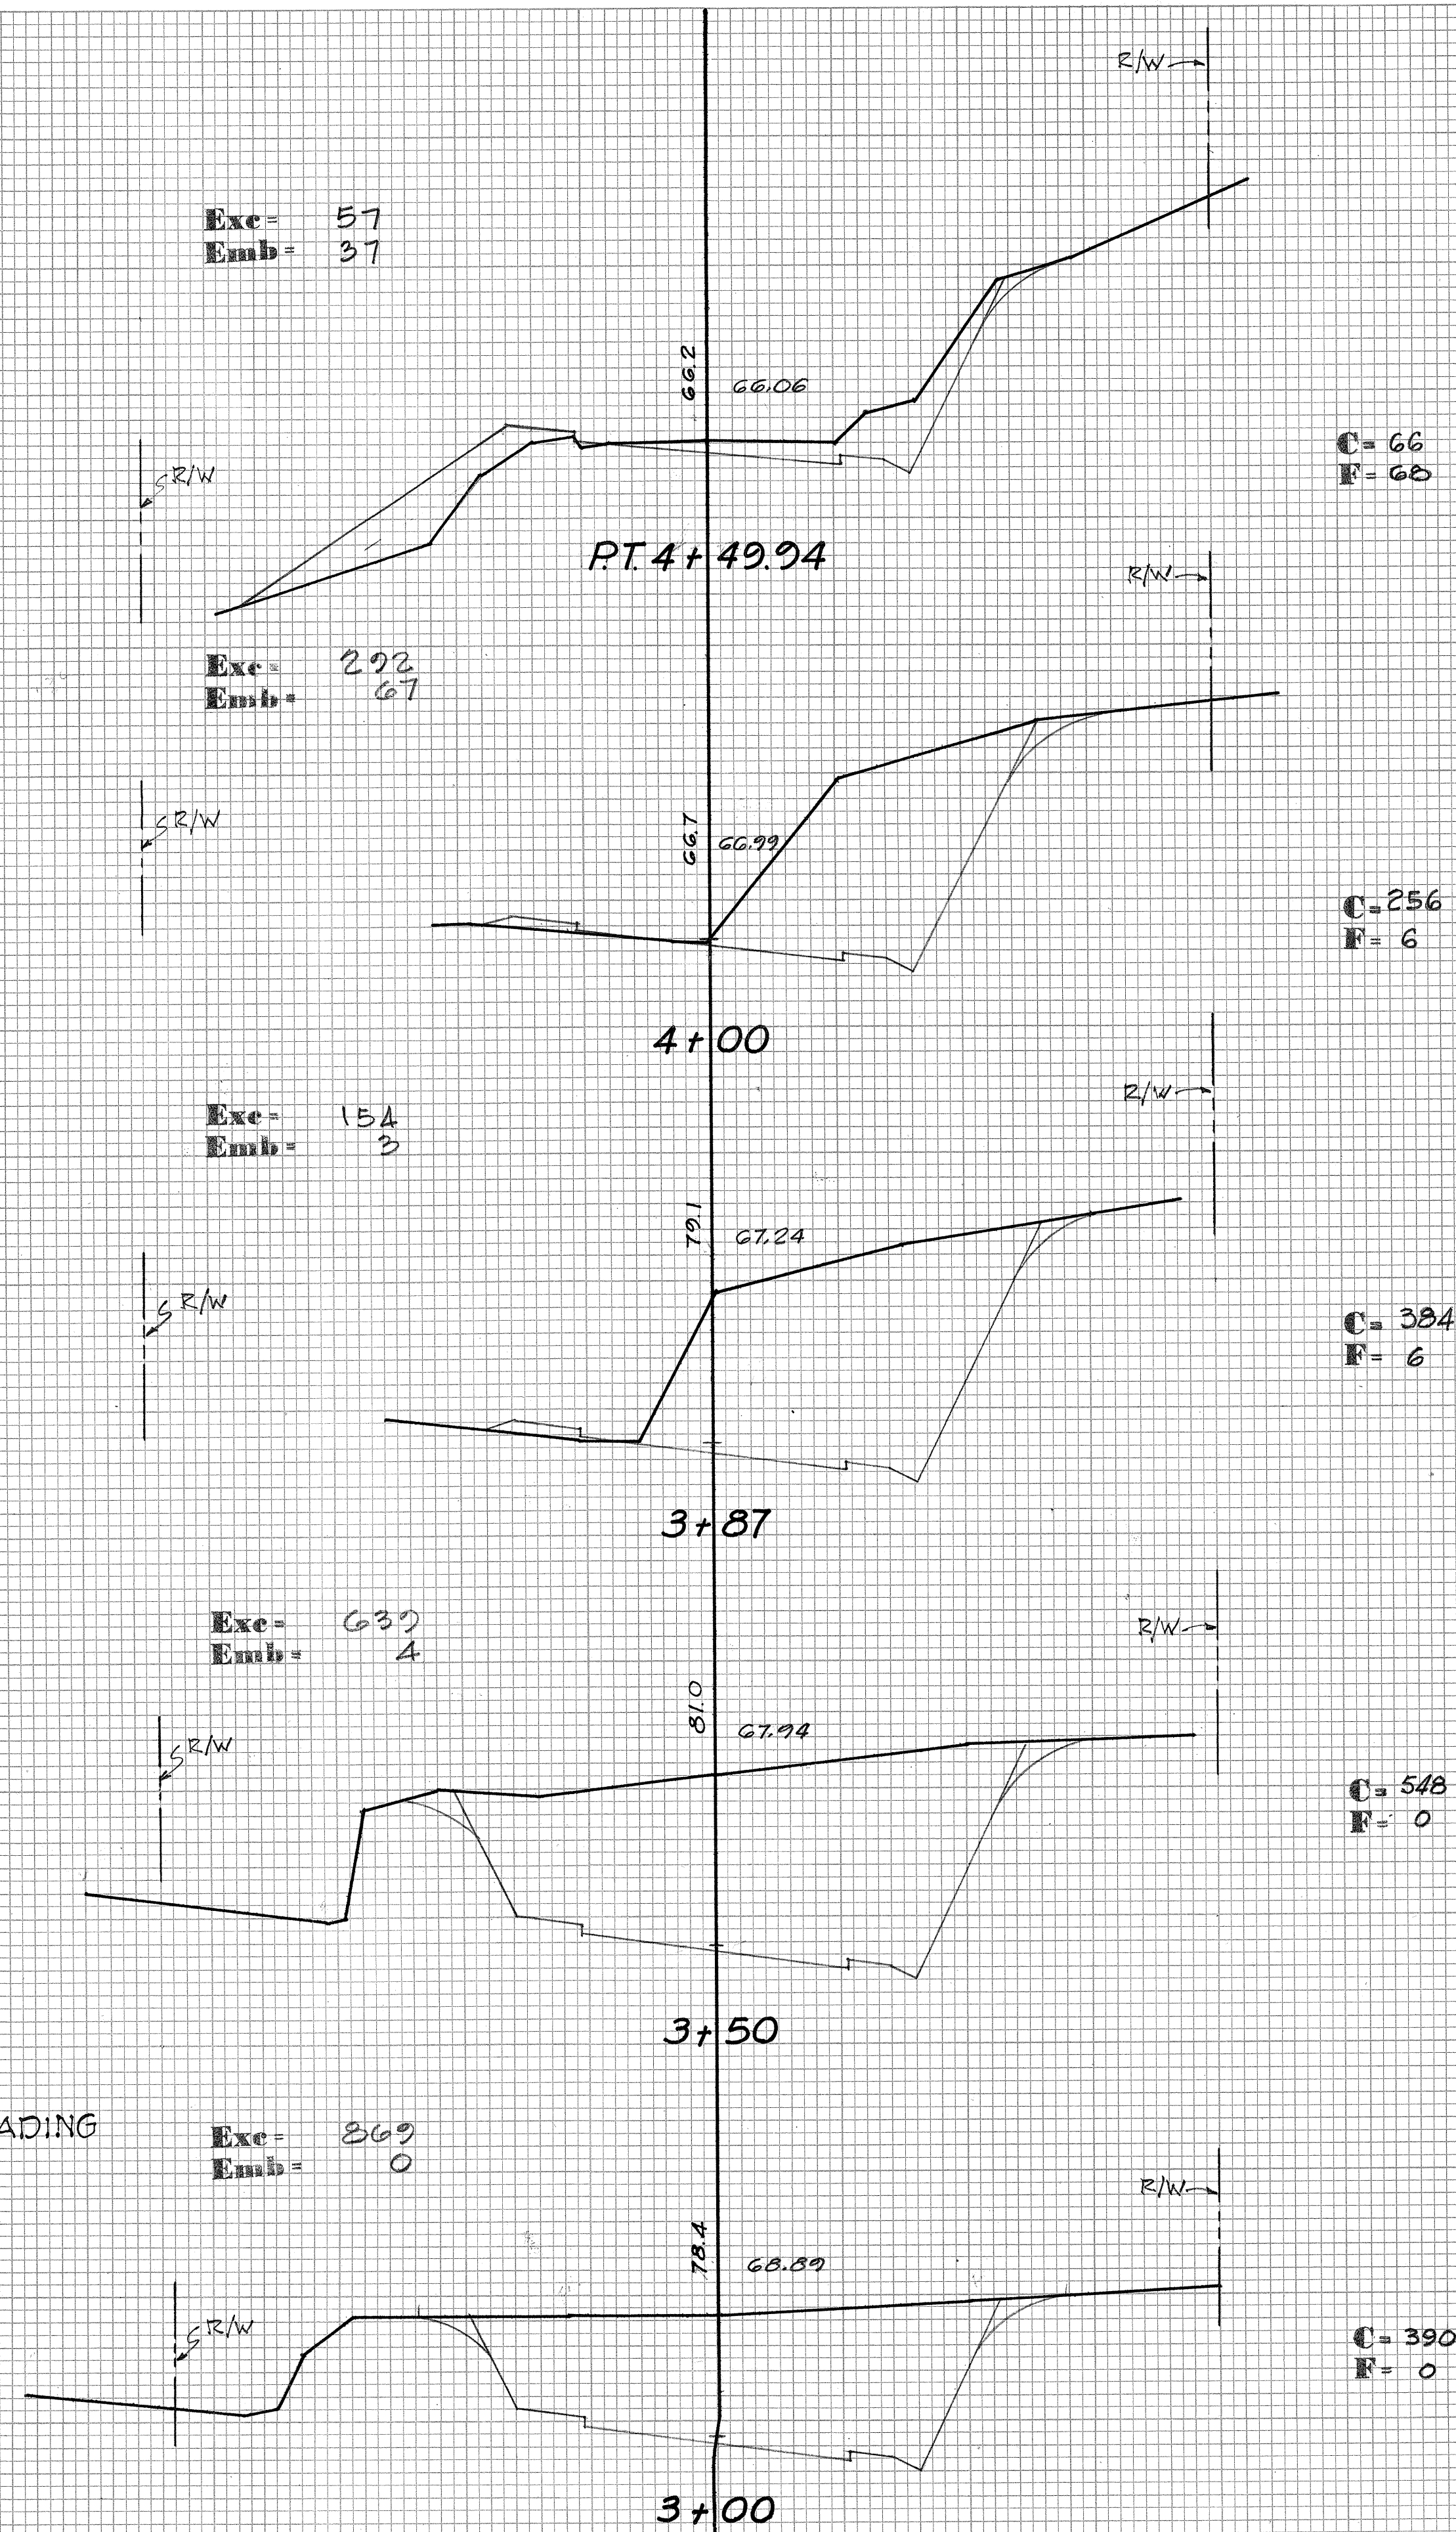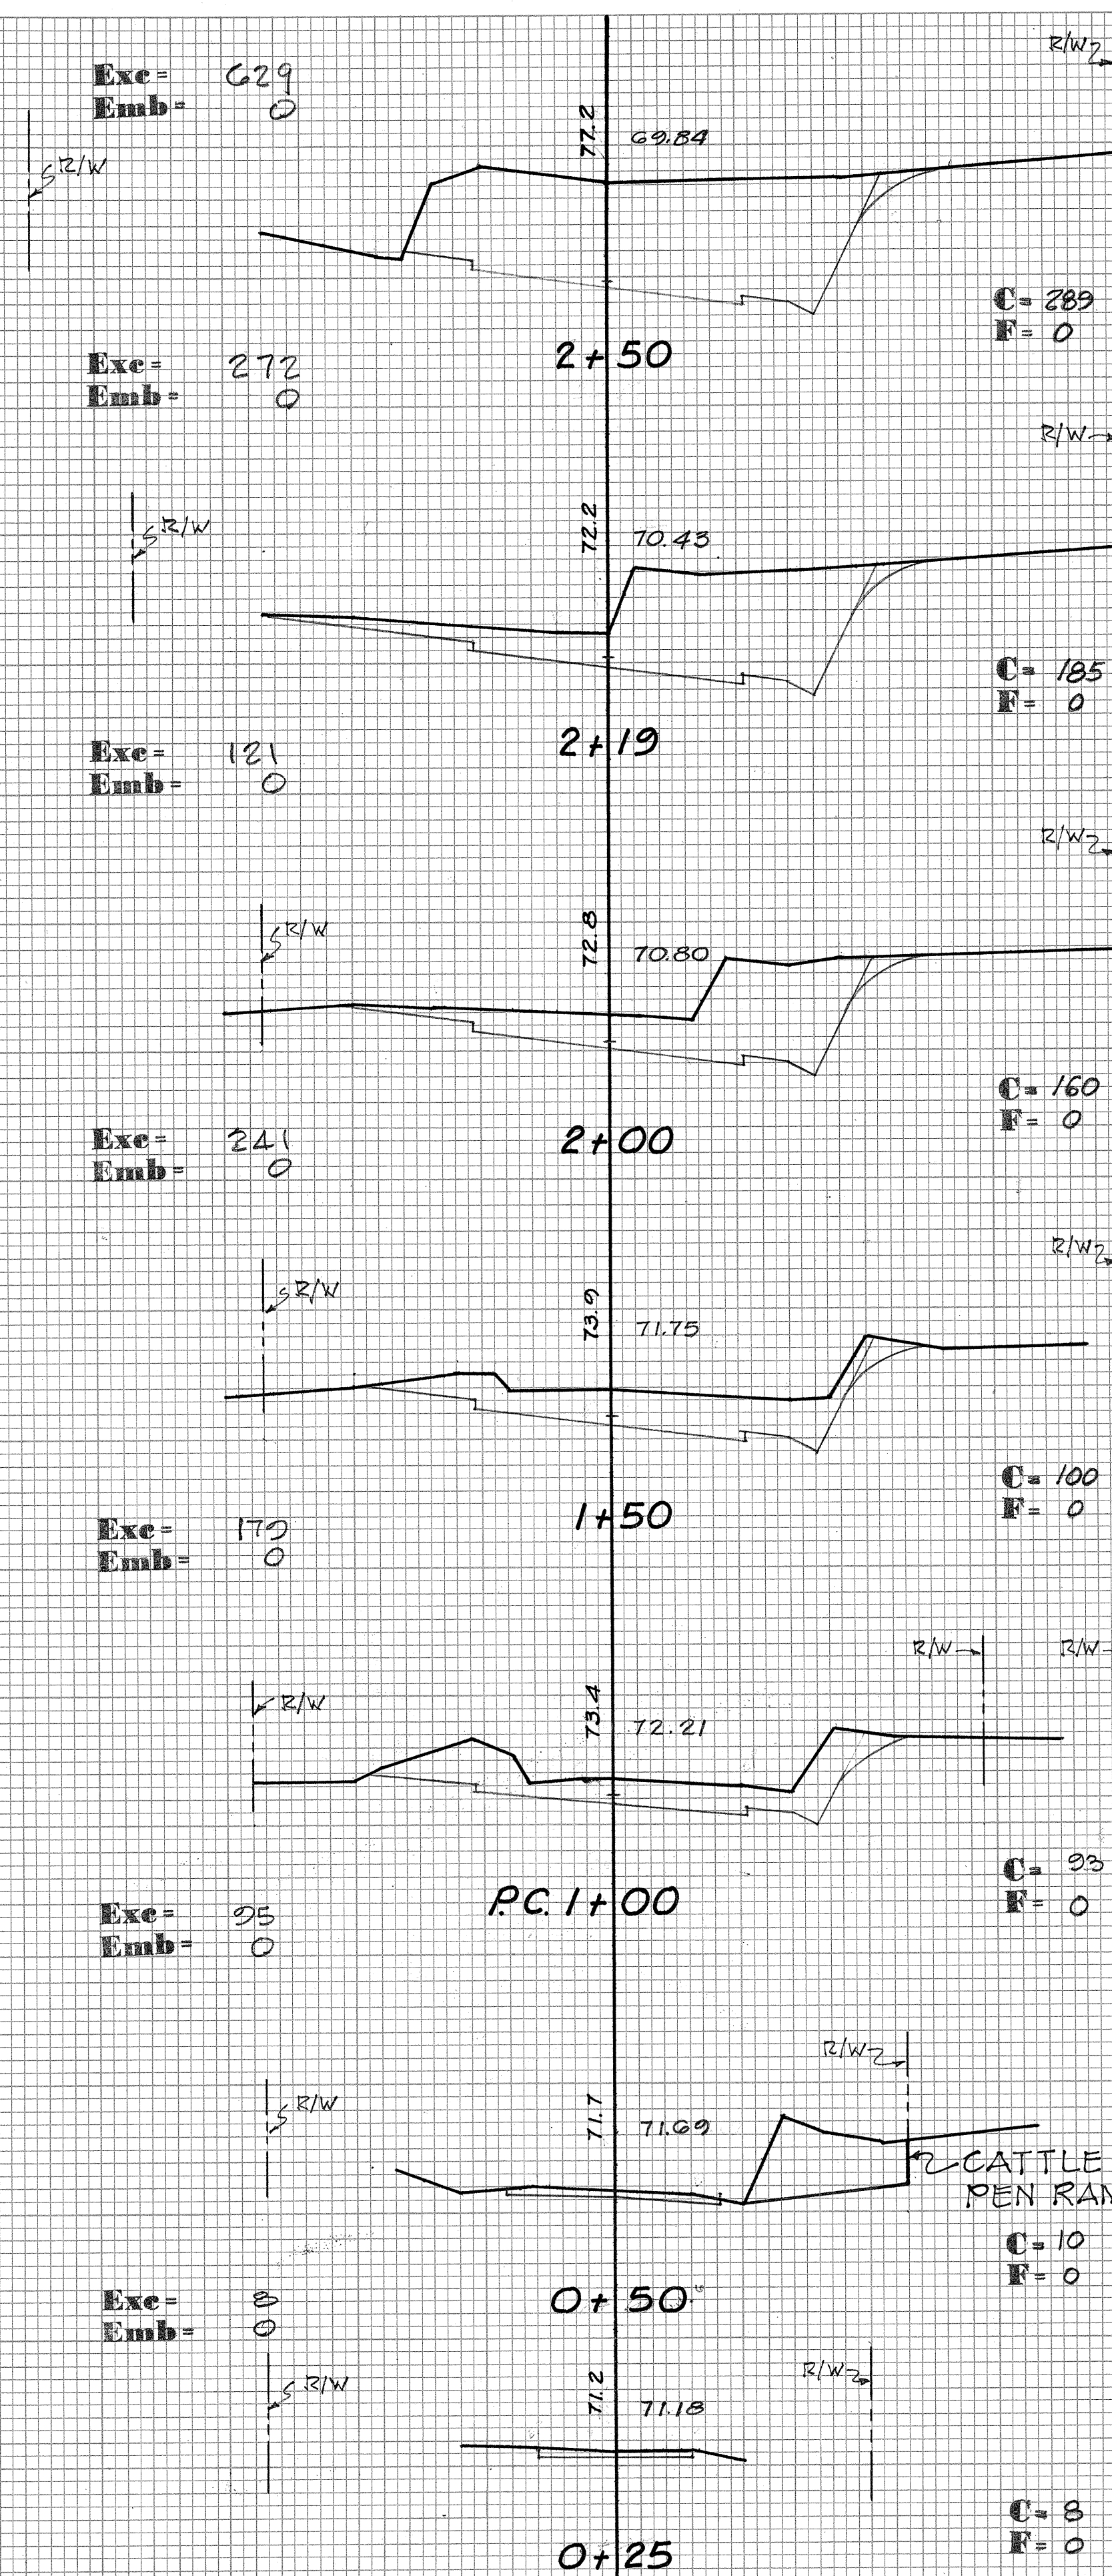


IMPROVEMENT NO. 4


PLATE 3 CROSS SECTION O. P. R. & R. E. STANDARD
100% RAG PAPER—MADE AND PRINTED IN U. S. A.
EUGENE DIETZGEN CO.

14

FED. ROAD DIST. NO.	STATE	PROJ. NO.	FISCAL YEAR	SHEET NO.	TOTAL SHEETS
HAWAII	HAW.	C-350-01-03	1965	15	18

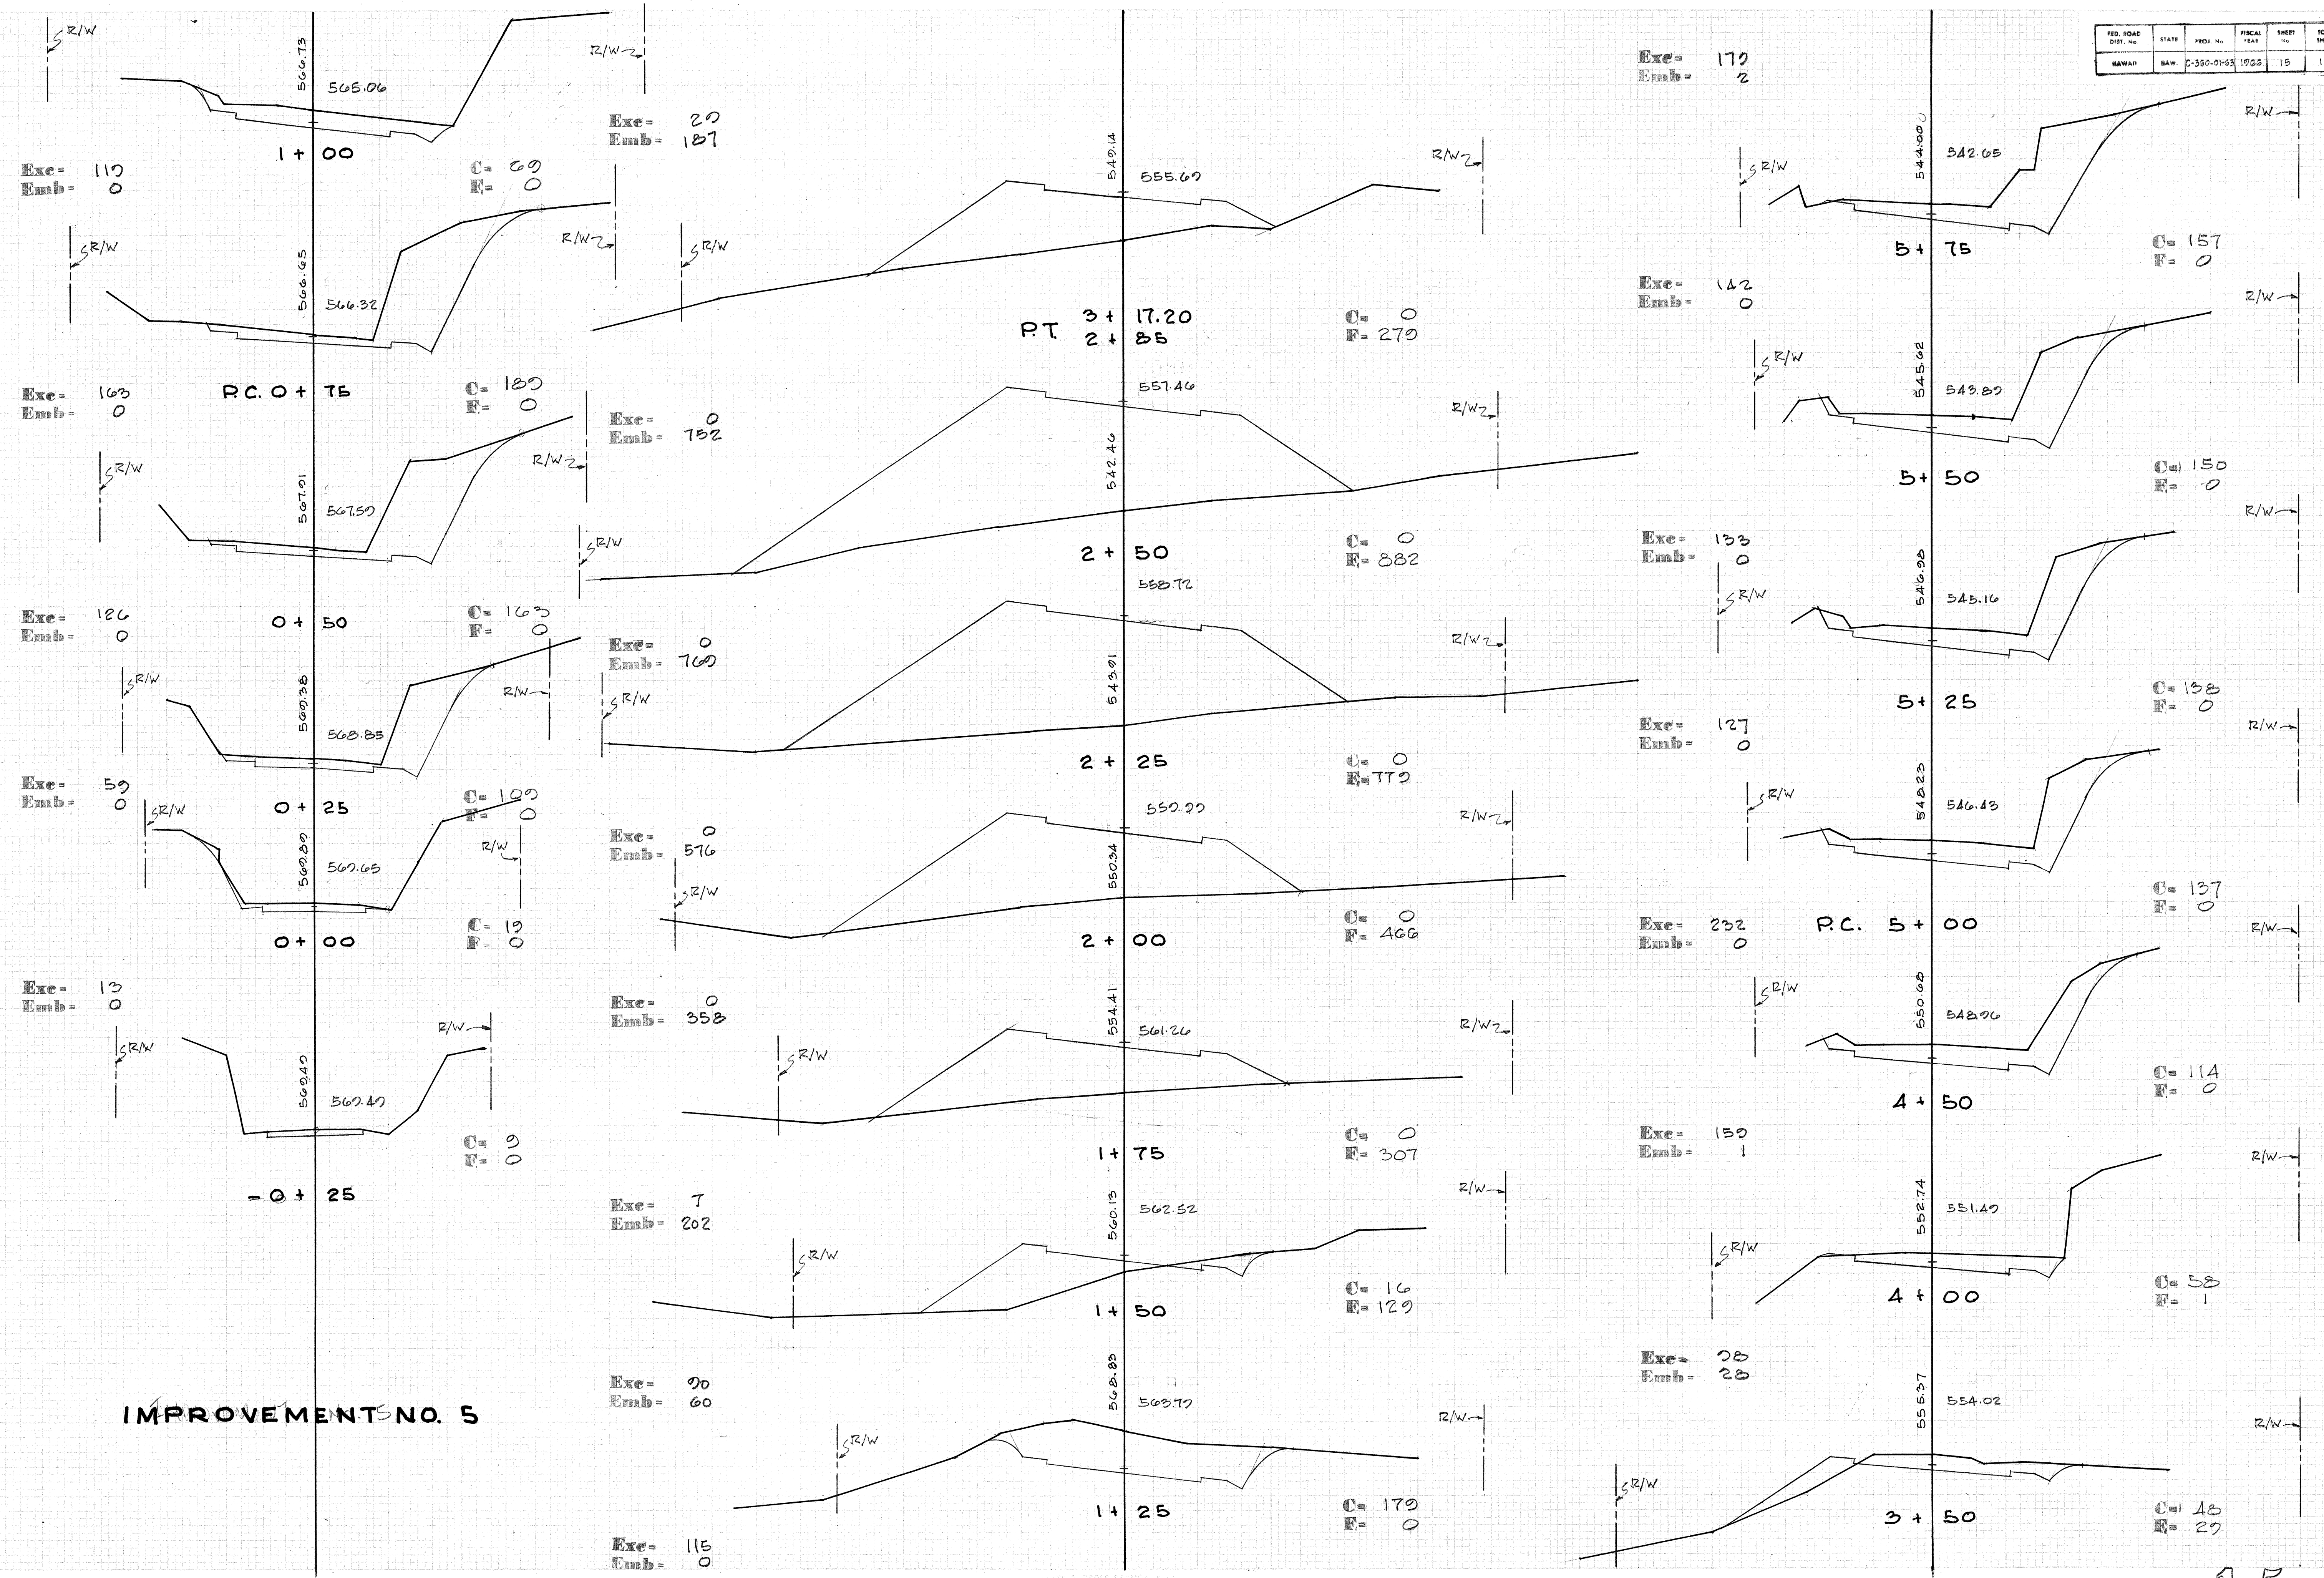

PRO. ROAD DIST. No.	STATE	PROJ. No.	FISCAL YEAR	SHEET No.	TOTAL SHEETS
HAWAII	HAW.	C-360-0155	1966	16	18

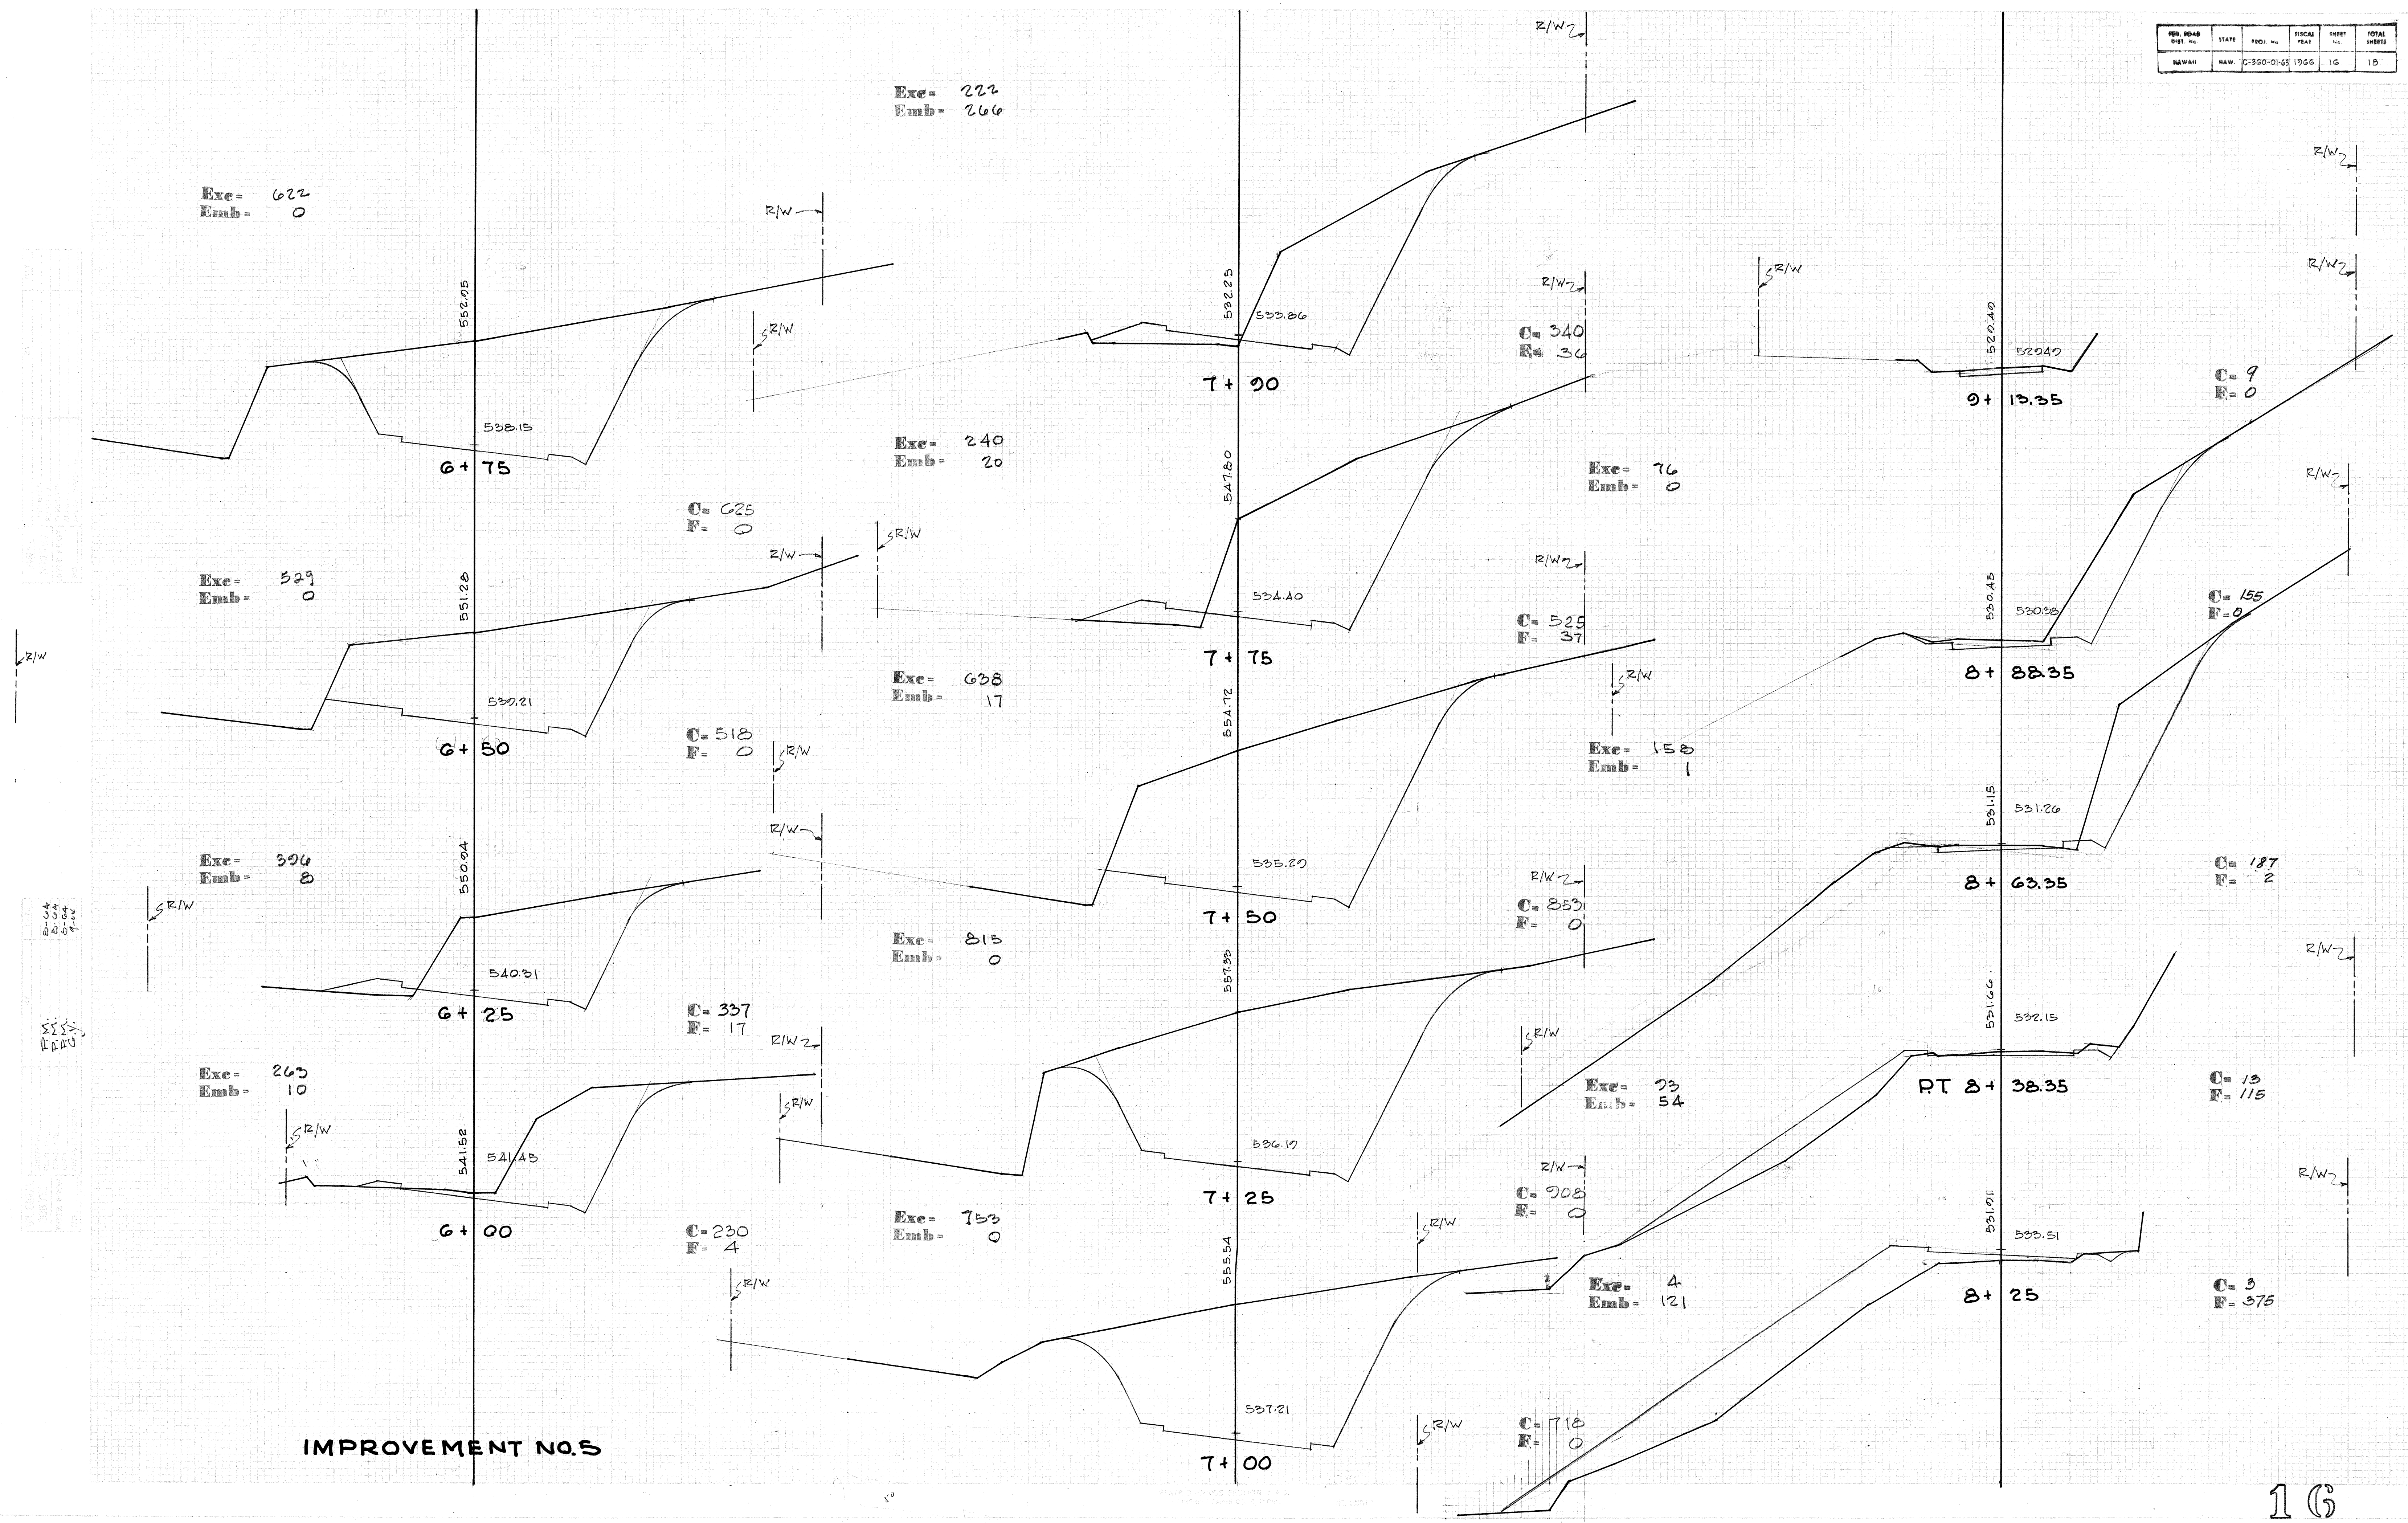

FED. ROAD DIST. NO.	STATE	PROJ. NO.	FISCAL YEAR	SHEET NO.	TOTAL SHEETS
HAWAII	HAW.	C-360-01-63	1966	17	18

Exc- 276
Emb- 6

C- 234
F- 8

Exc- 48
Emb- 2

C- 202
F- 6

Exc- 159
Emb- 6

C- 142
F- 8

Exc- 81
Emb- 5

C- 34
F- 2

IMPROVEMENT NO 6

Exc- 889
Emb- 0

Exc- 1169
Emb- 0

Exc- 1066
Emb- 0

Exc- 693
Emb- 3

C- 1170
F- 0

C- 1355
F- 0

C- 947
F- 0

C- 550
F- 9

Exc- 112
Emb- 8

Exc- 89
Emb- 2

Exc- 193
Emb- 1

Exc- 540
Emb- 0

C- 200
F- 10

C- 278
F- 2

C- 416
F- 0

C- 750
F- 0

