



PLAN	SURVEYED	DATE
BY		
PLOTTED		
NOTE BOOK GRADES CHECKED		
RT. OF WAY CHECKED		
NO.		



PROFILE	SURVEYED	DATE
BY		
PLOTTED		
NOTE BOOK GRADES CHECKED		
STRUCTURE NOTING CHECKED		
NO.		

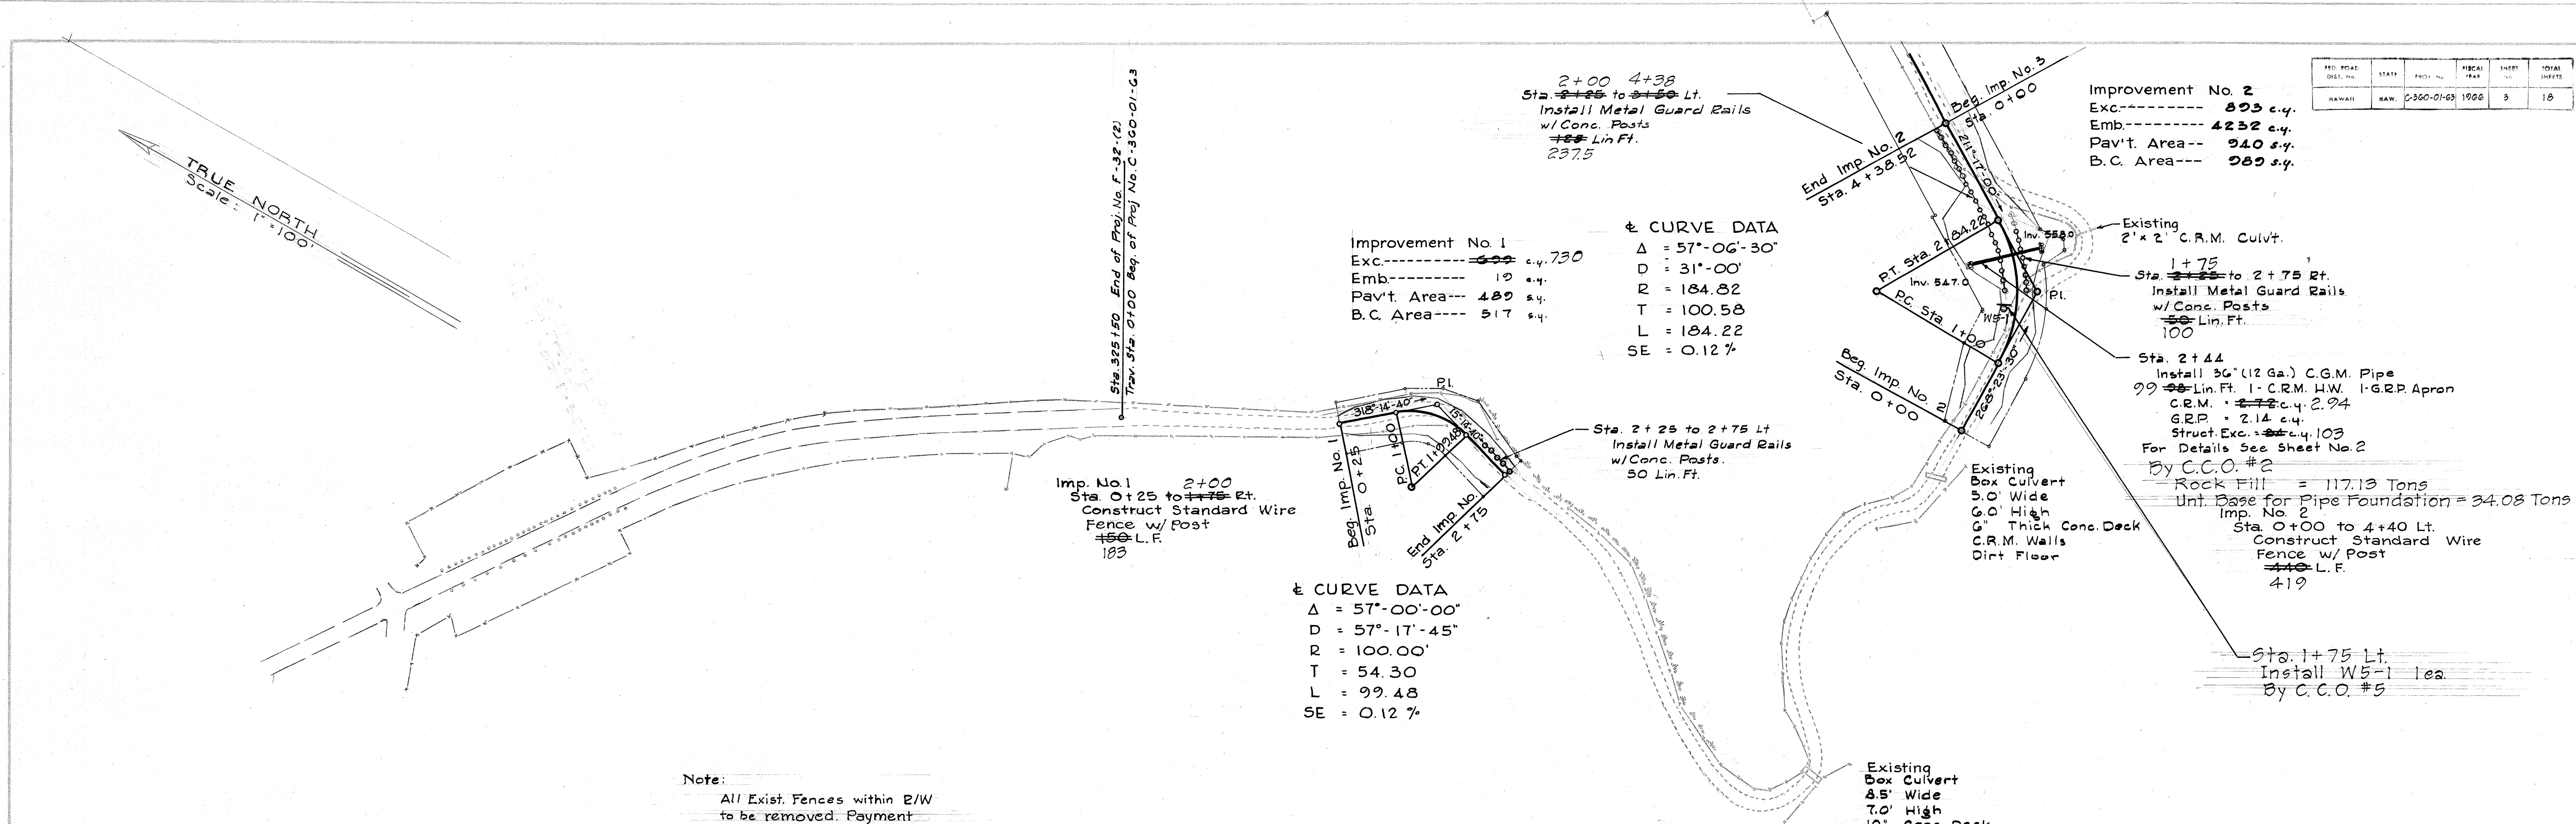

Note:
All Exist. Fences within R/W to be removed. Payment incidental to Roadway Excavation.

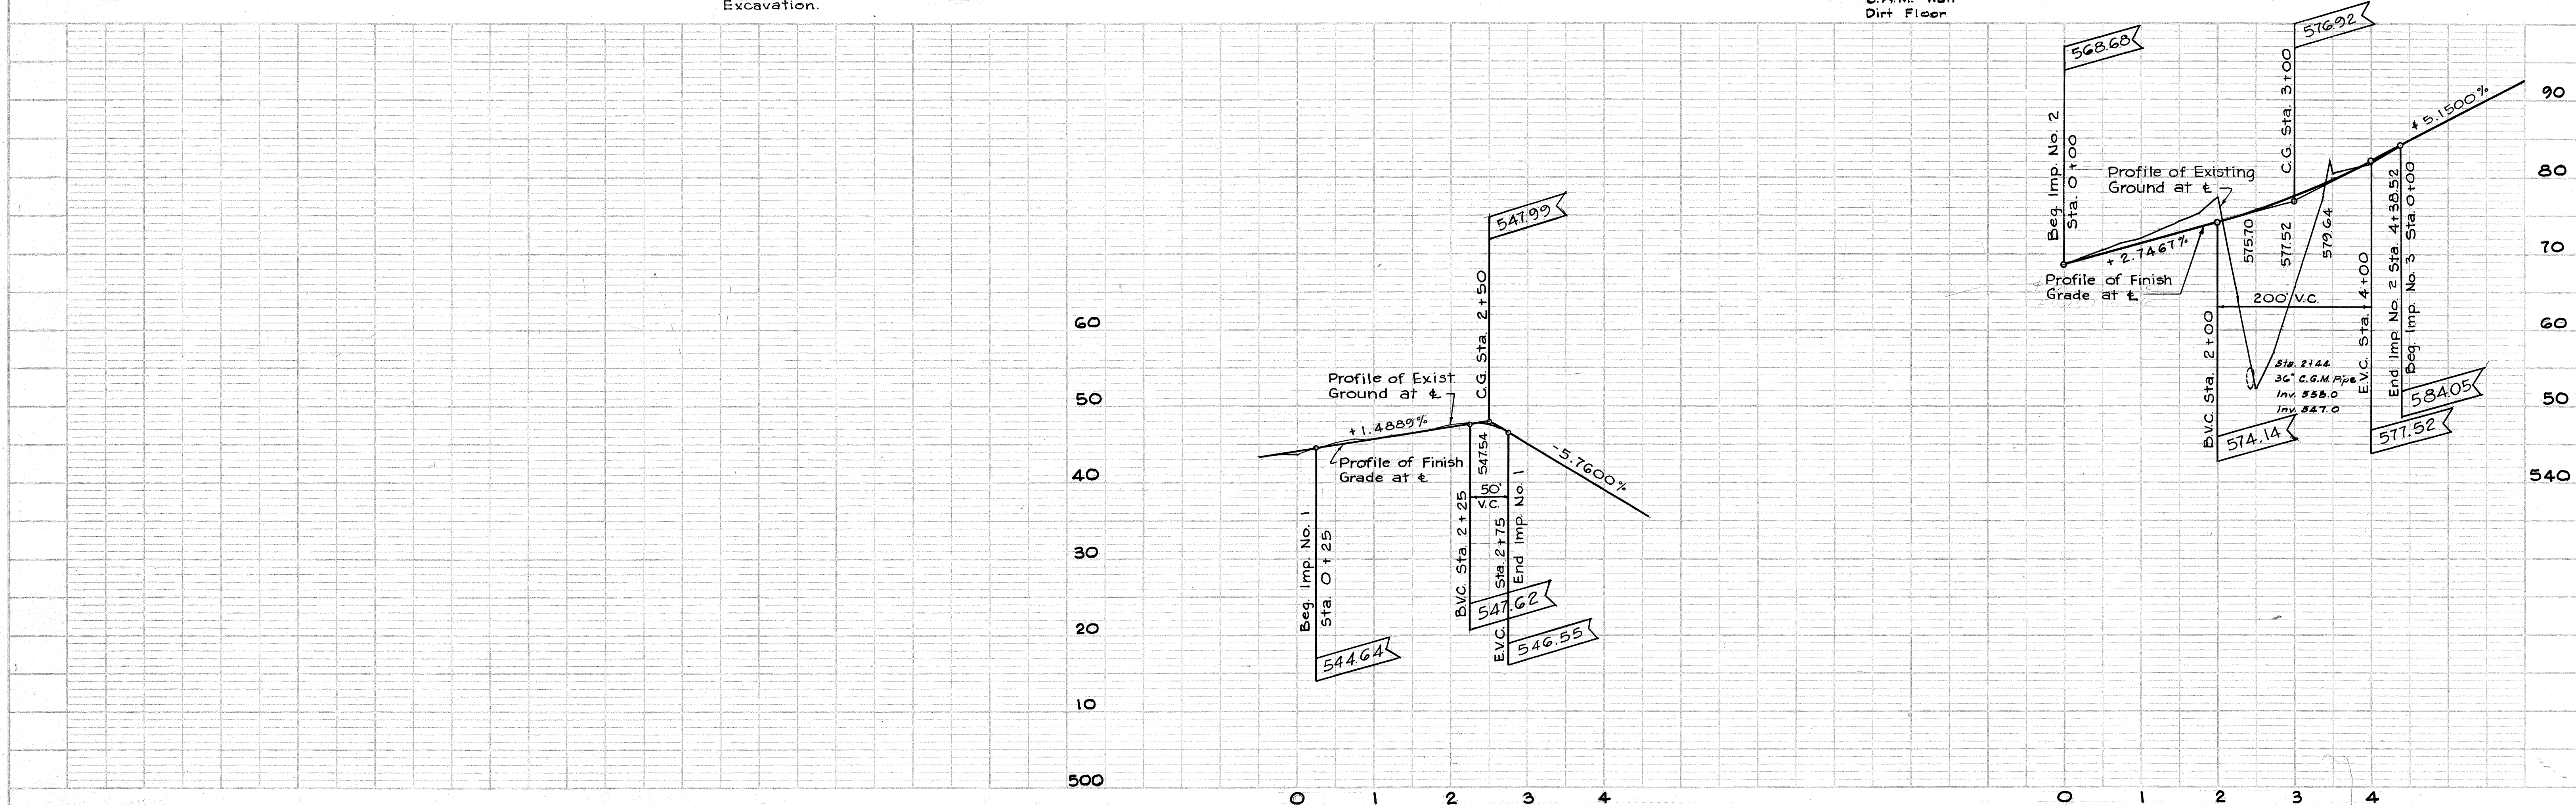

PLAN	SURVEYED	BY	DATE
	PLOTTED		
NOTE BOOK	ALIGNMENT CHECKED		
NO.	RT. OF WAY CHECKED		

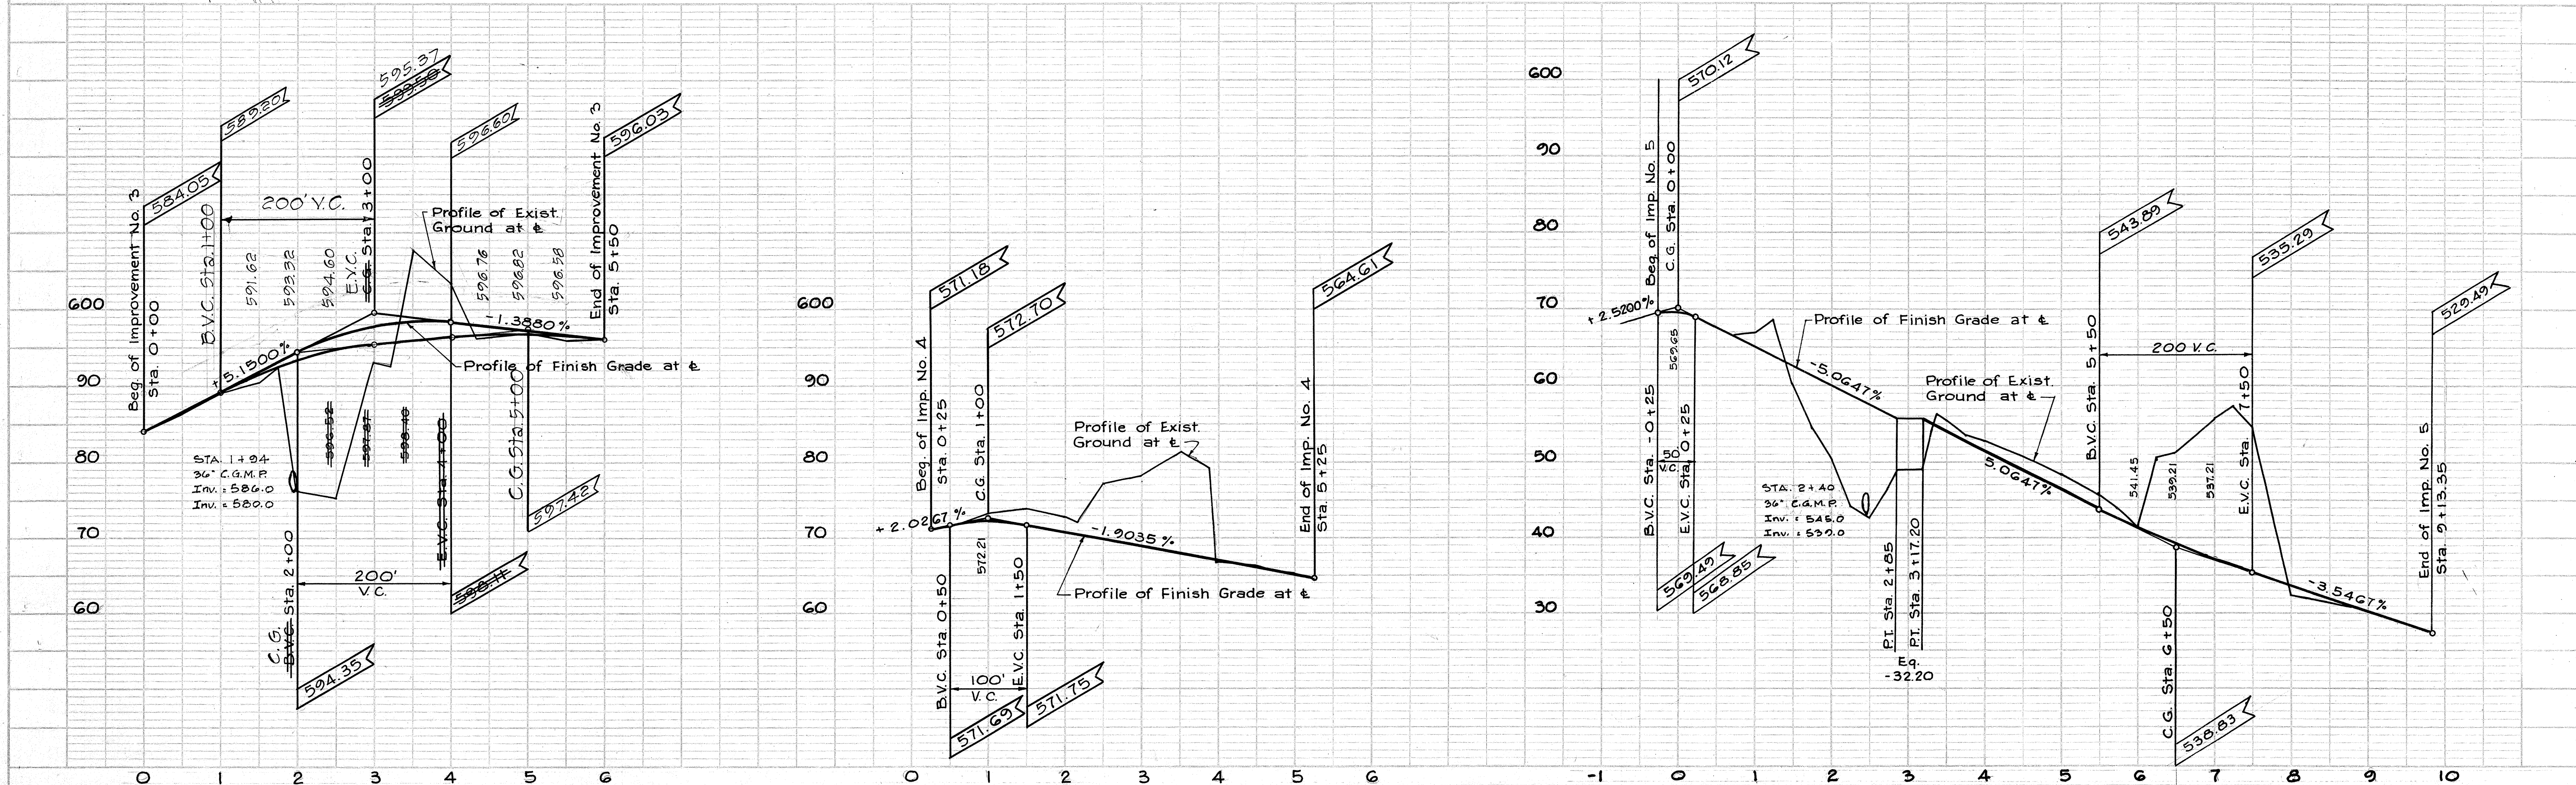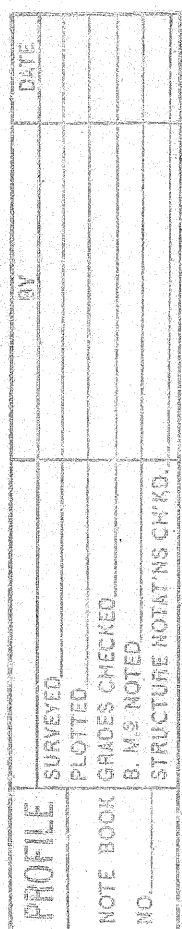

PROFILE	SURVEYED	BY	DATE
NOTE BOOK	PLOTTED		
INC.	GRACES CHECKED		
	B. M. & NOTED		
	STRUCTURE NOTATIONS CH'VD		