


FED. ROAD DIST. NO.	STATE	PROJ. NO.	FISCAL YEAR	SHEET NO.	TOTAL SHEETS
HAWAII	HAW.	C-360-01-63	1966	7	18

INDEX TO DRAWINGS	
SHEET NO	DESCRIPTION
1	TITLE SHEET
2	TYPICAL SECTION
3-6	PLAN & PROFILE
7-8	STANDARD DETAILS
9-18	CROSS SECTIONS

STATE OF HAWAII
DEPARTMENT OF TRANSPORTATION
HIGHWAYS DIVISION
HONOLULU, HAWAII
"AS BUILT"
PLANS FOR IMPROVING PORTIONS OF
HANA BELT ROAD
WAIPIO-KAILUA SECTION
PROJECT NO. C-360-01-63

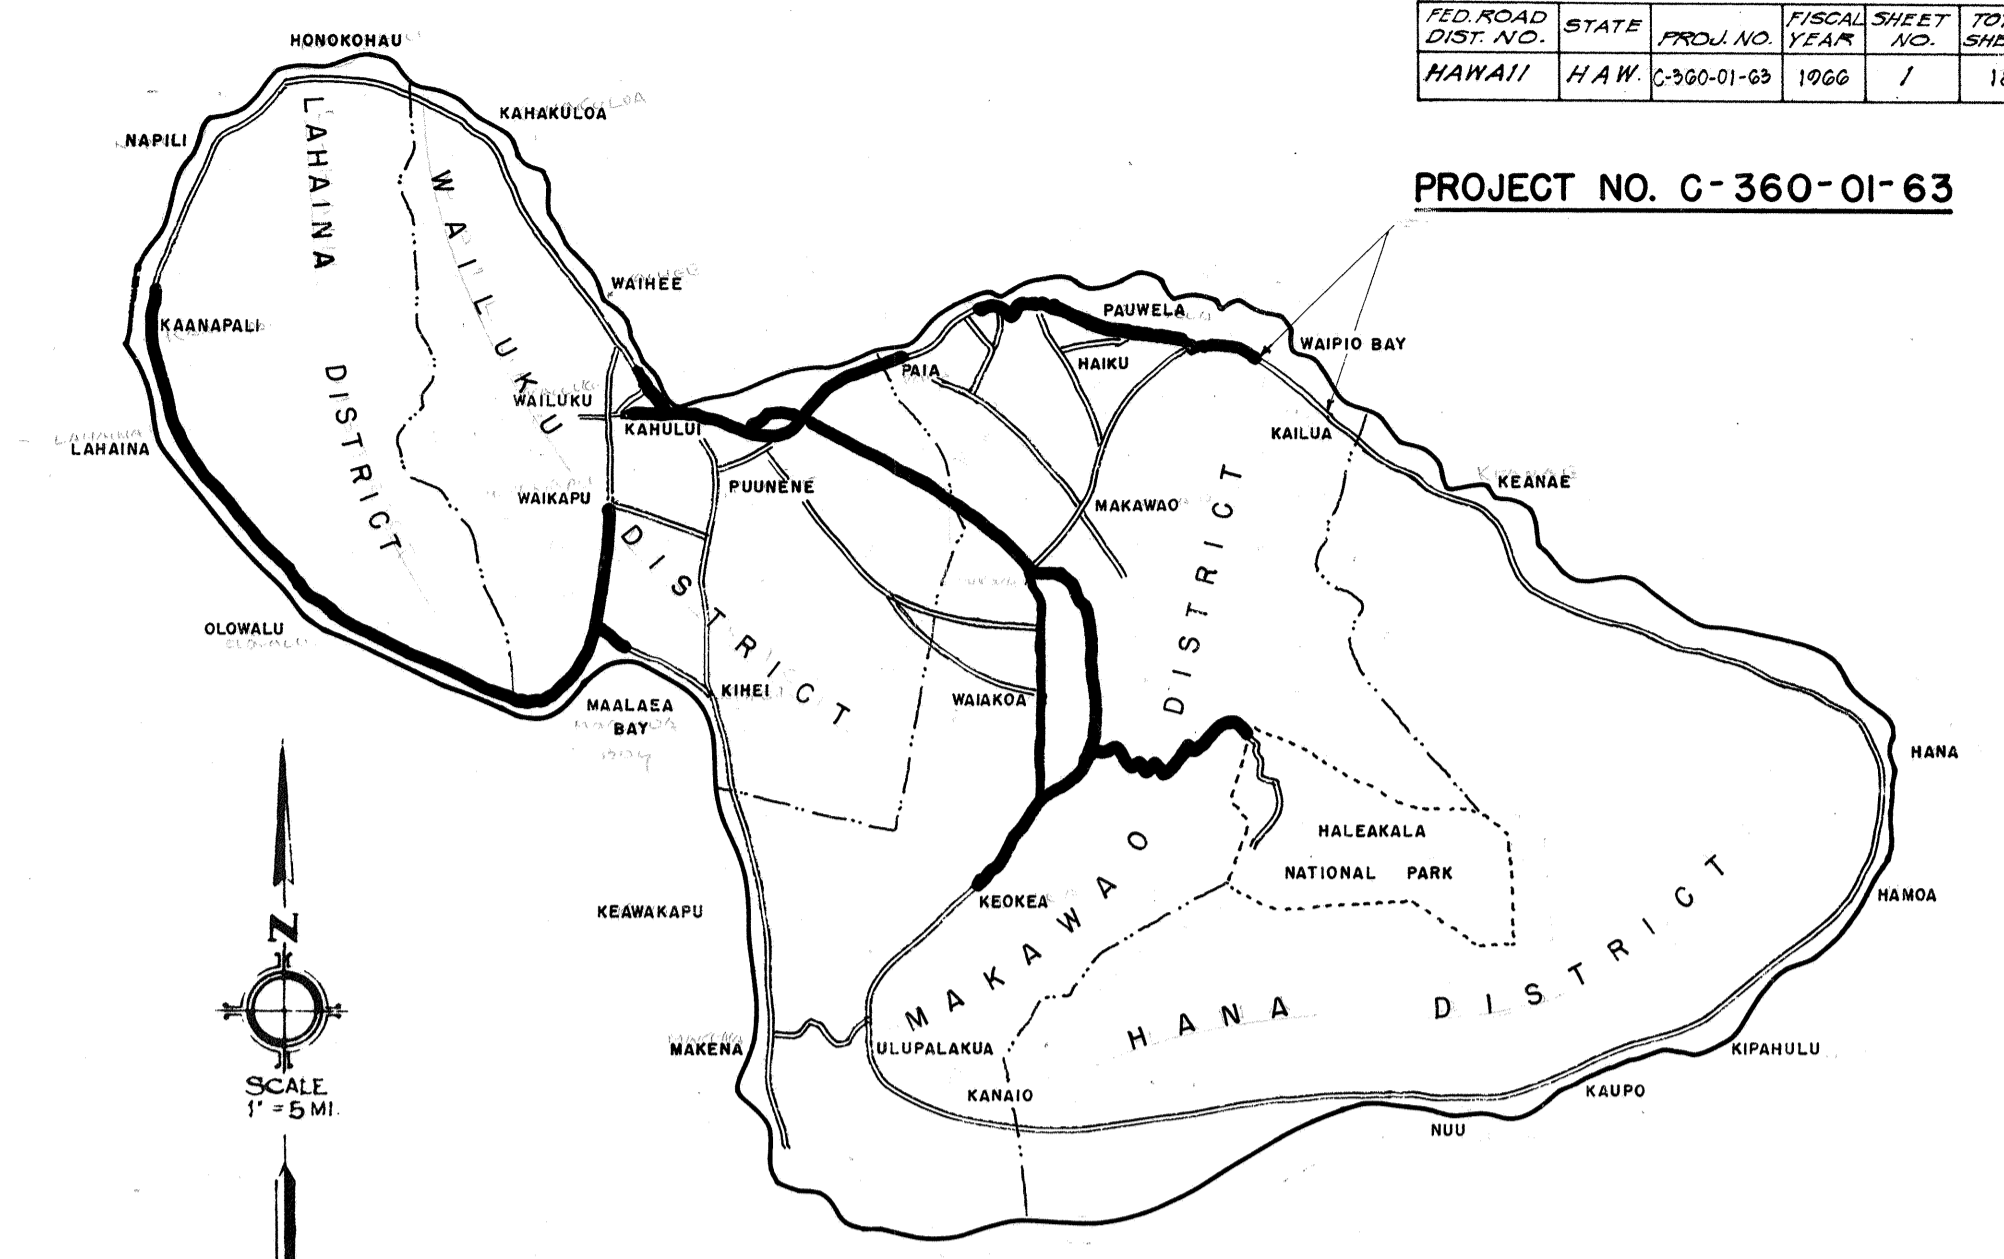

LOCATION MAP
Federal Aid Projects previously constructed or under construction.

CONVENTIONAL SIGNS


Centerline	
Boundary Lines	
Fences (Named)	
Existing Roadways	
Circular Culvert	
Box Culvert	
Bridge	
Telephone Pole	
Electric Power Pole	
Water Main	
Storm Drain	
Concrete Drop Intake	
Standard Catch Basin	
Standard Manhole	
Sewer Manhole	
Telephone Manhole	
Fire Hydrant	
Trees (Named)	
Railroad	
Location of Improvement	

MAKAWAO DISTRICT
ISLAND OF MAUI
SCALE

PLAN 1 IN. = 100 FT.
PROFILE HOR. 1 IN. = 100 FT.
VER. 1 IN. = 10 FT.
X-SECTIONS HOR. 1 IN. = 10 FT.
VER. 1 IN. = 10 FT.

NOTE:
ALL CHANGES MADE DURING CONSTRUCTION
HAVE BEEN NOTED IN RED ON THESE
TRACINGS AND CHECKED BY:

Patrick Muehlan
PROJECT ENGINEER
5/23/68
DATE

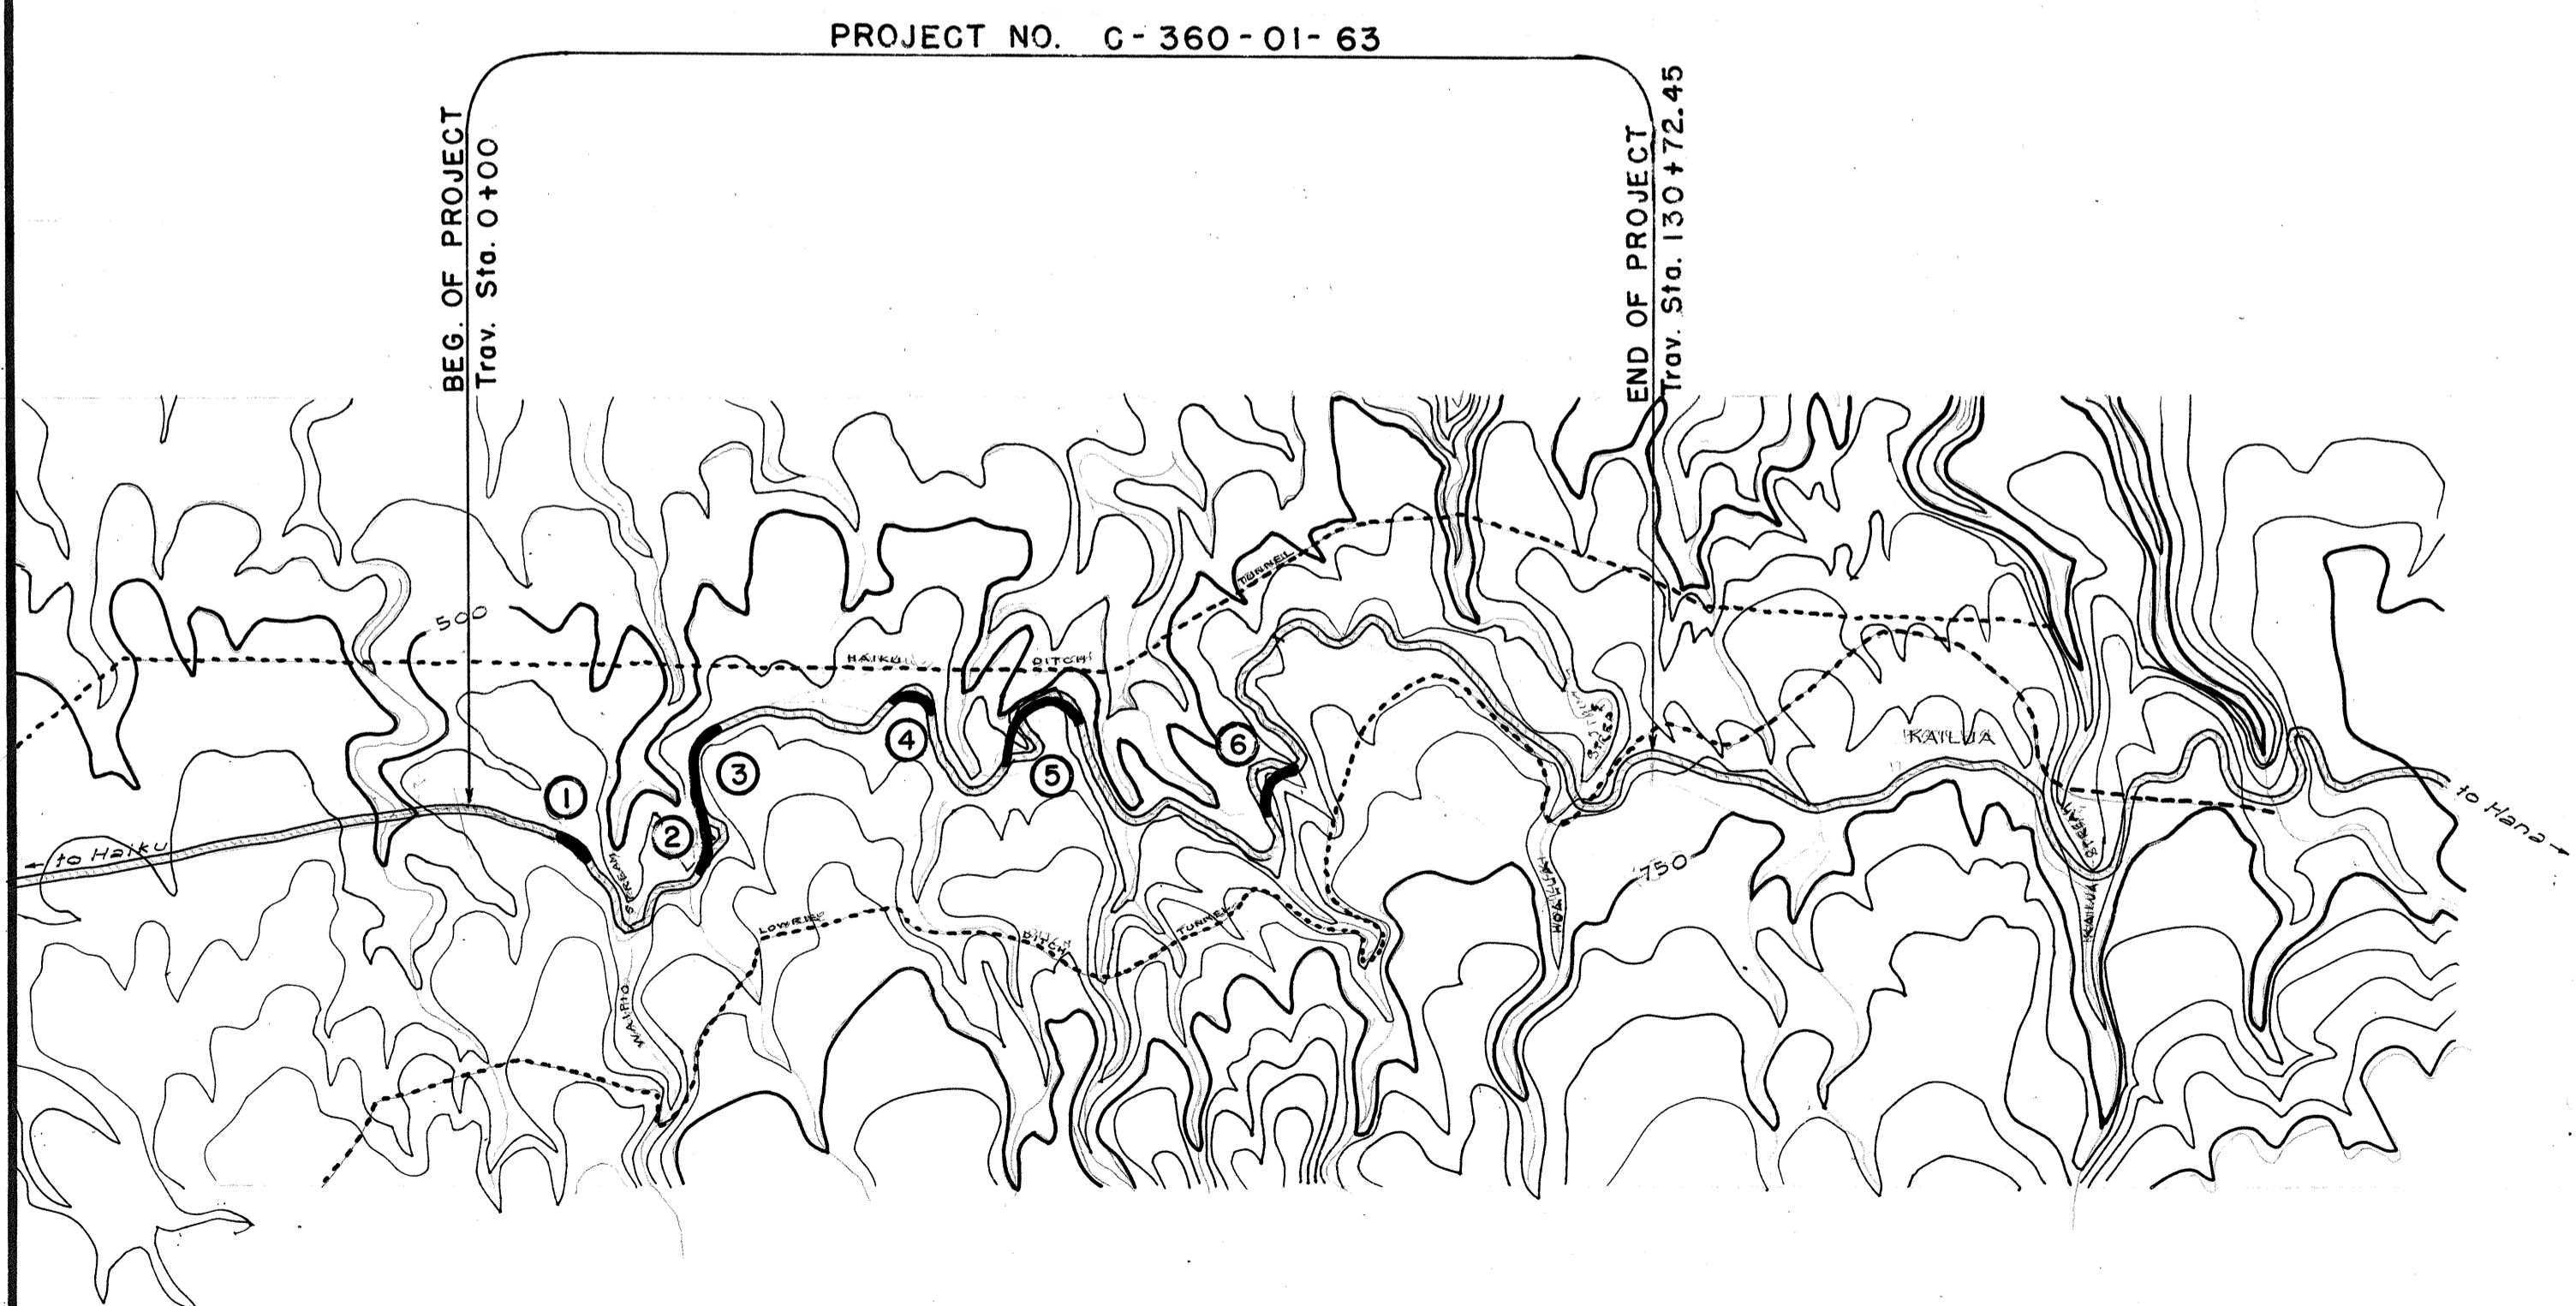

LAYOUT OF PROJECT
Scale: 1" = 1000'
GROSS LENGTH OF PROJECT = 2.476 Miles
NET LENGTH OF PROJECT = 0.568 Miles

APPROVED: DATE 4-12-66
John M. Sun
DIRECTOR OF TRANSPORTATION

DATE: 4-12-66
PROJECT ENGINEER: Patrick Muehlan
CHECKED BY: [Signature]
DRAWN BY: [Signature]
SCALE: 1" = 1000'