	INDEX TO DRAWINGS
SHEET NO.	DESCRIPTION
ļ	TITLE SHEET
	PLAN, PROFILE & TYPICAL SEC-
•	TION OF THE RECONSTRUCTION
2	OF APPROACHES TO HONOMA-
	NU BRIDGE
3	HONOMANU BRIDGE REPAIR
4-9	CONSTRUCTION SIGNING PLAN
,	& DETAILS
·	
,	



STATE OF HAWAII

DEPARTMENT OF TRANSPORTATION LAND TRANSPORTATION FACILITIES DIVISION

"AS-BUILT"

PLANS FOR


HANA HIGHWAY

HONOMANU BRIDGE REPAIR

PROJECT NO. 360AB-02-78

DISTRICT OF HANA

ISLAND OF MAUL

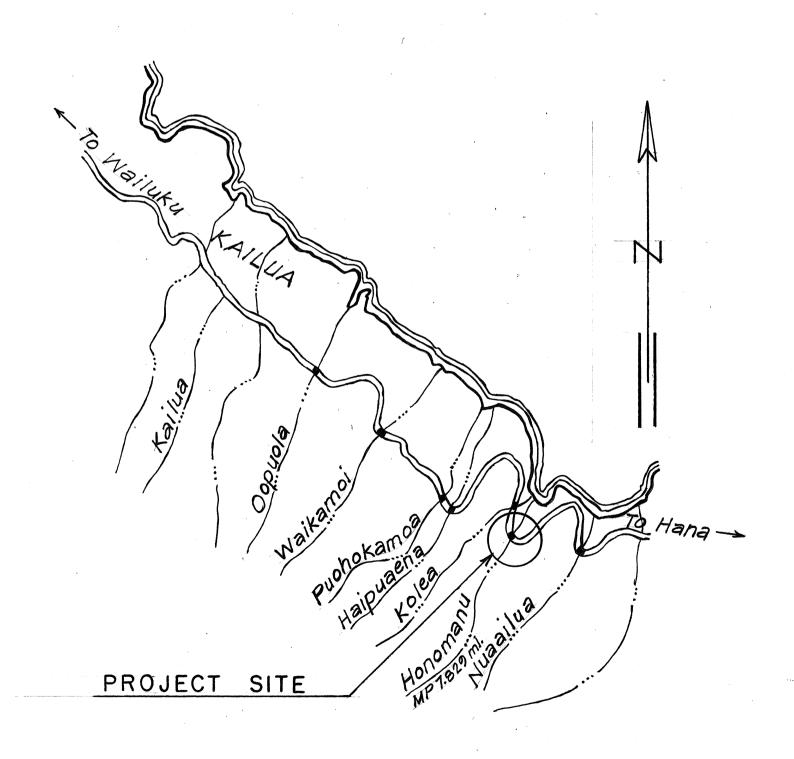


LOCATION PLAN

SCALE: I" = I MILE

FED. ROAD DIST. NO. STATE FED. AID PROJ. NO. FISCAL SHEET TOTAL SHEETS

HAWAII HAW. 360AB-02-78 1978 1 9

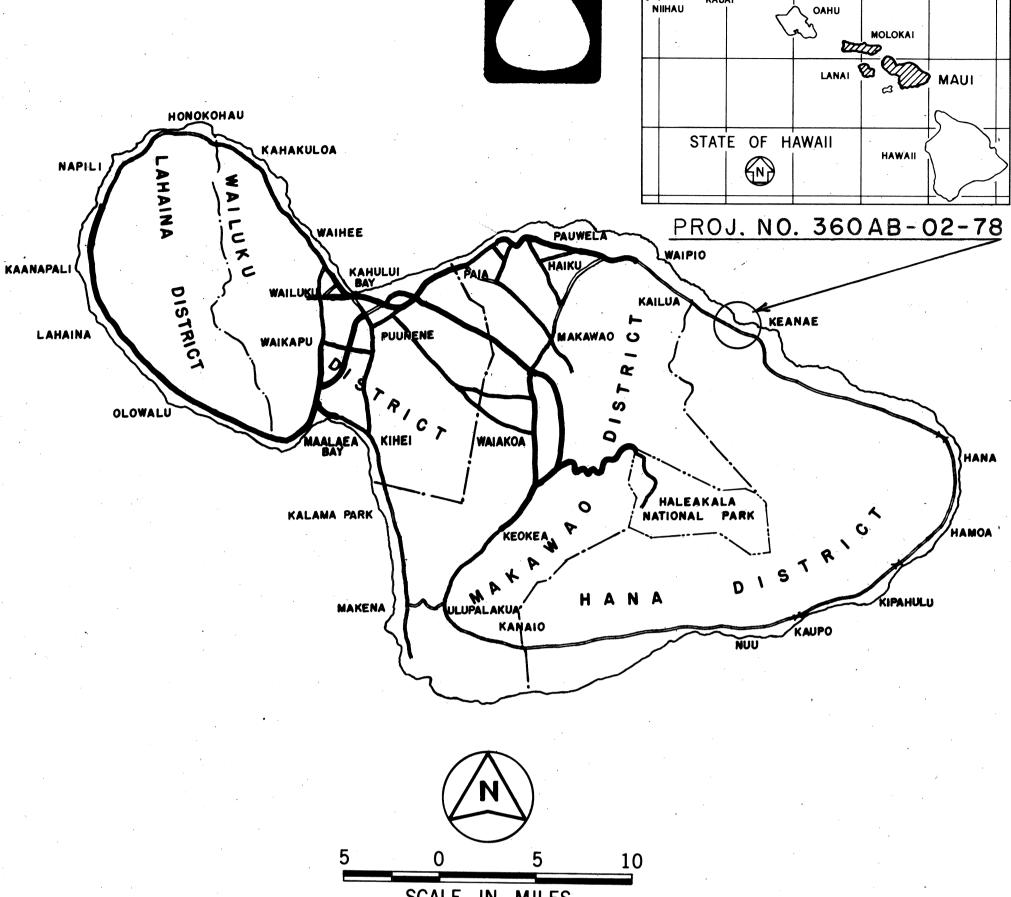

FEDERAL AID PROJECTS PREVIOUSLY CONSTRUCTED OR UNDER CONSTRUCTION

NOTE:

ALL CHANGES MADE DURING CONSTRUCTION HAVE BEEN NOTED IN RED ON THESE TRACINGS AND CHECKED BY

Leonge M. Kaya RESIDENT ENGINEER

8/15/79 DATE

DEPARTMENT OF TRANSPORTATION STATE OF HAWAII

APPROVED:

Ryskiele Higashionna 7/ DIR. OF TRANSFORTATION DA

| 548-7456 JUNE, 1976 E. BY PHONE DATE

GNED BY P S & F BY