



FED. ROAD DIST. NO.	STATE	PROJ. NO.	FISCAL YEAR	SHEET NO.	TOTAL SHEETS
HAWAII	HAW.	360B-01-80	1980	6	28

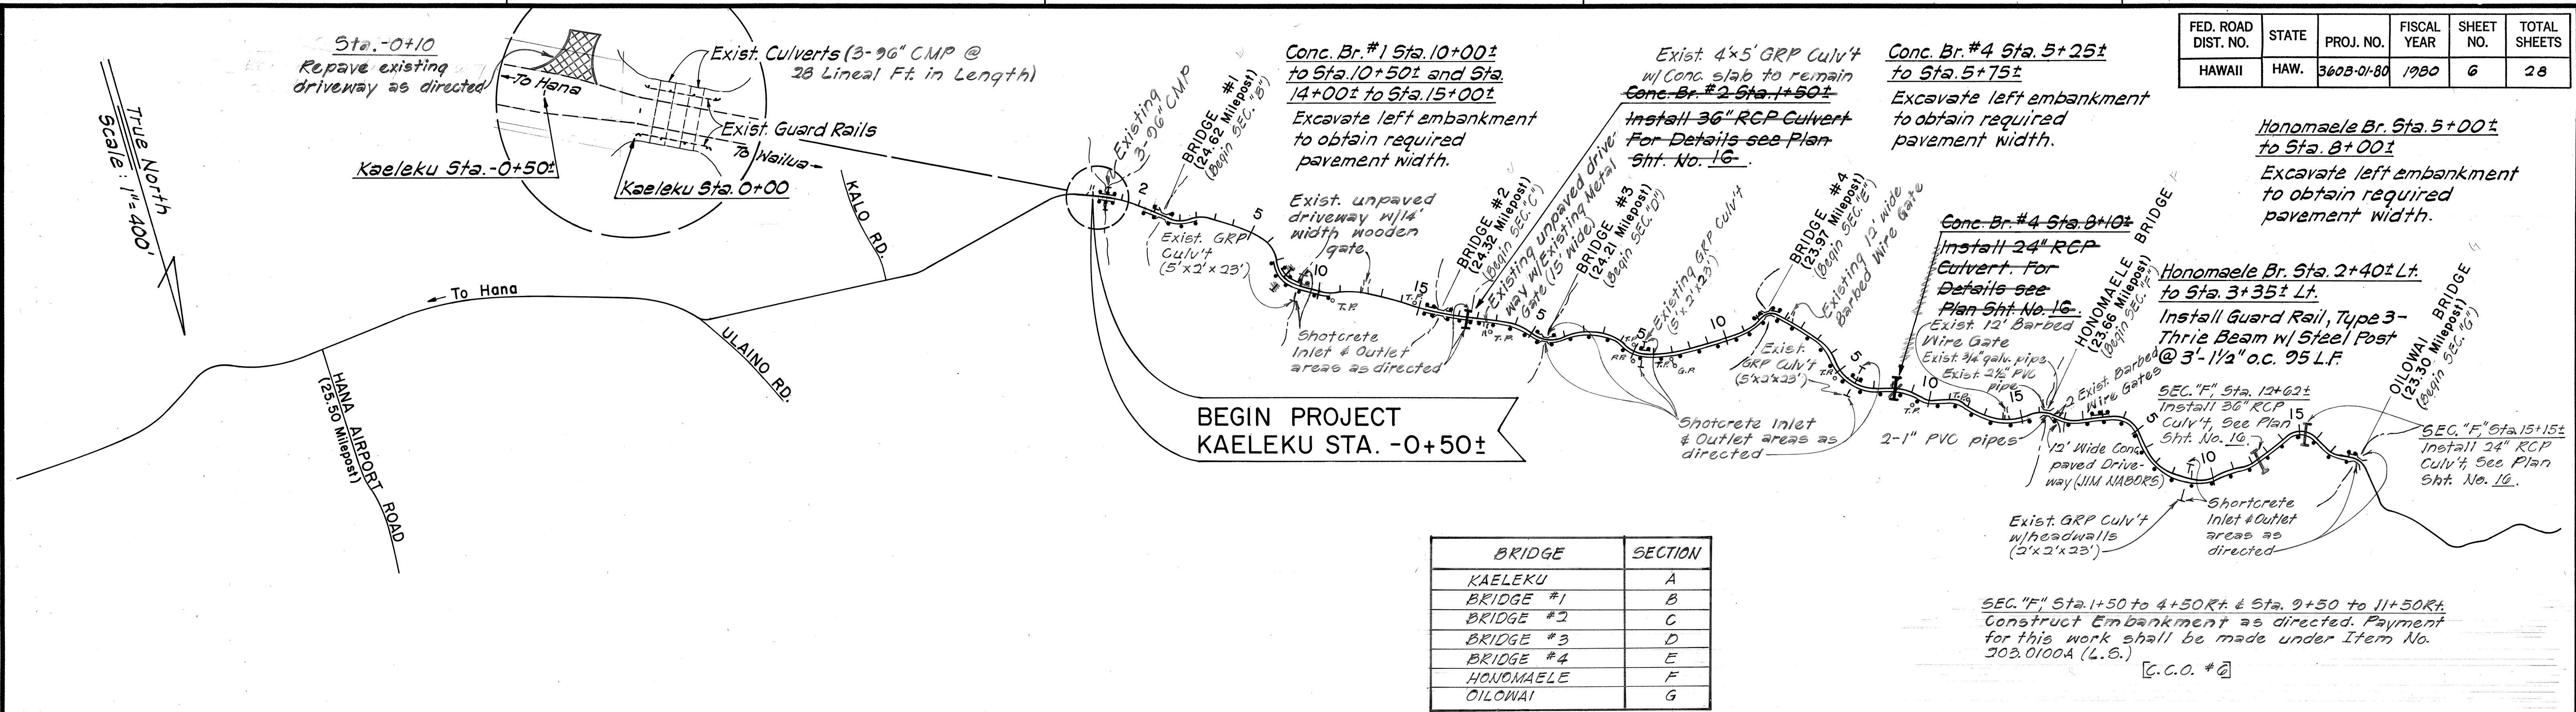

BRIDGE	SECTION
KAELEKU	A
BRIDGE #1	B
BRIDGE #2	C
BRIDGE #3	D
BRIDGE #4	E
HONOMAELE	F
OLOWAI	G

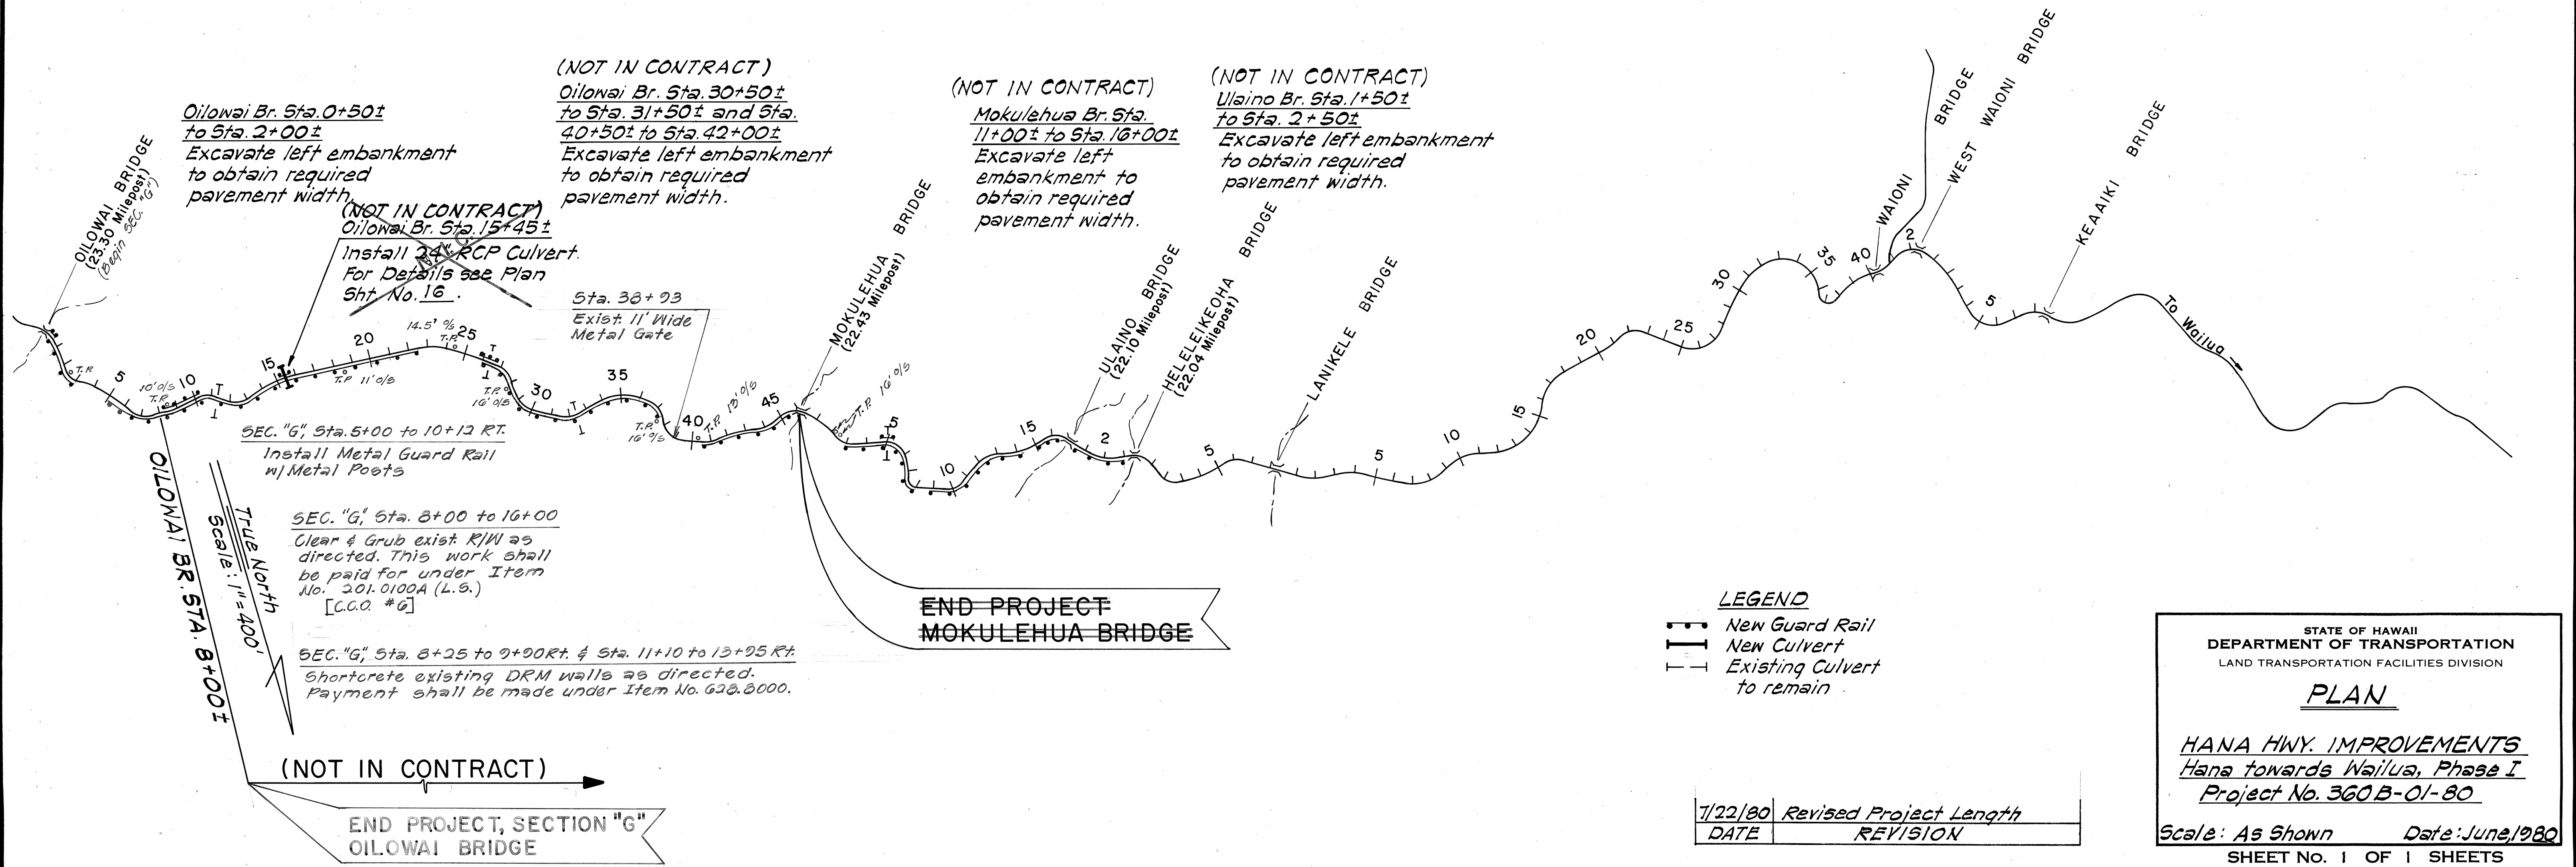

STATE OF HAWAII
DEPARTMENT OF TRANSPORTATION
LAND TRANSPORTATION FACILITIES DIVISION

PLAN

HANA HWY. IMPROVEMENTS

Hana towards Wailua, Phase I

Project No. 360B-01-80

Scale: As Shown Date: June, 1980

SHEET NO. 1 OF 1 SHEETS

DATE	REVISION
7/22/80	Revised Project Length