

[illegible]

STATE OF HAWAII

DEPARTMENT OF TRANSPORTATION  
HIGHWAYS DIVISION


"AS-BUILT" PLANS FOR  
**HANA HIGHWAY IMPROVEMENTS**  
**HANA TOWARDS WAILUA, PHASE I**  
PROJECT NO. 360B-01-80

DISTRICT OF HANA  
ISLAND OF MAUI

ALL CHANGES MADE DURING CONSTRUCTION HAVE BEEN INCORPORATED ON THESE PLANS IN RED EXCEPT CHANGES IN THE ORIGINAL THEORETICAL QUANTITIES. FOR ACTUAL QUANTITIES, REFER TO PROJECT LEDGER AND/OR COMPUTATION BOOK.

*Lloyd P. Wozze*  
RESIDENT ENGINEER

5-26-83  
DATE

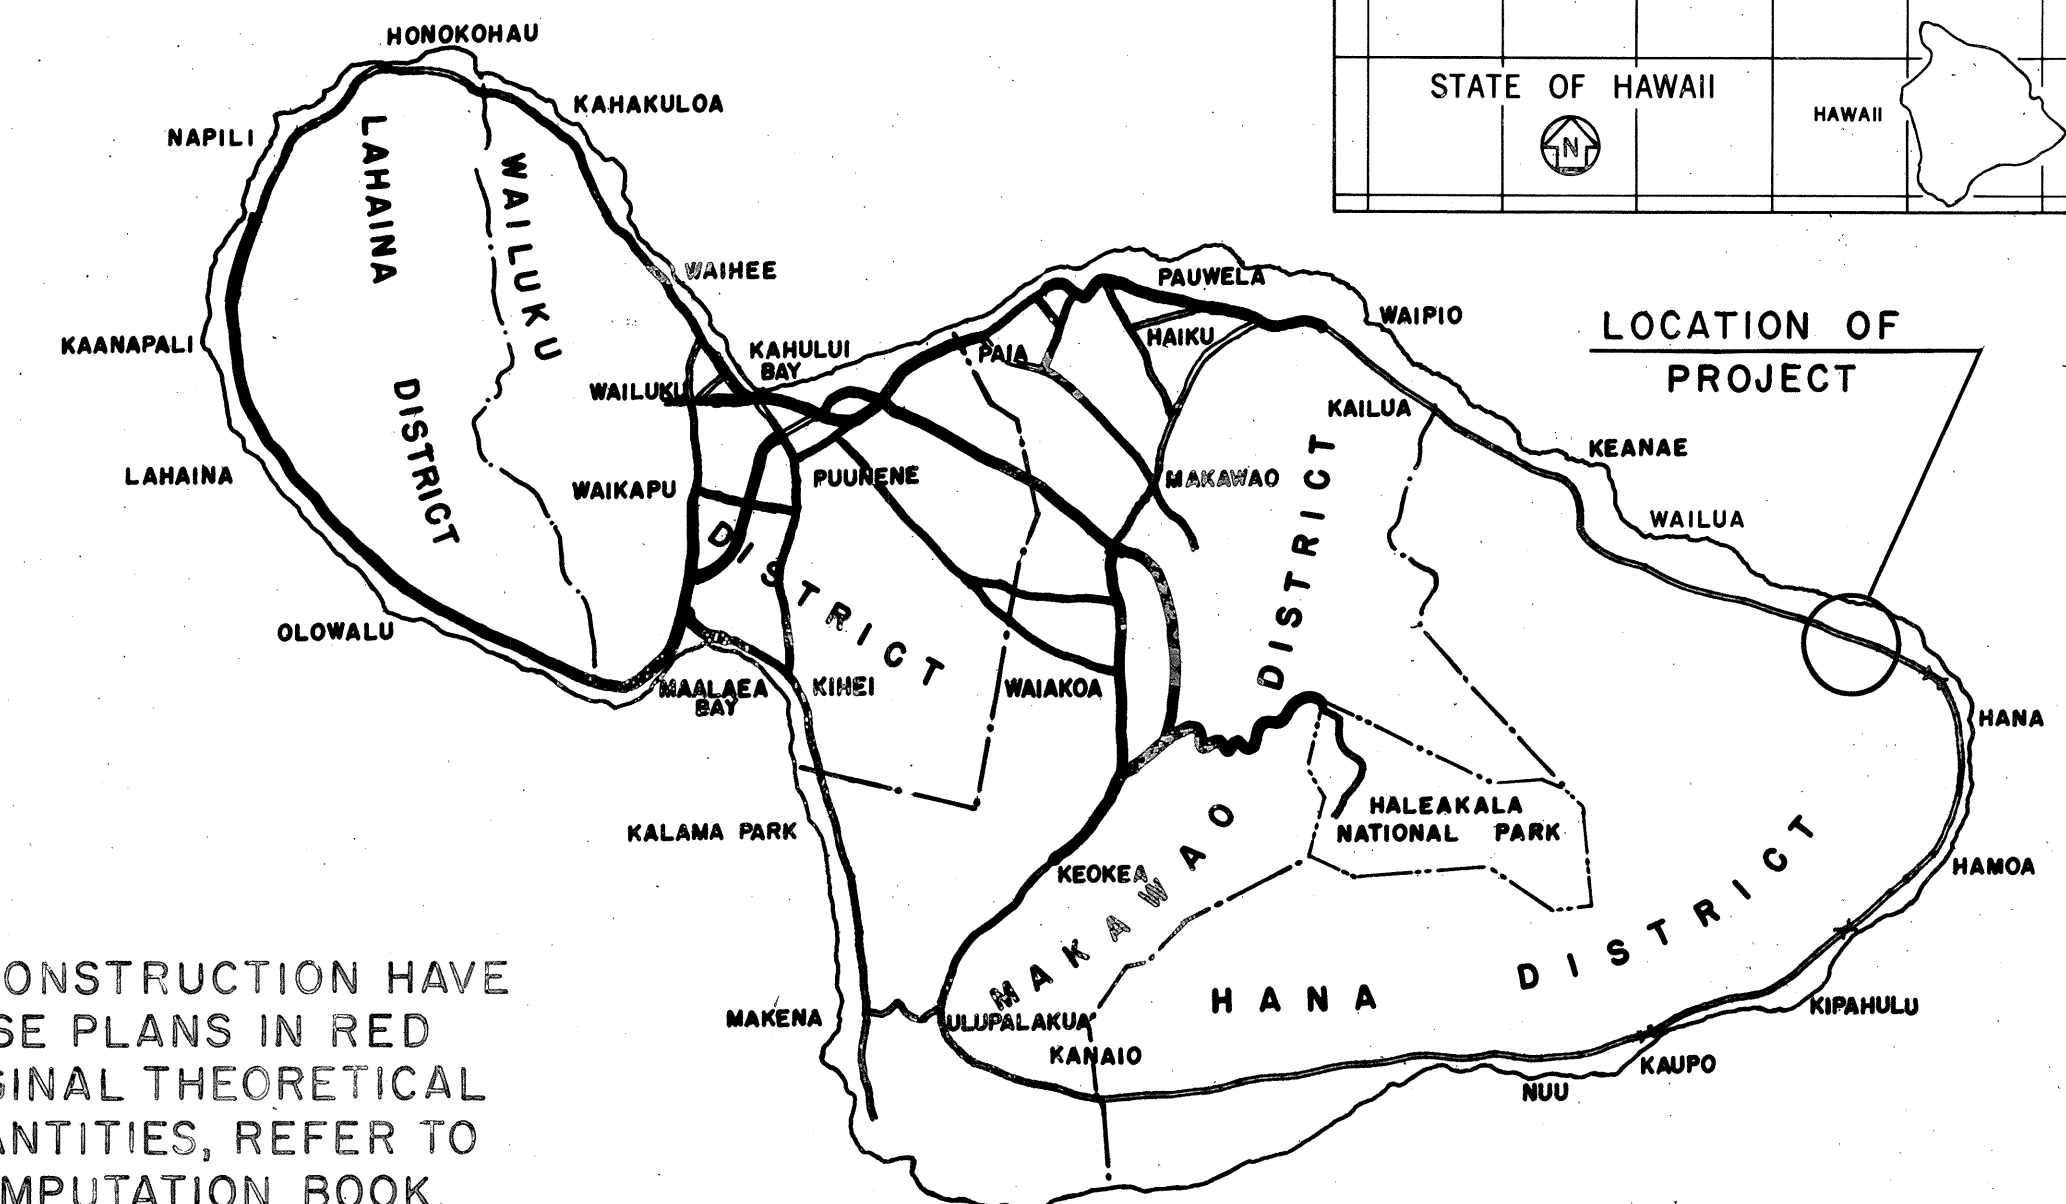


5 0 5 10

SCALE IN MILES

FEDERAL AID PROJECTS PREVIOUSLY CONSTRUCTED  
OR UNDER CONSTRUCTION

**BEGIN PROJECT**  
KAELEKU STA. (-)0+50

END PROJECT  
~~MOKULEHUA~~ BRIDGE STA.8+00  
OILWAI

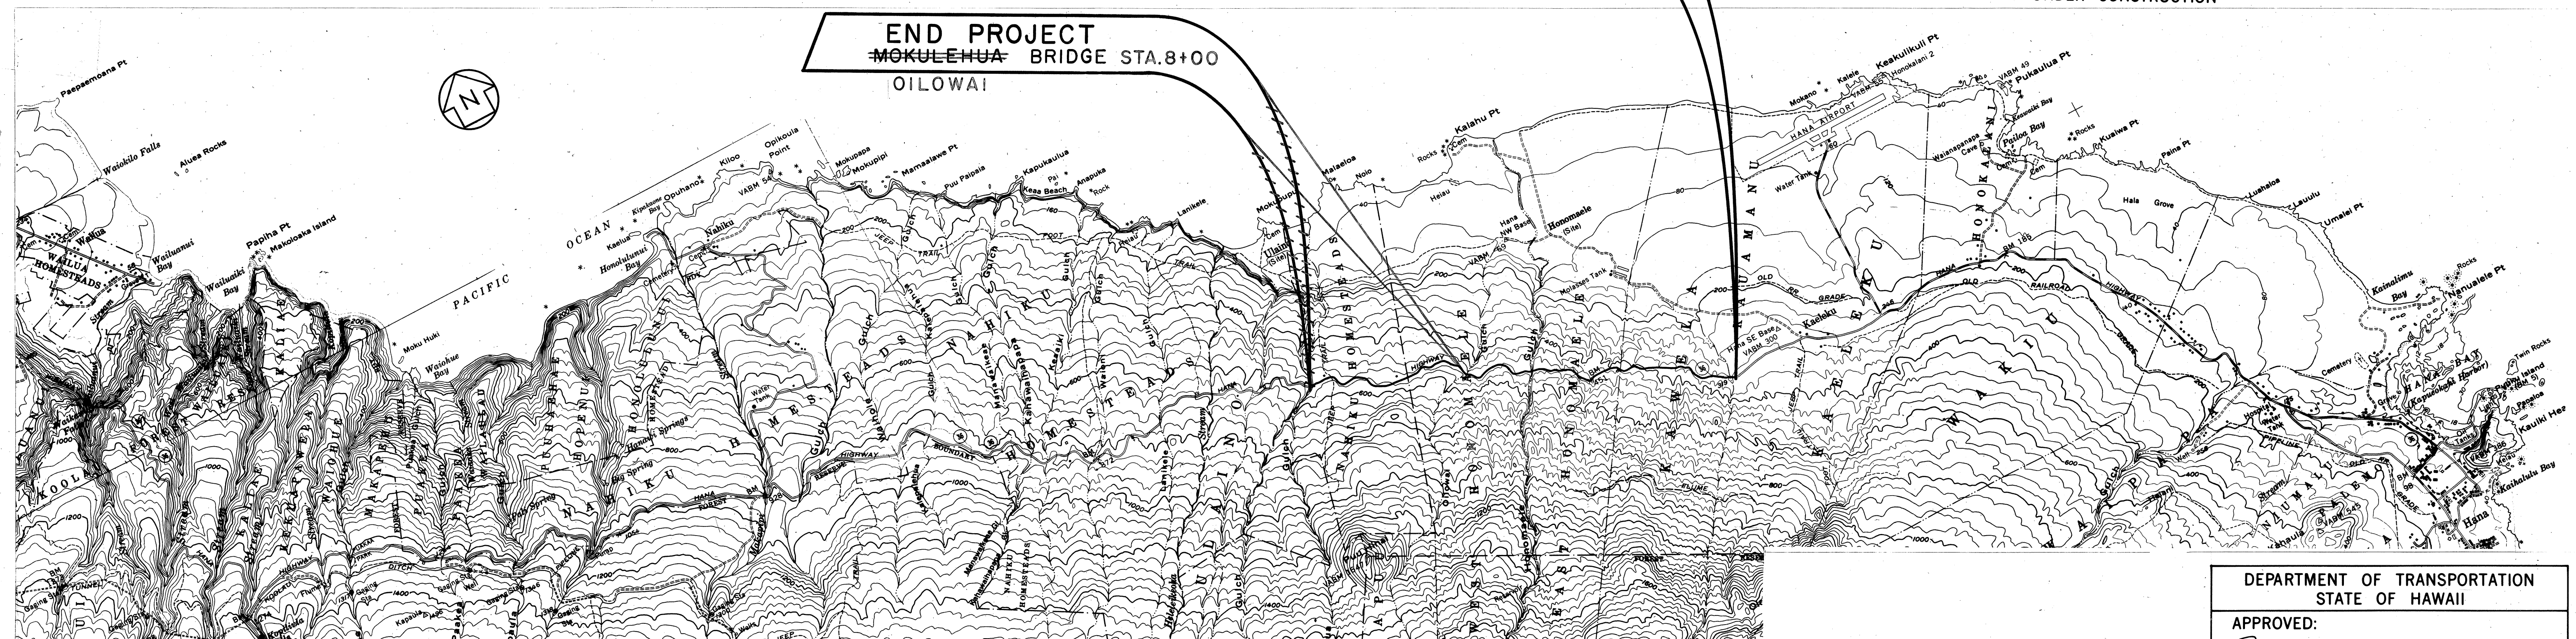

## LAYOUT PLAN

LENGTH OF PROJECT.....<sup>1.55</sup>~~2.26~~ MILES

DEPARTMENT OF TRANSPORTATION  
STATE OF HAWAII

APPROVED: James R. Carras 6/6/80  
DIR. OF TRANSPORTATION DATE

R. Tsuzuki P. S. & E. BY 548-2456 May, 1980  
DESIGNED BY PHONE DATE