	INDEX TO DRAWINGS
SHEET NO.	DESCRIPTION
	TITLE SHEET
2	PLAN, PROFILE AND DETAILS
3-5	STANDARD DETAILS
}	
¥f	

AUG. 1981 DATE

548 - 2456 PHONE



STATE OF HAWAII


DEPARTMENT OF TRANSPORTATION HIGHWAYS DIVISION

HONOLULU, HAWAII

PLANS FOR


HANA HIGHWAY DRAINAGE IMPROVEMENTS AT HANA TOWN PROJECT NO. 360B-01-81

DISTRICT OF HANA
ISLAND OF MAUI

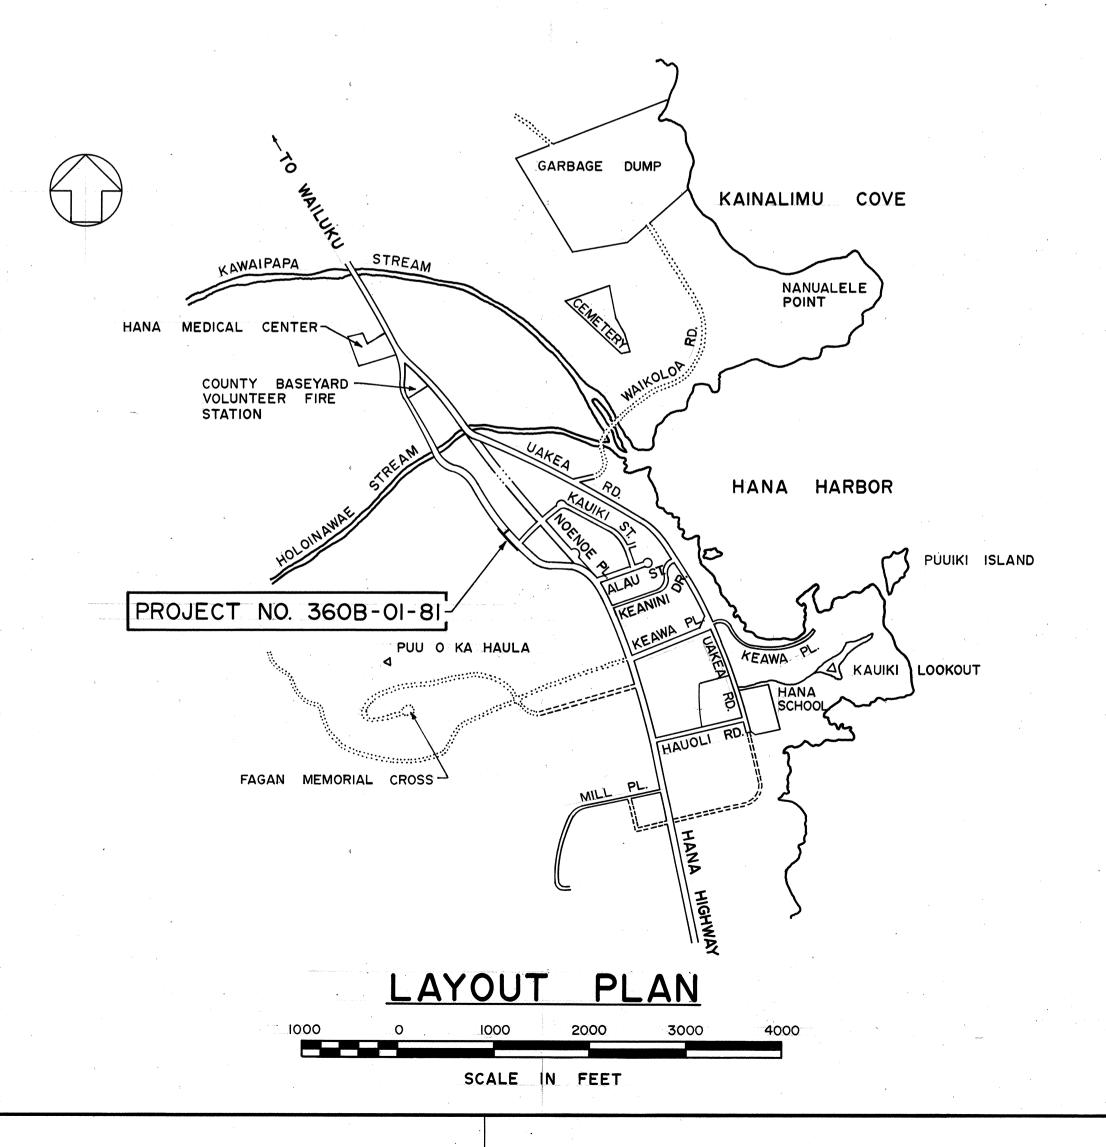

FED. ROAD DIST. NO. STATE PROJ. NO. FISCAL SHEET TOTAL YEAR NO. SHEETS

HAWAII HAW. 360B-01-81 1982 1 5

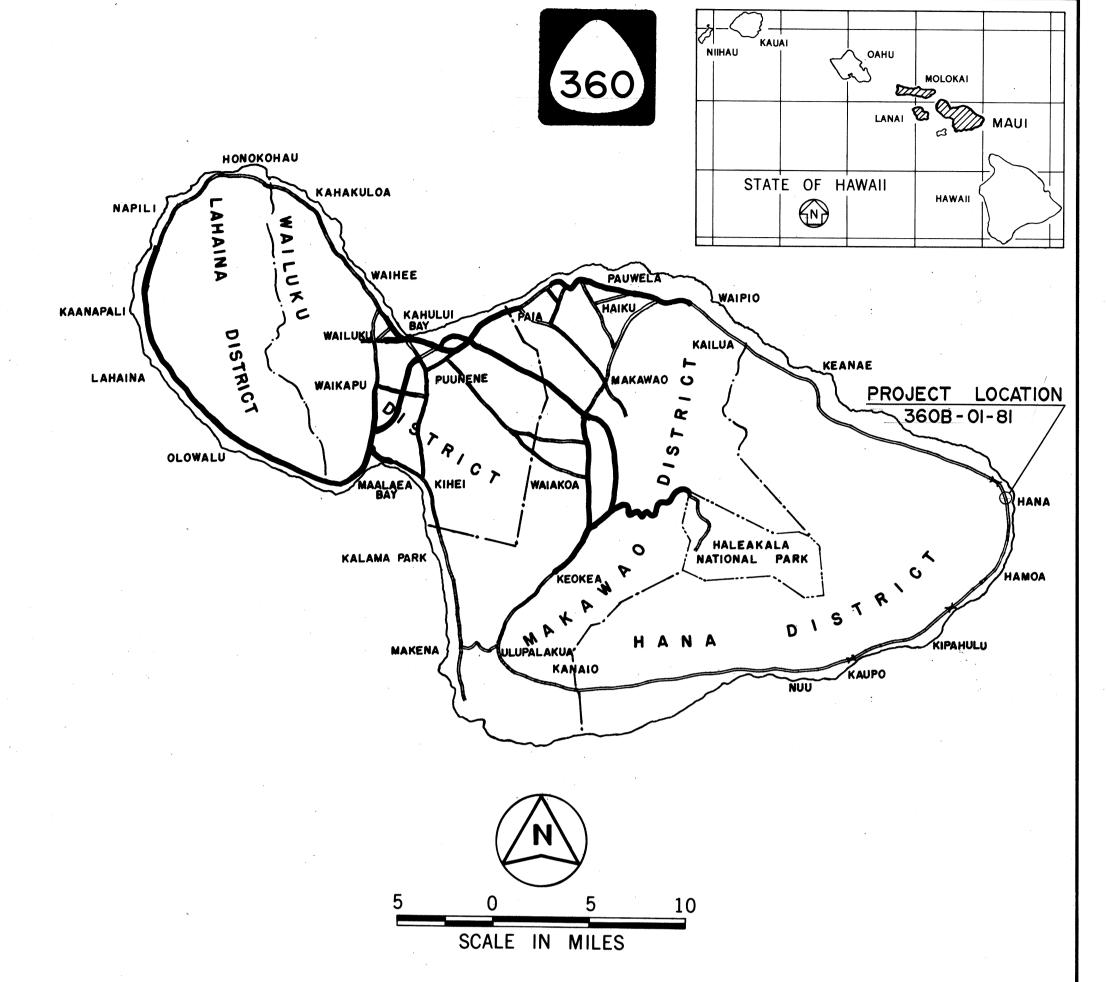

FEDERAL AID PROJECTS PREVIOUSLY CONSTRUCTED OR UNDER CONSTRUCTION

ALL CHANGES MADE DURING CONSTRUCTION HAVE BEEN INCORPORATED ON THESE PLANS IN RED EXCEPT CHANGES IN THE ORIGINAL THEORETICAL QUANTITIES. FOR ACTUAL QUANTITIES, REFER TO PROJECT LEDGER AND/OR COMPUTATION BOOK.

Jary & Baker RESIDENT ENGINEER

5/5/82 DATE

DEPARTMENT OF TRANSPORTATION
STATE OF HAWAII

APPROVED:

Sames R. Carras 10/5/8/
SpDIR. OF TRANSPORTATION DATE

1 12.0.2.1