


[illegible]

- (a) 13S-1 & 13S-2
(b) 14S-1, 14S-2 & 15S-1
(c) 26S-1 & 26S-2

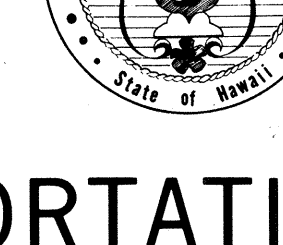

STATE OF HAWAII

DEPARTMENT OF TRANSPORTATION

HIGHWAYS DIVISION

"AS-BUILT"

PLANS FOR

HANA HIGHWAY IMPROVEMENTS

HUELO TOWARDS WAILUA, PHASE II

PROJECT NO. 360A-01-82


AND

HANA HIGHWAY RESURFACING

HUELO TO HONOMANU BAY

PROJECT NO. 360A-01-83M


FED. ROAD DIST. NO.	STATE	PROJ. NO.	FISCAL YEAR	SHEET NO.	TOTAL SHEETS
HAWAII	HAW.	360A-01-82 360A-01-83M	1982	1	36

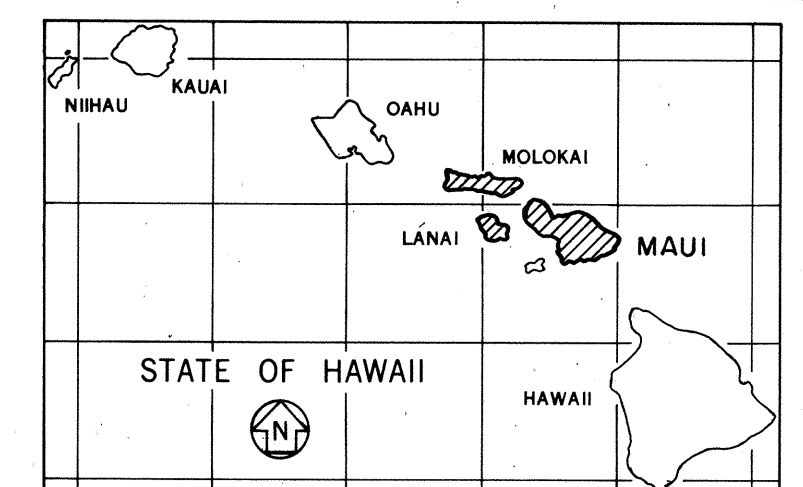

5 0 5 10
SCALE IN MILES

CHANGES MADE DURING CONSTRUCTION HAVE BEEN INCORPORATED ON THESE PLANS EXCEPT CHANGES IN THE ORIGINAL THEORETICAL QUANTITIES. FOR ACTUAL QUANTITIES, REFER TO PROJECT LEDGER AND/OR COMPUTATION BOOK.

10/24/83
DATE

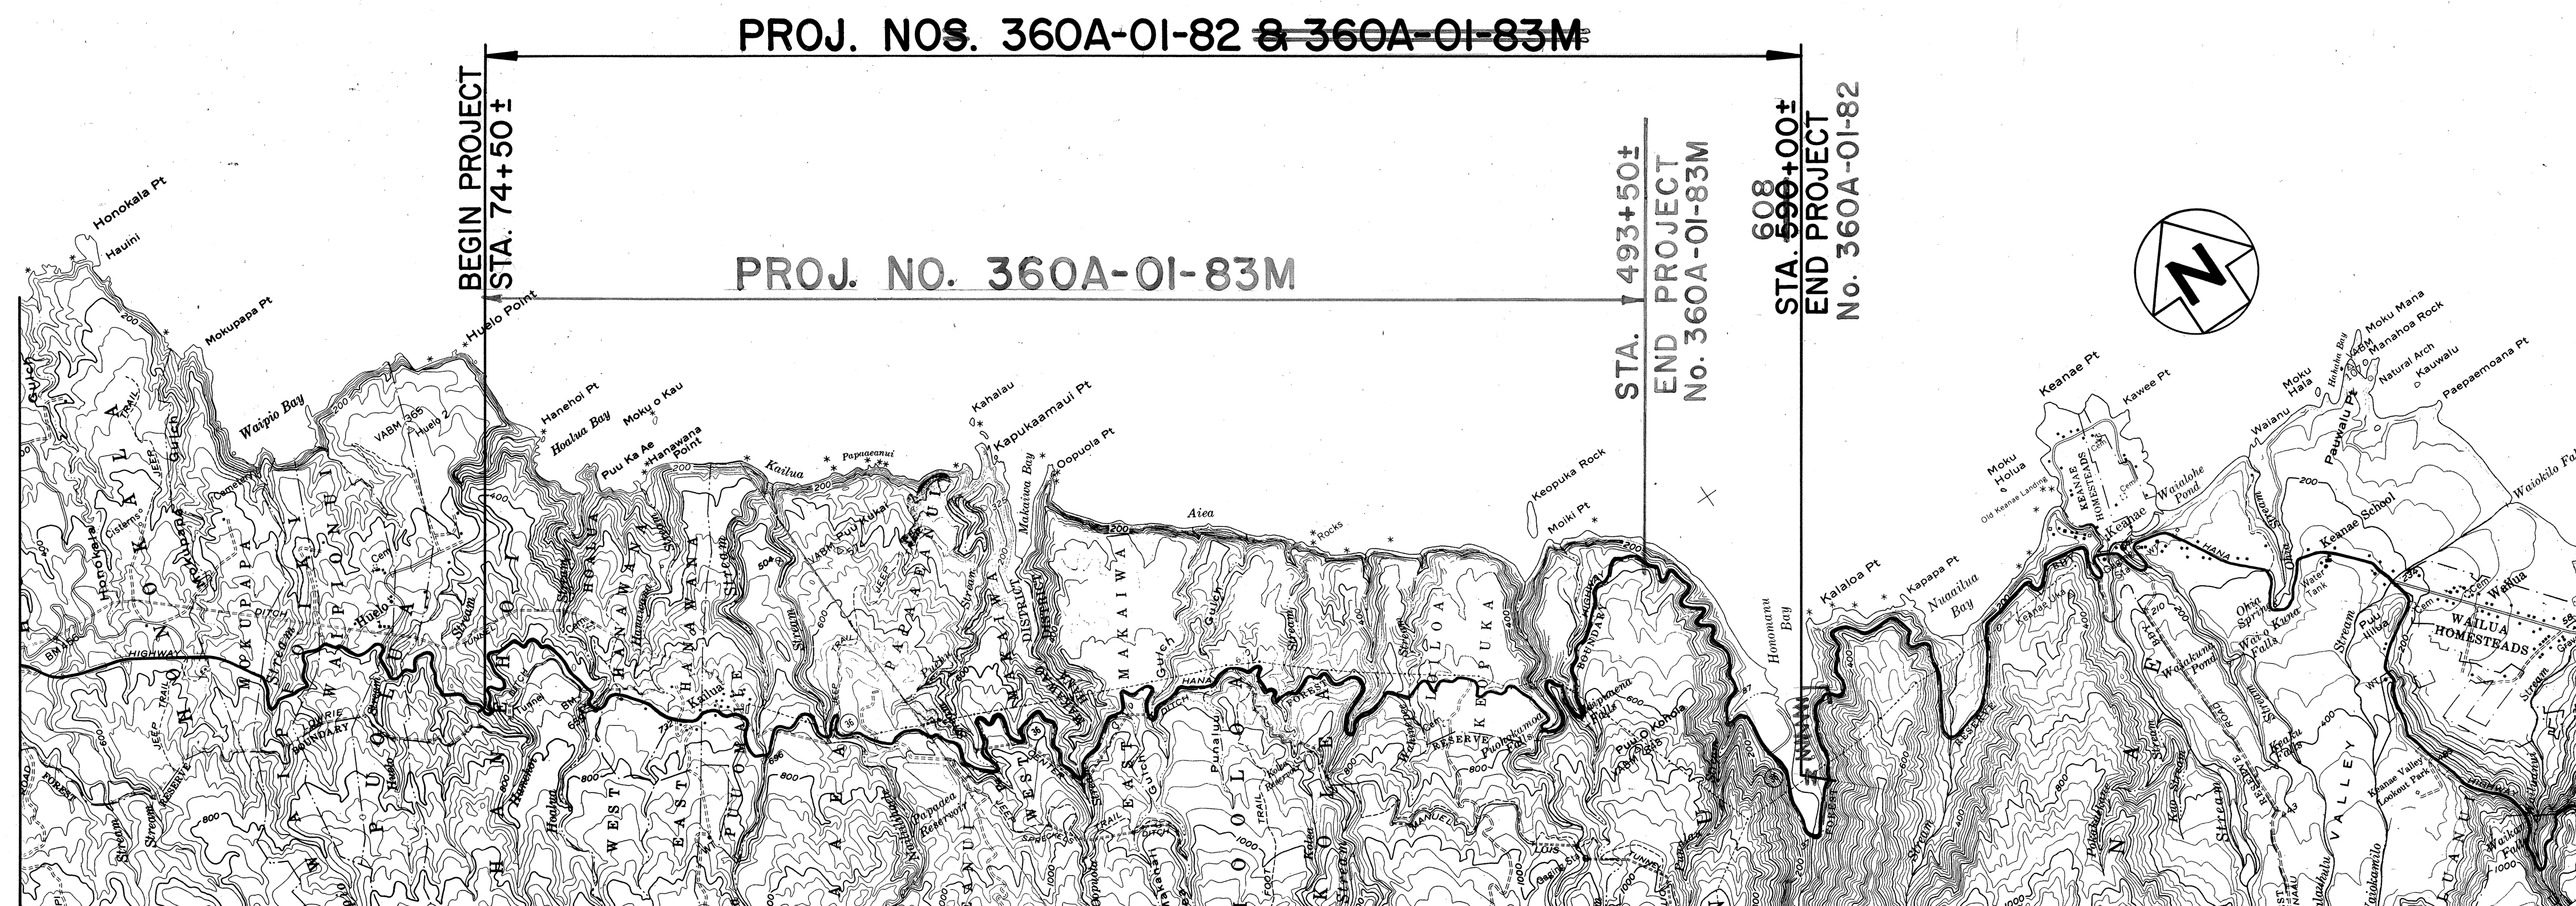

LAYOUT PLAN

DEPARTMENT OF TRANSPORTATION
STATE OF HAWAII

APPROVED:

James R. Carras 6/2/82
DIR. OF TRANSPORTATION DATE