

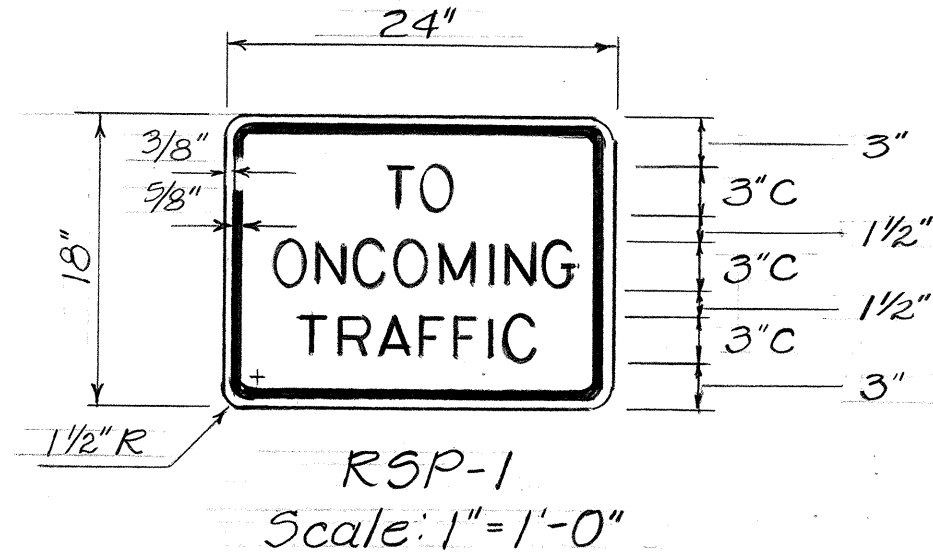
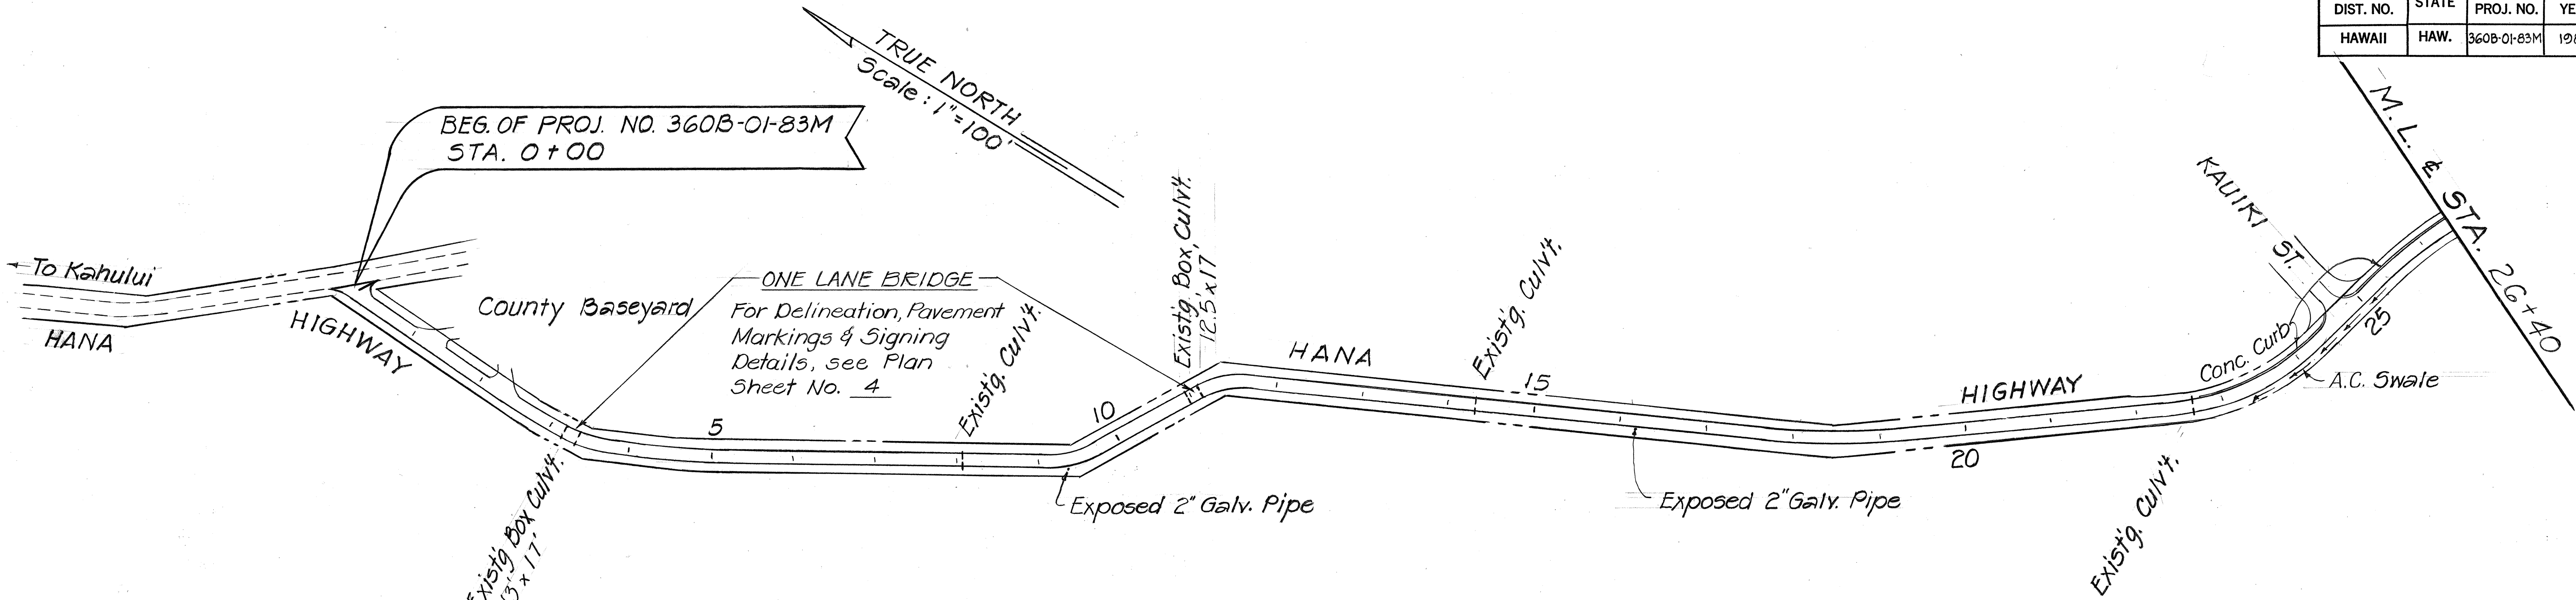


FED. ROAD DIST. NO.	STATE	PROJ. NO.	FISCAL YEAR	SHEET NO.	TOTAL SHEETS
HAWAII	HAW.	360B-01-83M	1983	3	12

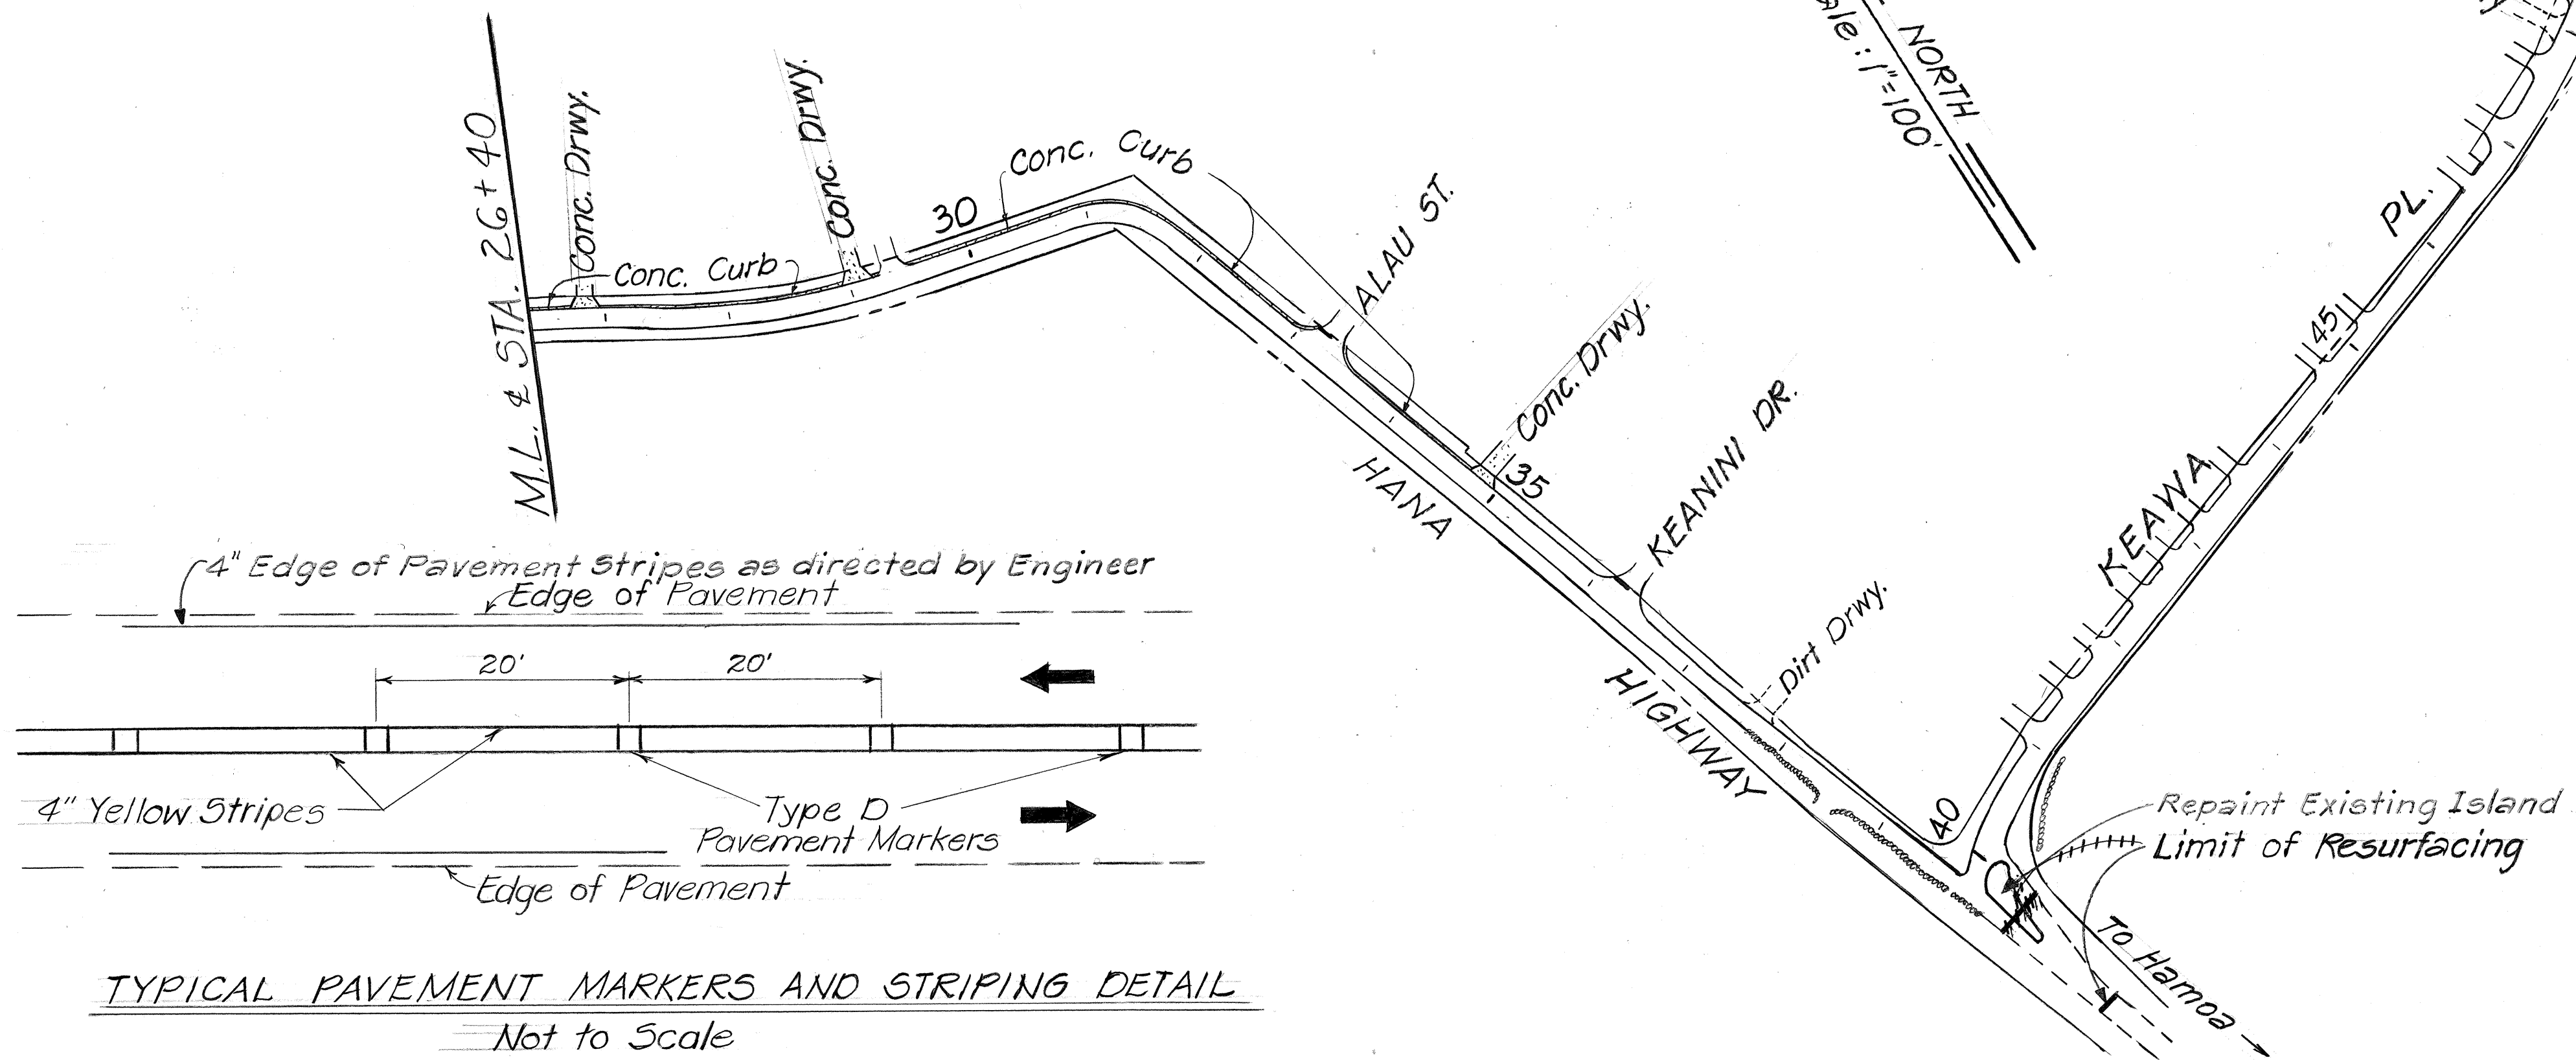

NOTE:
Sign RSP-1 is a Regulatory sign.

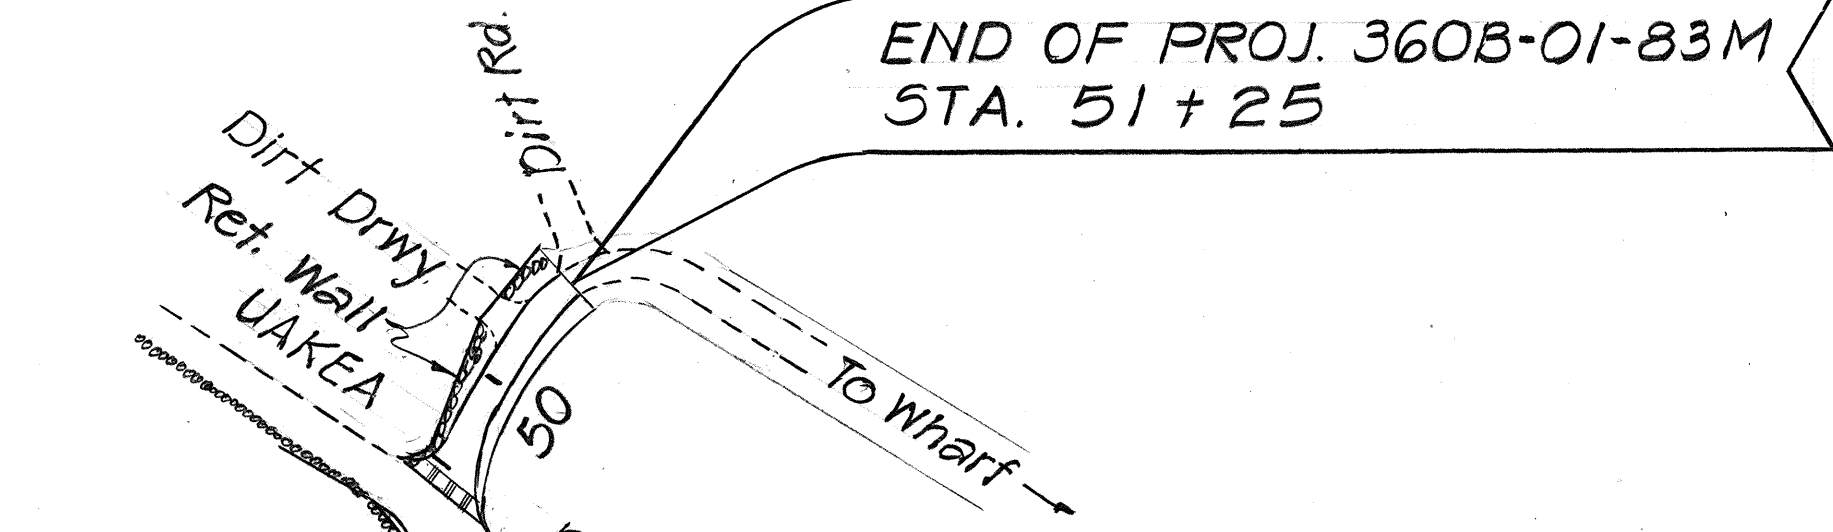

STATE OF HAWAII
DEPARTMENT OF TRANSPORTATION
LAND TRANSPORTATION FACILITIES DIVISION

PLAN

HANA HWY RESURFACING
CIVIC CENTER TO HANA WHARF
PROJ. NO. 360B-01-83M

SCALE: AS NOTED
JUNE 1982

SURVEY PLOTTED BY	DATE
DRAWN BY	
DESIGNED BY	
QUANTITIES BY	
CHECKED BY	