t.	
	INDEX TO DRAWINGS
SHEET NO.	DESCRIPTION
. 1	TITLE SHEET
2	TYPICAL SECTION, DETAILS, & GENERAL NOTES
3	PLANS
4 - 12	TYPICAL & STANDARD DETAILS
*,	
***************************************	



DEPARTMENT

STATE OF HAWAII

TRANSPORTATION

HIGHWAYS DIVISION


OF

HONOLULU, HAWAII

"AS - BUILT" PLANS FOR


## HANA HIGHWAY RESURFACING CIVIC CENTER TO HANA WHARF PROJECT NO. 360B-01-83M


DISTRICT OF HANA ISLAND OF MAUI

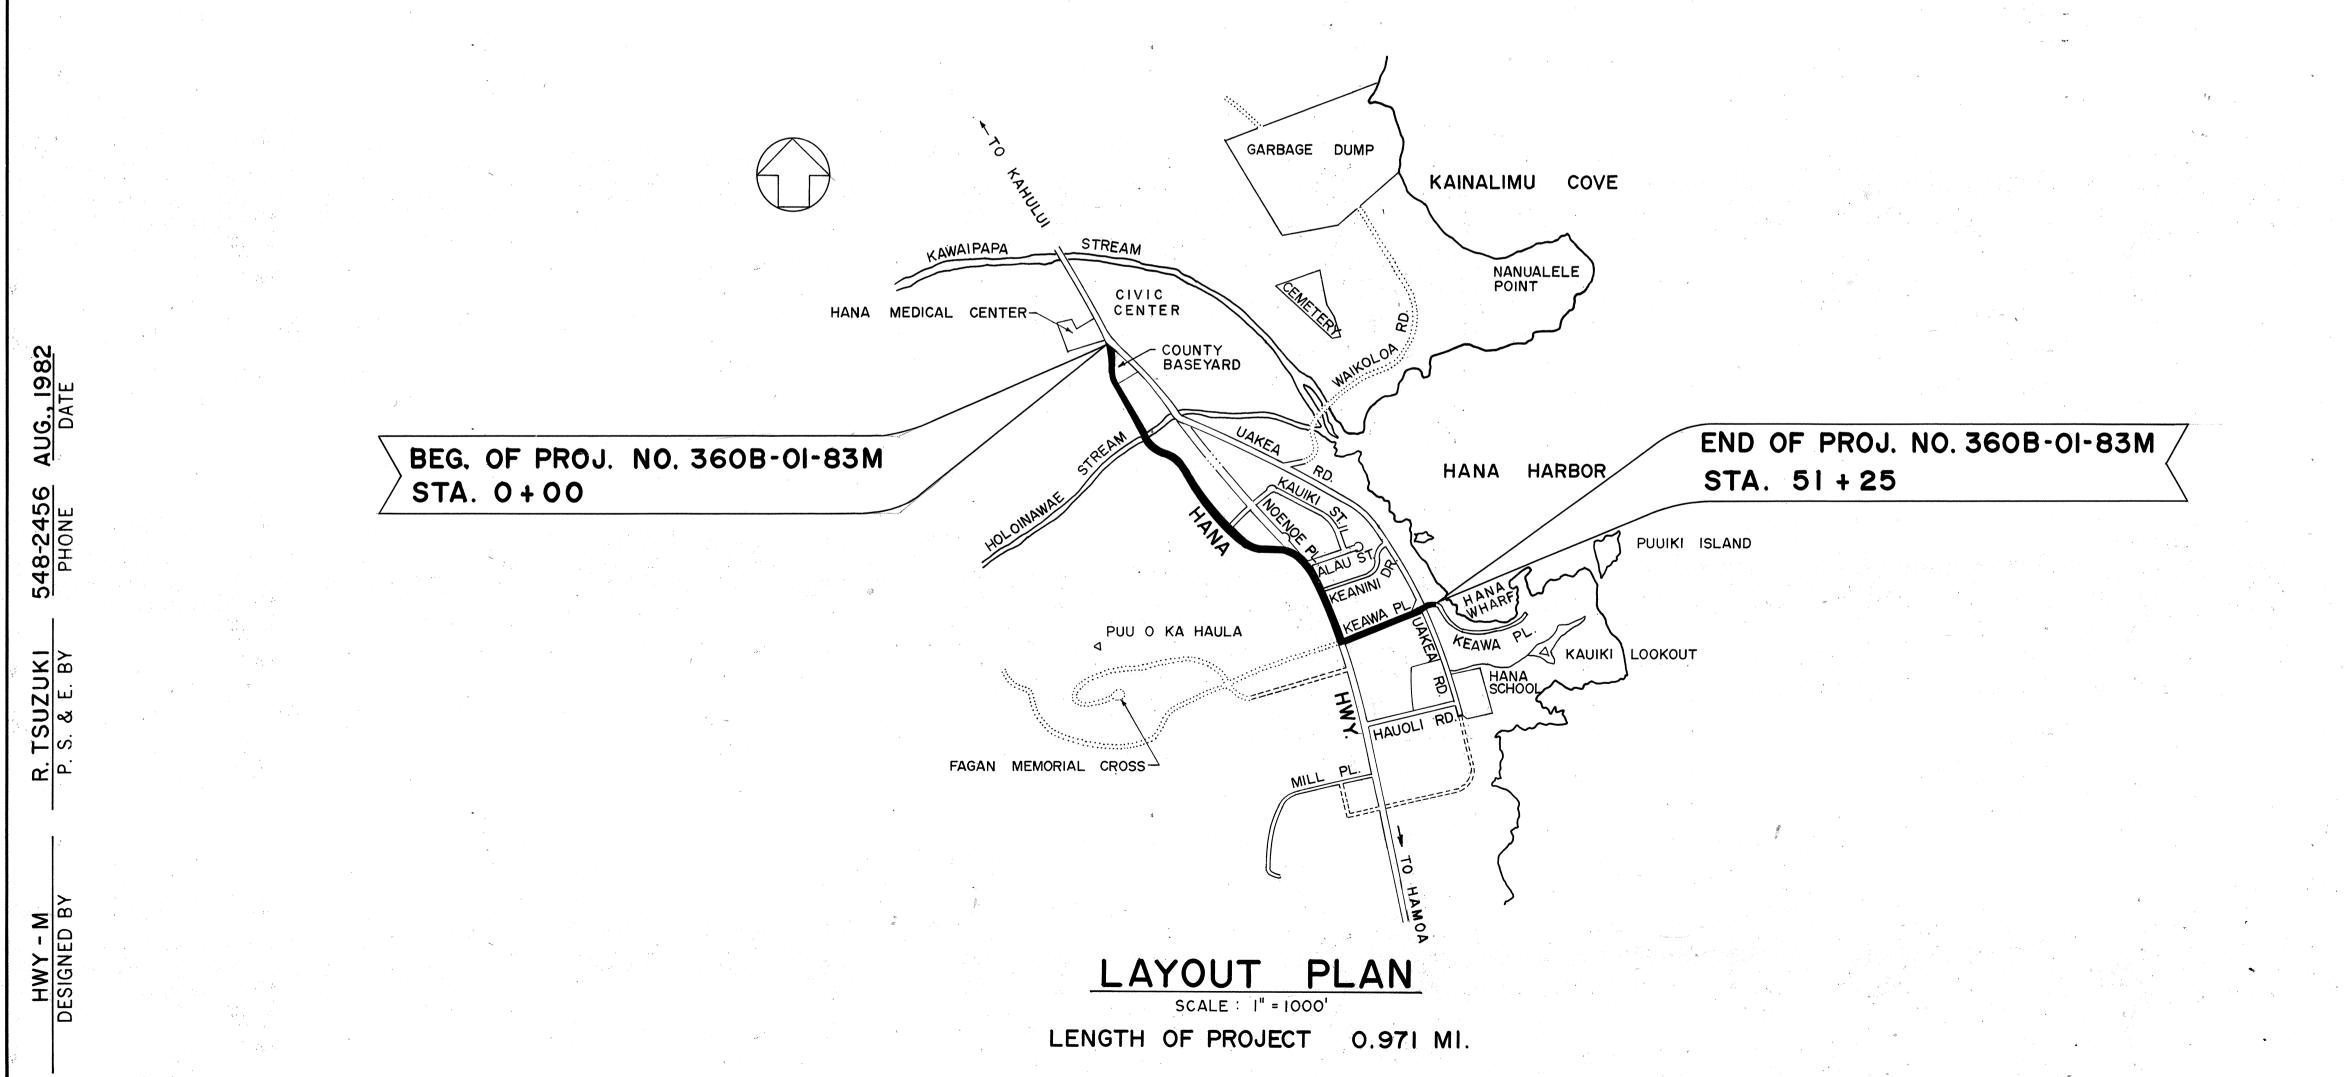


FED. ROAD DIST. NO. FISCAL YEAR SHEET TOTAL NO. SHEETS 360B-01-83M



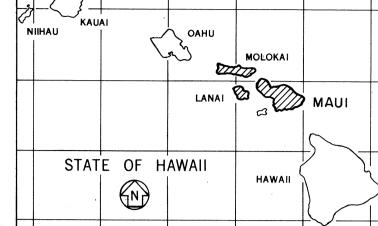

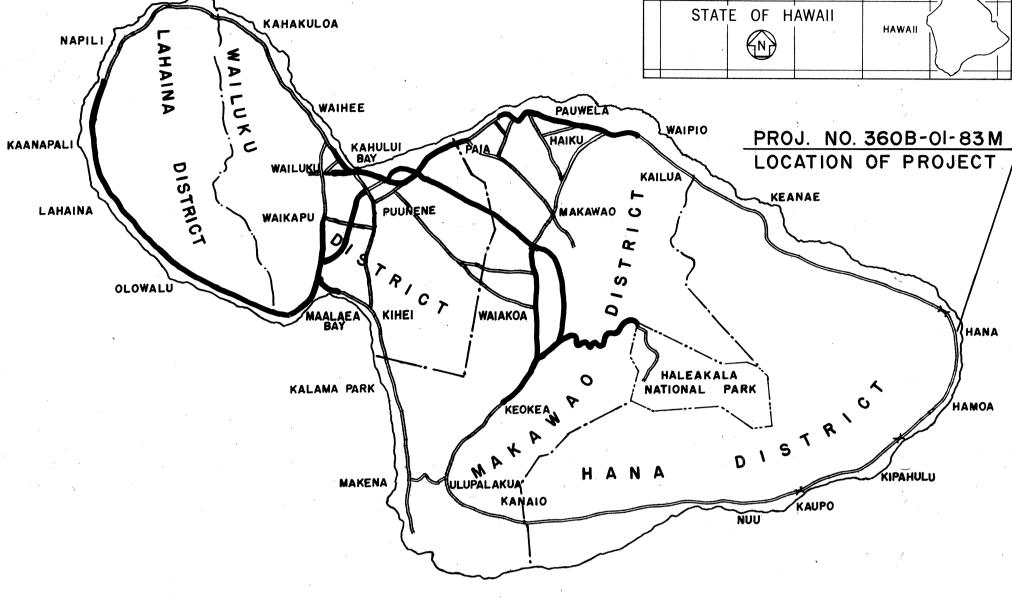

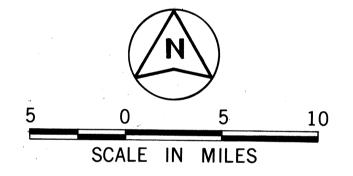

OR UNDER CONSTRUCTION

ALL CHANGES MADE DURING CONSTRUCTION HAVE BEEN INCORPORATED ON THESE PLANS IN RED EXCEPT CHANGES IN THE ORIGINAL THEORETICAL QUANTITIES. FOR ACTUAL QUANTITIES, REFER TO PROJECT LEDGER AND/OR COMPUTATION BOOK.

RESIDENT ENGINEER

DEPARTMENT OF TRANSPORTATION STATE OF HAWAII